



PARIC CORPORATION
77 Westport Plaza Suite 250
St. Louis, MO 63146
TEL: 636-561-9500
FAX: 636-561-9501

REQUEST FOR INFORMATION	DATE: July 20, 2017	NO.: RFI-593
--------------------------------	----------------------------	---------------------

To: Cannon Design

Attn: Kelvin Patel

From: Paric Corporation

Requested By: Devin Gates

Project Name: 15051-Webster University Interdisciplinary Science Building	Project No.: 15051
---	--------------------

Subject: Wood paneling clarifications

Response Required By: July 27, 2017

Drawing / Spec Reference:

Information Requested:

A0101.A and 1/A0210 do not show wood paneling at the alcoves for the restrooms or the janitors closet, however ID0101 does, please confirm if this is needed. **YES.**

A0102.A and 1/A0210 do not show wood paneling at the alcoves for the restrooms or the lactation room, however ID0102 does, please confirm if this is needed. **YES.**

At the reception (rm 202) area on A0102.B there is an elevation for 1/A0606, which gives a cut on the jambs for 3/A0810 which shows wood paneling. ID0102 does not show this paneling, please confirm if this is needed. **YES.**

A0103.A shows a cut for 3/A0180 on the south wall only in the alcove for the restrooms and the north wall only in the alcove for the janitors closet, please confirm whether to follow A0103.A or ID0103 at these locations. **YES.**

A104.A and 1/A0210 do not show wood paneling at the alcoves for the restrooms or the janitors closet, however ID0101 does, please confirm if this is needed. **YES.**

Please see attached plan and confirm this is the design intent.

YES. THE ATTACHED PLAN REFLECTS THE DESIGN INTENT.

Response:

Answered By: Kelvin Patel

Date: 07/20/2017



ARCHITECT'S RESPONSE:

This information is provided as an interpretation of the Contract Documents for implementation. It is not an authorization for change to the Contract Sum or Contract Time. If this information results in a claim for a change to the Contract, the Contractor shall notify the [Construction Manager][Architect] of a change through the change process.

Answered By: _____

Date: _____

INTERIORS SYMBOLS LEGEND
1/8" = 1'-0"

- 1 WWP-2 OPAQUE, WHITE (LAQUER FINISH) PANELS TO BE LOCATED FLOOR TO CEILING AT DESIGNATED LOCATIONS. SEE ELEVATIONS AND ENVIRONMENTAL GRAPHICS DRAWINGS FOR LAYOUT AND GRAPHIC INLAY.
- 2 WWP-1 TO BE USED ON FACES OF WALLS AND SOFFITS AT DESIGNATED LAB ENTRANCE RECESSES.
- 3 OPAQUE FINISH WOOD PERFORATED PANELS FOR ACOUSTICS WITH 1 1/2" FIBERGLASS ACOUSTICS WHITE BATTS BEHIND. TO BE PAINTED SCHEDULED WALL COLOR.
- 4 AP-1 FABRIC WRAPPED ACOUSTIC PANELS - FULL HEIGHT.
- 5 VERTICAL WOOD GRILLE SCREEN - REFER TO INTERIOR ELEVATIONS.
- 6 AWC-1 MARKER BOARD PAINT TO BE USED FULL HEIGHT.
- 7 CWC-1 CORK WALLCOVERING TO BE APPLIED 3'0" AFF TO CEILING.
- 8 EXTENTS OF WALL TILE. SEE SHEET ID0202 FOR FLOOR AND WALL PATTERN.
- 9 EXTENTS OF FAP-1 PANELS TO BE MOUNTED ABOVE WALL BASE.
- 10 WALL TO HAVE 3/16" SOUND COUSTIC PADS. PADS TO BE PAINTED SCHEDULED WALL COLOR.
- 11 COMBINATION AWC-1 MARKER BOARD PAINT AND CWC-1 CORK WALLCOVERING WALL TREATMENT. CWC-1 TO BE 4'0" WIDE SECTION ON NORTH SIDE OF WALL / REMAINDER OF WALL TO BE AWC-1. SEE ELEVATIONS ON ID0202 FOR TYPICAL.



© Cannon Design 2015


INTERIOR SYMBOLS LEGEND

- SHADED AREAS ARE NOT INCLUDED IN SCOPE OF WORK FOR INTERIOR RENOVATION
- KEYED NOTE
- LVT-1 INSTALLATION DIRECTION. INSTALL PARALLEL WITH DIRECTION OF SYMBOL
- XX-# LOCATION OF FLOORING MATERIAL TRANSITION
- XX-# SPECIFIED FINISH, REFERENCE FINISH SCHEDULE IF NOT NOTED.

INTERIORS SYMBOLS LEGEND
1/8" = 1'-0"

PLAN KEY NOTES

- WVP-2 OPAQUE, WHITE (LAQUER FINISH) PANELS TO BE LOCATED FLOOR TO CEILING AT DESIGNATED LOCATIONS. SEE ELEVATIONS AND ENVIRONMENTAL GRAPHICS DRAWINGS FOR LAYOUT AND GRAPHIC INLAY.
- WVP-1 TO BE USED ON FACES OF WALLS AND SOFFITS AT DESIGNATED LAB ENTRANCE RECESSES.
- OPAQUE FINISH WOOD PERFORATED PANELS FOR ACOUSTICS WITH 1 1/2" FIBERGLASS ACOUSTICS WHITE BATTS BEHIND. TO BE PAINTED SCHEDULED WALL COLOR.
- AP-1 FABRIC WRAPPED ACOUSTIC PANELS - FULL HEIGHT.
- VERTICAL WOOD GRILLE SCREEN - REFER TO INTERIOR ELEVATIONS.
- AWC-1 MARKER BOARD PAINT TO BE USED FULL HEIGHT.
- CWC-1 CORK WALLCOVERING TO BE APPLIED 30" AFF TO CEILING.
- EXTENTS OF WALL TILE. SEE SHEET ID0202 FOR FLOOR AND WALL PATTERN.
- EXTENTS OF FAP-1 PANELS TO BE MOUNTED ABOVE WALL BASE.
- WALL TO HAVE 3/16" SOUND COUSTIC PADS. PADS TO BE PAINTED SCHEDULED WALL COLOR.
- COMBINATION AWC-1 MARKER BOARD PAINT AND CWC-1 CORK WALLCOVERING WALL TREATMENT. CWC-1 TO BE 40" WIDE SECTION ON NORTH SIDE OF WALL / REMAINDER OF WALL TO BE AWC-1. SEE ELEVATIONS ON ID0202 FOR TYPICAL.

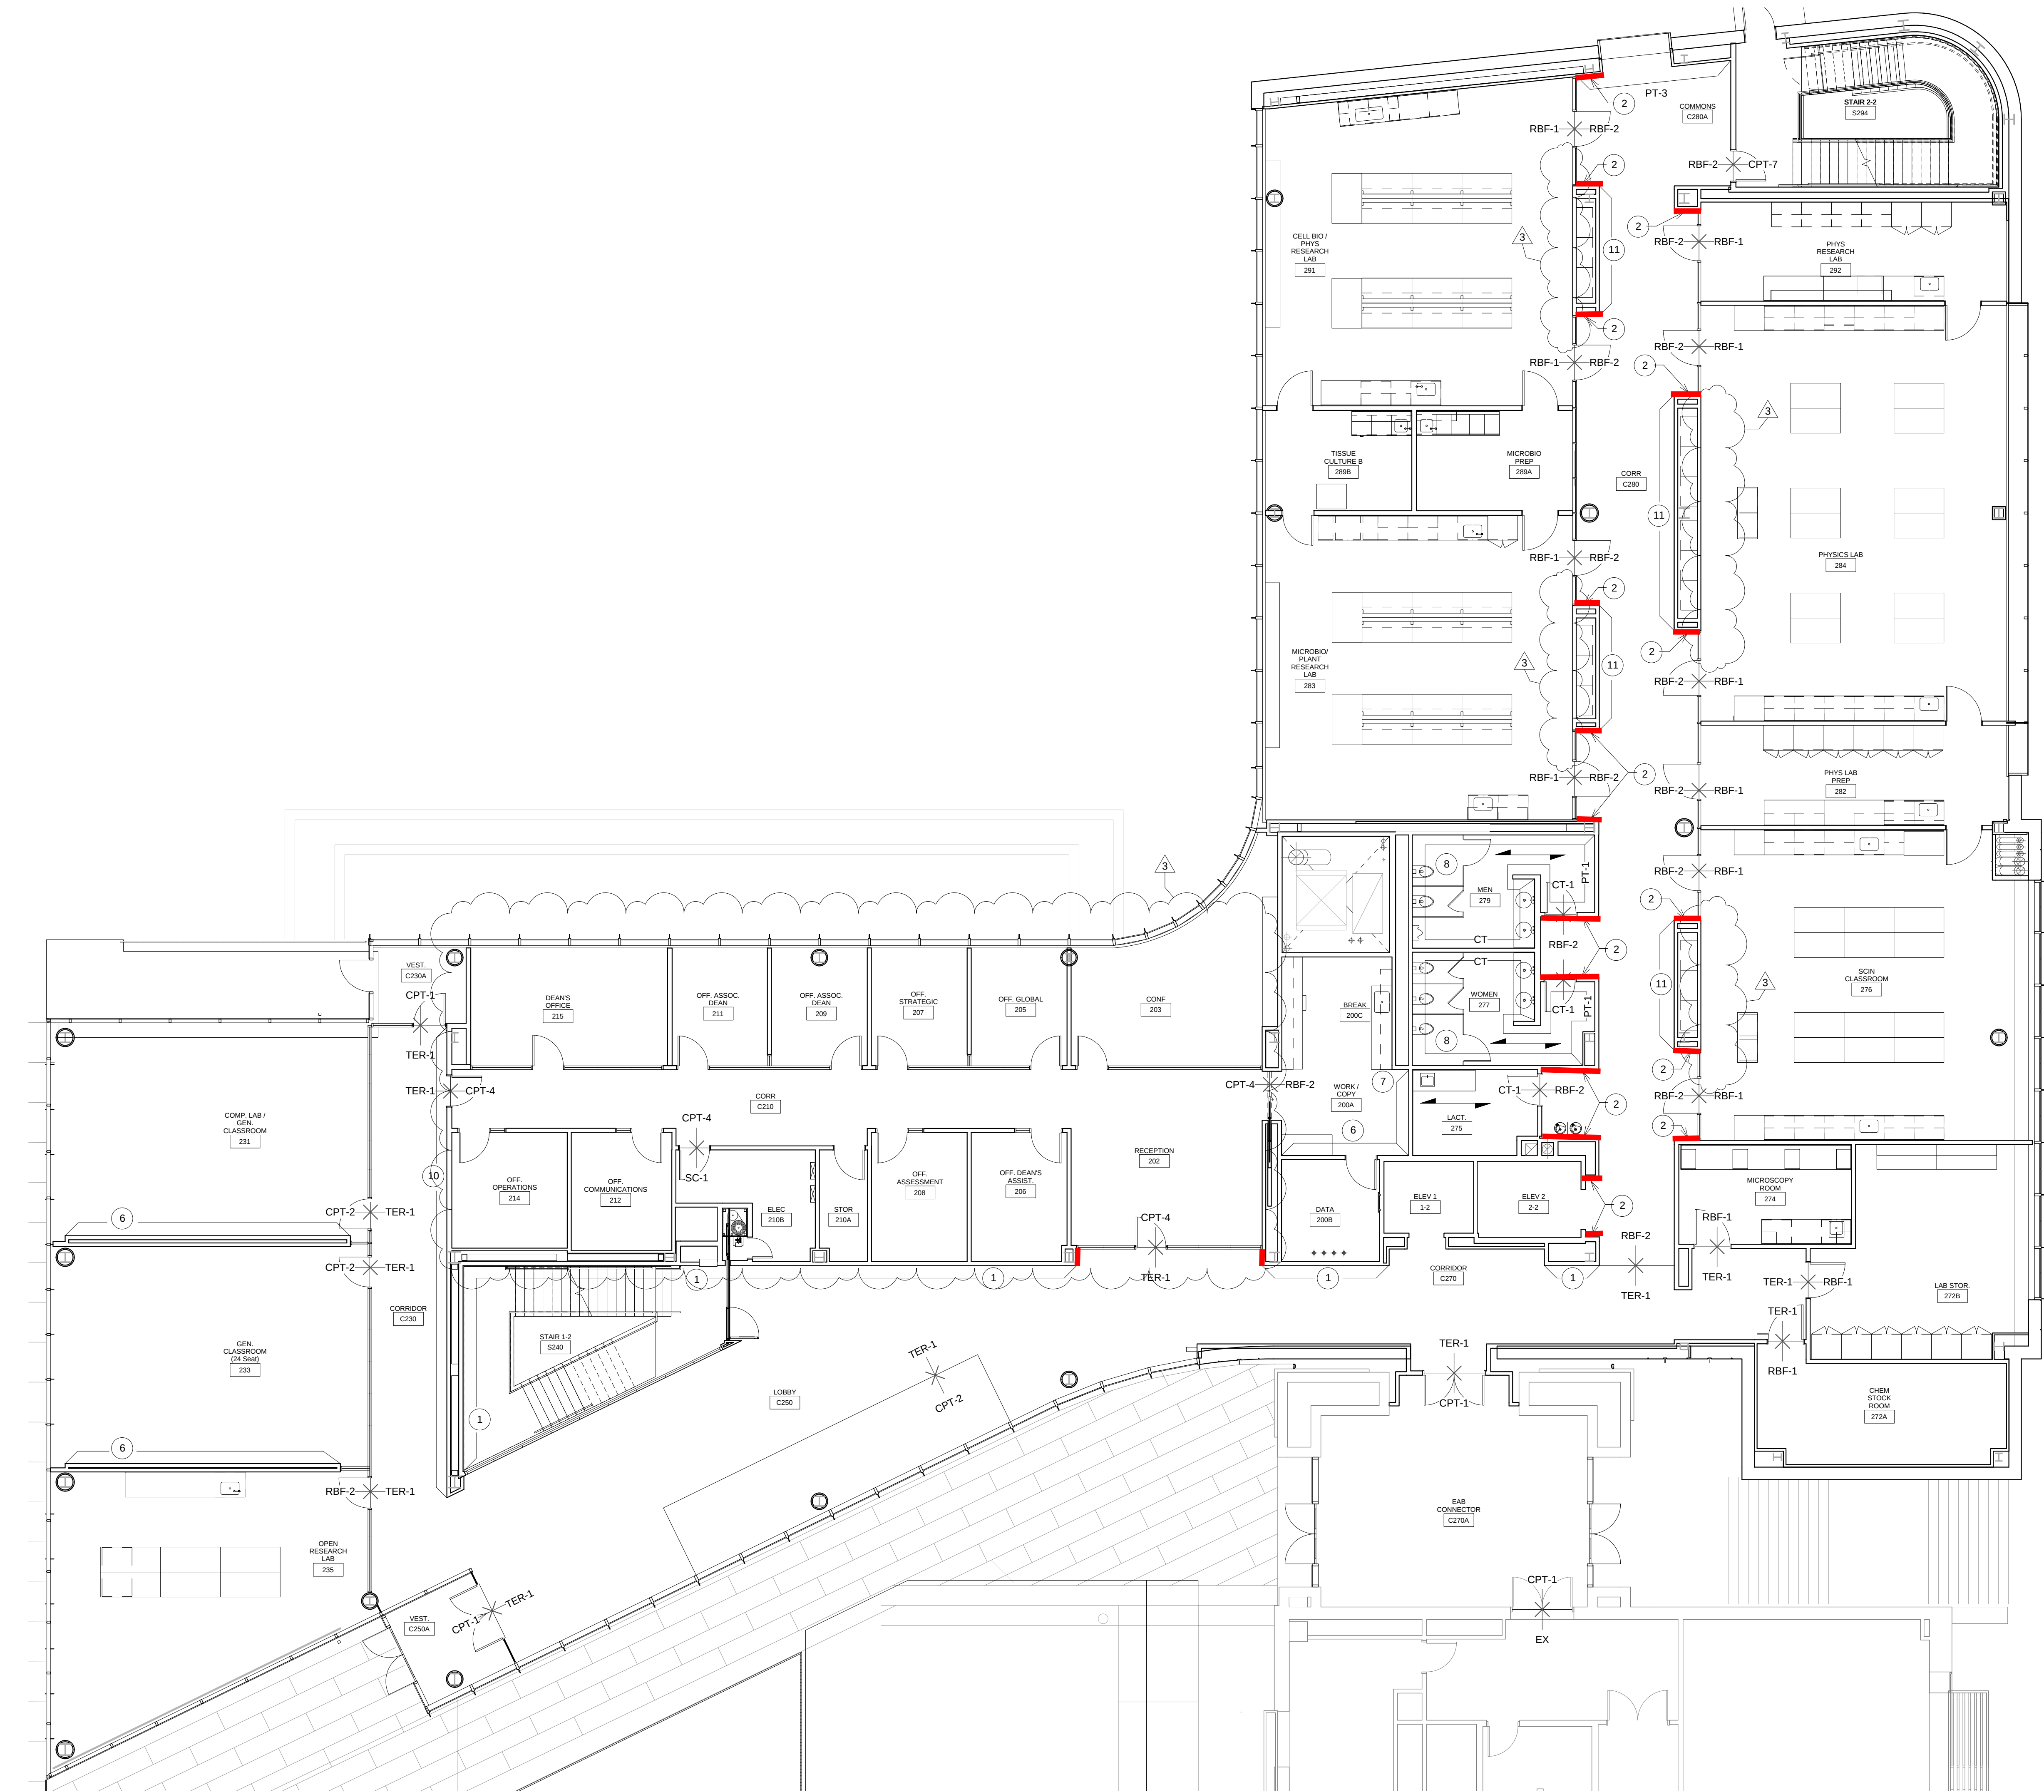

1 SECOND FLOOR TRANSITION PLAN
1/8" = 1'-0"

- William Tao & Associates, Inc.**
MEP/FP Engineer
7955 Manchester Road, Suite 125
St. Louis, MO 63143
314-884-7600
- David Mason & Associates, Inc.**
Structural & Civil Engineer
800 South Vandeventer Avenue
St. Louis, MO 63110
314-534-1053
- Faith Group**
Technology
3101 S. Hanley Rd. Suite 100
St. Louis, MO 63143
314-991-2229
- Kuhmann Leavitt, Inc.**
Environmental Graphics & Signage
7400 Pershing Ave
St. Louis, MO 63130
314-725-6616
- KWA Architects**
Architecture
9721 Litzinger Road
St. Louis, MO 63124
314-962-2560
- Spellman Brady & Company**
Interior Designer
8251 Maryland Avenue, Suite 300
St. Louis, MO 63105
314-862-0070
- SWT Design**
Landscape Architect
7722 Big Bend Blvd
St. Louis, MO 63119
314-644-5700
- Webb Engineering Services, Inc.**
Planning & Fire Protection
1400 S. 3rd Street, Suite 201
St. Louis, MO 63104
314-588-0600

3	ASI-064	26 APR 2017
2	ASI-015	25 JUL 2016
1	ADDENDUM 3-2	15 APR 2016
ISSUED FOR CONSTRUCTION (BP3)		15 MAR 2016
No.	Description	Date

Drawing Title:

SECOND FLOOR
TRANSITION PLAN

Project No.: 04561.01 Checked by:

ID0102

SHADED AREAS ARE NOT INCLUDED IN SCOPE OF WORK FOR INTERIOR RENOVATION

KEYED NOTE

LVT-1 INSTALLATION DIRECTION.
INSTALL PARALLEL WITH DIRECTION OF SYMBOL

LOCATION OF FLOORING MATERIAL TRANSITION

SPECIFIED FINISH, REFERENCE FINISH SCHEDULE IF NOT NOTED.

- 1 WWP-2 OPAQUE, WHITE (LAQUER FINISH) PANELS TO BE LOCATED FLOOR TO CEILING AT DESIGNATED LOCATIONS. SEE ELEVATIONS AND ENVIRONMENTAL GRAPHICS DRAWINGS FOR LAYOUT AND GRAPHIC INLAY.
- 2 WWP-1 TO BE USED ON FACES OF WALLS AND SOFFITS AT DESIGNATED LAB ENTRANCE RECESSES.
- 3 OPAQUE FINISH WOOD PERFORATED PANELS FOR ACOUSTICS WITH 1 1/2" FIBERGLASS ACOUSTICS WHITE BATTS BEHIND. TO BE PAINTED SCHEDULED WALL COLOR.
- 4 AP-1 FABRIC WRAPPED ACOUSTIC PANELS - FULL HEIGHT.
- 5 VERTICAL WOOD GRILLE SCREEN - REFER TO INTERIOR ELEVATIONS.
- 6 AWC-1 MARKER BOARD PAINT TO BE USED FULL HEIGHT.
- 7 CWC-1 CORK WALLCOVERING TO BE APPLIED 30" AFF TO CEILING.
- 8 EXTENTS OF WALL TILE. SEE SHEET ID0202 FOR FLOOR AND WALL PATTERN.
- 9 EXTENTS OF FAP-1 PANELS TO BE MOUNTED ABOVE WALL BASE.
- 10 WALL TO HAVE 3/16" SOUND COUSTIC PADS. PADS TO BE PAINTED SCHEDULED WALL COLOR.
- 11 COMBINATION AWC-1 MARKER BOARD PAINT AND CWC-1 CORK WALLCOVERING WALL TREATMENT. CWC-1 TO BE 40" WIDE SECTION ON NORTH SIDE OF WALL / REMAINDER OF WALL TO BE AWC-1. SEE ELEVATIONS ON ID0202 FOR TYPICAL.



1 THIRD FLOOR TRANSITION PLAN
1/8" = 1'-0"

Webster University
Interdisciplinary Science
Building

CANNONDESIGN

William Tao & Associates, Inc
MEP/FP Engineer
955 Manchester Road, Suite 125
St. Louis, MO 63143
314-884-7600

David Mason & Associates, Inc
Structural & Civil Engineer
800 South Vandeventer Avenue
St. Louis, MO 63110
314.534.1053

Faith Group
Technology
3101 S. Hanley Rd, Suite 100
St. Louis, MO 63143
314.991.2228

Kuhlmann Leavitt, Inc.
Environmental Graphics & Signage
7400 Pershing Ave
St. Louis, MO 63130
314.725.6616

KWA Architects
Architecture
9721 Litzinger Road
St. Louis, MO 63124
314.962.2560

Spellman Brady & Company
Interior Designer
251 Maryland Avenue, Suite 300
St. Louis, MO 63105
314.862.0070

SWT Design
Landscape Architect
7722 Big Bend Blvd
St. Louis, MO 63119
314.644.5700

Webb Engineering Services, Inc.
Plumbing & Fire Protection
1400 S. 3rd Street, Suite 201
St. Louis, MO 63104
314.588.0600

2	ASI-064	26 APR 2017
1	ADDENDUM 3-2	15 APR 2016
-	ISSUED FOR CONSTRUCTION (BP3)	15 MAR 2016
No.	Description	Date

Drawing Title:

THIRD FLOOR TRANSITION PLAN

Project No.: 04561.01

Checked by:

ID0103

SHADED AREAS ARE NOT INCLUDED IN SCOPE OF WORK FOR INTERIOR RENOVATION

1 KEYED NOTE

LVT-1 INSTALLATION DIRECTION.
INSTALL PARALLEL WITH DIRECTION OF SYMBOL

XX-#

LOCATION OF FLOORING MATERIAL TRANSITION

XX-#

SPECIFIED FINISH, REFERENCE FINISH SCHEDULE IF NOT NOTED.

INTERIORS SYMBOLS LEGEND
1/8" = 1'-0"

- 1 WVP-2 OPAQUE, WHITE (LAQUER FINISH) PANELS TO BE LOCATED FLOOR TO CEILING AT DESIGNATED LOCATIONS. SEE ELEVATIONS AND ENVIRONMENTAL GRAPHICS DRAWINGS FOR LAYOUT AND GRAPHIC INLAY.
- 2 WVP-1 TO BE USED ON FACES OF WALLS AND SOFFITS AT DESIGNATED LAB ENTRANCE RECESSES.
- 3 OPAQUE FINISH WOOD PERFORATED PANELS FOR ACOUSTICS WITH 1 1/2" FIBERGLASS ACOUSTICS WHITE BATTS BEHIND. TO BE PAINTED SCHEDULED WALL COLOR.
- 4 AP-1 FABRIC WRAPPED ACOUSTIC PANELS - FULL HEIGHT.
- 5 VERTICAL WOOD GRILLE SCREEN - REFER TO INTERIOR ELEVATIONS.
- 6 AWC-1 MARKER BOARD PAINT TO BE USED FULL HEIGHT.
- 7 CWC-1 CORK WALLCOVERING TO BE APPLIED 30" AFF TO CEILING.
- 8 EXTENTS OF WALL TILE. SEE SHEET ID0202 FOR FLOOR AND WALL PATTERN.
- 9 EXTENTS OF FAP-1 PANELS TO BE MOUNTED ABOVE WALL BASE.
- 10 WALL TO HAVE 3 1/8" SOUND COUSTIC PADS. PADS TO BE PAINTED SCHEDULED WALL COLOR.
- 11 COMBINATION AWC-1 MARKER BOARD PAINT AND CWC-1 CORK WALLCOVERING WALL TREATMENT. CWC-1 TO BE 40" WIDE SECTION ON NORTH SIDE OF WALL / REMAINDER OF WALL TO BE AWC-1. SEE ELEVATIONS ON ID0202 FOR TYPICAL.
- 12 CWC-1 CORK WALLCOVERING WALL TREATMENT.



① FOURTH FLOOR TRANSITION PLAN
1/8" = 1'-0"



CANNONDESIGN

Webb Engineering Services, Inc.
Plumbing & Fire Protection
1400 S. 3rd Street, Suite 201
St. Louis, MO 63104
314.588.0600

2	ASI-064	26 APR 2017
1	ADDENDUM 3-2	15 APR 2016
-	ISSUED FOR CONSTRUCTION (BP3)	15 MAR 2016
No.	Description	Date

Project No.: 04561.01 Checked by:

ID0104

© Cannon Design 2015

© Cannon Design 2015
All rights reserved. No part of this document may be reproduced or utilized in any form, without prior written authorization by The Cannon Corporation.
4/26/2017 1:25:12 PM