



PARIC CORPORATION
77 Westport Plaza Suite 250
St. Louis, MO 63146
TEL: 636-561-9500
FAX: 636-561-9501

REQUEST FOR INFORMATION DATE: August 04, 2017 **NO.:** RFI-600

To: Cannon Design

Attn: Kelvin Patel

From: Paric Corporation

Requested By: Ryan Tune

Project Name: 15051-Webster University Interdisciplinary Science Building Project No.: 15051

Subject: Handrail Paint Color

Response Required By: August 11, 2017

Drawing / Spec Reference:

Information Requested:

Please confirm the color of the handrail at the lecture hall and loading dock. See attached.

Response:


As discussed on 08/07/2017, the handrails at the lecture hall to be 'web gray sw 7075' color to match the column covers.

ARCHITECT'S RESPONSE:

This information is provided as an interpretation of the Contract Documents for implementation. It is not an authorization for change to the Contract Sum or Contract Time. If this information results in a claim for a change to the Contract, the Contractor shall notify the [Construction Manager][Architect] of a change through the change process.

Answered By: Kelvin Patel


Date: 08/08/2017

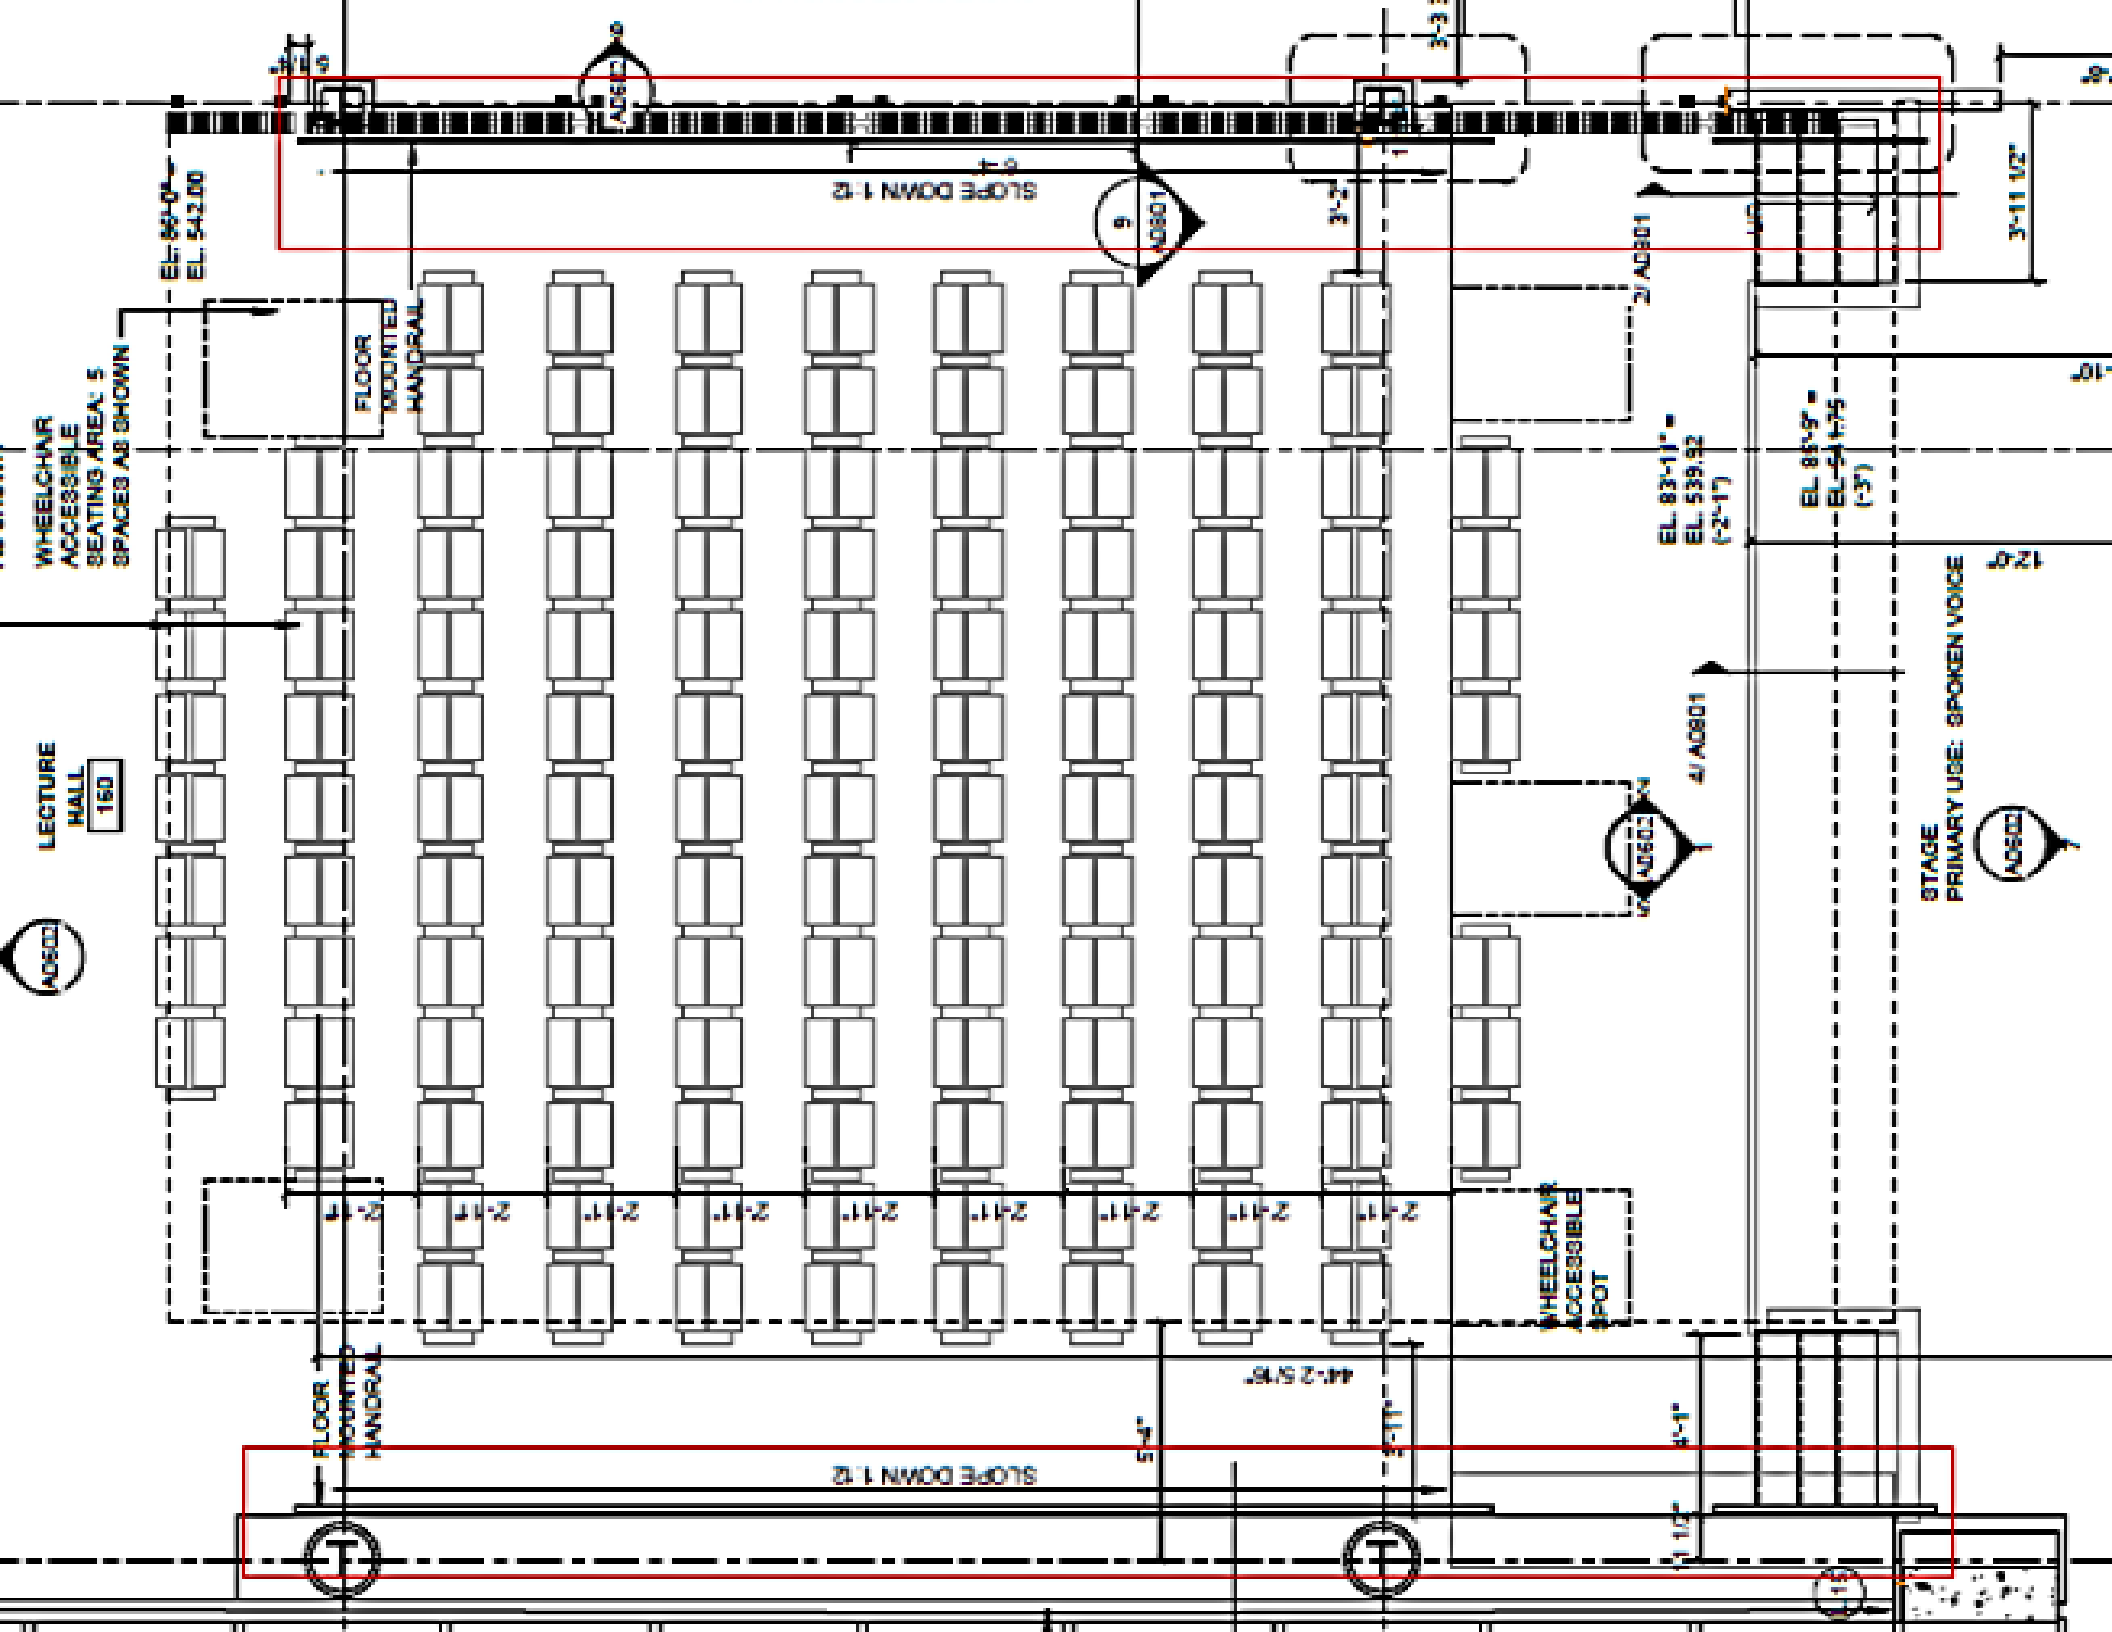


TYP

7
A05115'-6"
6 TREADS @ 11"

5'-3"

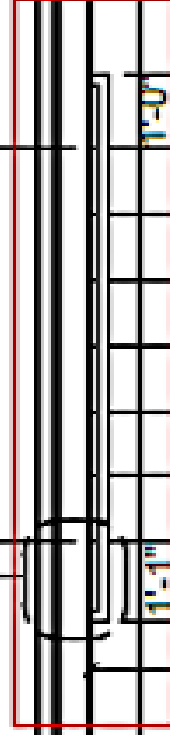CONCRETE
STEPS AND
PLATFORM
WITH RAILINGS

4'-4"

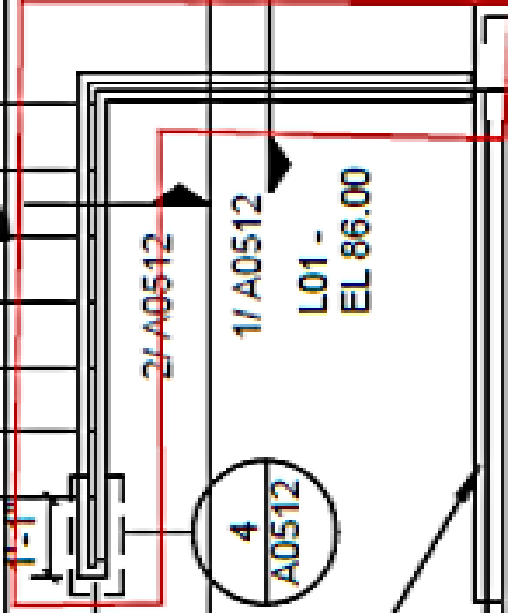

2/A0512

4
A0512

1/A0512

DOCK LIFT PIT:
14" DEEP W/
ANGLE 3 SIDESL01 -
EL 86.00L01 DOCK -
EL 90.0011 1300
STATIONARY
DOCK LIFT -72"
X 96"
PLATFORM

1/A0512

