HOHMANN & BARNARD, INC.
A MiTek - BERKSHIRE HATHAWAY COMPANY

Flashing and Reglets

T1 - Termination Bar

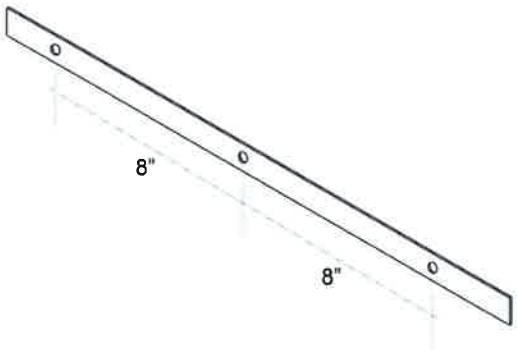

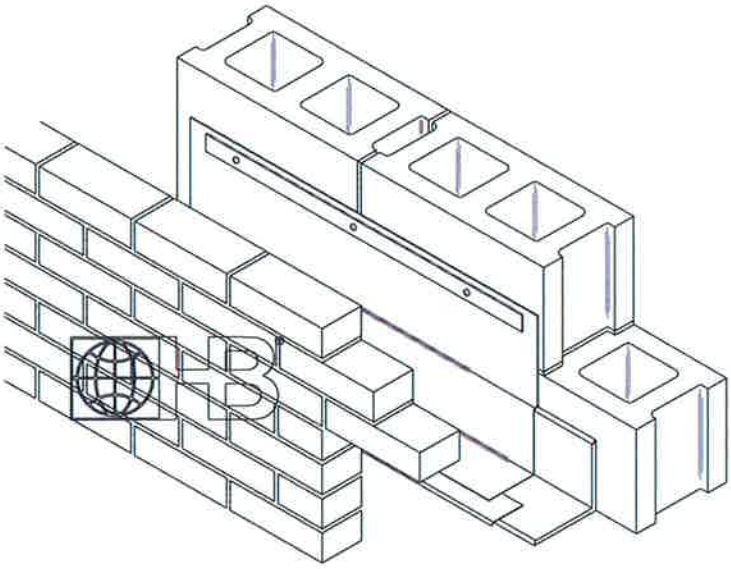

DRAWINGS FOR ILLUSTRATIVE PURPOSES ONLY

T1 - Termination Bar
Used at top of flashing to mechanically secure it to the backup.

- Compatible with all H&B Surface-Mount flashings.
- Available with optional Foam-Tite Seal™ to aid in inhibiting moisture infiltration.

U.S. Pat. No. 6,945, 000
Other Patents Pending

Size:
1/8" thick x 1" wide x 8' long
with 1/4" diameter holes, spaced 8" O.C.

Finishes:
- ☐ Stainless Steel (Type 304)
- ☐ Stainless Steel (Type 316 - *special order*)
- ☐ Aluminum
- ☐ Plastic (PVC)

Optional:
- ☐ FTS (Foam-Tite Seal™)

Foam-Tite Seal™ is a factory-installed foam strip designed to help seal small voids occurring between the termination bar and any irregular surfaces of the substrate, while offering added protection against water penetration due to deterioration of the sealant.

IMPORTANT: Since each construction project is unique, the appropriate selection and use of any product contained herein must be determined by competent architects, engineers and other appropriate professionals who are familiar with the specific requirements of the project in question.

HOHMANN & BARNARD, Inc.
30 Rasons Court | Hauppauge, NY 11788
CORPORATE HEADQUARTERS
T: 800.645.0616 F: 631.234.0683
www.h-b.com

Branch/Subsidiary Locations:
ALABAMA - ILLINOIS - MARYLAND
NEW YORK - PENNSYLVANIA - TEXAS
UTAH - CANADA

© HOHMANN & BARNARD, INC. - 2014

CANNONDESIGN

SUBMITTAL IDENTIFICATION SHEET

To be completed by Contractor/CM

WEBSTER UNIVERSITY ISB
PROJECT NAME

8274 BIG BEND BLVD
ADDRESS

NUMBER

WEBSTER UNIVERSITY
OWNER

CANNON DESIGN
ARCHITECT / ENGINEER

Joe Voypick
SUBMITTED BY

044300-007
CONTRACTOR / CM SUBMITTAL NO.

CANNON DESIGN SUBMITTAL NO.

DRAWING / DETAIL REFERENCE

044300
SPECIFICATION SECTION / PARAGRAPH

Leonard Masonry
MANUFACTURER / SUPPLIER

ITEM / PRODUCT ID

REQUIRED DATE

PRIORITY

◯ CRITICAL

ITEM BEING SUBMITTED (check only one)

- ◉ Shop Drawings
- ◯ Samples (_____ copies)
- ◯ LEED Submittal
- ◯ Certification / Qualifications
- ◯ Record Documents
- ◯ Product Data
- ◯ Coordination Drawing
- ◯ Calculations
- ◯ Schedules
- ◯ O&M Manuals
- ◯ Other _____

ITEM BEING SUBMITTED FOR (check only one)

- ◉ Action
- ◯ Information Only
- ◯ Record

REMARKS OR DEVIATIONS

CONTRACTOR / CM CERTIFICATION
(SUBMITTALS NOT CERTIFIED WILL BE RETURNED WITHOUT REVIEW)

PARIC

PARIC CORPORATION
SUBMITTAL STAMP

THIS SHOP DRAWING HAS BEEN REVIEWED BY PARIC CORPORATION

Subcontractor remains responsible for dimensions, quantities, coordination with other trades and compliance with contract documents.

By:
Devin D. Gates

Joe Voypick
REVIEWED BY

6/13/16
DATE

To be completed by Reviewer

04 4300-007
CANNON DESIGN SUBMITTAL NUMBER

6/13/16
RECEIVED DATE

- ◯ A. No Exceptions Taken
  No further review of submittal is required.
- ◯ B. Make Corrections Noted
  Incorporate corrections in work; resubmission is not required.
- ◉ C. Revise and Resubmit
  Revise as noted, and resubmit for review.
- ◯ D. Rejected
  Submittal is not in compliance with Contract Documents; provide new submittal.
- ◯ E. For Record / Information Only
  Submittal was reviewed for Record / Information purposes only.
- ◯ F. Not Required for Review
  Submittal is not required by Contract Documents and has not been reviewed.

Review is for conformance with the design concept of this project and for general compliance with contract documents. Contractor is responsible for quantities, dimensions and compliance with contract documents and for information that pertains to fabrication processes, construction techniques and coordination of this work with all trades which will be affected thereby. This review is null and void if submittal deviates from contract documents and does not indicate or note deviations.

A/E COMMENTS

◯ See attached sheet(s) for additional comments

1. Please flag correct item submitted and reference correct specification number 04 20 00.
2. Please carefully review specification section 04 20 00 and submit manufacturer's product documentation, samples, certifications and accessories as one package.

REVIEWED BY

6/15/16
DATE

77 Westport Plaza
Suite 250
St. Louis, MO 63146

TRANSMITTAL

No. 15051-0081

Paric Corporation

PROJECT: 15051-Webster University Interdisciplinary Science Building

DATE: 06/13/2016

TO: Cannon Design
1100 Clark Ave
St Louis MO 63102

RE: Masonry product data

ATTN: Kelvin Patel

JOB: 15051

WE ARE SENDING:	SUBMITTED FOR:	ACTION TAKEN:
☑ Shop Drawings	☑ Approval	☑ Approved as Submitted
☐ Letter	☐ Your Use	☐ Approved as Noted
☐ Prints	☐ As Requested	☐ Returned After Loan
☐ Change Order	☐ Review and Comment	☐ Resubmit
☐ Plans		☐ Submit
☐ Samples	**SENT VIA:**	☐ Returned
☐ Specifications	☐ Attached	☐ Returned for Corrections
☐ Other:	☐ Separate Cover Via:	☐ Due Date:

Item	*Package*	*Code*	*Rev.*	*Copies*	*Date*	*Description*	*Status*
Submittal		044300-007	1		06/13/2016	Masonry product data	Submitted

NOTES:

CC: Paric Corporation, Kathy Bathe

Project Coordinator: Paric Corporation, Kathy Bathe

Signed: _____
Devin Gates

TRANSMITTAL LETTER

Leonard Masonry, Inc.

5925 Fee Fee Road
St. Louis, MO 63042

Transmittal # **945-01**

Date: 6/10/2016
Phone: (314) 731-5500
Fax: (314) 731-3366

Project Name: Webster University Interdisciplinary Science Building **Project #:** 945

To: Paric Corporation
Attn: Devin Gates
77 Westport Plaza Drive
Suite 250
St. Louis, MO 63146

SUBJECT: Submittal 945-01, Rev #0 Masonry materials

Phone: (636) 561-9500 **Fax:** (636) 561-9501

Items listed are being sent
- ☑ Enclosed
- ☐ Under Separate Cover
- ☐ Via

We are transmitting the following to you:
- ☑ Product Data
- ☐ Samples
- ☑ Submittals: Submittal 945-01, Rev #0 Masonry materials
- ☐ Shop Drawings
- ☐ O & M Manuals
- ☐ Plans
- ☐ Architectural Drawings
- ☐ Letters
- ☐ Specifications
- ☐ Prints
- ☐ Addenda
- ☐ Engineering Drawings
- ☐ Change Order Requests
- ☐

Submittal: Masonry materials - Rev#0

Code/Spec	Copies	For	Product #	Summary Item
	1	Approval		Face brick test report
	1	Approval		Type N mortar certification
	1	Approval		Mortar color product data
	1	Approval		Veneer anchor product data
	1	Approval		Weep vent product data
	1	Approval		Cavity drainage material product data
	1	Approval		Termination bar product data
	1	Approval		Cavity-wall insulation product data
	1	Approval		Masonry cleaner product data

Remarks:

COPIES TO:

By: Ken Westhoff
Project Manager

Received by: _____ Date: _____