#2nd OPTION
DYNA-GUARD
800-821-5448

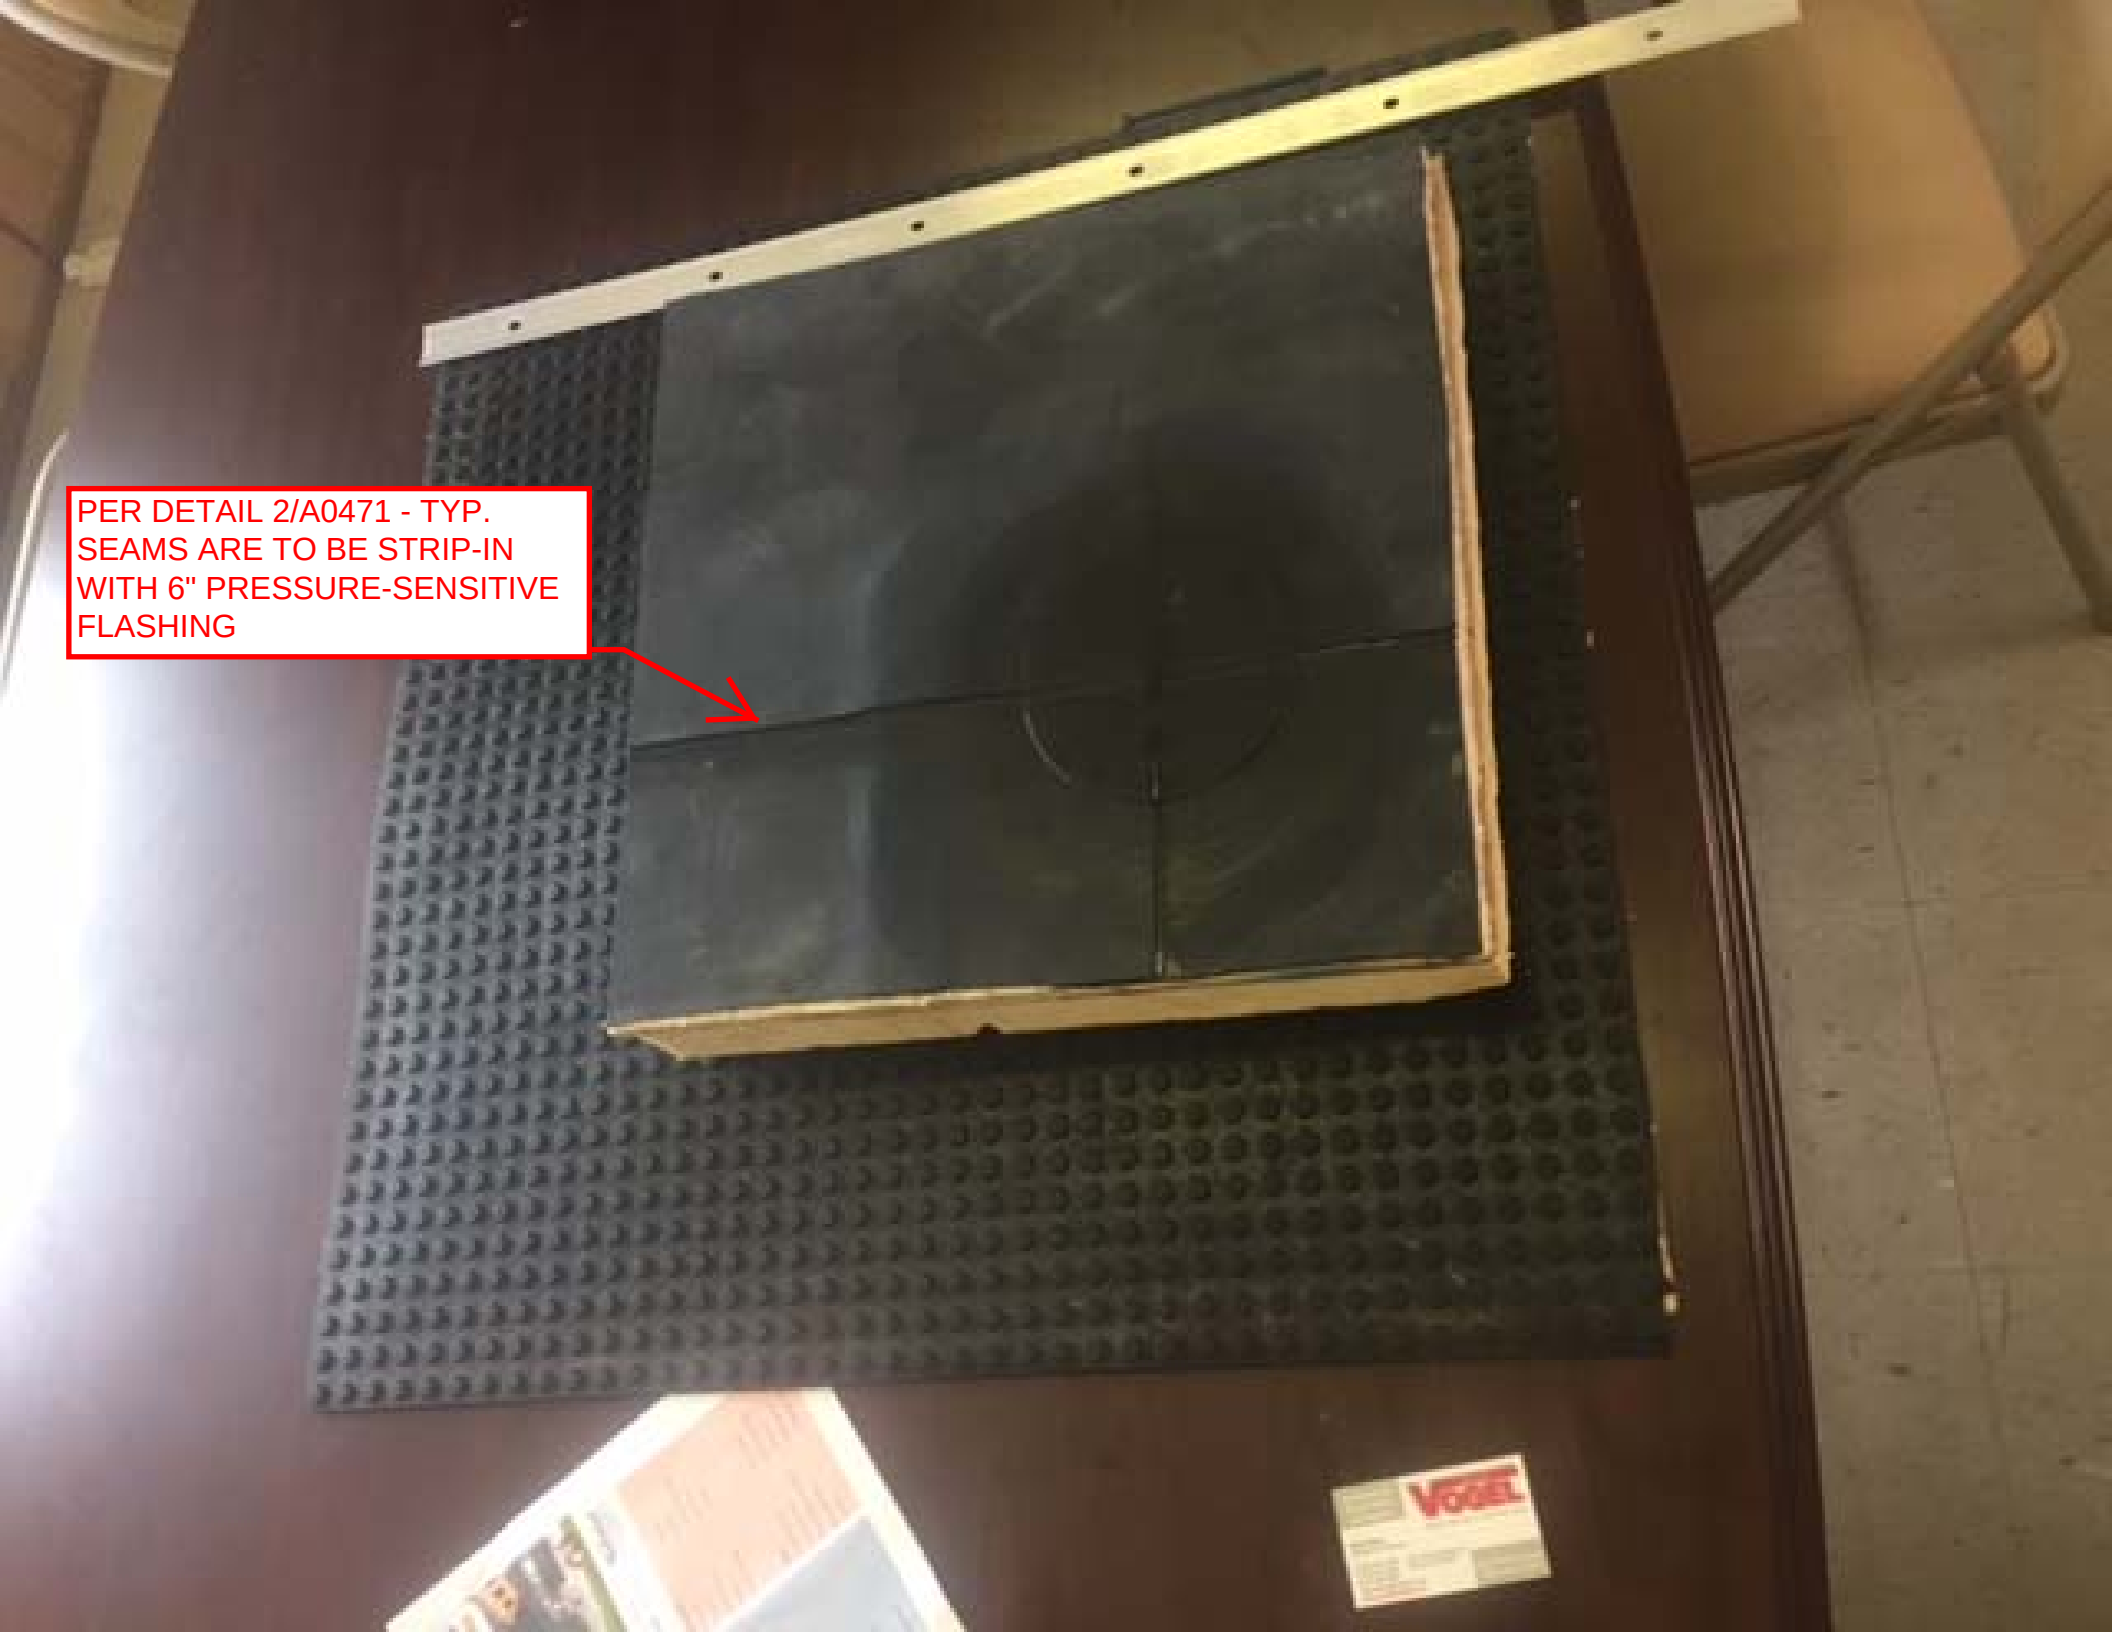
PER DETAIL 2/A0471 - TYP.
SEAMS ARE TO BE STRIP-IN
WITH 6" PRESSURE-SENSITIVE
FLASHING
VOGEL

CANNONDESIGN

SUBMITTAL IDENTIFICATION SHEET

To be completed by Contractor/CM

WEBSTER UNIVERSITY ISB
PROJECT NAME

8274 BIG BEND BLVD
ADDRESS

NUMBER

WEBSTER UNIVERSITY
OWNER

CANNON DESIGN
ARCHITECT / ENGINEER

DEVIN D GATES
SUBMITTED BY

075323-004
CONTRACTOR / CM SUBMITTAL NO.

CANNON DESIGN SUBMITTAL NO.

DRAWING / DETAIL REFERENCE

075323
SPECIFICATION SECTION / PARAGRAPH

MANUFACTURER / SUPPLIER

ITEM / PRODUCT ID

REQUIRED DATE

PRIORITY

◯ CRITICAL

ITEM BEING SUBMITTED (check only one)

- ◯ Shop Drawings
- ◯ Samples (_____ copies)
- ◯ LEED Submittal
- ◉ Certification / Qualifications
- ◯ Record Documents
- ◯ Product Data
- ◯ Coordination Drawing
- ◯ Calculations
- ◯ Schedules
- ◯ O&M Manuals
- ◯ Other _____

ITEM BEING SUBMITTED FOR (check only one)

◉ Action ◯ Information Only ◯ Record

REMARKS OR DEVIATIONS

Samples for the following
1. EPDM
2. 2 OPTIONS OF FASTENERS
3. INSULATION
4. FIBER ROOF BOARD
5. DRAINAGE MAT (GREEN ROOF)
couriered to Cannon's office 10/7/16

CONTRACTOR / CM CERTIFICATION
(SUBMITTALS NOT CERTIFIED WILL BE RETURNED WITHOUT REVIEW)

PARIC
PARIC CORPORATION
SUBMITTAL STAMP

THIS SHOP DRAWING HAS BEEN REVIEWED BY PARIC CORPORATION

Subcontractor remains responsible for dimensions, quantities, coordination with other trades and compliance with contract documents.

By:
Devin D. Gates

DEVIN D GATES — REVIEWED BY
10/7/16 — DATE

To be completed by Reviewer

07 5323-005
CANNON DESIGN SUBMITTAL NUMBER

10/7/16
RECEIVED DATE

- ◯ A. No Exceptions Taken
  No further review of submittal is required.
- ◉ B. Make Corrections Noted
  Incorporate corrections in work; resubmission is not required.
- ◯ C. Revise and Resubmit
  Revise as noted, and resubmit for review.
- ◯ D. Rejected
  Submittal is not in compliance with Contract Documents; provide new submittal.
- ◯ E. For Record / Information Only
  Submittal was reviewed for Record / Information purposes only.
- ◯ F. Not Required for Review
  Submittal is not required by Contract Documents and has not been reviewed.

Review is for conformance with the design concept of this project and for general compliance with contract documents. Contractor is responsible for quantities, dimensions and compliance with contract documents and for information that pertains to fabrication processes, construction techniques and coordination of this work with all trades which will be affected thereby. This review is null and void if submittal deviates from contract documents and does not indicate or note deviations.

A/E COMMENTS ◯ See attached sheet(s) for additional comments

All samples submitted are approved unless noted otherwise. See below - #2 option for the fasteners are approved, #1 option for fasteners are rejected. Per detail 2/A0471 all EPDM seams are to have 6" pressure-sensitive flashing applied over seams.

REVIEWED BY

10/11/2016
DATE