CANNONDESIGN

SUBMITTAL IDENTIFICATION SHEET

To be completed by Contractor/CM

WEBSTER UNIVERSITY ISB
PROJECT NAME

8274 BIG BEND BLVD
ADDRESS

NUMBER

WEBSTER UNIVERSITY
OWNER

CANNON DESIGN
ARCHITECT / ENGINEER

Joe Voypick
SUBMITTED BY

083113
CONTRACTOR / CM SUBMITTAL NO.

CANNON DESIGN SUBMITTAL NO.

DRAWING / DETAIL REFERENCE

083113
SPECIFICATION SECTION / PARAGRAPH

MANUFACTURER / SUPPLIER

ITEM / PRODUCT ID

REQUIRED DATE

PRIORITY

CRITICAL

ITEM BEING SUBMITTED (check only one)

- (•) Shop Drawings
- ( ) Samples (_____ copies)
- ( ) LEED Submittal
- ( ) Certification / Qualifications
- ( ) Record Documents
- ( ) Product Data
- ( ) Coordination Drawing
- ( ) Calculations
- ( ) Schedules
- ( ) O&M Manuals
- ( ) Other _____

ITEM BEING SUBMITTED FOR (check only one)

(•) Action ( ) Information Only ( ) Record

REMARKS OR DEVIATIONS

Proposed in RFI 502

CONTRACTOR / CM CERTIFICATION
(SUBMITTALS NOT CERTIFIED WILL BE RETURNED WITHOUT REVIEW)

PARIC

PARIC CORPORATION
SUBMITTAL STAMP

THIS SHOP DRAWING HAS BEEN REVIEWED BY PARIC CORPORATION

Subcontractor remains responsible for dimensions, quantities, coordination with other trades and compliance with contract documents.

By:
Devin D. Gates

Devin Gates
REVIEWED BY

3/30/17
DATE

To be completed by Reviewer

08 3113-001
CANNON DESIGN SUBMITTAL NUMBER

3/30/17
RECEIVED DATE

- ( ) A. No Exceptions Taken
  No further review of submittal is required.
- (•) B. Make Corrections Noted
  Incorporate corrections in work; resubmission is not required.
- ( ) C. Revise and Resubmit
  Revise as noted, and resubmit for review.
- ( ) D. Rejected
  Submittal is not in compliance with Contract Documents; provide new submittal.
- ( ) E. For Record / Information Only
  Submittal was reviewed for Record / Information purposes only.
- ( ) F. Not Required for Review
  Submittal is not required by Contract Documents and has not been reviewed.

Review is for conformance with the design concept of this project and for general compliance with contract documents. Contractor is responsible for quantities, dimensions and compliance with contract documents and for information that pertains to fabrication processes, construction techniques and coordination of this work with all trades which will be affected thereby. This review is null and void if submittal deviates from contract documents and does not indicate or note deviations.

A/E COMMENTS

( ) See attached sheet(s) for additional comments

VERIFY WITH WEBSTER UNIVERSITY IF LOCK & KEY ARE NEEDED.

THE ACCESS PANEL AT VESTIBULE C153 MIGHT NEED LOCK - CONFIRM WITH WEBSTER UNIVERSITY.

Kelvin Patel
Digitally signed by Kelvin Patel
DN: C=US, E=kpatel@cannondesign.com, O=Cannon Design, OU=Architect, CN=Kelvin Patel
Date: 2017.04.12 18:17:50-05'00'
REVIEWED BY

4/12/17
DATE

ACUDOR
www.acudor.com
U.S.A.: info@acudor.com / 800.722.0501
CANADA: info@acudor.ca / 844.228.3671
INTERNATIONAL: info@acudorintl.com
(905) 428.2240

DW-5040

FLUSH FOR DRYWALL

QTY.	NOMINAL SIZE	A	B	C	D	E	F	LATCH QTY
	6 x 6 (152 x 152)	6.00 (152)	6.00 (152)	8.57 (218)	8.57 (218)	6.12 (155)	6.12 (155)	1
	8 x 8 (202 x 203)	8.00 (202)	8.00 (202)	10.57 (268)	10.57 (268)	8.12 (206)	8.12 (206)	1
	10 x 10 (254 x 254)	10.00 (254)	10.00 (254)	12.57 (319)	12.57 (319)	10.12 (257)	10.12 (257)	1
	12 x 12 (305 x 305)	12.00 (305)	12.00 (305)	14.57 (370)	14.57 (370)	12.12 (308)	12.12 (308)	1
	14 x 14 (355 x 355)	14.00 (355)	14.00 (355)	16.57 (421)	16.57 (421)	14.12 (359)	14.12 (359)	1
	16 x 16 (406 x 406)	16.00 (406)	16.00 (406)	18.57 (472)	18.57 (472)	16.12 (409)	16.12 (409)	1
	18 x 18 (457 x 457)	18.00 (457)	18.00 (457)	20.57 (522)	20.57 (522)	18.12 (460)	18.12 (460)	1
	22 x 22 (560 x 560)	22.00 (560)	22.00 (560)	24.57 (624)	24.57 (624)	22.12 (562)	22.12 (562)	1
	24 x 24 (610 x 610)	24.00 (610)	24.00 (610)	26.57 (675)	26.57 (675)	24.12 (613)	24.12 (613)	1
	24 x 36 (610 x 914)	36.00 (914)	24.00 (610)	26.57 (675)	38.57 (980)	24.12 (613)	36.12 (917)	2
	30 x 30 (762 x 762)	30.00 (762)	30.00 (762)	32.57 (827)	32.57 (827)	30.12 (765)	30.12 (765)	2
	36 x 36 (914 x 914)	36.00 (914)	36.00 (914)	38.57 (980)	38.57 (980)	36.12 (917)	36.12 (917)	2

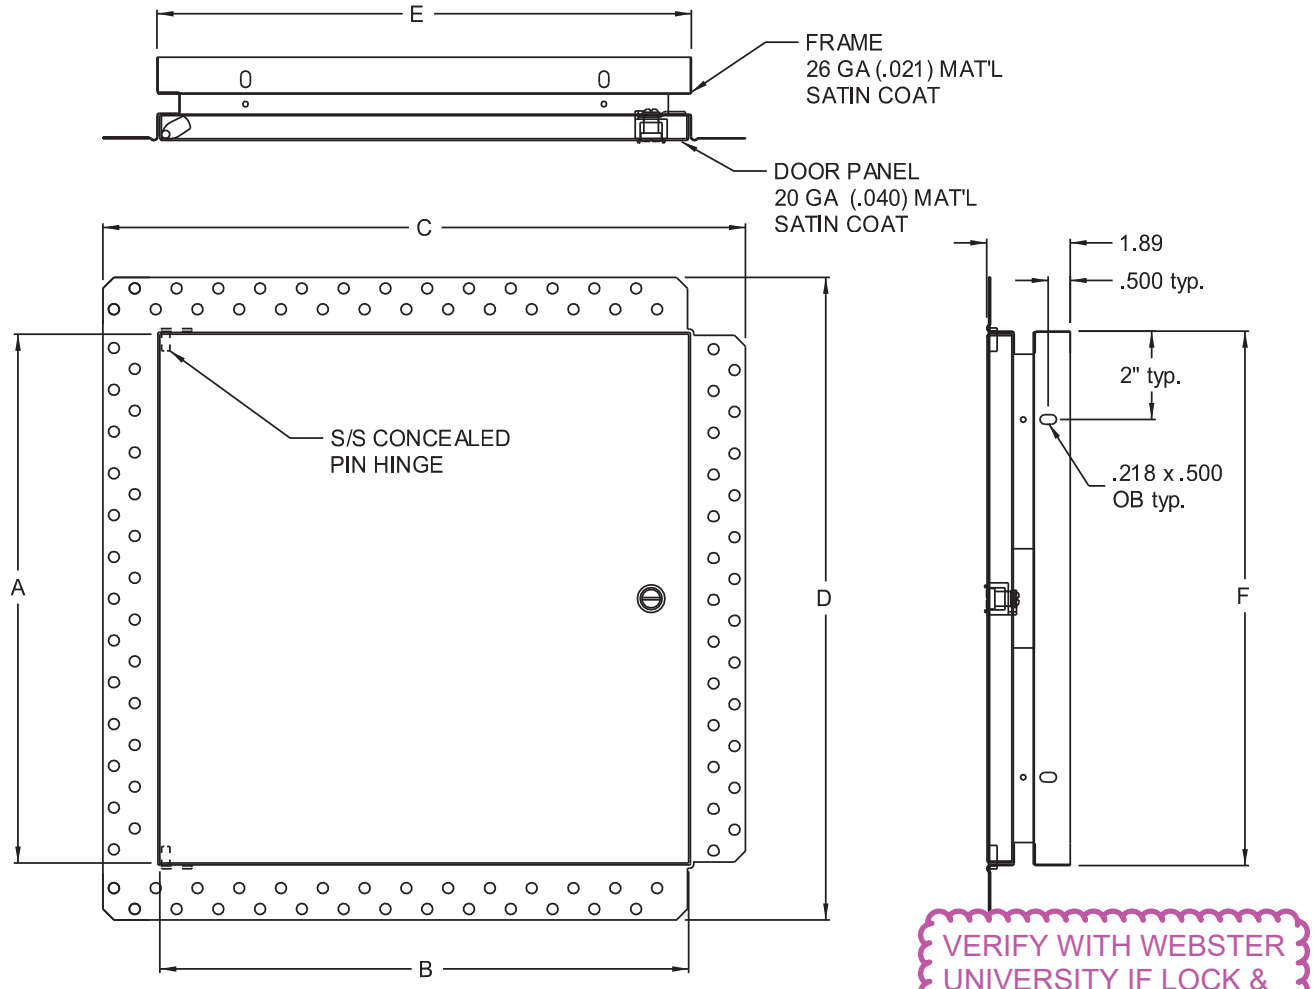

STANDARD FEATURES:

SCREW DRIVER OPERATED CAM LATCH
SATIN COAT STEEL; FORMED DOOR PANEL
WHITE BAKED ENAMEL FINISH
FLANGE FRAME PERFORATED; MILL FINISH

VERIFY WITH WEBSTER UNIVERSITY IF LOCK & KEY ARE NEEDED. ESPECIALLY AT THE VESTIBULE C153.

LOCK OPTIONS: ☐ CYLINDER LOCK AND KEY ☐ SPANNER HEAD LATCH ☐ TORX HEAD LATCH ☐ ALLEN HEAD LATCH

Can be provided with cylinder lock and key. Please advise.

JOB NAME:

CUSTOMER:

COPYRIGHT © 2016 ACUDOR PRODUCTS LTD. - ALL RIGHTS RESERVED