224HD Full Mortise Aluminum Geared Continuous Hinge

- Handing required when modified
- Door Edge Protector
- 48" Maximum Door Width
- 1/16" Door Inset
- Beveled or Square Edge Doors

For Doors Weighing up to 450 pounds without reinforcing, 600 pounds with reinforcing

Standard lengths 83", 85", 95", 120"
Standard Mounting Hardware
12-24 X 3/4" Steel Self Drilling, Self Tapping Screws
Optional WD - Wood Screws or SEC - Security Fasteners Available

Finishes

Clear (CL), Dark Bronze (DB)

Custom Anodizing and Painting are available, consult factory.

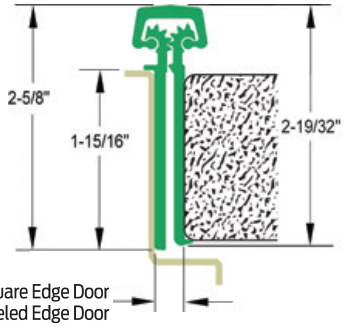

5/16" Clearance for Square Edge Door
1/32" Clearance For Beveled Edge Door

Confirm EPT cutout should be at 23 7/8"

EPT 112HD

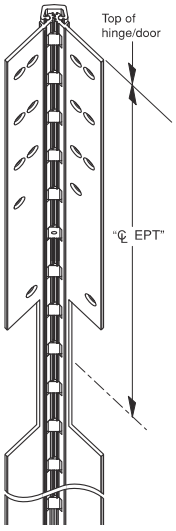

EPT 224HD

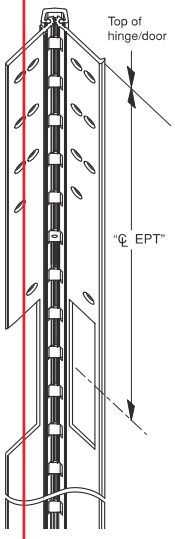

TW 112HD 224HD

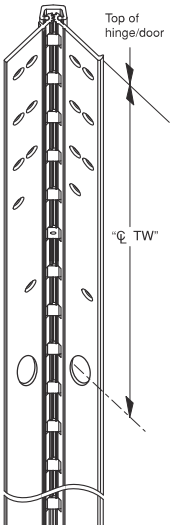

Note: See ordering guide in price book for proper placement.

Electrical Cutouts

Ives Aluminum Geared Continuous Hinges are available with factory modified cutouts to accommodate most electrical frame to door requirements. Special templates are required.

When ordering indicate the following:
1. Opening size.
2. Handing. LH, RH, RHR or LHR.
3. Manufacturer and model number of the electrical product being used. Example; Von Duprin EPT2

Because clearances may vary between door and frame manufacturer, and locations can be influenced by the door hardware it is always recommend contacting Ives Customer Technical for specific template information.

For your general information below are standard locations for Von Duprin EPT2 or EPT10, and monitor switch.

From Top Edge of Door to Center Line of Cut-Out

Standard Length	112HD EPT	224HD EPT	112HD/224HD TW
83"	30"	30"	41-1/2"
85"	32"	32"	42-1/2"
95"	42"	42"	57-3/4"
120"	67"	67"	81-25/32"

TWP option centered in hinge.

CANNONDESIGN

SUBMITTAL IDENTIFICATION SHEET

To be completed by Contractor/CM

WEBSTER UNIVERSITY ISB
PROJECT NAME

8274 BIG BEND BLVD
ADDRESS

NUMBER

WEBSTER UNIVERSITY
OWNER

CANNON DESIGN
ARCHITECT / ENGINEER

DEVIN D GATES
SUBMITTED BY

087100.01-001
CONTRACTOR / CM SUBMITTAL NO.

CANNON DESIGN SUBMITTAL NO.

DRAWING / DETAIL REFERENCE

087100.01
SPECIFICATION SECTION / PARAGRAPH

MANUFACTURER / SUPPLIER

ITEM / PRODUCT ID

REQUIRED DATE

PRIORITY

○ CRITICAL

ITEM BEING SUBMITTED (check only one)

○ Shop Drawings	○ Certification / Qualifications	○ Coordination Drawing
○ Samples (_____ copies)	◉ Record Documents	○ Calculations
○ LEED Submittal	○ Product Data	○ Schedules
		○ O&M Manuals

○ Other _____

ITEM BEING SUBMITTED FOR (check only one)

◉ Action ○ Information Only ○ Record

REMARKS OR DEVIATIONS

CONTRACTOR / CM CERTIFICATION
(SUBMITTALS NOT CERTIFIED WILL BE RETURNED WITHOUT REVIEW)

PARIC

PARIC CORPORATION
SUBMITTAL STAMP

THIS SHOP DRAWING HAS BEEN REVIEWED BY PARIC CORPORATION

Subcontractor remains responsible for dimensions, quantities, coordination with other trades and compliance with contract documents.

By:
Devin D. Gates

DEVIN D GATES — 10/31/16
REVIEWED BY — DATE

To be completed by Reviewer

08 7100.01-001
CANNON DESIGN SUBMITTAL NUMBER

10/31/16
RECEIVED DATE

○ A. No Exceptions Taken
No further review of submittal is required.

◉ B. Make Corrections Noted
Incorporate corrections in work; resubmission is not required.

○ C. Revise and Resubmit
Revise as noted, and resubmit for review.

○ D. Rejected
Submittal is not in compliance with Contract Documents; provide new submittal.

○ E. For Record / Information Only
Submittal was reviewed for Record / Information purposes only.

○ F. Not Required for Review
Submittal is not required by Contract Documents and has not been reviewed.

Review is for conformance with the design concept of this project and for general compliance with contract documents. Contractor is responsible for quantities, dimensions and compliance with contract documents and for information that pertains to fabrication processes, construction techniques and coordination of this work with all trades which will be affected thereby. This review is null and void if submittal deviates from contract documents and does not indicate or note deviations.

A/E COMMENTS ◉ See attached sheet(s) for additional comments

SEE MARKUP

SEE LETTER ON FOLLOWING PAGE

Lynn Grossman — Digitally signed by Lynn Grossman DN: C=US, E=lgrossman@cannondesign.com, O=Cannon Design, CN=Lynn Grossman Date: 2016.12.05 18:32:59-06'00' — 12.05.16
REVIEWED BY — DATE

Allegion, PLC
6810 Hillsdale Ct.
Indianapolis, IN 46250 USA
Office 877.238.2022 Fax 317.715.4055
allegion.com

Submittal Review
Specification Section: 087100 Door Hardware

Date: 11/10/2016

Project: Webster University - ISB
Webster, MO

Firm: Cannon Design
Attn: Kelvin Patel
1100 Clark Ave
St. Louis, MO 63102
(314) 425-8756

Kelvin,

I have reviewed this submittal for the door hardware per specification section 087100. This review is for specification compliance based on the specifications submitted to you for the above referenced project. I did not review for doors and frames and nor did I respond to any questions or comments regarding doors and frames. The Contractor remains responsible for the accuracy and completeness of submittal including, but not limited to, dimensions, quantities, fabrication, and construction techniques. General Conditions of contract documents apply.

You will need to review the door and frame submittal for compliance based on your plans, door schedule, and door/frame elevations. If any changes were made through addenda or RFI please update my comments appropriately.

Submittal Action:
Door Hardware Submittal dated 10/31/16 - Reviewed / Reviewed As Noted

Submittal Notes/Comments:
- Revise all closers to 4010/4110 DEL series per email revision
- Provide Exit Devices with NL-OP trim where specified versus the submitted NL trim

Door Hardware Submittal–
Note: The general comments are listed to save time for repetitious items, comments, and/or concerns. The specific comments listed for individual headings are subject to the general comments listed below.

1. General:
   a. I did not review submittal for handing.
   b. Operational Description: Operational Description, of openings with electrified hardware, needs to be included in the door hardware schedule. [Reference Section 087100, Article 1.3.C.3.]

Please remind the contractor to coordinate the hardware being supplied by the Aluminum Door supplier with the hardware from this package. The hardware for aluminum doors is specified in Section 087100. This submittal references aluminum hardware as “by others”. All the hardware is required to be of the same manufacturer and model and meet the requirements of Section 087100.

✓ Single Source Responsibility: Obtain each type of hardware (ie. latch and locksets, hinges, exit devices, closers, etc.) from a single manufacturer. [Reference Section 087100, Article 1.4.D.]

The door hardware specification includes some project controls to assist in a smooth project. Please remind the general contractor of the following specification items in Section 087100:

- ✓ Article 1.3.C.3.I.3. Riser and Wiring Diagram – Please advise hardware supplier to provide riser and (point-to-point) Wiring Diagrams per approved finish hardware schedule.
- ✓ Articles 1.3.D. and 2.6. Keying – Please advise the hardware supplier to schedule and complete the keying conference prior to ordering hardware to avoid issues with keying or lock functions.
- ✓ Articles 1.6. and 1.7. Coordination – Please advise general contractor to schedule pre-installation, installation coordination, and electrified hardware coordination conferences prior to installation of any finish hardware.

Also, put the following items on the check-list at project completion time:

- ✓ Article 3.1 Installation
- ✓ Articles 3.1.L and 3.2 Adjustment and Field Inspections

As a reminder the following services are available to you for this project:

- ✓ Provide product training to installers.
- ✓ Assist you with “Jobsite Inspection” and creation of a detailed punch-list.
- ✓ Provide product training to owner.

Please review and contact us at the above telephone number or via email at aaron.owens@allegion.com with any questions or if you need further assistance. Thank you for your time and allowing me to follow up on this project.

Sincerely,

Aaron Owens

<Aaron Owens>