

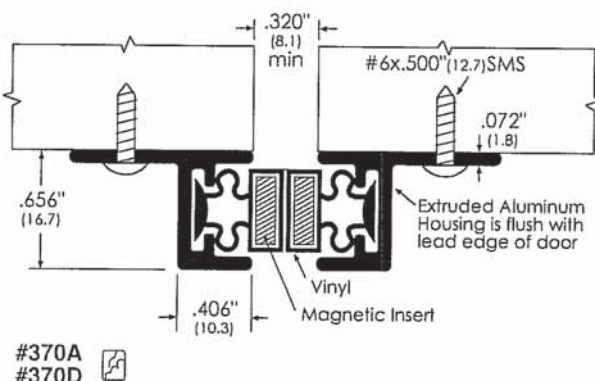
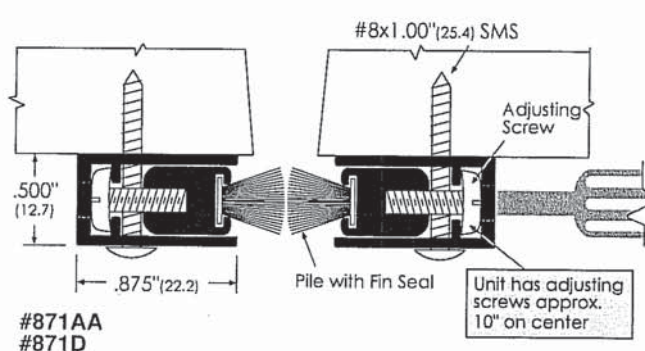
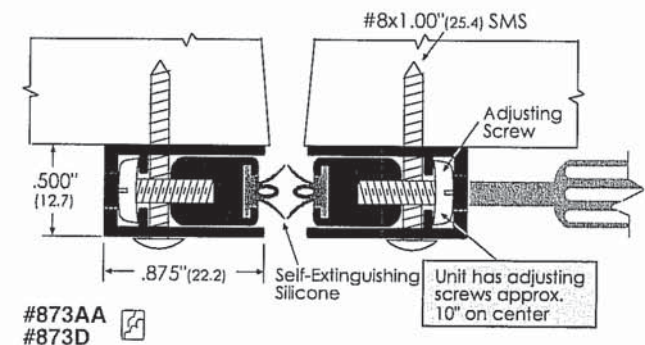
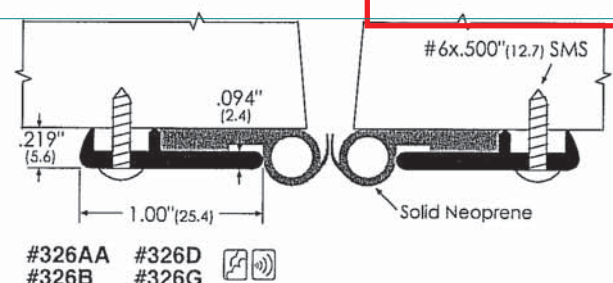
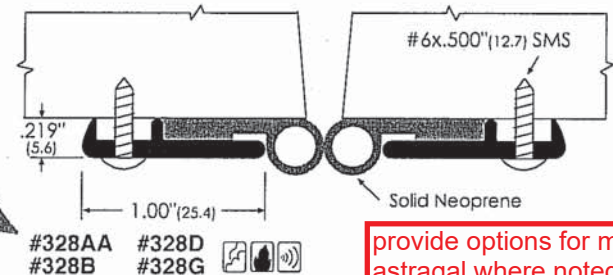
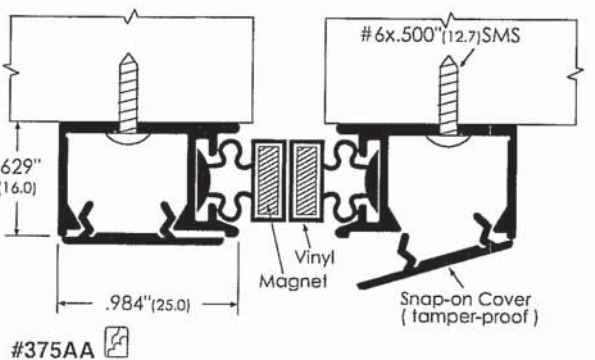
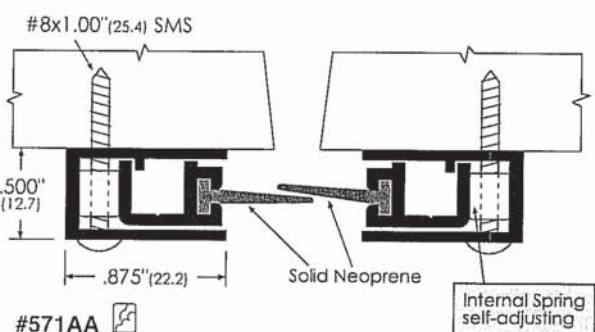
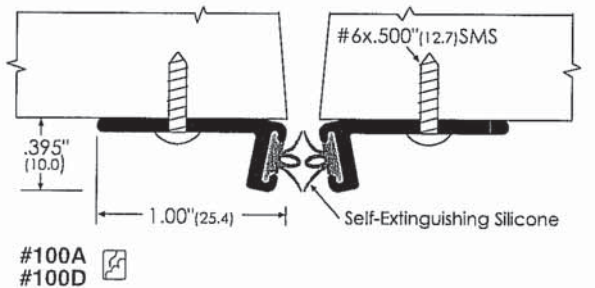


Meeting Stiles - Both Doors Active

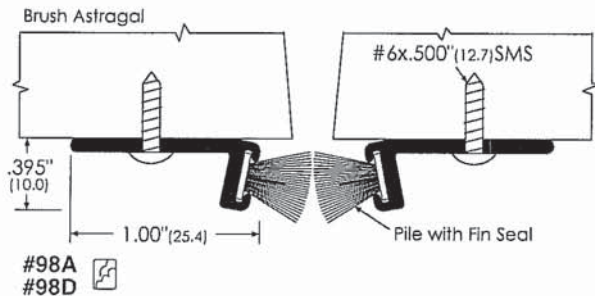

Note: A = Aluminum
B = Bronze
G = Gold Anodized
AA = Clear Anodized
D = Dr. Bronze Anodized

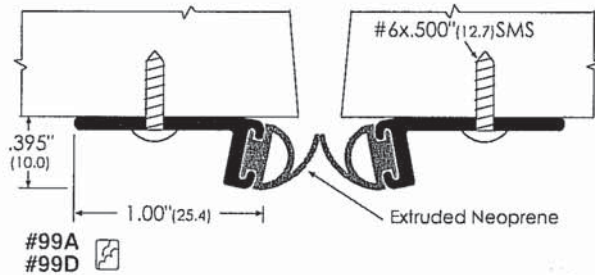

provide options for mortised astragal where noted (most locations) on hardware schedule

Meeting Stiles

Hardware

Manufacturer's

Accurate Lock, Doug Mockett, Glynn Johnson,
Ives, LCN, Brio, Schlage, Von Duprin, Zero

Hardware Finish

32D Satin Stainless Steel, 26D Satin Chrome,
Aluminum



PARIC
EXPERIENCE. EXCELLENCE.

77 Westport Plaza
Suite 250
St. Louis, MO 63146

TRANSMITTAL

No. 15051-0222

Paric Corporation

PROJECT: 15051-Webster University Interdisciplinary Science Building

DATE: 09/12/2016

TO: Cannon Design
1100 Clark Ave
St Louis MO 63102

RE: Hardware Product Data

ATTN: Kelvin Patel

JOB: 15051

WE ARE SENDING:	SUBMITTED FOR:	ACTION TAKEN:
☐ Shop Drawings	☒ Approval	☐ Approved as Submitted
☐ Letter	☐ Your Use	☐ Approved as Noted
☐ Prints	☐ As Requested	☐ Returned After Loan
☐ Change Order	☐ Review and Comment	☐ Resubmit
☐ Plans		☐ Submit
☐ Samples	SENT VIA:	☐ Returned
☐ Specifications	☐ Attached	☐ Returned for Corrections
☒ Other: Product Data	☐ Separate Cover Via:	☐ Due Date:

Item	Package	Code	Rev.	Copies	Date	Description	Status
Submittal		087100.03-002	1		09/12/2016	Hardware Product Data	Submitted

NOTES:

CC:

Signed: _____

Devin Gates