SUBMITTAL: 1400 SERIES AED CABINET

Description: 1400 Series is designed to accommodate all Automated External Defibrillators (AED's) on the market today, with all except surface-mounted models, ADAC-Compliant . Select from steel, stainless steel or aluminum construction.

Trim Construction: #4 brushed stainless steel, clear anodized aluminum or CRS with white powder-coat finish. 1-3/4" trim on face and 1-1/4" trim on door.
Door: Formed door with 1-1/4" or 1-1/2" trim, mounted in a 5/8" door stop with zinc-plated handle and roller catch and continuous hinge. F and G styles include graphics on acrylic glazing as shown at right, other door styles include AED decal. Theft-deterrent SAF-T-LOK™ available for all door styles.
Alarm: 85 db Commander (audible) alarm standard.
Trim Style & Depth: *Recessed* – 3/8" flat trim, *Semi*-Recessed – 1-1/2" square edge or 3" rolled edge. *Surface-mount* has a square edge.
Tub: White powder-coated CRS except for aluminum and stainless surface-mounted models. Fire-rated available - See Separate Submittal

1413F12SA " Surface-Mounted Cabinet With

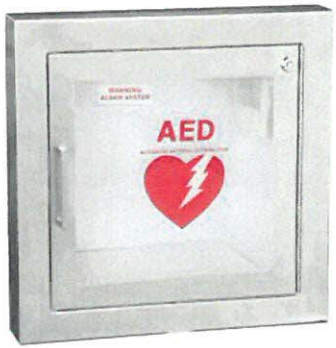

1436F12 Semi-Recessed Cabinet in Stainless Steel with 1-1/2" Square Trim

BIM MODELS FOR REVIT DOWNLOAD HERE

STEP 1: SELECT MODEL NUMBER AND QUANTITY ON CHART (refer to chart on page 2)
A. Determine Trim Style according to wall depth. **B.** Determine Tub I.D. according to size most suited for extinguisher and wall opening.

STEP 2: SELECT DOOR STYLE Check one box below

- [x] **F12** Full Acrylic Glazing; Pull & AED Graphics
- [ ] **F17** Full Tempered Glazing; Pull & AED Decal
- [ ] **G12** Full Glazing; Acrylic, SAF-T-LOK™, Pull & AED Graphics
- [ ] **G17** Full Glazing; Tempered, SAF-T-LOK™, Pull & AED Decal
- [ ] **D12** Horizontal Duo Panel; Acrylic, Pull & AED Decal
- [ ] **D17** Horizontal Duo Panel; Tempered, Pull & AED Decal
- [ ] **E12** Horizontal Dual Panel; Acrylic, SAF-T-LOK™, Pull & AED Decal
- [ ] **E17** Horizontal Dual Panel; Tempered, SAF-T-LOK™, Pull & AED Decal
- [ ] **S21** Solid Door; Pull & AED Decal
- [ ] **L22** Solid; SAF-T-LOK™, Pull & AED Decal
- [ ] **V12** Vertical Duo; Acrylic Glazing, Pull & AED Decal
- [ ] **V17** Vertical Duo; Tempered Glass, Pull & AED Decal
- [ ] **W12** Vertical Duo; Acrylic, SAF-T-LOK™, Pull & AED Decal
- [ ] **W17** Vertical Duo; Tempered, SAF-T-LOK™, Pull & AED Decal

NOT REQUIRED. CONFIRM WITH WEBSTER UNIVERSITY.

Optional Features at Additional Cost:

- [x] **(SA)** Siren Strobe Alarm and 85 db Alarm (3" Trim & Surface-Mount Models Only)
- [ ] **(STC)** Saf-T-Clasp for Visual Notification When Door has been opened
- [ ] Custom Door Graphics available—company logos, photos, etc. Contact C. S.
- [ ] AED Wall Signs ____ 14S ____ 14TX ____ 14XS - See Separate Submittal
- [ ] Optional Colors View Optional Colors Online Contact Customer Service
- [ ] Optional Anodized Aluminum Finishes - View Finishes Online (Pulls to match)
- [ ] Optional Stainless Steel Finishes View Finishes Online
- [ ] Optional Rolled Edge Surface Mount (1419) (1439)
- [ ] Bronze or Brass Finish Contact Cust. Service (Pulls to match)
- [ ] **(14MAG)** Magnetic Door Contact for Existing Alarm Systems
- [ ] **(14RR)** Roller Reed Ball Contact for Existing Alarm Systems
- [ ] Custom Colors (Provide Paint Chip) Contact Customer Service
- [ ] Optional Tub Color: ___ Black ____Red
- [ ] Optional Tub Material ___ Stainless ___ Aluminum
- [ ] Etched, Silkscreen or Engraved Lettering Complete Attachment
- [ ] Recessed Pull, Lever Handle

JL INDUSTRIES

ACTIVAR INC. www.activarcpg.com Construction Products Group

Distributor: Fire Safety, Inc.	Quantity: 4
Contractor: PARIC Corporation	Approved By:
Model #: 1417F12SA	Architect: Cannon Design
Project: Webster ISB	Date: 4/21/2017

SUBMITTAL: 1400 SERIES AED CABINET

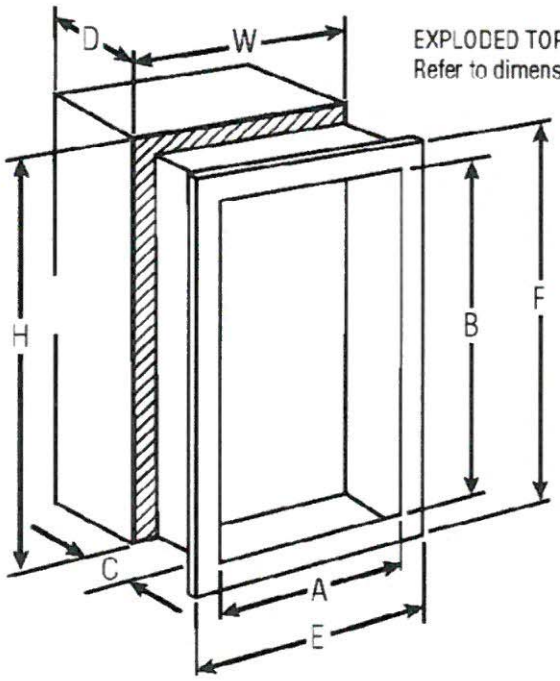

EXPLODED TOP & SIDE VIEWS
Refer to dimensions table

1417 3" Rolled Edge Recessed

1419SA with Custom Graphics & Optional Color

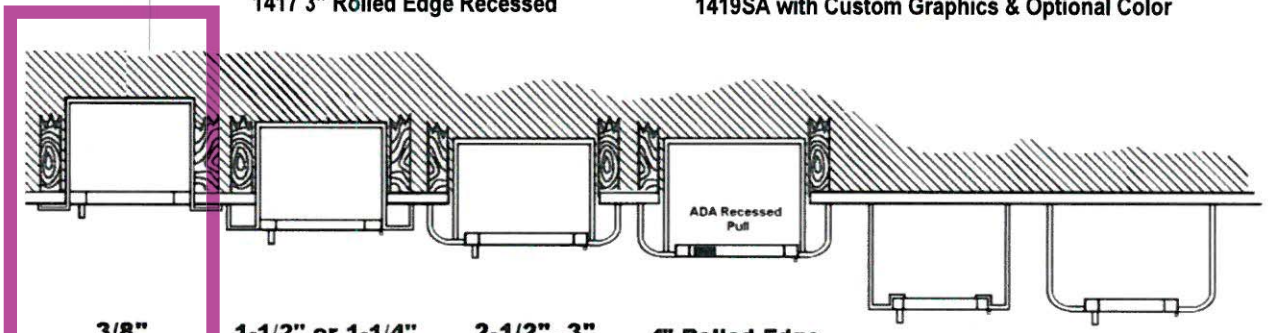

3/8" Flat Trim | 1-1/2" or 1-1/4" Square Trim | 2-1/2", 3" Rolled Edge | 4" Rolled Edge with ADA Pull | Surface Mount Square Trim | Surface Mount Opt. Rolled Edge

AED Decal 4-1/2" x 1":

TRIM & DOOR MATERIAL & SERIES #							TUB I.D.			FRAME O.D.		WALL OPENING		
QTY	STEEL	QTY	ALUMINUM	QTY	STAINLESS STEEL	TRIM STYLE	A	B	C	E	F	W	H	D
	1415		1425		1435	3/8" Flat Trim	14"	14"	6-3/4"	17-3/8"	17-3/8"	15-1/4"	15-1/4"	6-1/2"
	1416		1426		1436	1-1/2" Square	14"	14"	6-3/4"	17-3/8"	17-3/8"	15-1/4"	15-1/4"	5-7/8"
	1417		*1427		1437	3" or 2-1/2" Rolled	14"	14"	6-3/4"	17-3/8"	17-3/8"	15-1/4"	15-1/4"	3-3/4"
	1413 Sq Edge		1423 Sq. Edge		—	Surface Mounted	17-3/16"	17-3/16"	7"	17-3/8"	17-3/8"	–	–	–
	1419 Rolled Edge		—		1439 Rolled Edge	Surface Mounted	17-3/16"	17-3/16"	7"	17-3/8"	17-3/8"	–	–	–

* Model 1427 has 2-1/2" Trim & Requires 5/8" Deeper Wall Opening

CANNONDESIGN

SUBMITTAL IDENTIFICATION SHEET

To be completed by Contractor/CM

WEBSTER UNIVERSITY ISB
PROJECT NAME

8274 BIG BEND BLVD
ADDRESS

NUMBER

WEBSTER UNIVERSITY
OWNER

CANNON DESIGN
ARCHITECT / ENGINEER

Joe Voypick
SUBMITTED BY

104313-001
CONTRACTOR / CM SUBMITTAL NO.

CANNON DESIGN SUBMITTAL NO.

DRAWING / DETAIL REFERENCE

104313
SPECIFICATION SECTION / PARAGRAPH

MANUFACTURER / SUPPLIER

ITEM / PRODUCT ID

REQUIRED DATE

PRIORITY

CRITICAL

ITEM BEING SUBMITTED (check only one)

- ○ Shop Drawings
- ○ Samples (_____ copies)
- ○ LEED Submittal
- ○ Certification / Qualifications
- ○ Record Documents
- ◉ Product Data
- ○ Coordination Drawing
- ○ Calculations
- ○ Schedules
- ○ O&M Manuals
- ○ Other _____

ITEM BEING SUBMITTED FOR (check only one)

◉ Action ○ Information Only ○ Record

REMARKS OR DEVIATIONS

CONTRACTOR / CM CERTIFICATION
(SUBMITTALS NOT CERTIFIED WILL BE RETURNED WITHOUT REVIEW)

PARIC

PARIC CORPORATION
SUBMITTAL STAMP

THIS SHOP DRAWING HAS BEEN REVIEWED BY PARIC CORPORATION

Subcontractor remains responsible for dimensions, quantities, coordination with other trades and compliance with contract documents.

By:
Devin D. Gates

Joe Voypick
REVIEWED BY

5/11/17
DATE

To be completed by Reviewer

10 4313-001
CANNON DESIGN SUBMITTAL NUMBER

5/12/17
RECEIVED DATE

- ○ A. No Exceptions Taken
  No further review of submittal is required.
- ◉ B. Make Corrections Noted
  Incorporate corrections in work; resubmission is not required.
- ○ C. Revise and Resubmit
  Revise as noted, and resubmit for review.
- ○ D. Rejected
  Submittal is not in compliance with Contract Documents; provide new submittal.
- ○ E. For Record / Information Only
  Submittal was reviewed for Record / Information purposes only.
- ○ F. Not Required for Review
  Submittal is not required by Contract Documents and has not been reviewed.

Review is for conformance with the design concept of this project and for general compliance with contract documents. Contractor is responsible for quantities, dimensions and compliance with contract documents and for information that pertains to fabrication processes, construction techniques and coordination of this work with all trades which will be affected thereby. This review is null and void if submittal deviates from contract documents and does not indicate or note deviations.

A/E COMMENTS ○ See attached sheet(s) for additional comments

PROVIDE RECESSED - 3/8" FLAT TRIM STYLE TO MATCH WITH FIRE EXTINGUISHER CABINETS.

SEE MARKUPS.

Kelvin Patel
Digitally signed by Kelvin Patel
DN: C=US, E=kpatel@cannondesign.com, O=Cannon Design, OU=Architect, CN=Kelvin Patel
Date: 2017.05.26 11:46:25-05'00'
REVIEWED BY

5/26/17
DATE

77 Westport Plaza
Suite 250
St. Louis, MO 63146

TRANSMITTAL

No. 15051-0574

Paric Corporation

PROJECT: 15051-Webster University Interdisciplinary Science Building

DATE: 05/11/2017

TO: Cannon Design
1100 Clark Ave
St Louis MO 63102

Fax;
314-241-2203

RE: AED cabinet product data

ATTN: Kelvin Patel

JOB: 15051

WE ARE SENDING:	SUBMITTED FOR:	ACTION TAKEN:
☐ Shop Drawings	☐ Approval	☐ Approved as Submitted
☐ Letter	☐ Your Use	☐ Approved as Noted
☐ Prints	☐ As Requested	☐ Returned After Loan
☐ Change Order	☐ Review and Comment	☐ Resubmit
☐ Plans		☐ Submit
☐ Samples	**SENT VIA:**	☐ Returned
☐ Specifications	☐ Attached	☐ Returned for Corrections
☑ Other: Product Data	☐ Separate Cover Via:	☑ Due Date: 01/12/2017

Item	*Package*	*Code*	*Rev.*	*Copies*	*Date*	*Description*	*Status*
Submittal		104313-001	1		05/11/2017	AED cabinet product data	Submitted

NOTES:

CC:

Signed: _____

EVAN FOX