

SUBMITTAL: AMBASSADOR™ STEEL FIRE EXTINGUISHER CABINETS

PAGE 1 OF 2

The Ambassador Series is a Durable, Attractive Steel Cabinet with Powder-coat Finish that Stands up to Conditions in Commercial Buildings.

Door & Trim Construction: Cold rolled steel with white powder-coated finish standard. Flush cabinet doors with a 5/8" door stop are attached by a continuous hinge and equipped with zinc-plated handle and roller catch. All models have 1-3/4" wide trim on frame and 1-1/4" trim on doors with glazing.

Trim Style & Depth: *Trimless Recessed* - See Separate Submittal. Recessed Flat 3/8" Trim, *Semi Recessed* - 1-1/4", 1-1/2" Square Edge or 2-1/2", 3", 4", 4-1/2" Rolled Edge (4" has recessed ADAC pull). *Surface-mount* models have a square edge or optional rolled edge upon request.

Tub: The tub is constructed of cold rolled steel with white powder-coat finish standard.

Fire-Rated Option Available: Yes - [See separate Submittal Form](#).

PROVIDE FIRE-RATED CABINETS PER SPECIFICATION 104413, 2.2, B AT FIRE-RATED PARTITIONS.

STEP 1: SELECT MODEL NUMBER AND QUANTITY ON CHART (refer to chart on page 2)

A. Determine Trim Style according to wall depth.

B. Determine Tub I.D. according to size most suited for extinguisher and wall opening.

STEP 2: SELECT DOOR STYLE WITH HANDLE

Check one box below Examples on Page 2

- | | |
|---|--|
| ☐ F Full Glazing in 1-1/4" wide Frame | ☐ L22 Solid with SAF-T-LOK™ |
| ☐ G Full Glazing with SAF-T-LOK™ in 1-1/4" Frame | ☐ L24 Solid with Cylinder Lock - No Handle |
| ☐ D Horizontal Duo Panel | ☐ V Vertical Duo |
| ☐ E Horizontal Dual Panel with SAF-T-LOK™ | ☒ W Vertical Duo with SAF-T-LOK™ |
| ☐ S21 Solid Door | ☐ B Solid with 2" x 4" View Window & SAF-T-LOK™ |

CONFIRM IF SAF-T-LOK IS ACCEPTABLE WITH WEBSTER UNIVERSITY

STEP 3: SELECT DOOR GLAZING

(Check one box below)

- | | | |
|---|--|--|
| ☒ 10 Clear Acrylic | ☐ 15 Bronze Acrylic | ☐ 17 Clear Tempered Glass |
| ☐ 13 Wire Glass with Safety Film | ☐ 16 Gray Acrylic | ☐ 18 Laminated Safety Glass |

1012W10
4" Rolled Trim with
Standard ADA Pull

[BIM Objects for REVIT® Platform](#)

STEP 4: OPTIONAL FEATURES AT ADDED COST (SELECT ANY)

- | | | | |
|---|---|--|---|
| ☐ Optional Tub Color: ___ Black ___ Red | ☐ Black Vertical FE Letters LDCVBFE | ☐ Black Vertical Decal LDVBFE | ☐ (CA) Commander Alarm |
| ☐ Futura "Fire" Pull ___ Mill Alum ___ Red ___ White | ☒ Red Vertical FE Letters LDCVRFE | ☐ Red Vertical Decal LDVRFE | ☐ (BA) Brigadier Alarm |
| ☐ ADAC Flush Pull Handle | ☐ White Vertical FE Letters LDCVWFE | ☐ White Vertical Decal LDVWFE | ☐ (SA) Strobe Alarm (Surface Mount Models) |
| ☐ Polished Chrome Handle (PUCH) | ☐ Black Horizontal FE Letters LDCHBFE | ☐ Black Horizontal Decal LDHBFE | ☐ Etched/Engraved Lettering in Glass or Metal- Attach Sub. |
| ☐ Optional Colors: ___ Red ___ Black ___ Flat Black | ☐ Red Horizontal FE Letters LDCHRFE | ☐ Red Horizontal Decal LDHRFE | ☐ Rolled Edge Surface Mount- See Separate Submittal |
| ___ Sand ___ AMS Beige ___ SC Flat Beige | ☐ White Horizontal FE Letters LDCHWFE | ☐ White Horizontal Decal LDHWFE | ☐ Optional Lock for G, E, W, L22, B: _____ |
| ___ Gray ___ Bronze ___ Silver | | | |

For More Information on Options See Other Submittals: [Handles & Levers](#) [Decals/Die Cuts & Wall Signs](#) [More Alarm Information](#)




 ACTIVAR INC. CONSTRUCTION PRODUCTS GROUP AMBASSADOR™ IS A TRADEMARK OF ACTIVAR DOWNLOAD CURRENT SUBMITTAL BEFORE ORDERING	Distributor: Fire Safety, Inc.	Quantity: 19
	Contractor: PARIC Corporation	Approved By:
	Model #: 1015W10	Architect: Cannon Design
	Project: Webster ISB	Date: 4/21/2017 © Activar Construction Products Inc 2016

HEADQUARTERS & JL INDUSTRIES: 4450 WEST 78TH ST CIRCLE, BLOOMINGTON, MN 55435-5416 PH: 800-554-6077 FAX: 952-835-2218 EMAIL: SALES@ACTIVARCPG.COM WWW.ACTIVARCPG.COM
ACPG WEST COAST/SAMSON: COMMERCE, CA • WARE HOUSES: FT MYERS FL, ATLANTA GA, DALLAS TX, SEATTLE WA, LANCASTER PA, FARGO ND, OMAHA NE 1/5/2016

SUBMITTAL: AMBASSADOR STEEL FIRE EXTINGUISHER CABINETS

PAGE 2 OF 2

TRIM & DOOR SERIES #			Tub I.D.			Frame O.D.		Wall Opening			Fits Extinguishers View Submittal
QTY	Model	Trim Style	A	B	C	E	F	W	H	D	
	8115	Flat 3/8" Trim •	9	18	5 1/2	12 3/8	21 3/8	10	19	5 3/8	Cosmic & Galaxy 2 1/2-6, Mercury 2 1/2- 5
	8116	1 1/2 Square •	9	18	5 1/2	12 3/8	21 3/8	10	19	4 1/8	
	8117	2 1/2 Rolled •	9	18	5 1/2	12 3/8	21 3/8	10	19	3 1/8	
	8113	Surf. Mtd Sq	12 3/16	21 3/16	6	12 3/8	21 3/8	—	—	—	
	1710	2-1/4 Square •	10 1/2	24	5	13 7/8	27 3/8	11 1/2	25	3	
	1815	Flat 3/8" Trim •	10 1/2	24	5 1/2	13 7/8	27 3/8	11 1/2	25	5 3/8	Cosmic & Galaxy 2 1/2-6 Mercury 2 1/2-5
	1816	1 1/2 Square •	10 1/2	24	5 1/2	13 7/8	27 3/8	11 1/2	25	4 1/8	
	1817	3 Rolled •	10 1/2	24	5 1/2	13 7/8	27 3/8	11 1/2	25	2 5/8	
	1812	4 Rolled/ADA Pull •	10 1/2	24	5 1/2	13 7/8	27 3/8	11 1/2	25	1 5/8	
	1818	4 1/2 Rolled	10 1/2	24	5 1/2	13 7/8	27 3/8	11 1/2	25	1 1/8	
19	1015	Flat 3/8" Trim •	10 1/2	24	6	13 7/8	27 3/8	11 1/2	25	5 7/8	Cosmic & Galaxy 2 1/2-10 Mercury 2 1/2-5 , Sentinel 5
	1016	1 1/2 Square •	10 1/2	24	6	13 7/8	27 3/8	11 1/2	25	4 5/8	
	1017	3 Rolled •	10 1/2	24	6	13 7/8	27 3/8	11 1/2	25	3 1/8	
	1012	4 Rolled/ADA Pull •	10 1/2	24	6	13 7/8	27 3/8	11 1/2	25	2 1/8	
	1018	4 1/2 Rolled	10 1/2	24	6	13 7/8	27 3/8	11 1/2	25	1 5/8	
	1013	Surf Mtd. Sq	13 11/16	27 3/16	6 1/2	13 7/8	27 3/8	—	—	—	Any Cosmic**, Galaxy**, Mercury, Saturn or Grenadier P, Sentinel 5 & 10
	2015	Flat 3/8" Trim •	12	27	7 3/4	15 3/8	30 3/8	13	28	7 5/8	
	2016	1 1/4 Square •	12	27	7 3/4	15 3/8	30 3/8	13	28	6 5/8	
	2017	2 1/2 Rolled •	12	27	7 3/4	15 3/8	30 3/8	13	28	5 3/8	
	2012	4 Rolled/ADA Pull •	12	27	7 3/4	15 3/8	30 3/8	13	28	3 7/8	
	2018	4 1/2 Rolled	12	27	7 3/4	15 3/8	30 3/8	13	28	3 3/8	Any Cosmic**, Galaxy**, Mercury, Saturn or Grenadier P, Sentinel 5-15, 272
	2013	Surf Mtd. Sq	15 3/16	30 3/16	8 1/4	15 3/8	30 3/8	—	—	—	
	3015	Flat 3/8" Trim •	16	32	7 3/4	19 3/8	35 3/8	17	33	7 5/8	
	3016	1 1/4 Square •	16	32	7 3/4	19 3/8	35 3/8	17	33	6 5/8	
	3017	2 1/2 Rolled •	16	32	7 3/4	19 3/8	35 3/8	17	33	5 3/8	
	3012	4 Rolled/ADA Pull •	16	32	7 3/4	19 3/8	35 3/8	17	33	3 7/8	Two each of: any Cosmic**, Galaxy**, Mercury, Saturn or Grenadier P, Sentinel 5
	3018	4 1/2 Rolled	16	32	7 3/4	19 3/8	35 3/8	17	33	3 3/8	
	3013	Surf Mtd. Sq	19 3/16	35 3/16	8 1/4	19 3/8	35 3/8	—	—	—	
	4015	Flat 3/8" Trim •	20	27	7 3/4	23 3/8	30 3/8	21	28	7 5/8	
	4016	1 1/4 Square •	20	27	7 3/4	23 3/8	30 3/8	21	28	6 5/8	
	4017	2 1/2 Rolled •	20	27	7 3/4	23 3/8	30 3/8	21	28	5 3/8	
	4012	4 Rolled/ADA Pull •	20	27	7 3/4	23 3/8	30 3/8	21	28	3 7/8	
	4018	4 1/2 Rolled	20	27	7 3/4	23 3/8	30 3/8	21	28	3 3/8	
	4013	Surf Mtd. Sq	23 3/16	30 3/16	8 1/4	23 3/8	30 3/8	—	—	—	

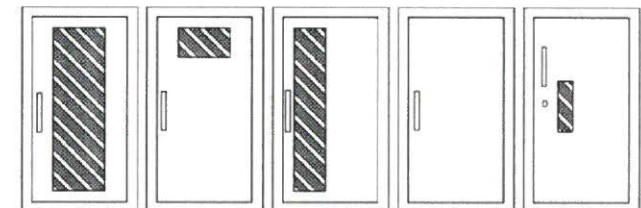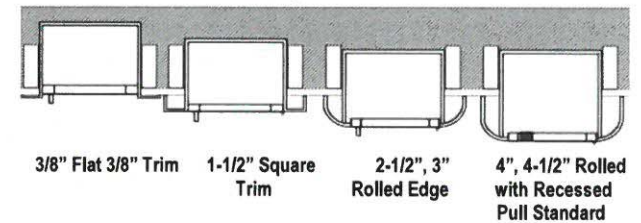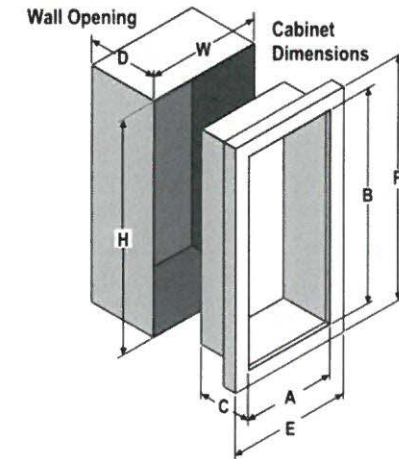

F - Full glass with pull handle
G - Full glass with pull handle above Saf-T-Lok (Not Shown)
D - Horizontal duo panel with pull handle
E - Horizontal duo panel with pull handle above Saf-T-Lok (Not Shown)
V - Vertical duo panel with pull handle
W - Vertical duo panel with pull handle above Saf-T-Lok (Not Shown)
S21 - Solid with pull handle
L22 - Solid with pull handle above Saf-T-Lok
L24 - Solid with cylinder key lock and no handle
B - Small view window with pull handle, above Saf-T-Lok

ADA Cabinet Mounting Height: Standard Pull on G, E, W, L22 and B Door Styles with Saf-T-Lok are 3 5/8" Higher than Door Center, so Allow for that When Mounting Cabinet. Standard Pull with No Lock or ADA Recessed Pull are Centered on Door.

Models shown in **Large Bold** above are available in several door styles for Quick Shipment. [See current Stock List.](#)

** Cosmic 20 & Galaxy 20 Extinguisher must be mounted on the back of the cabinet tub

• ADA Cabinets

[ADA Information](#)

[VIEW ALL DOOR STYLES ONLINE](#)

SUBMITTAL IDENTIFICATION SHEET

To be completed by Contractor/CM

WEBSTER UNIVERSITY ISB	
PROJECT NAME	
8274 BIG BEND BLVD	
ADDRESS	
NUMBER	
WEBSTER UNIVERSITY	
OWNER	
CANNON DESIGN	
ARCHITECT / ENGINEER	
Joe Voypick	
SUBMITTED BY	
104413-001	
CONTRACTOR / CM SUBMITTAL NO.	CANNON DESIGN SUBMITTAL NO.
	104413
DRAWING / DETAIL REFERENCE	SPECIFICATION SECTION / PARAGRAPH
MANUFACTURER / SUPPLIER	ITEM / PRODUCT ID
REQUIRED DATE	PRIORITY
	CRITICAL

ITEM BEING SUBMITTED (check only one)

- | | | |
|--------------------------------------|---|--|
| ☐ Shop Drawings | ☐ Certification / | ☐ Coordination Drawing |
| ☐ Samples | ☐ Qualifications | ☐ Calculations |
| ☐ (____ copies) | ☐ Record Documents | ☐ Schedules |
| ☐ LEED Submittal | ☒ Product Data | ☐ O&M Manuals |
| ☐ Other _____ | | |

ITEM BEING SUBMITTED FOR (check only one)

- ☒ Action ☐ Information Only ☐ Record

REMARKS OR DEVIATIONS

sample forthcoming

CONTRACTOR / CM CERTIFICATION (SUBMITTALS NOT CERTIFIED WILL BE RETURNED WITHOUT REVIEW)



PARIC CORPORATION
SUBMITTAL STAMP

THIS SHOP DRAWING HAS BEEN REVIEWED BY PARIC CORPORATION

Subcontractor remains responsible for dimensions, quantities, coordination with other trades and compliance with contract documents.

By:

Devin D. Gates

To be completed by Reviewer

10 4413-001 REV002
CANNON DESIGN SUBMITTAL NUMBER
5/12/17
RECEIVED DATE

- ☐ A. No Exceptions Taken
No further review of submittal is required.
- ☒ B. Make Corrections Noted
Incorporate corrections in work; resubmission is not required.
- ☐ C. Revise and Resubmit
Revise as noted, and resubmit for review.
- ☐ D. Rejected
Submittal is not in compliance with Contract Documents; provide new submittal.
- ☐ E. For Record / Information Only
Submittal was reviewed for Record / Information purposes only.
- ☐ F. Not Required for Review
Submittal is not required by Contract Documents and has not been reviewed.

Review is for conformance with the design concept of this project and for general compliance with contract documents. Contractor is responsible for quantities, dimensions and compliance with contract documents and for information that pertains to fabrication processes, construction techniques and coordination of this work with all trades which will be affected thereby. This review is null and void if submittal deviates from contract documents and does not indicate or note deviations.

A/E COMMENTS

☐ See attached sheet(s) for additional comments

PROVIDE FIRE-RATED CABINETS PER SPECIFICATION 104413, 2.2, B AT FIRE-RATED PARTITIONS.

CONFIRM IF SAF-T-LOK IS ACCEPTABLE WITH WEBSTER UNIVERSITY.

SEE ADDITIONAL MARKUPS.

Joe Voypick	5/11/17
REVIEWED BY	DATE

Kelvin Patel	5/26/17
REVIEWED BY	DATE

Digitally signed by Kelvin Patel
DN: cn=Kelvin Patel, o=Cannon Design,
ou=Architect, email=K-Patel@cannondesign.com, Date: 2017.05.26 11:45:51 -0500



77 Westport Plaza
Suite 250
St. Louis, MO 63146

TRANSMITTAL

No. 15051-0573

Paric Corporation

PROJECT: 15051-Webster University Interdisciplinary Science Building

DATE: 05/11/2017

TO: Cannon Design
1100 Clark Ave
St Louis MO 63102

Fax;
314-241-2203

RE: Fire Extinguisher Cabinets product data

ATTN: Kelvin Patel

JOB: 15051

WE ARE SENDING:	SUBMITTED FOR:	ACTION TAKEN:
☐ Shop Drawings	☒ Approval	☐ Approved as Submitted
☐ Letter	☐ Your Use	☐ Approved as Noted
☐ Prints	☐ As Requested	☐ Returned After Loan
☐ Change Order	☐ Review and Comment	☐ Resubmit
☐ Plans		☐ Submit
☐ Samples	SENT VIA:	☐ Returned
☐ Specifications	☐ Attached	☐ Returned for Corrections
☒ Other: Product Data	☐ Separate Cover Via:	☒ Due Date: 01/12/2017

Item	Package	Code	Rev.	Copies	Date	Description	Status
Submittal		104413-001	1		05/11/2017	Fire Extinguisher Cabinets product data	Submitted

NOTES:

CC:

Signed: _____
Devin Gates