


PEGBOARD

6678M

GRAPHITE EPOXY RESIN PEGBOARD 36" WIDE 35" HIGH W/ (53) FIFTY THREE POLYPROPYLENE PEGS

PLEASE REFER TO THE DETAIL SHEETS (PG. 79) TO
SEE FULL PEGBOARD ASSEMBLY

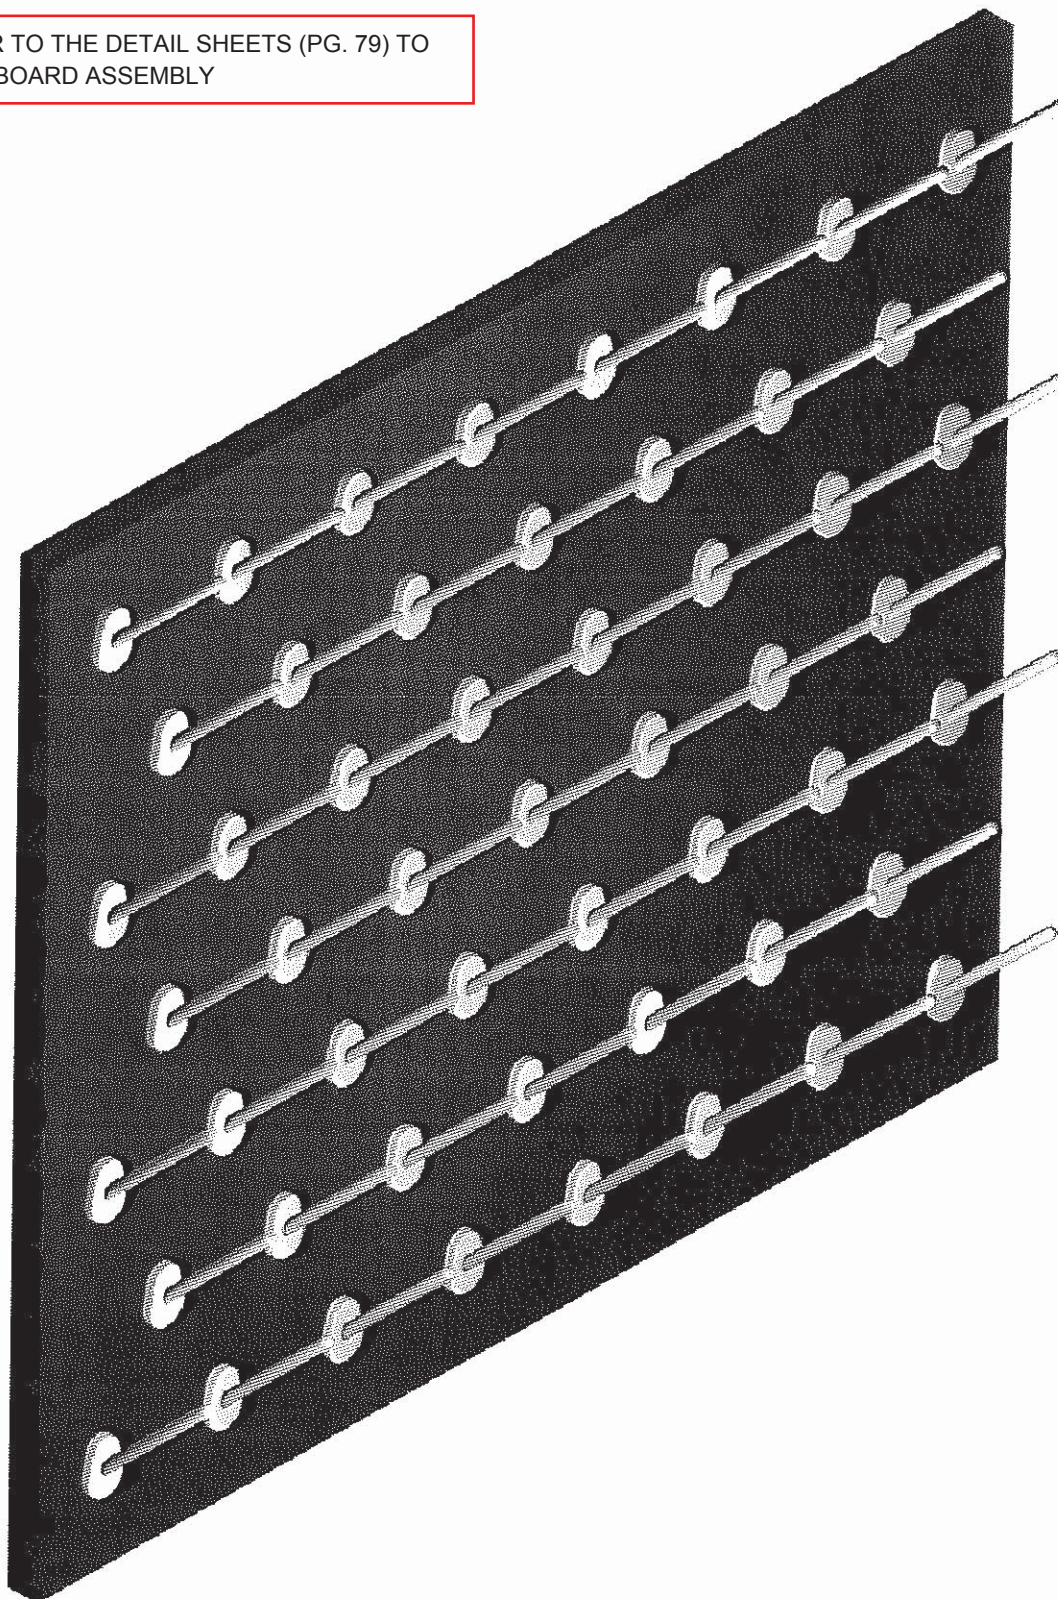

GENERAL COMMENTS:

-ALL LAB CASEWORK TO MEET PERFORMANCE REQUIREMENT INFORMATION PER SPECIFICATION (SPEC.) 123553,1.3,A.

-TABLES TO MEET UL REQUIREMENT PER SPECIFICATION 123553,1.3,D.

-EW, DH & PRE-RINSE FIXTURE APPROVAL ON HOLD.

-ALL CABINETS (WOOD, METAL, FLAMMABLE, ACID) TO BE FLUSH OVERLAY.

-PRODUCT DATA FOR MOBILE LAB CASEWORK SYSTEM WHICH WAS PRESENT IN PREVIOUS SUBMITTAL WAS DELETED IN THIS RE-SUBMITTAL. THE MOBILE LABORATORY CASEWORK SYSTEM IS APPROVED PROVIDED IT IS ONE OF THE APPROVED MANUFACTURER PER SPECIFICATIONS, JAMESTOWN METAL PRODUCTS PER PREVIOUS SUBMITTAL. PROVIDE WRITTEN CONFIRMATION TO DOCUMENT THE MANUFACTURER & PRODUCT MEETS SPECIFICATIONS.

-PROVIDE WHITE COLOR CYLINDER RACKS.

-ALL PRE-WIRED TABLES CONNECTING TO FLOOR BOXES TO HAVE STANDARD ELECTRICAL PLUG.

-COORDINATE ALL ELECTRICAL OUTLETS WITH ELECTRICAL DRAWING & SPECIFICATIONS. TECHNICAL SPECIFICATIONS PER ELECTRICAL DRAWINGS.

PROVIDE SEPARATE SUBMITTAL FOR FOLLOWING:

-PROVIDE LOAD CAPACITY OF TABLES.

-PROVIDE SEPARATE SUBMITTAL OF TEST REPORTS FOR COUNTERTOP PER SPEC. 123553,1.5,C.

-HEAVY DUTY SLIDE PRODUCT DATA FOR GRADE 1HD-100 & 1HD-200 PER SPEC. 123553,2.12,E.

-PROVIDE PRODUCT DATA FOR V-5 AND A-5 (QUICK DISCONNECTS).

-PROVIDE PRODUCT DATA FOR E-5, E-6, D-5, D-6

-PROVIDE PRODUCT DATA FOR PAPER TOWEL DISPENSER.

-PROVIDE PRODUCT DATA FOR OVERHEAD SERVICE CARRIER & MOBILE LABORATORY CASEWORK SYSTEM (IDENTIFY MANUFACTURER).

-PROVIDE PRODUCT DATA FOR EPOXY COUNTERTOPS.

-PROVIDE SAMPLE & INFORMATION RELATED TO SIGNAGE FOR ACID (CORROSIVES) & FLAMMABLE CABINETS - CONSISTENT CLEAN GRAPHICS LETTERING.

-PROVIDE WHITE COLOR CYLINDER RACKS.

-ALL PRE-WIRED TABLES CONNECTING TO FLOOR BOXES TO HAVE STANDARD ELECTRICAL PLUG.



INSTITUTIONAL CASEWORK, INC.
1865 Highway 641 North
Paris, Tennessee 38242-8814
(731) 642-4251

DATE: 1/25/2017
JOB: 04437A, B, C, D
RE: Webster University
Webster Groves, MO

TO: Carroll Seating

ATTENTION: Eddie Scheer/Amanda Kohlbrecher

We are forwarding the following via FTP SITE:

- | | | |
|----------------|--------------------------|-----------------------------------|
| ● For Approval | For Review and Comment | As Requested |
| For Your Use | Returned for Corrections | ● Return <u>1</u> Prints and Sets |

COPIES	DATE	NO.	DESCRIPTION
1	1/25/17	04437ARI -E2 and 04337BRI -E4	Rough-In & Elevation Shop Drawings
1	1/25/17	04437DETAILS1 & 04437DETAILS2	Cabinet Sections
1	1/25/17	04437OHSC	OHSC detail/quantities Sheet
1	1/25/17	Set	Project Data Document

REMARKS:

We cannot schedule this project until we receive one copy indicating:

- ☐ Approval
- ☐ Casework finish
- ☐ Field dimensions

If you have any questions, please feel free to call.

CC:

BY: Mitzi A. Hutter