

SERIES S2S ACCESS DOOR

STANDARD FEATURES:




- AUTO-LOCK T-316 STAINLESS STEEL HOLD OPEN ARM WITH RELEASE HANDLE
- T-316 STAINLESS STEEL HINGES AND ATTACHING HARDWARE
- T-316 STAINLESS STEEL SLAM LOCK WITH REMOVABLE KEY
- STAINLESS STEEL COMPRESSION SPRING ASSIST
- BUILT-IN NEOPRENE CUSHION/GASKET
- NON-OZONE DEPLETING BITUMINOUS COATING
- DOUBLE LEAF CONSTRUCTION
- 300 LBS. PER SQ. FT. LOAD RATING (1464 KG. PER SQ. METER LOAD RATING)
- EXTRUDED ALUMINUM FRAME
- RECESSED LIFTING HANDLE
- LIFETIME GUARANTEE



www.HallidayProducts.com
Phone 800-298-1027
Fax 407-298-4534
Sales@HallidayProducts.com

STANDARD SIZES

QTY.	MODEL NO.	A DIM. INCHES (MM)	C DIM. INCHES (MM)	UNIT WT. LBS. (KG.)
	S2S4242	42 (1067)	42 (1067)	93 (42)
	S2S4842	48 (1219)	42 (1067)	99 (45)
	S2S4848	48 (1219)	48 (1219)	110 (50)
	S2S5442	54 (1372)	42 (1067)	108 (49)
	S2S5448	54 (1372)	48 (1219)	119 (54)
	S2S5454	54 (1372)	54 (1372)	127 (58)
	S2S6030	60 (1524)	30 (762)	87 (39)
	S2S6036	60 (1524)	36 (914)	100 (45)
	S2S6042	60 (1524)	42 (1067)	115 (52)
	S2S6048	60 (1524)	48 (1219)	130 (59)
	S2S6054	60 (1524)	54 (1372)	143 (65)
	S2S6060	60 (1524)	60 (1524)	158 (72)
	S2S6636	66 (1676)	36 (914)	109 (49)
	S2S6648	66 (1676)	48 (1219)	141 (64)
	S2S7236	72 (1829)	36 (914)	116 (53)
	S2S7242	72 (1829)	42 (1067)	135 (61)
	S2S7248	72 (1829)	48 (1219)	151 (68)
	S2S7254	72 (1829)	54 (1372)	168 (76)
	S2S7260	72 (1829)	60 (1524)	178 (81)

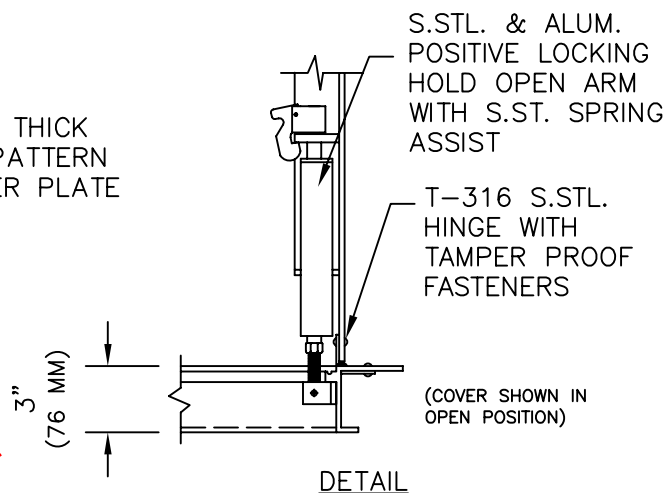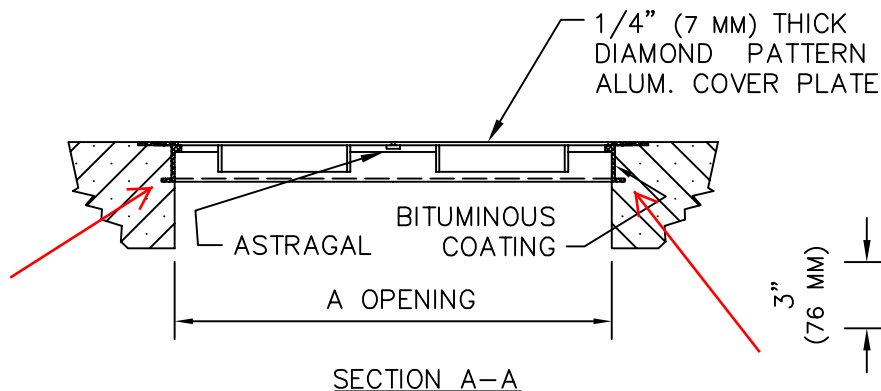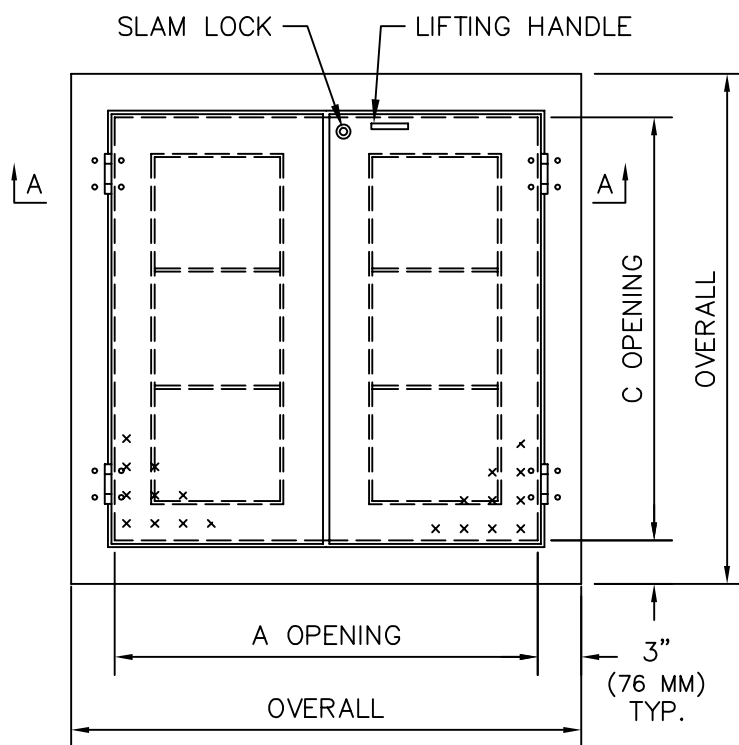

SUBMITTAL IDENTIFICATION SHEET

To be completed by Contractor/CM

PROJECT NAME	
ADDRESS	
NUMBER	
OWNER	
ARCHITECT / ENGINEER	
SUBMITTED BY	
CONTRACTOR / CM SUBMITTAL NO.	CANNON DESIGN SUBMITTAL NO.
DRAWING / DETAIL REFERENCE	SPECIFICATION SECTION / PARAGRAPH
MANUFACTURER / SUPPLIER	ITEM / PRODUCT ID
REQUIRED DATE	PRIORITY
CRITICALITY	

To be completed by Reviewer

CANNON DESIGN SUBMITTAL NUMBER
RECEIVED DATE

- ☐ **A. No Exceptions Taken**
No further review of submittal is required.
- ☐ **B. Make Corrections Noted**
Incorporate corrections in work;
resubmission is not required.
- ☐ **C. Revise and Resubmit**
Revise as noted, and resubmit for review.
- ☐ **D. Rejected**
Submittal is not in compliance with Contract Documents;
provide new submittal.
- ☐ **E. For Record / Information Only**
Submittal was reviewed for Record / Information
purposes only.
- ☐ **F. Not Required for Review**
Submittal is not required by Contract Documents
and has not been reviewed.

Review is for conformance with the design concept of this project and for general compliance with contract documents. Contractor is responsible for quantities, dimensions and compliance with contract documents and for information that pertains to fabrication processes, construction techniques and coordination of this work with all trades which will be affected thereby. This review is null and void if submittal deviates from contract documents and does not indicate or note deviations.

ITEM BEING SUBMITTED (check only one)

- ☐ Shop Drawings ☐ Certification / Qualifications ☐ Coordination Drawing
☐ Samples ☐ Record Documents ☐ Calculations
 (_____ copies) ☐ Product Data ☐ Schedules
☐ LEED Submittal ☐ O&M Manuals
☐ Other

ITEM BEING SUBMITTED FOR (check only one)

- ☐ Action ☐ Information Only ☐ Record

REMARKS OR DEVIATIONS

CONTRACTOR / CM CERTIFICATION
(SUBMITTALS NOT CERTIFIED WILL BE RETURNED WITHOUT REVIEW)



PARIC CORPORATION
SUBMITTAL STAMP

THIS SHOP DRAWING HAS BEEN REVIEWED BY PARIC CORPORATION

Subcontractor remains responsible for dimensions, quantities, coordination with other trades and compliance with contract documents.

Ry:

By:
Devin D. Gates

REVIEWED BY	DATE

A/E COMMENTS

- ☐
- See attached sheet(s) for additional comments

REVIEWED BY	DATE



77 Westport Plaza
Suite 250
St. Louis, MO 63146

TRANSMITTAL

No. 15051-0173

Paric Corporation

PROJECT: 15051-Webster University Interdisciplinary Science Building

DATE: 08/04/2016

TO: Cannon Design
1100 Clark Ave
St Louis MO 63102

RE: Split Water Service Product Data

ATTN: Kelvin Patel

JOB: 15051

WE ARE SENDING:	SUBMITTED FOR:	ACTION TAKEN:
☐ Shop Drawings	☒ Approval	☐ Approved as Submitted
☐ Letter	☐ Your Use	☐ Approved as Noted
☐ Prints	☐ As Requested	☐ Returned After Loan
☐ Change Order	☐ Review and Comment	☐ Resubmit
☐ Plans		☐ Submit
☐ Samples	SENT VIA:	☐ Returned
☐ Specifications	☐ Attached	☐ Returned for Corrections
☒ Other: Product Data	☐ Separate Cover Via:	☐ Due Date:

Item	Package	Code	Rev.	Copies	Date	Description	Status
Submittal		221116-002	1		08/04/2016	Split Water Service Product Data	Submitted

NOTES:

CC:

Signed: _____
Devin Gates



SUBMITTAL TRANSMITTAL

345 Marshall Avenue Suite 302, Webster Groves, MO 63119
314-421-0042 phone, 314-231-9157 fax

To: Paric Corporation
77 Westport Plaza, Suite 250
St. Louis, MO 63146

From: Ethan Gwinn
Date: 8/4/2016

Attn: Jason Szachnieski

Project Name:
CASTLE Project Number:
Architect/Engineer's Project Number:

Subm. #: _____ **Sub/Vendor:** Midwest Municipal Supply

PLEASE FIND ENCLOSED:

Copies	Date	No.	Description
1	8/4/2016	1	Domestic & Fire Water Service

ACTION:

☒ For Approval	☐ Approved As Submitted
☐ For your Use	☐ Approved As Noted
☐ As requested	☐ Revise & Resubmit

COMMENTS:

CC: File