



Model AG

Air Gap Adaptor Fitting

Application

Designed for use with 1/4" thru 10" Model 975XL, 975XL2, 375, 375XL and 475 Reduced Pressure Principle Backflow Preventers on horizontal or vertical installations. Device is necessary when installing a drain line and can be mounted to the body. (Drain line can be any standard piping material.)

Approvals

ANSI/ASME A 112.1.2

Materials

Body Cast grey iron, epoxy painted
 Body (AG-11, 12) Nylon
 Elbow Cast grey iron, epoxy painted
 Bolts Steel, zinc plated



AG-4 thru AG-8



AG-9 & AG-10




AG-11 & AG-12

Sizes: 1/4", 1/2", 3/4", 1", 1-1/4", 2", 2 1/2", 6", 8", 10"


Model: 375, 375XL, 475, 975XL, 975XL2

Dimensions & Weights (do not include pkg.)


MODEL	DIMENSIONS (approximate)							WEIGHT	
	SIZES	FOR MODEL	A		B		C		
			in.	mm	in.	mm	OUTLETPPIPE SIZE	lbs.	kg
AG-8	1/4" - 1/2"	975XL, 975XL2	2 1/2	64	3 1/2	89	1" NPT	2	0.9
AG-4	3/4"-1"	975XL, 975XL2	3 1/4	83	5	127	1" NPT	2	0.9
AG-5	1 1/4" - 2"	975XL, 975XL2	4 1/2	114	8	203	2" NPT	3	1.4
AG-6	2 1/2" - 3"	475V	5 3/8	137	10	254	3" NPT	5	2.3
AG-6	2 1/2" - 6"	375, 475	5 3/8	137	10	254	3" NPT	5	2.3
AG-7	8" - 10"	375, 475	7	178	11	279	4" NPT	8	3.6
AG-9	4" - 6"	475V	5 3/8	137	14 1/2	368	3" NPT	9	4
AG-10	8" - 10"	475V	7	178	16 1/2	413	4" NPT	11	5
AG-11	1/2" - 1"	375, 375XL	3 3/4	95	5 1/2	140	2" IPS Slip	1	0.5
AG-11V	1/2" - 1"	375 VERT., 375XL	-	-	-	-	2" IPS Slip	1	0.5
AG-12	1 1/4" - 2"	375, 375XL	6 1/2	165	8	200	3" IPS Slip	1	0.5

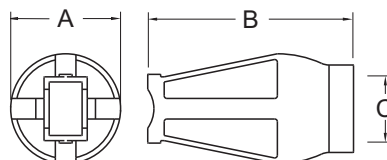


AG-4 THRU AG-8

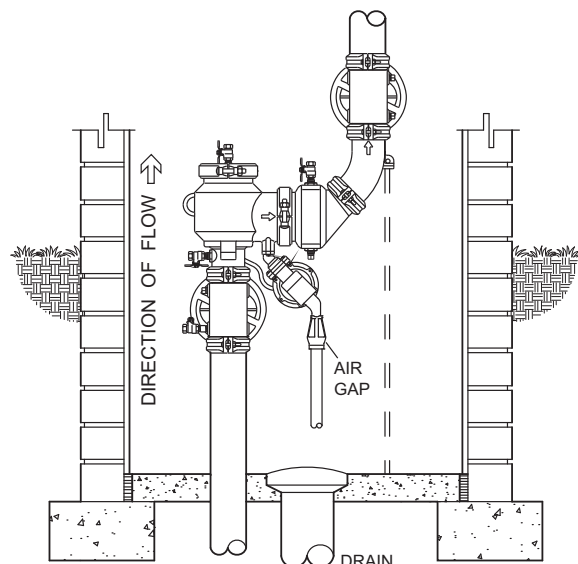

Indoor Installation

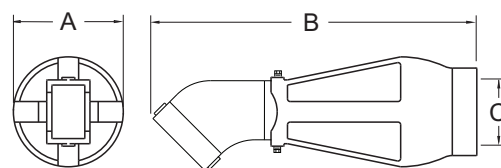

AG-9 & AG-10

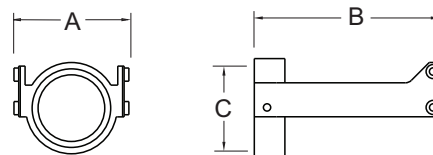

AG-11 & AG-12

Typical Installation

Local codes shall govern installation requirements. To be installed in accordance with the manufacturers' instructions and the latest edition of the Uniform Plumbing Code.

Zurn Industries, LLC | Wilkins

1747 Commerce Way, Paso Robles, CA U.S.A. 93446 · Ph. 855-663-9876, Fax 805-238-5766

In Canada | Zurn Industries Limited

3544 Nashua Drive, Mississauga, Ontario L4V 1L2 · Ph. 905-405-8272, Fax 905-405-1292

www.zurn.com

Rev. A

Date: 6/13

Document No. BF-AG

Product No. Model AG

**BFP-1**

W375ASTP

WILKINS

WFSCP

WILKINS

WAG6

WILKINS

WZW209P

WILKINS

BFP-1 BACKFLOW PREVENTER PER ADDENDUM #2-1

LEAD LAW COMPLIANT 4 STAINLESS STEEL RPP ASSEMBLY

STAINLESS STEEL BODY FLGXFLG

4" FS CAST IRON FLANGE WYE STRAINER

2-1/2" - 6 AIR GAP

LF 4 PRESSURE REDUCING VALVE 150# FXF

1. BFP-1 - Provide caps and tethers for each test cock.
2. PRV - Coating to be FDA approved or comply with AWWA C550

Shop Drawing Submittal Review

Transmitted To: Cannon Design

Date: June 13, 2016

Attention: stl-cac@cannondesign.com

Contact Person / WTA Field Inspector:
Patrick Garner

Project Name: Webster University-**ISB**

Reviewed by: Mike Whitworth (WES)

Project No. WT 14127.01
WES 607

☐ UPS ☐ Courier ☒ **Email**

Copies	No.	Description
1 PDF	221119P02	(Submittal No.'s)
		(Cannon #22 1119-004) – (Paric #15051-) – (WES #607)
		• Domestic Water Piping Specialties

***Remarks: See Submittal Review from Webb Engineering.**

c: **Kevin Patel**
Kpatel@cannondesign.com

☒ ***Reviewed**

☒ ***No Exceptions Taken**

☒ ***Make Corrections Noted
*Amend & Resubmit**

☒ ***Make Corrections As Noted,
No Resubmittal Required**

Corrections or comments made on shop drawings during this review do not relieve contractor from compliance with requirements of drawings and specifications. This check is only for review of general conformance with the design concept of project and general compliance with information given in contract documents. Contractor is responsible for: confirming and correlating all quantities and dimensions; selecting fabrication processes and techniques of construction; coordinating his work with that of all other trades; and performing his work in a safe and satisfactory manner.



1400 S. 3rd Street, Suite 201
St. Louis, Missouri 63104
Phone: (314) 588-0600
Fax: (314) 588-0604

Letter of Transmittal

To: wtashop@wmtao.com

From: Mike Whitworth

Date: June 11, 2016

Re: Webster University ISB

WES No: 607

☐ For your Files

☐ For Review

☐ Please Comment

☐ Please Reply

Item No.	Description	No. of Copies	Date
1	Shop Drawing Review – 22 1119 Domestic Water Piping Specialties	1	06-11-2016

•Signature: Mike Whitworth



**WEBB
ENGINEERING
SERVICES INC.**

www.webb-engineering.com

The review of this submittal is limited to the general conformance with the designated design concept and intent of this project and with the general compliance of the information provided in the contract documents. All comments, remarks and notations made on the submittal(s) as a result of this review do not relieve the contractor from full compliance with requirements of the contract documents. Approval for a specific item shall not include approval of an assembly of which the item is not a component. The contractor is solely responsible for rough-in and installation confirming and correlating all quantities and dimensions; selecting fabrication processes and techniques of construction; coordination of this work with that of other trades on this project; and in a safe and satisfactory manner. All work shall be installed in full compliance with the manufacturer's recommendation, Federal, State and Local rules and regulation and the Authority Having Jurisdiction (AHJ) and applicable adopted codes and standards.

PROJECT NAME: Webster University ISB

LOCATION: St. Louis Missouri

CLIENT PROJ. NO.: N/A

WES PROJ. NO.: 607

SPEC SECTION: 22 1119
Domestic Water Piping
Specialties

SUBMITTAL ITEM: See Below -

CONTRACTOR: Deluca Plumbing, LLC.

CTR. SUBMITTAL # 22 1119-004

SUBMITTAL DATE: June 06, 2016

DATE RECEIVED: June 08, 2016

RECEIVED VIA: E-Mail

RECEIVED FROM: WTA

DATE RETURNED: JUNE 11, 2016

RETURNED VIA: E-MAIL

RETRURNED TO: WTASHOP@WMTAO.COM

STATUS KEY:

NO EXCEPTION TAKEN

MAKE CORRECTIONS NOTED, NO RESUBMITTAL:

AMEND AND RESUBMIT

REJECTED, SEE REMARKS:

REVIEWED ONLY

NEC	MCN	AAR	REJ	REV	ITEM	REMARKS
	X				BFP-1 Backflow Preventer Zurn Model – 375ASTP	1. Provide caps and tethers for each test cock.
X					Strainer Wilkins a Zurn Company Model - FSCP	
X					Air Gap Fitting Zurn Model – AG6	
	X				PRV Pressure Reducing Valve Zurn Model – ZW209	1. Coating to be FDA approved or comply with AWWA C550.
	X				BFP-2 Backflow Preventer Zurn Model – 375XLSF With Strainer	1. Provide caps and tethers for each test cock.
X					Air Gap Fitting Zurn Model – AG4	
	X				BFP-3 Backflow Preventer Zurn Model – 375XLSG With Strainer	1. Provide caps and tethers for each test cock.
X					Air Gap Fitting Zurn Model – AG4	



	X				BFP-4 Backflow Preventer Zurn Model – 375XLSH With Strainer	1. Provide caps and tethers for each test cock.
X					Air Gap Fitting Zurn Model – AG5	
		X			Trap Primer PPP Model – PR-500	1. This type/style of trap primer is not specified for this project. Is contractor proposing to use this type/style rather than the waste arm trap primer?
		X	X		Water Hammer Arrester Sioux Chief Model 650-660 Series	1. Provide type/style specified. Refer to specification section 22 1119. Part 2 Products, paragraph 2.12. 2. Refer to Plumbing Fixture Schedule on drawing P0601.

REVIEWED BY: Michael R. Whitworth DATE: June 11, 2016

THESE COMMENTS ARE TO BE ATTACHED TO ALL COPIES OF THE SHOP DRAWING REFERENCED ABOVE.



77 Westport Plaza
Suite 250
St. Louis, MO 63146

TRANSMITTAL

No. 15051-0073

Paric Corporation

PROJECT: 15051-Webster University Interdisciplinary Science Building

DATE: 06/07/2016

TO: Cannon Design
1100 Clark Ave
St Louis MO 63102

RE: BFP 1-4 WHA TP Product data

ATTN: Kelvin Patel

JOB: 15051

WE ARE SENDING:		SUBMITTED FOR:	ACTION TAKEN:
☐ Shop Drawings		☒ Approval	☒ Approved as Submitted
☐ Letter		☐ Your Use	☐ Approved as Noted
☐ Prints		☐ As Requested	☐ Returned After Loan
☐ Change Order		☐ Review and Comment	☐ Resubmit
☐ Plans			☐ Submit
☐ Samples		SENT VIA:	☐ Returned
☐ Specifications		☐ Attached	☐ Returned for Corrections
☒ Other: Product Data		☐ Separate Cover Via:	☐ Due Date:

Item	Package	Code	Rev.	Copies	Date	Description	Status
Submittal		221119-04	1		06/07/2016	BFP 1-4 WHA TP Product data	Submitted

NOTES:

CC: Paric Corporation, Kathy Bathe

Project Coordinator: Paric Corporation, Kathy Bathe

Signed: _____
Devin Gates

Shop Drawing Submittal

Project Name: **WEBSTER ISB**

Specification # **221119-02**

Specification Description: Domestic Water Specialties
- BFP 1-4
- Trap Primers
- Water Hammer Arrestors

Date: 06-06-16

General Contractor / Construction Manager: Paric

Contractor: DeLuca Plumbing, L.L.C.
8465 Delport Drive
St. Louis, MO 63114

Supplier: Various

Manufacturer: Various

Reviewed & Approved by: DeLuca Plumbing 06-06-16

Action: Forward to GC/CM for Review & Approval

--