PROFESSIONAL
OUTDOOR LIGHTING

Type: EC MOUNTING STAKE

Model:

Project: WEBSTER ISB

SPECIFICATION SHEET

MODEL MP-150 Mounting Pedestal Landscape Series • Accessories

FIXTURE SPECIFICATIONS:

DESCRIPTION:
3" diameter, black PVC mounting pedestal.

MOUNTING:
½" FPT for fixture mounting.

All Vista luminaires are MADE IN THE U.S.A.

DIMENSIONS:

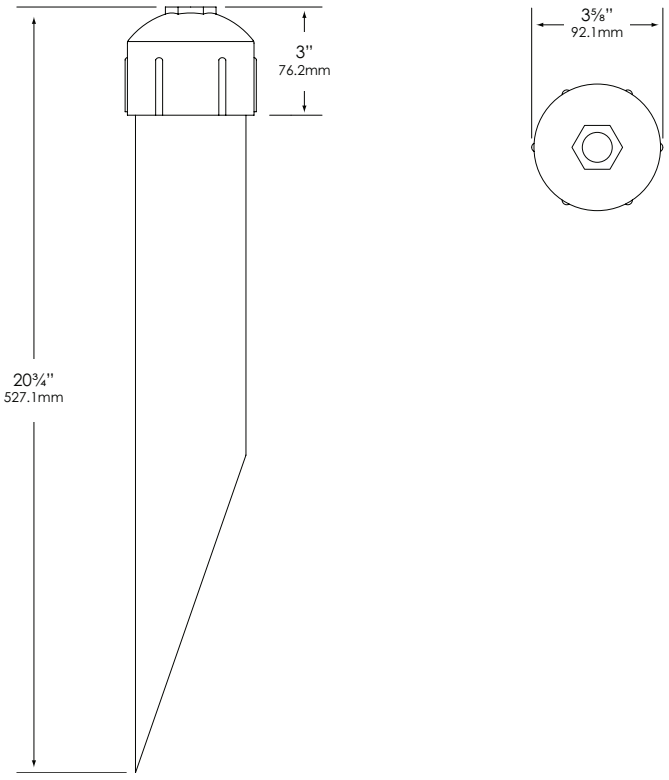

Vista Professional Outdoor Lighting reserves the right to modify the design and/or construction of the fixture shown without further notification.

1625 Surveyor Avenue • Simi Valley, CA 93063 • (805) 527-0987 • (800) 766-VISTA (8478)
FAX: (888) 670-VISTA (8478) • email@vistapro.com • www.vistapro.com

WM TAO & ASSOCIATES
CONSULTING ENGINEERS

Shop Drawing Submittal Review

Transmitted To: Cannon Design

Date: January 17, 2017

Attention: **stl-cac@cannondesign.com**

Contact Person / WTA Field Inspector: Patrick Garner

Project Name: Webster University-**ISB**

Reviewed by: Mark de la Fuente

Project No. WT 14127.01

[ ] UPS [ ] Courier [X] **Email**

Copies	No.	Description
1 PDF	265200E01A	(Submittal No.'s:) (R&B CxSRC)
		(Cannon #265200-006) - ~~(Paric #15051-)~~ – ~~(WES #607)~~
		➢ **Outdoor Lighting Final Fixture Package - Resubmittal**
		EB, EC, ED, SA, EF36, EF42, EH, EL, and RQ

Submittal Review Comments

1. **Refer to previous shop drawing submittals for previous shop drawing comments.**
2. Type EC: See attached cutsheet for updated configuration.
3. Type EF36/42: Provide Bronze finish.
4. Type EL: Provide Black finish.
5. Type RQ: Provide 277 volt configuration.

c: **Kelvin Patel**
Kpatel@cannondesign.com

[ ] Furnish as Submitted [X] ***Furnish as Noted**

[ ] Rejected [ ] Revise & Resubmit

[ ] Reviewed [ ]

Corrections or comments made on shop drawings during this review do not relieve contractor from compliance with requirements of drawings and specifications. This check is only for review of general conformance with the design concept of project and general compliance with information given in contract documents. Contractor is responsible for: confirming and correlating all quantities and dimensions; selecting fabrication processes and techniques of construction; coordinating his work with that of all other trades; and performing his work in a safe and satisfactory manner.

14127.01 - 265200 E01A RESUBMITTAL - MAD TO REVIEW 01/11/17

WTASHOP - Webster ISB - 26 5200-006

From: STL-CAC <STL-CAC@CANNONDESIGN.COM>
To: 'Patrick Garner' <pgarner@wmtao.com>, "WTASHOP (WTASHOP@wmtao.com)" <WTA...
Date: 1/11/2017 1:59 PM
Subject: Webster ISB - 26 5200-006
Cc: "Patel, Kelvin" <kpatel@CANNONDESIGN.COM>
Attachments: 265200-006 Outdoor lighting final fixture package.pdf

---

Attached for review.

Melissa Pirtle

CANNONDESIGN

1100 Clark Ave
St. Louis, Missouri 63102
T 314.425.8797
cannondesign.com

CANNONDESIGN

SUBMITTAL IDENTIFICATION SHEET

To be completed by Contractor/CM

WEBSTER UNIVERSITY ISB
PROJECT NAME

8274 BIG BEND BLVD
ADDRESS

NUMBER

WEBSTER UNIVERSITY
OWNER

CANNON DESIGN
ARCHITECT / ENGINEER

DEVIN D GATES
SUBMITTED BY

265200-006
CONTRACTOR / CM SUBMITTAL NO.

CANNON DESIGN SUBMITTAL NO.

DRAWING / DETAIL REFERENCE

265200
SPECIFICATION SECTION / PARAGRAPH

MANUFACTURER / SUPPLIER

ITEM / PRODUCT ID

REQUIRED DATE

PRIORITY

◯ CRITICAL

ITEM BEING SUBMITTED (check only one)

- ◯ Shop Drawings
- ◯ Samples (_____ copies)
- ◯ LEED Submittal
- ◯ Certification / Qualifications
- ◯ Record Documents
- ◯ Product Data
- ◯ Coordination Drawing
- ◯ Calculations
- ◯ Schedules
- ◯ O&M Manuals
- ◯ Other _____

ITEM BEING SUBMITTED FOR (check only one)

- ◉ Action
- ◯ Information Only
- ◯ Record

REMARKS OR DEVIATIONS

CONTRACTOR / CM CERTIFICATION
(SUBMITTALS NOT CERTIFIED WILL BE RETURNED WITHOUT REVIEW)

PARIC

PARIC CORPORATION
SUBMITTAL STAMP

THIS SHOP DRAWING HAS BEEN REVIEWED BY PARIC CORPORATION

Subcontractor remains responsible for dimensions, quantities, coordination with other trades and compliance with contract documents.

By:
Devin D. Gates

DEVIN D GATES
REVIEWED BY

1/11/16
DATE

To be completed by Reviewer

26 5200-006
CANNON DESIGN SUBMITTAL NUMBER

1/11/17
RECEIVED DATE

- ◯ A. No Exceptions Taken
  No further review of submittal is required.
- ◯ B. Make Corrections Noted
  Incorporate corrections in work; resubmission is not required.
- ◯ C. Revise and Resubmit
  Revise as noted, and resubmit for review.
- ◯ D. Rejected
  Submittal is not in compliance with Contract Documents; provide new submittal.
- ◯ E. For Record / Information Only
  Submittal was reviewed for Record / Information purposes only.
- ◯ F. Not Required for Review
  Submittal is not required by Contract Documents and has not been reviewed.

Review is for conformance with the design concept of this project and for general compliance with contract documents. Contractor is responsible for quantities, dimensions and compliance with contract documents and for information that pertains to fabrication processes, construction techniques and coordination of this work with all trades which will be affected thereby. This review is null and void if submittal deviates from contract documents and does not indicate or note deviations.

A/E COMMENTS

◯ See attached sheet(s) for additional comments

REVIEWED BY

DATE