



LEGEND

EJ EXPANSION JOINTS
CJ CONTROL JOINT

1 STANDARD CONCRETE PAVING
5" THICK CONCRETE PAVING, LIGHT BROOM FINISH.
EDGES TO BE 1/4" TOOLED RADIUS, SAW CUT JOINTS.
SEE CIVIL DRAWINGS FOR LAYOUT. CONTRACTOR
TO COORDINATE LOCATION OF ALL JOINTS WITH
LANDSCAPE ARCHITECT.

2 CONCRETE PAVERS
WAUSAU TILE
12" X 24", COLOR TO BE: XP-40
SAND SETTING BED ON CONCRETE BASE
SEE DETAIL A/L501

3 CONCRETE PAVERS
WAUSAU TILE
12" X 24", COLOR TO BE: XP-40 OR XP-120
OVERSIZED PAVERS PER DETAIL 'E' & 'F' L500
PEDESTAL SYSTEM
SEE DETAILS F, G/ L501

4 TREE PIT
CLEAN 3/4" TRAP ROCK MULCH AT TREE PITS.
INCLUDES (2) LED UPLIGHTS PER TREE:
HYDREL MODEL, M9440-SS-12LED-WHT53K-MVOLT-VWFL-FLC20-34S-IHL-LP
SEE DETAILS C, D/ L500

5 PERMEABLE CONCRETE PAVER
HANOVER ARCHITECTURAL PRODUCTS
12" x 18", COLOR TO BE DETERMINED
SEE DETAIL SHEETS C, D/ L500 & CIVIL DRAWING DETAIL 5/C700

6 CONCRETE SEATWALL
WITH IPE WOOD TOP.
SEE DETAIL D/L501

7 STAIRS
SEE ARCHITECTURAL DRAWINGS

8 GREENROOF EDGE RESTRAINT
HEIGHT OF EDGE VARIES. SEE ARCHITECTURAL
DRAWINGS


9 DECORATIVE GRAVEL MAINTENANCE STRIP
BLACK MOUNTAIN TRAP ROCK
SEE DETAIL B/L500

10 EXISTING STONE BENCHES TO REMAIN
PROTECT FROM DAMAGE

11 TRENCH DRAIN
6" WIDE W/ PERFORATED STAINLESS STEEL
GRATE, MODEL #DS-226 BY NDS. INSTALL PER
MANUFACTURER RECOMMENDATIONS. SEE
CIVIL DRAWINGS FOR DETAILS

12 BIKE RACK
LANDSCAPE FORMS
SEE DETAIL SHEET A/L500

13 CONCRETE RETAINING WALL
CAST IN PLACE CONCRETE WALL WITH FORM
LINER FINISH. FORM LINER PATTERN TO BE
DETERMINED. REFERENCE ARCHITECTURAL
WALL DETAILS

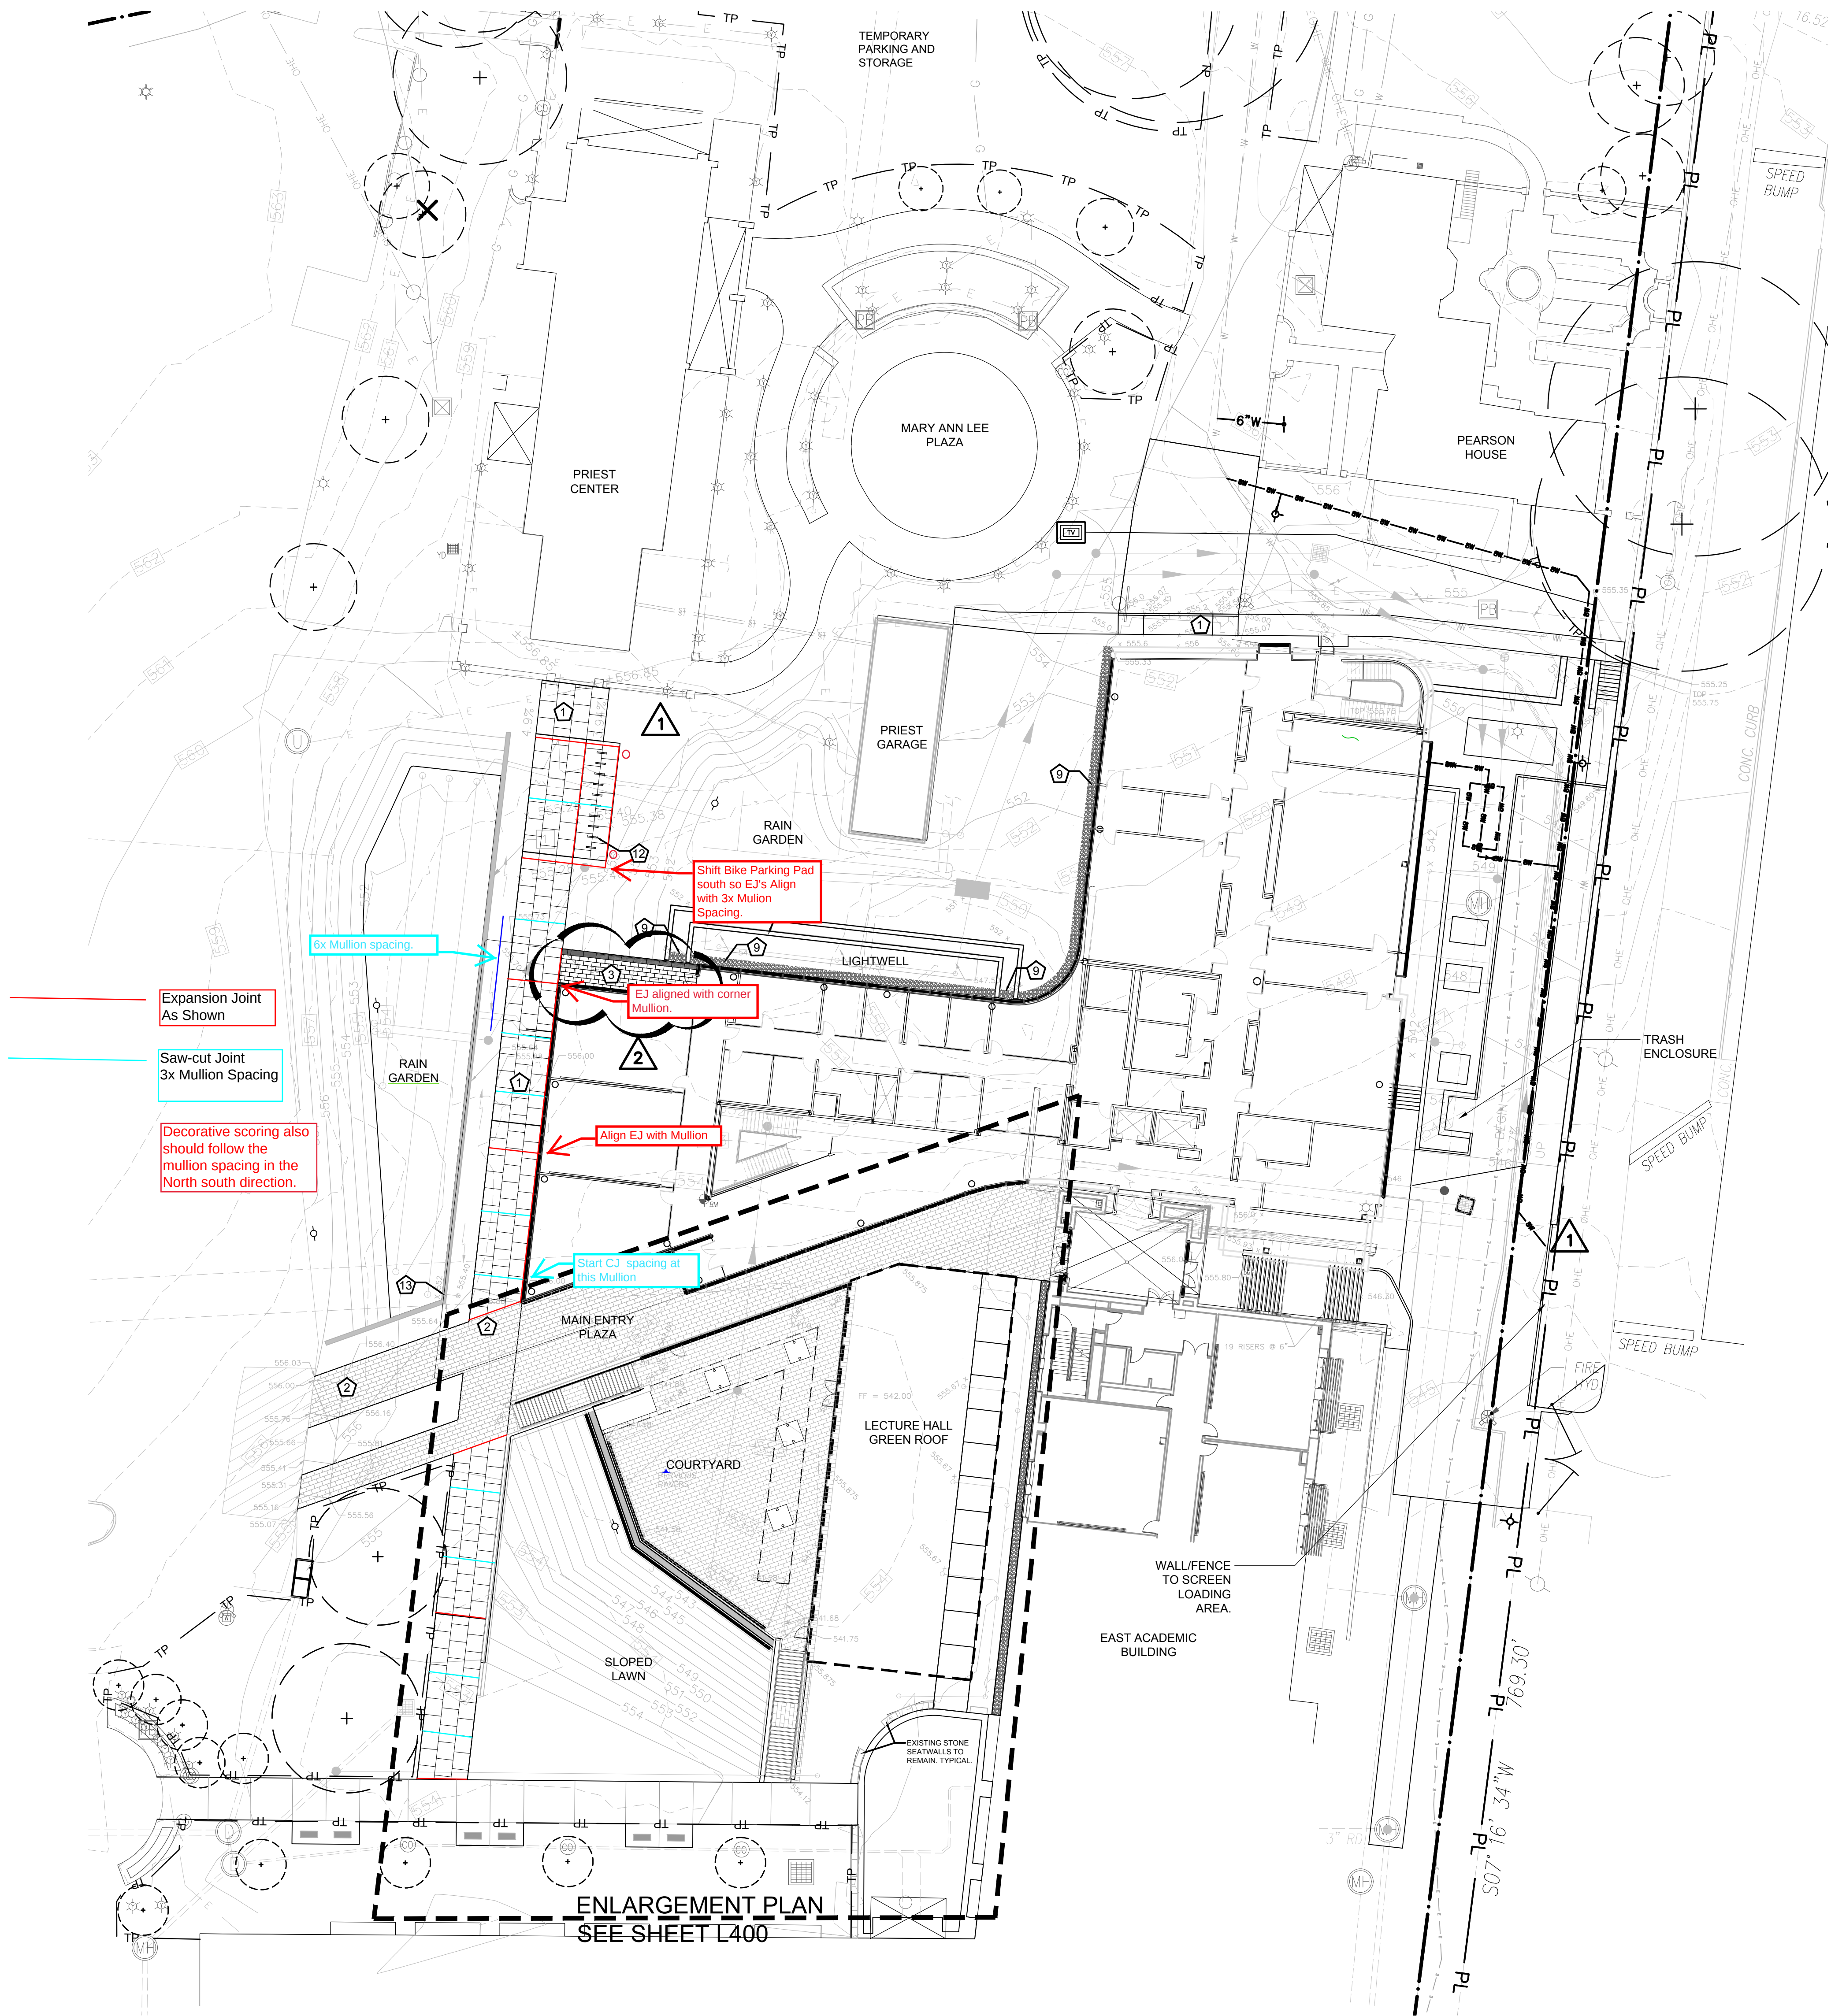

A MATERIALS PLAN
SCALE: 1" = 20'

