TRANSMITTAL LETTER

Leonard Masonry, Inc.

5925 Fee Fee Road
St. Louis, MO 63042

Transmittal # **945-04**

Date: 7/7/2016
Phone: (314) 731-5500
Fax: (314) 731-3366

Project Name: Webster University Interdisciplinary Science Building **Project #:** 945

To: Paric Corporation
Attn: Jason Szachnieski
77 Westport Plaza Drive
Suite 250
St. Louis, MO 63146

SUBJECT: Submittal 945-04, Rev #0 Brick shapes

Phone: (636) 561-9500 **Fax:** (636) 561-9501

Items listed are being sent
- ☑ Enclosed
- ☐ Under Separate Cover
- ☐ Via

We are transmitting the following to you:

- ☐ Product Data
- ☐ Samples
- ☑ Submittals: Submittal 945-04, Rev #0 Brick shapes
- ☑ Shop Drawings
- ☐ O & M Manuals
- ☐ Plans
- ☐ Architectural Drawings
- ☐ Letters
- ☐ Specifications
- ☐ Prints
- ☐ Addenda
- ☐ Engineering Drawings
- ☐ Change Order Requests
- ☐

Submittal: Brick shapes - Rev#0

Code/Spec	Copies	For	Product #	Summary Item
	1	Approval		96 degree corner shape
	1	Approval		Lipped brick shape

Remarks:

COPIES TO:

By: Ken Westhoff
Project Manager

Received by: _____ Date: _____

RAGLAND
CLAY PRODUCTS, LLC
JESSE FORD INDUSTRIAL DRIVE • P. O. BOX 160 • RAGLAND, ALABAMA 35131 • OFFICE (205) 472-2136 • FAX (205) 472-2119

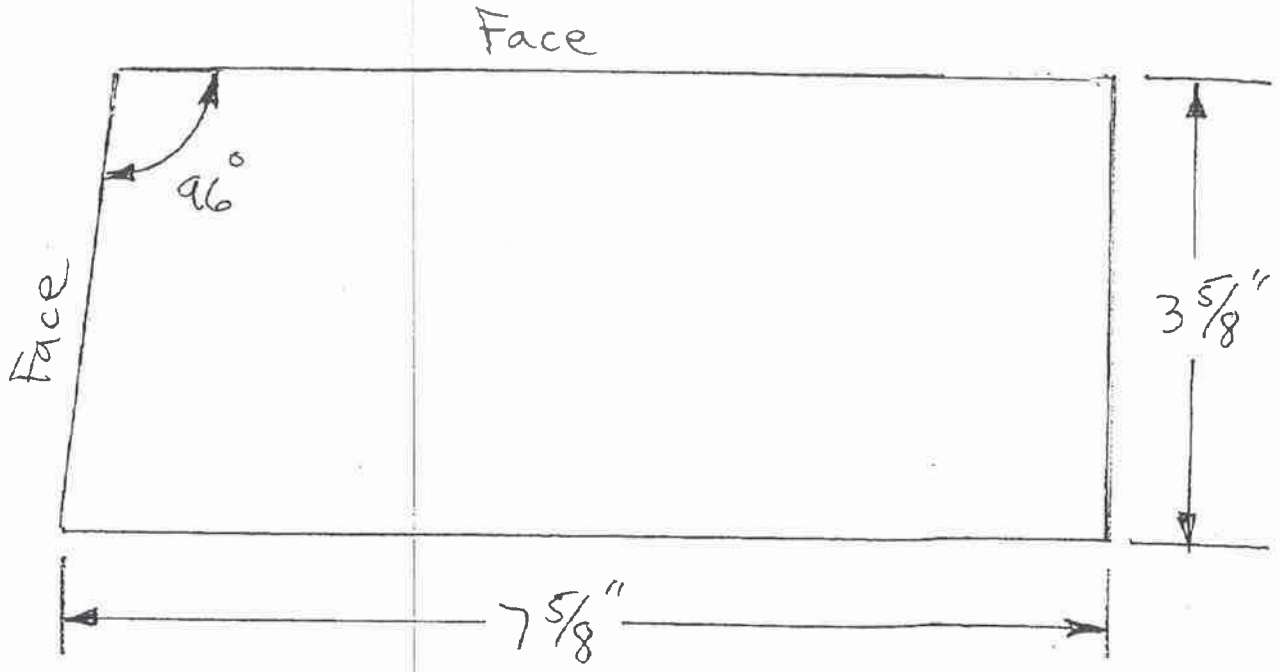

Rejected - Submit special corner brick per drawing 8/A0457

Full Range Select - Modular
Webster Univ. Brick Shape
Scale: 3/4" = 1", Solid 2 1/4"
Date: 6/17/16
Geoff Dunlap

Jesse Rowold
Midwest Block + Brick
Bridgeton, MO
Fax 314-985-0390

RAGLAND
CLAY PRODUCTS, LLC
JESSE FORD INDUSTRIAL DRIVE • P. O. BOX 160 • RAGLAND, ALABAMA 35131 • OFFICE (205) 472-2136 • FAX (205) 472-2119

Attn: Jesse Rowold

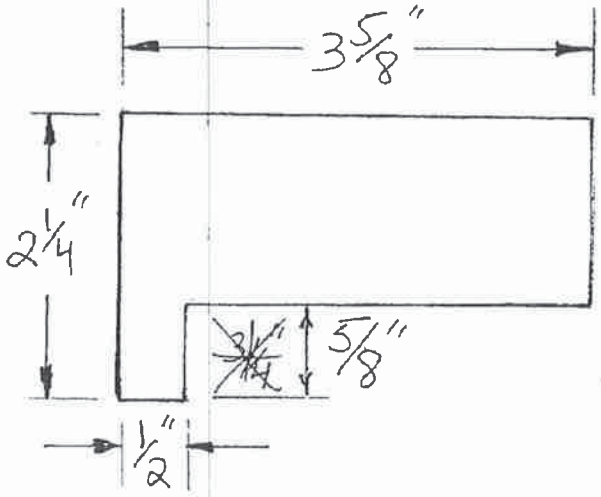

Webster University Prj.
Brick Shape - Lip Stretcher
Date: 6/17/16
Geoff Dunlap

CANNONDESIGN

SUBMITTAL IDENTIFICATION SHEET

To be completed by Contractor/CM

WEBSTER UNIVERSITY ISB
PROJECT NAME

8274 BIG BEND BLVD
ADDRESS

NUMBER

WEBSTER UNIVERSITY
OWNER

CANNON DESIGN
ARCHITECT / ENGINEER

Joe Voypick
SUBMITTED BY

042000-016
CONTRACTOR / CM SUBMITTAL NO.

CANNON DESIGN SUBMITTAL NO.

DRAWING / DETAIL REFERENCE

042000
SPECIFICATION SECTION / PARAGRAPH

Leonard Masonry
MANUFACTURER / SUPPLIER

ITEM / PRODUCT ID

REQUIRED DATE

PRIORITY

CRITICAL

ITEM BEING SUBMITTED (check only one)

- (•) Shop Drawings
- ( ) Samples (_____ copies)
- ( ) LEED Submittal
- ( ) Certification / Qualifications
- ( ) Record Documents
- ( ) Product Data
- ( ) Coordination Drawing
- ( ) Calculations
- ( ) Schedules
- ( ) O&M Manuals
- ( ) Other _____

ITEM BEING SUBMITTED FOR (check only one)

(•) Action ( ) Information Only ( ) Record

REMARKS OR DEVIATIONS

Product Sample Available upon Approval of Shop Drawings

CONTRACTOR / CM CERTIFICATION
(SUBMITTALS NOT CERTIFIED WILL BE RETURNED WITHOUT REVIEW)

PARIC

PARIC CORPORATION
SUBMITTAL STAMP

THIS SHOP DRAWING HAS BEEN REVIEWED BY PARIC CORPORATION

Subcontractor remains responsible for dimensions, quantities, coordination with other trades and compliance with contract documents.

By:
Devin D. Gates

Joe Voypick
REVIEWED BY

7/8/16
DATE

To be completed by Reviewer

04 2000-016
CANNON DESIGN SUBMITTAL NUMBER

7/8/16
RECEIVED DATE

( ) A. No Exceptions Taken
No further review of submittal is required.

( ) B. Make Corrections Noted
Incorporate corrections in work; resubmission is not required.

(•) C. Revise and Resubmit
Revise as noted, and resubmit for review.

( ) D. Rejected
Submittal is not in compliance with Contract Documents; provide new submittal.

( ) E. For Record / Information Only
Submittal was reviewed for Record / Information purposes only.

( ) F. Not Required for Review
Submittal is not required by Contract Documents and has not been reviewed.

Review is for conformance with the design concept of this project and for general compliance with contract documents. Contractor is responsible for quantities, dimensions and compliance with contract documents and for information that pertains to fabrication processes, construction techniques and coordination of this work with all trades which will be affected thereby. This review is null and void if submittal deviates from contract documents and does not indicate or note deviations.

A/E COMMENTS

( ) See attached sheet(s) for additional comments

See comments below in "green"

Kathy Williams
REVIEWED BY

7/20/16
DATE

77 Westport Plaza
Suite 250
St. Louis, MO 63146

TRANSMITTAL

No. 15051-0128

Paric Corporation

PROJECT: 15051-Webster University Interdisciplinary Science Building

DATE: 07/08/2016

TO: Cannon Design
1100 Clark Ave
St Louis MO 63102

RE: Clay Faced Brick Special Shapes Shop Drawing

ATTN: Kelvin Patel

JOB: 15051

WE ARE SENDING:	SUBMITTED FOR:	ACTION TAKEN:
☑ Shop Drawings	☑ Approval	☐ Approved as Submitted
☐ Letter	☐ Your Use	☐ Approved as Noted
☐ Prints	☐ As Requested	☐ Returned After Loan
☐ Change Order	☐ Review and Comment	☐ Resubmit
☐ Plans		☐ Submit
☐ Samples	**SENT VIA:**	☐ Returned
☐ Specifications	☐ Attached	☐ Returned for Corrections
☐ Other:	☐ Separate Cover Via:	☐ Due Date:

Item	*Package*	*Code*	*Rev.*	*Copies*	*Date*	*Description*	*Status*
Submittal		042000-016	1		07/08/2016	Clay Faced Brick Special Shapes Shop Drawing	Submitted

NOTES:

CC:

Signed: _____

Devin Gates