

SUBMITTAL IDENTIFICATION SHEET

To be completed by Contractor/CM

WEBSTER UNIVERSITY ISB	
PROJECT NAME	
8274 BIG BEND BLVD	
ADDRESS	
NUMBER	
WEBSTER UNIVERSITY	
OWNER	
CANNON DESIGN	
ARCHITECT / ENGINEER	
Joe Voypick	
SUBMITTED BY	
042000-019	
CONTRACTOR / CM SUBMITTAL NO.	CANNON DESIGN SUBMITTAL NO.
	042000
DRAWING / DETAIL REFERENCE	SPECIFICATION SECTION / PARAGRAPH
Leonard Masonry	
MANUFACTURER / SUPPLIER	ITEM / PRODUCT ID
REQUIRED DATE	PRIORITY
	CRITICAL

ITEM BEING SUBMITTED (check only one)

- | | | |
|--|--|--|
| ☒ Shop Drawings | ☐ Certification / Qualifications | ☐ Coordination Drawing |
| ☐ Samples (____ copies) | ☐ Record Documents | ☐ Calculations |
| ☐ LEED Submittal | ☐ Product Data | ☐ Schedules |
| ☐ Other _____ | ☐ O&M Manuals | |

ITEM BEING SUBMITTED FOR (check only one)

- ☒ Action ☐ Information Only ☐ Record

REMARKS OR DEVIATIONS

See attached email correspondence regarding wet dimension.

CONTRACTOR / CM CERTIFICATION (SUBMITTALS NOT CERTIFIED WILL BE RETURNED WITHOUT REVIEW)



PARIC CORPORATION
SUBMITTAL STAMP

THIS SHOP DRAWING HAS BEEN REVIEWED BY PARIC CORPORATION

Subcontractor remains responsible for dimensions, quantities, coordination with other trades and compliance with contract documents.

By:
Devin D. Gates

Joe Voypick	8/2/16
REVIEWED BY	DATE

To be completed by Reviewer

04 2000-019
CANNON DESIGN SUBMITTAL NUMBER
8/3/16
RECEIVED DATE

- ☐ A. No Exceptions Taken
No further review of submittal is required.
- ☒ B. Make Corrections Noted
Incorporate corrections in work; resubmission is not required.
- ☐ C. Revise and Resubmit
Revise as noted, and resubmit for review.
- ☐ D. Rejected
Submittal is not in compliance with Contract Documents; provide new submittal.
- ☐ E. For Record / Information Only
Submittal was reviewed for Record / Information purposes only.
- ☐ F. Not Required for Review
Submittal is not required by Contract Documents and has not been reviewed.

Review is for conformance with the design concept of this project and for general compliance with contract documents. Contractor is responsible for quantities, dimensions and compliance with contract documents and for information that pertains to fabrication processes, construction techniques and coordination of this work with all trades which will be affected thereby. This review is null and void if submittal deviates from contract documents and does not indicate or note deviations.

A/E COMMENTS

☐ See attached sheet(s) for additional comments

See dimensions listed in red for final dry brick dimensions.

Kathy Williams	08/03/16
REVIEWED BY	DATE



77 Westport Plaza
Suite 250
St. Louis, MO 63146

TRANSMITTAL

No. 15051-0172

Paric Corporation

PROJECT: 15051-Webster University Interdisciplinary Science Building

DATE: 08/02/2016

TO: Cannon Design
1100 Clark Ave
St Louis MO 63102

RE: Special brick Shape Shop Drawing

ATTN: Kelvin Patel

JOB: 15051

WE ARE SENDING:	SUBMITTED FOR:	ACTION TAKEN:
☒ Shop Drawings	☒ Approval	☐ Approved as Submitted
☐ Letter	☐ Your Use	☐ Approved as Noted
☐ Prints	☐ As Requested	☐ Returned After Loan
☐ Change Order	☐ Review and Comment	☐ Resubmit
☐ Plans		☐ Submit
☐ Samples	SENT VIA:	☐ Returned
☐ Specifications	☐ Attached	☐ Returned for Corrections
☐ Other:	☐ Separate Cover Via:	☐ Due Date:

Item	Package	Code	Rev.	Copies	Date	Description	Status
Submittal		042000-019	1		08/02/2016	Special brick Shape Shop Drawing	Submitted

NOTES:

CC:

Signed: _____
Devin Gates


ATTENTION

THIS DOCUMENT AND THE DATA DISCLOSED HEREIN OR HEREWITH IS NOT TO BE REPRODUCED, USED, OR DISCLOSED IN WHOLE OR IN PART WITHOUT THE EXPRESSED, WRITTEN PERMISSION OF REYMOND PRODUCTS AND IS SUBJECT TO RETURN UPON REQUEST

REVISIONS

ECN	REV.	DESCRIPTION	BY	DATE
-	00	ORIGINAL RELEASE	JOA	01/20/2016

Final dry brick dim shown in "red"

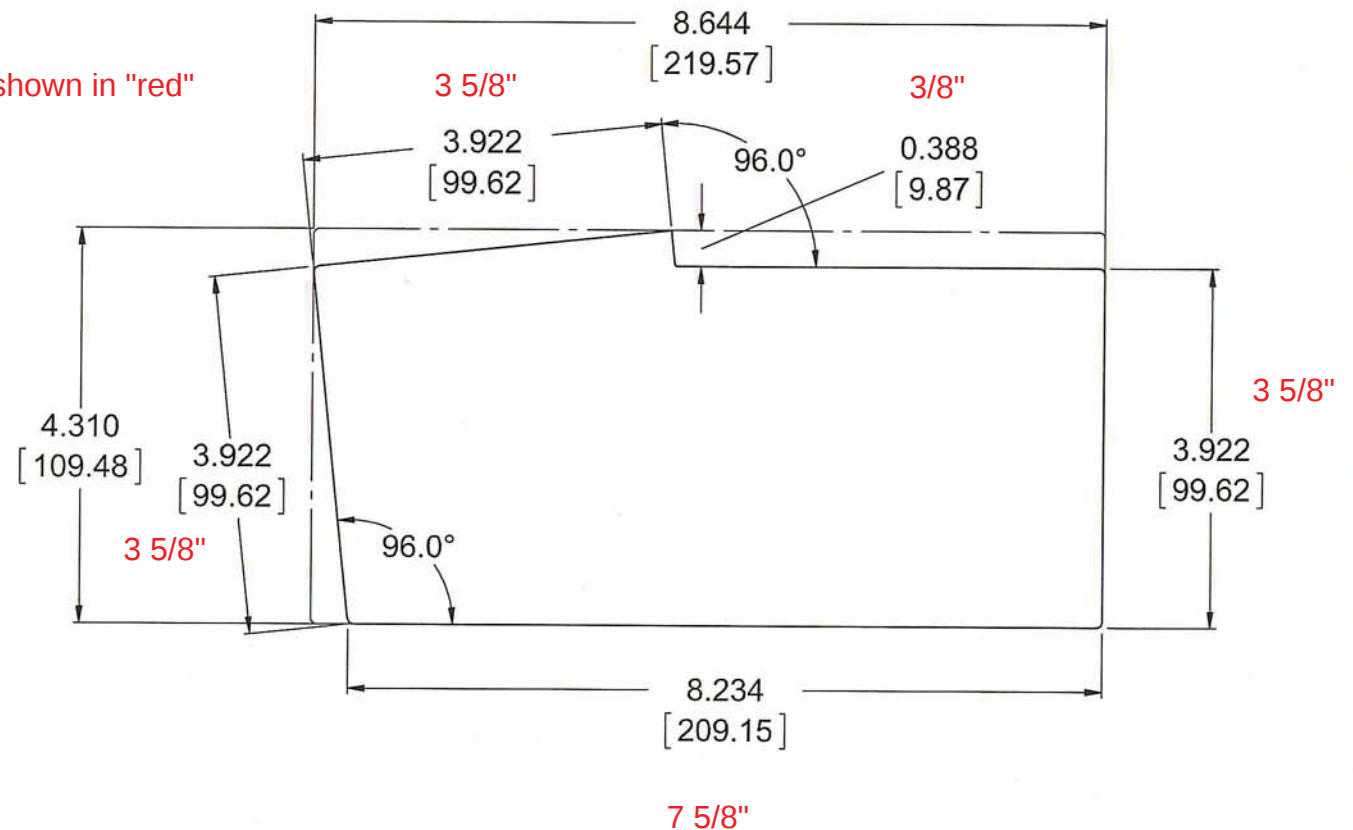

MANUFACTURING BEGINS AFTER
RECEIPT OF APPROVAL DRAWING

DATE: _____
SIGNATURE: _____
P.O. # _____

CUSTOMER RAGLAND CLAY PRODUCTS		Reymond Products International, Inc. P.O. Box 202 Midvale, OH 44653 Web: www.reymondproducts.com Tel: 330.339.3583 Fax: 330.339.6809			
FIRST USE					
MATERIAL See Bill Of Materials					
FINISH					
UNLESS OTHERWISE SPECIFIED: TOLERANCES		WEIGHT 935.45 LBS.	TITLE 4.310 (109.48mm) x 8.644 (219.57mm) SPECIAL CORNER BRICK		
ANGULAR DIMENSIONS..... ± .5 deg.		SCALE 1:2			
FRACTIONAL DIMENSIONS..... ± 1/32 in.		DATE 01/20/2016			
2 PLACE DECIMAL DIMENSIONS ± .015 in.		DRAWN JOA	SIZE A	PART NO. JA01202016A	REV. 00
3 PLACE DECIMAL DIMENSIONS ± .005 in.					SHEET 1 OF 1

Gates, Devin

Subject: FW: rejected special shape shop drawing

From: Travis Irvin [<mailto:tirvin@midwestblock.com>]
Sent: Monday, August 01, 2016 10:03 PM
To: Ken Westhoff
Cc: Jesse Rowold; Tommy Schmidt; Travis Irvin
Subject: RE: rejected special shape shop drawing

Ken:

Thank you for your patience in this matter, here is the update from Ragland...

The attached drawing from Reymond International, shows dimensions the new housing will produce.
*Dimensions are for wet slugs, after drying and firing, the dimensions will match the original details from Webster.

The drawing that was originally submitted represents what we can achieve with machinery already at Ragland without the purchase of the new housing. If the housing from Reymond needs to be purchased and installed, our lead time on the "Special Corner Shape" brick will be 12-16 weeks from the date of a signed sales order.

I will call you on Tuesday to discuss our options further. Thanks

Travis Irvin

Commercial/Architectural Sales

Midwest Block & Brick Inc.

D/314.985.0359
C/636.236.0649

CONFIDENTIALITY NOTICE: This e-mail may contain privileged and confidential information and is intended only for the use of the specific person(s) to whom it is addressed. If you are not an intended recipient of this e-mail, you are hereby notified that any unauthorized use, dissemination or copying of this e-mail or the information contained in it or attached to it is strictly prohibited.

A Member of Concrete Products Group
www.concreteproductsgroup.com