

SUBMITTAL IDENTIFICATION SHEET

To be completed by Contractor/CM

WEBSTER UNIVERSITY ISB	
PROJECT NAME	
8274 BIG BEND BLVD	
ADDRESS	
NUMBER	
WEBSTER UNIVERSITY	
OWNER	
CANNON DESIGN	
ARCHITECT / ENGINEER	
Ryan Tune	
SUBMITTED BY	
042000-027	
CONTRACTOR / CM SUBMITTAL NO.	CANNON DESIGN SUBMITTAL NO.
	042000
DRAWING / DETAIL REFERENCE	SPECIFICATION SECTION / PARAGRAPH
MANUFACTURER / SUPPLIER	ITEM / PRODUCT ID
REQUIRED DATE	PRIORITY
	☐ CRITICAL

ITEM BEING SUBMITTED (check only one)

- | | | |
|--|--|--|
| ☒ Shop Drawings | ☐ Certification / | ☐ Coordination Drawing |
| ☐ Samples | ☐ Qualifications | ☐ Calculations |
| (_____ copies) | ☐ Record Documents | ☐ Schedules |
| ☐ LEED Submittal | ☐ Product Data | ☐ O&M Manuals |
| ☐ Other _____ | | |

ITEM BEING SUBMITTED FOR (check only one)

- ☒ Action ☐ Information Only ☐ Record

REMARKS OR DEVIATIONS

Subcontractor to review in concurrence with with A0505, ASI 07, and RFI 239.

CONTRACTOR / CM CERTIFICATION (SUBMITTALS NOT CERTIFIED WILL BE RETURNED WITHOUT REVIEW)



PARIC CORPORATION
SUBMITTAL STAMP

THIS SHOP DRAWING HAS BEEN REVIEWED BY PARIC CORPORATION

Subcontractor remains responsible for dimensions, quantities, coordination with other trades and compliance with contract documents.

By:

Devin D. Gates

Ryan Tune	05/25/17
REVIEWED BY	DATE

To be completed by Reviewer

04 2000-027
CANNON DESIGN SUBMITTAL NUMBER
5/25/17
RECEIVED DATE

- ☐ A. No Exceptions Taken
No further review of submittal is required.
- ☒ B. Make Corrections Noted
Incorporate corrections in work; resubmission is not required.
- ☐ C. Revise and Resubmit
Revise as noted, and resubmit for review.
- ☐ D. Rejected
Submittal is not in compliance with Contract Documents; provide new submittal.
- ☐ E. For Record / Information Only
Submittal was reviewed for Record / Information purposes only.
- ☐ F. Not Required for Review
Submittal is not required by Contract Documents and has not been reviewed.

Review is for conformance with the design concept of this project and for general compliance with contract documents. Contractor is responsible for quantities, dimensions and compliance with contract documents and for information that pertains to fabrication processes, construction techniques and coordination of this work with all trades which will be affected thereby. This review is null and void if submittal deviates from contract documents and does not indicate or note deviations.

A/E COMMENTS

☐ See attached sheet(s) for additional comments


SEE MARKUPS.

Kelvin Patel	6/2/17
REVIEWED BY	DATE


Digitally signed by Kelvin Patel
DN: C=US, E=kpatel@cannondesign.com, O=Cannon Design,
OU=Architect, CN=Kelvin Patel
Date: 2017.06.02 18:43:27 -0500

General Notes


NOTES
Stone type to be Indiana Limestone, smooth finish
Contractor to verify or provide all dimensions
All stone anchors to be provided and installed by others
All stone joints are to be 3/8" UNO
Pieces marked with an * are to be field cut for length

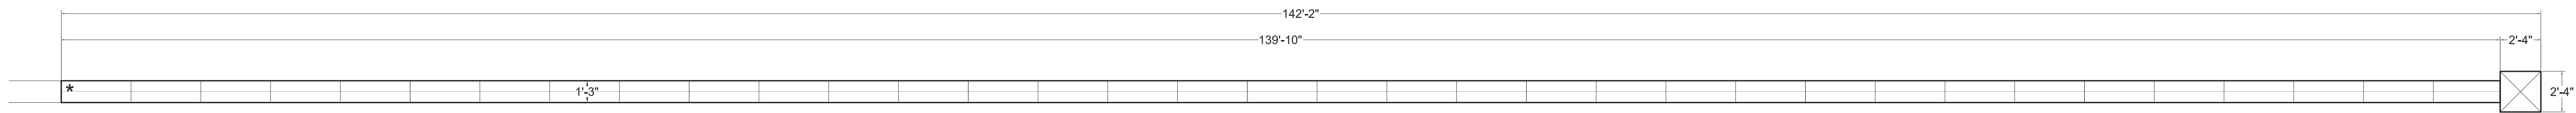


SITEWALL PLAN VIEW

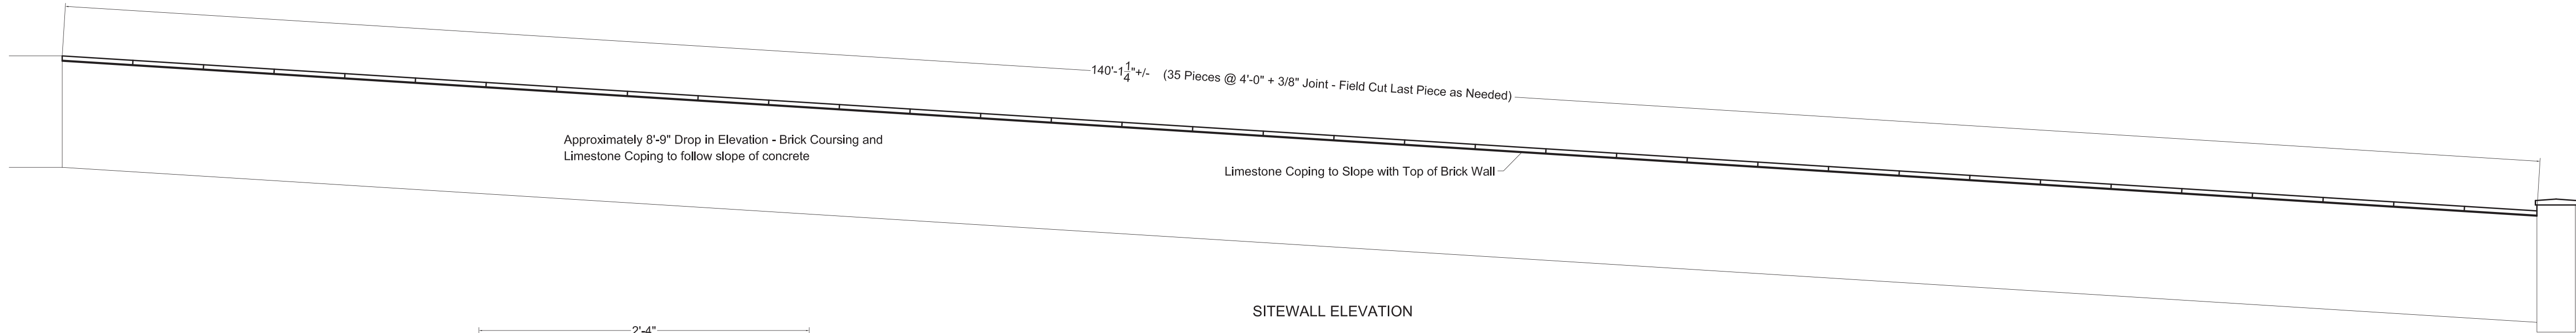

SITEWALL ELEVATION

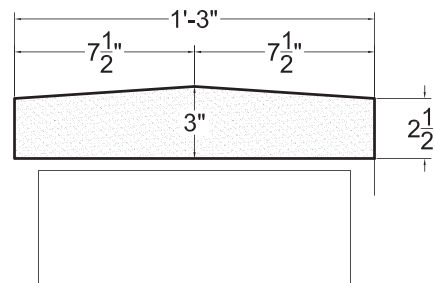


SITE WALL COPING SECTION

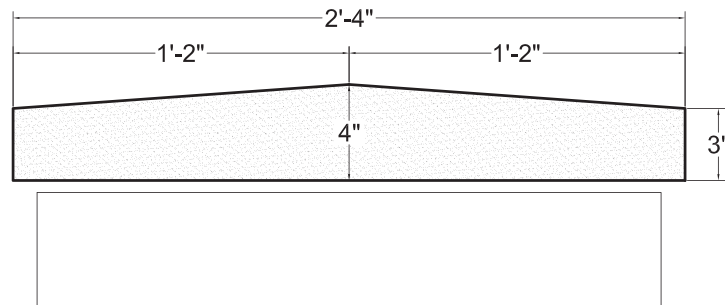


PIER CAP SECTION

COPING FOR NERINX SITE WALL ACCEPTABLE, PROVIDED IT MATCHES EXISTING COPING DETAIL.

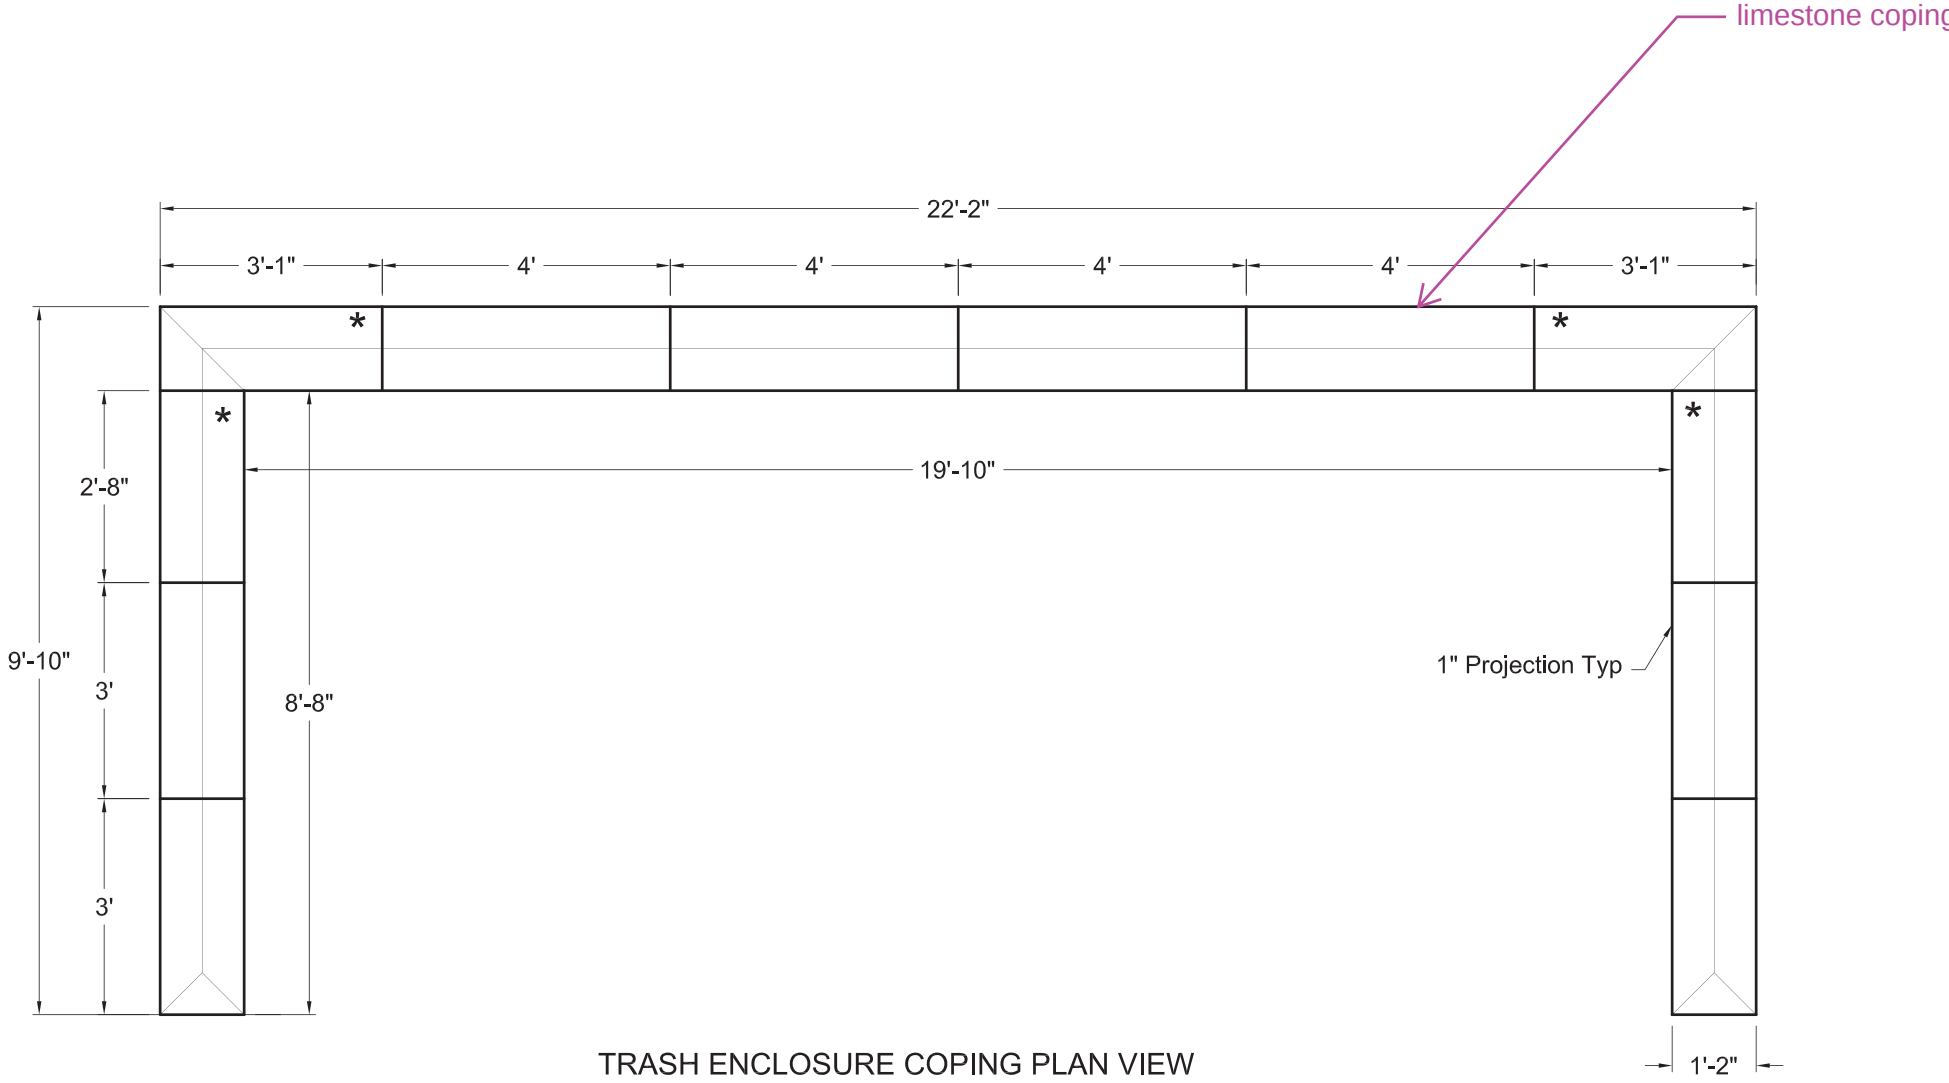

TRASH ENCLOSURE COPING PLAN VIEW

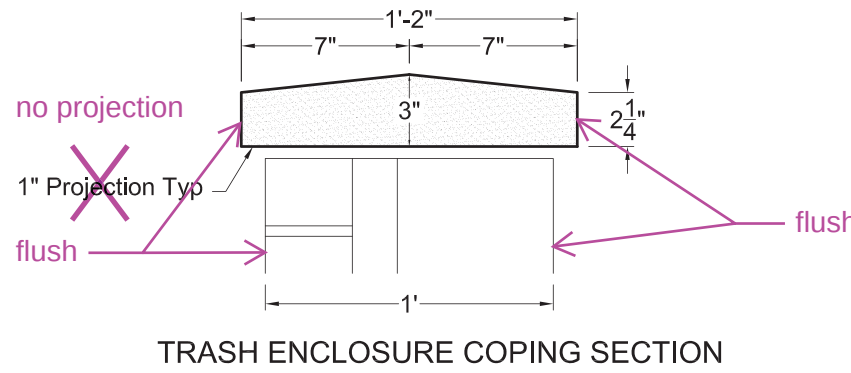

TRASH ENCLOSURE COPING SECTION

1	Approval to Fabricate	5/18/17
No.	Revision/Issue	Date

Firm Name and Address

St. Louis Stone

Project Name and Address

WEBSTER UNIVERSITY
Interdisciplinary Science Building

Project	Sheet
Date	1
Scale	