




ANY MATERIAL FABRICATED IN ACCORDANCE WITH APPROVED SHOP DRAWINGS THAT DOES NOT FIT JOB CONDITIONS WILL BE REMADE AND SHIPPED TO THE JOB ONLY AT CUSTOMERS EXPENSE, AND ONLY AFTER RECEIVING A WRITTEN ORDER FROM THE CUSTOMER. THE ADDITIONAL EXPENSE COLDSRONG ASSUMES NO RESPONSIBILITY FOR THE CUTTING OF MATERIAL TO ACCOMMODATE OTHER TRADES AND WILL NOT BE RESPONSIBLE FOR ANY DELAYS OR ADDITIONAL WORK SHOWN ON THESE DRAWINGS. ANY ANCHORING DETAILS PROVIDED BY COLDSRONG ARE TO BE CONSIDERED AS PROPOSALS ONLY, SUBJECT TO FINAL REVIEW BY ENGINEER, ARCHITECT AND THE CUSTOMER. TAKING INTO ACCOUNT ALL ASPECTS OF THE MATERIAL, INSTALLATION AND BACKUP SYSTEMS, COLDSRONG ASSUMES THE ENTIRE RESPONSIBILITY OF THE SOLE AND EXCLUSIVE RESPONSIBILITY OF THE MATERIAL, AND WILL NOT BE THE RESPONSIBILITY OF COLDSRONG, UNLESS EXPRESSLY AGREED TO BETWEEN THE CUSTOMER AND COLDSRONG, IN WRITING.

[illegible]

COLDSPRINGTM

17482 GRANITE WEST ROAD, COLD SPRING, MN 56320-4578
 PHONE (320) 685-3621, FAX (320) 685-5052
WWW.COLDSPRINGUSA.COM

PROJECT	
WEBSTER UNIVERSITY - INTERDISCIPLINARY SCIENCE BUILDING	
LOCATION	
ST. LOUIS, MO	
PURCHASER	
LEONARD MASONRY	
ARCHITECT	
CANNON DESIGN	
DRAWN BY	
NATE PRIMUS	
MATERIAL	FINISH
MESABI BLACK - DIAMOND 8	
STONE MARK	
DESCRIPTION	
EXTERIOR MOCK UP	
JOB NUMBER	
1003819	
BIN #	SHEET
	MU.1

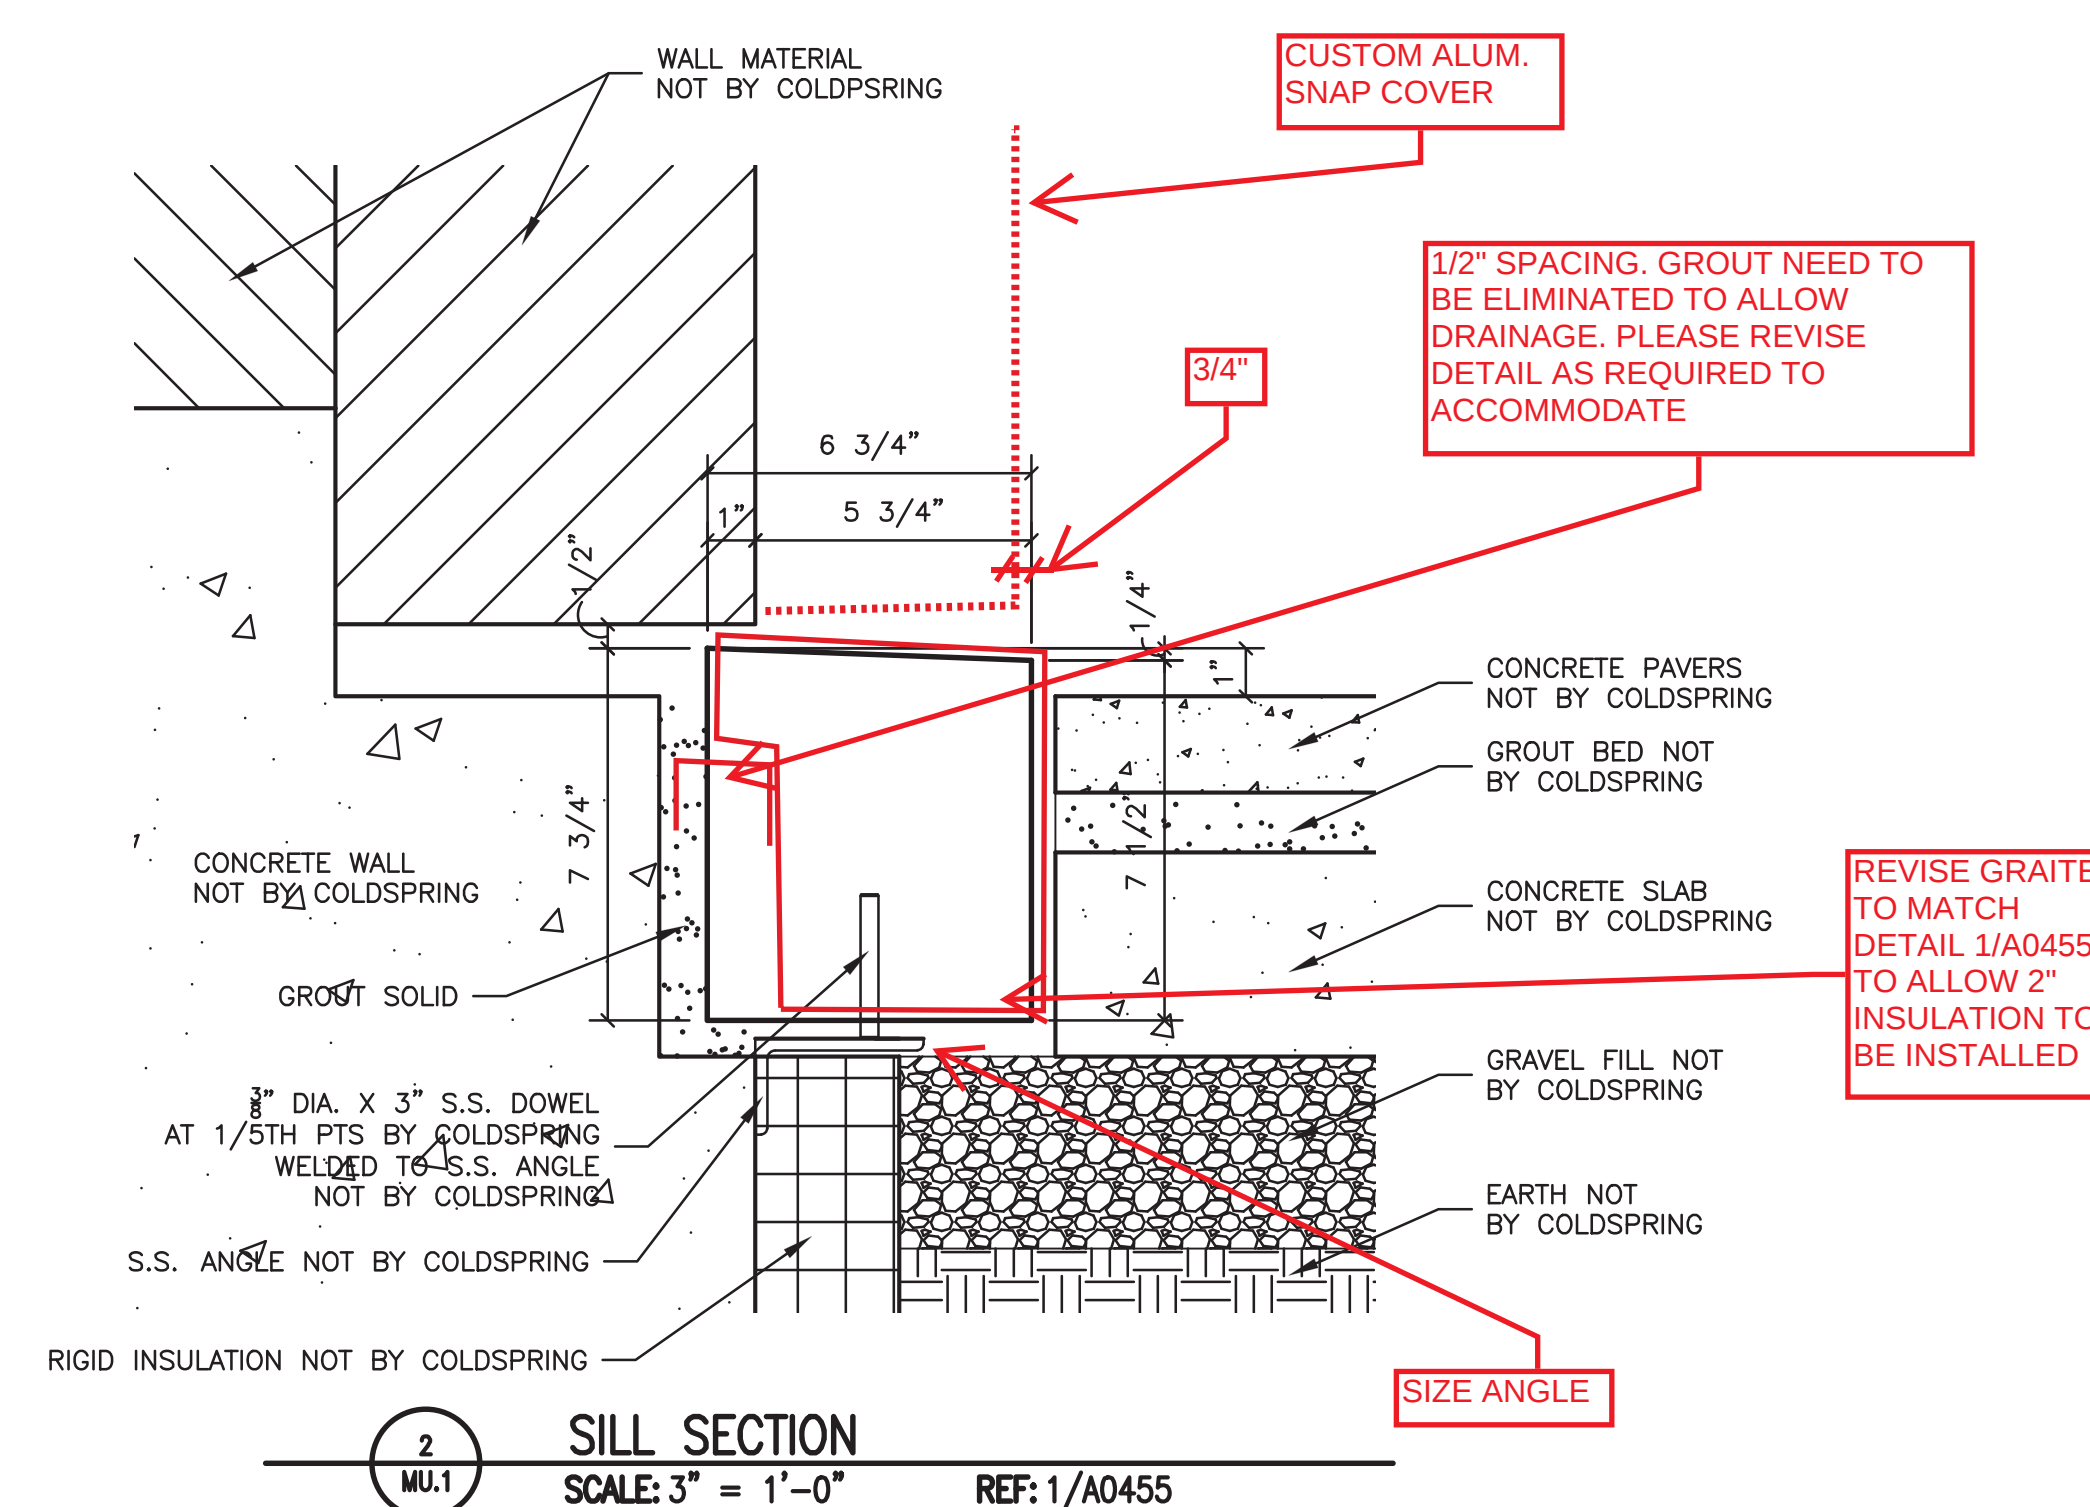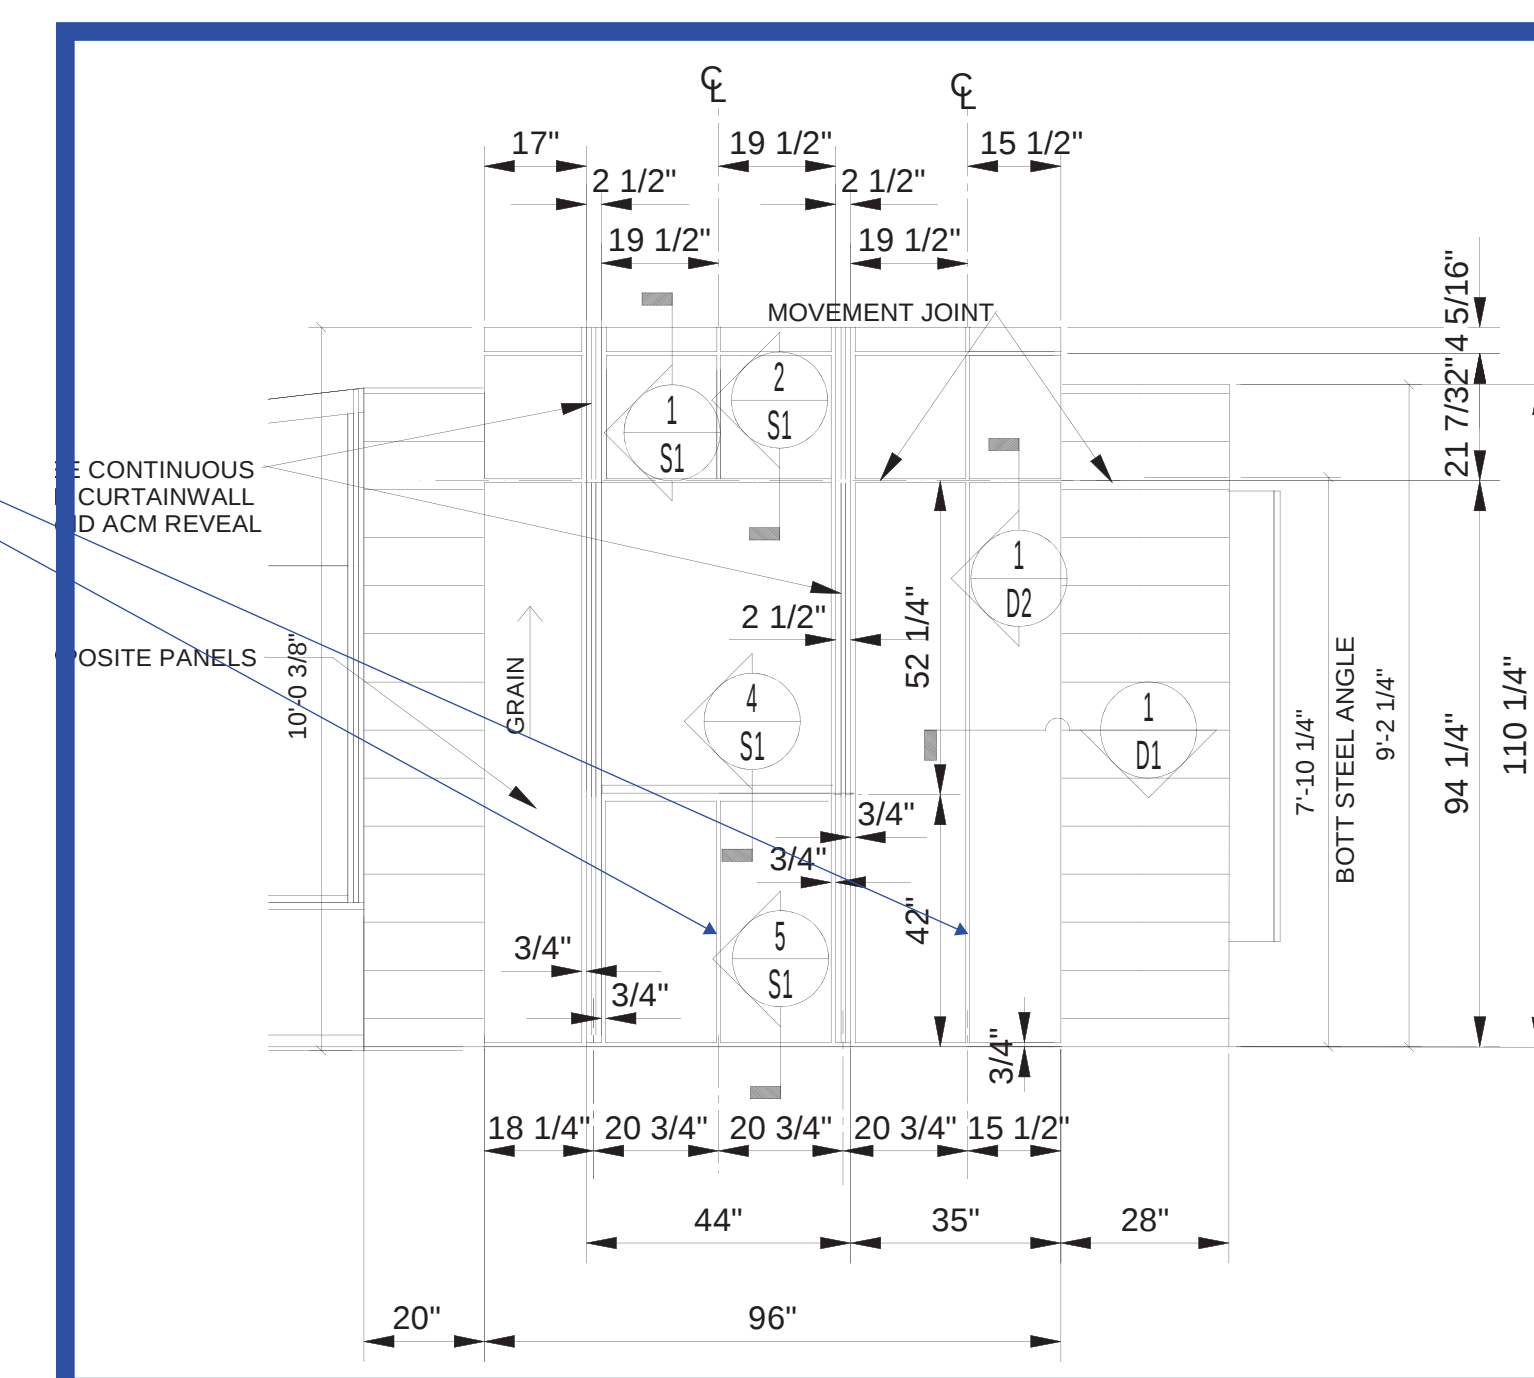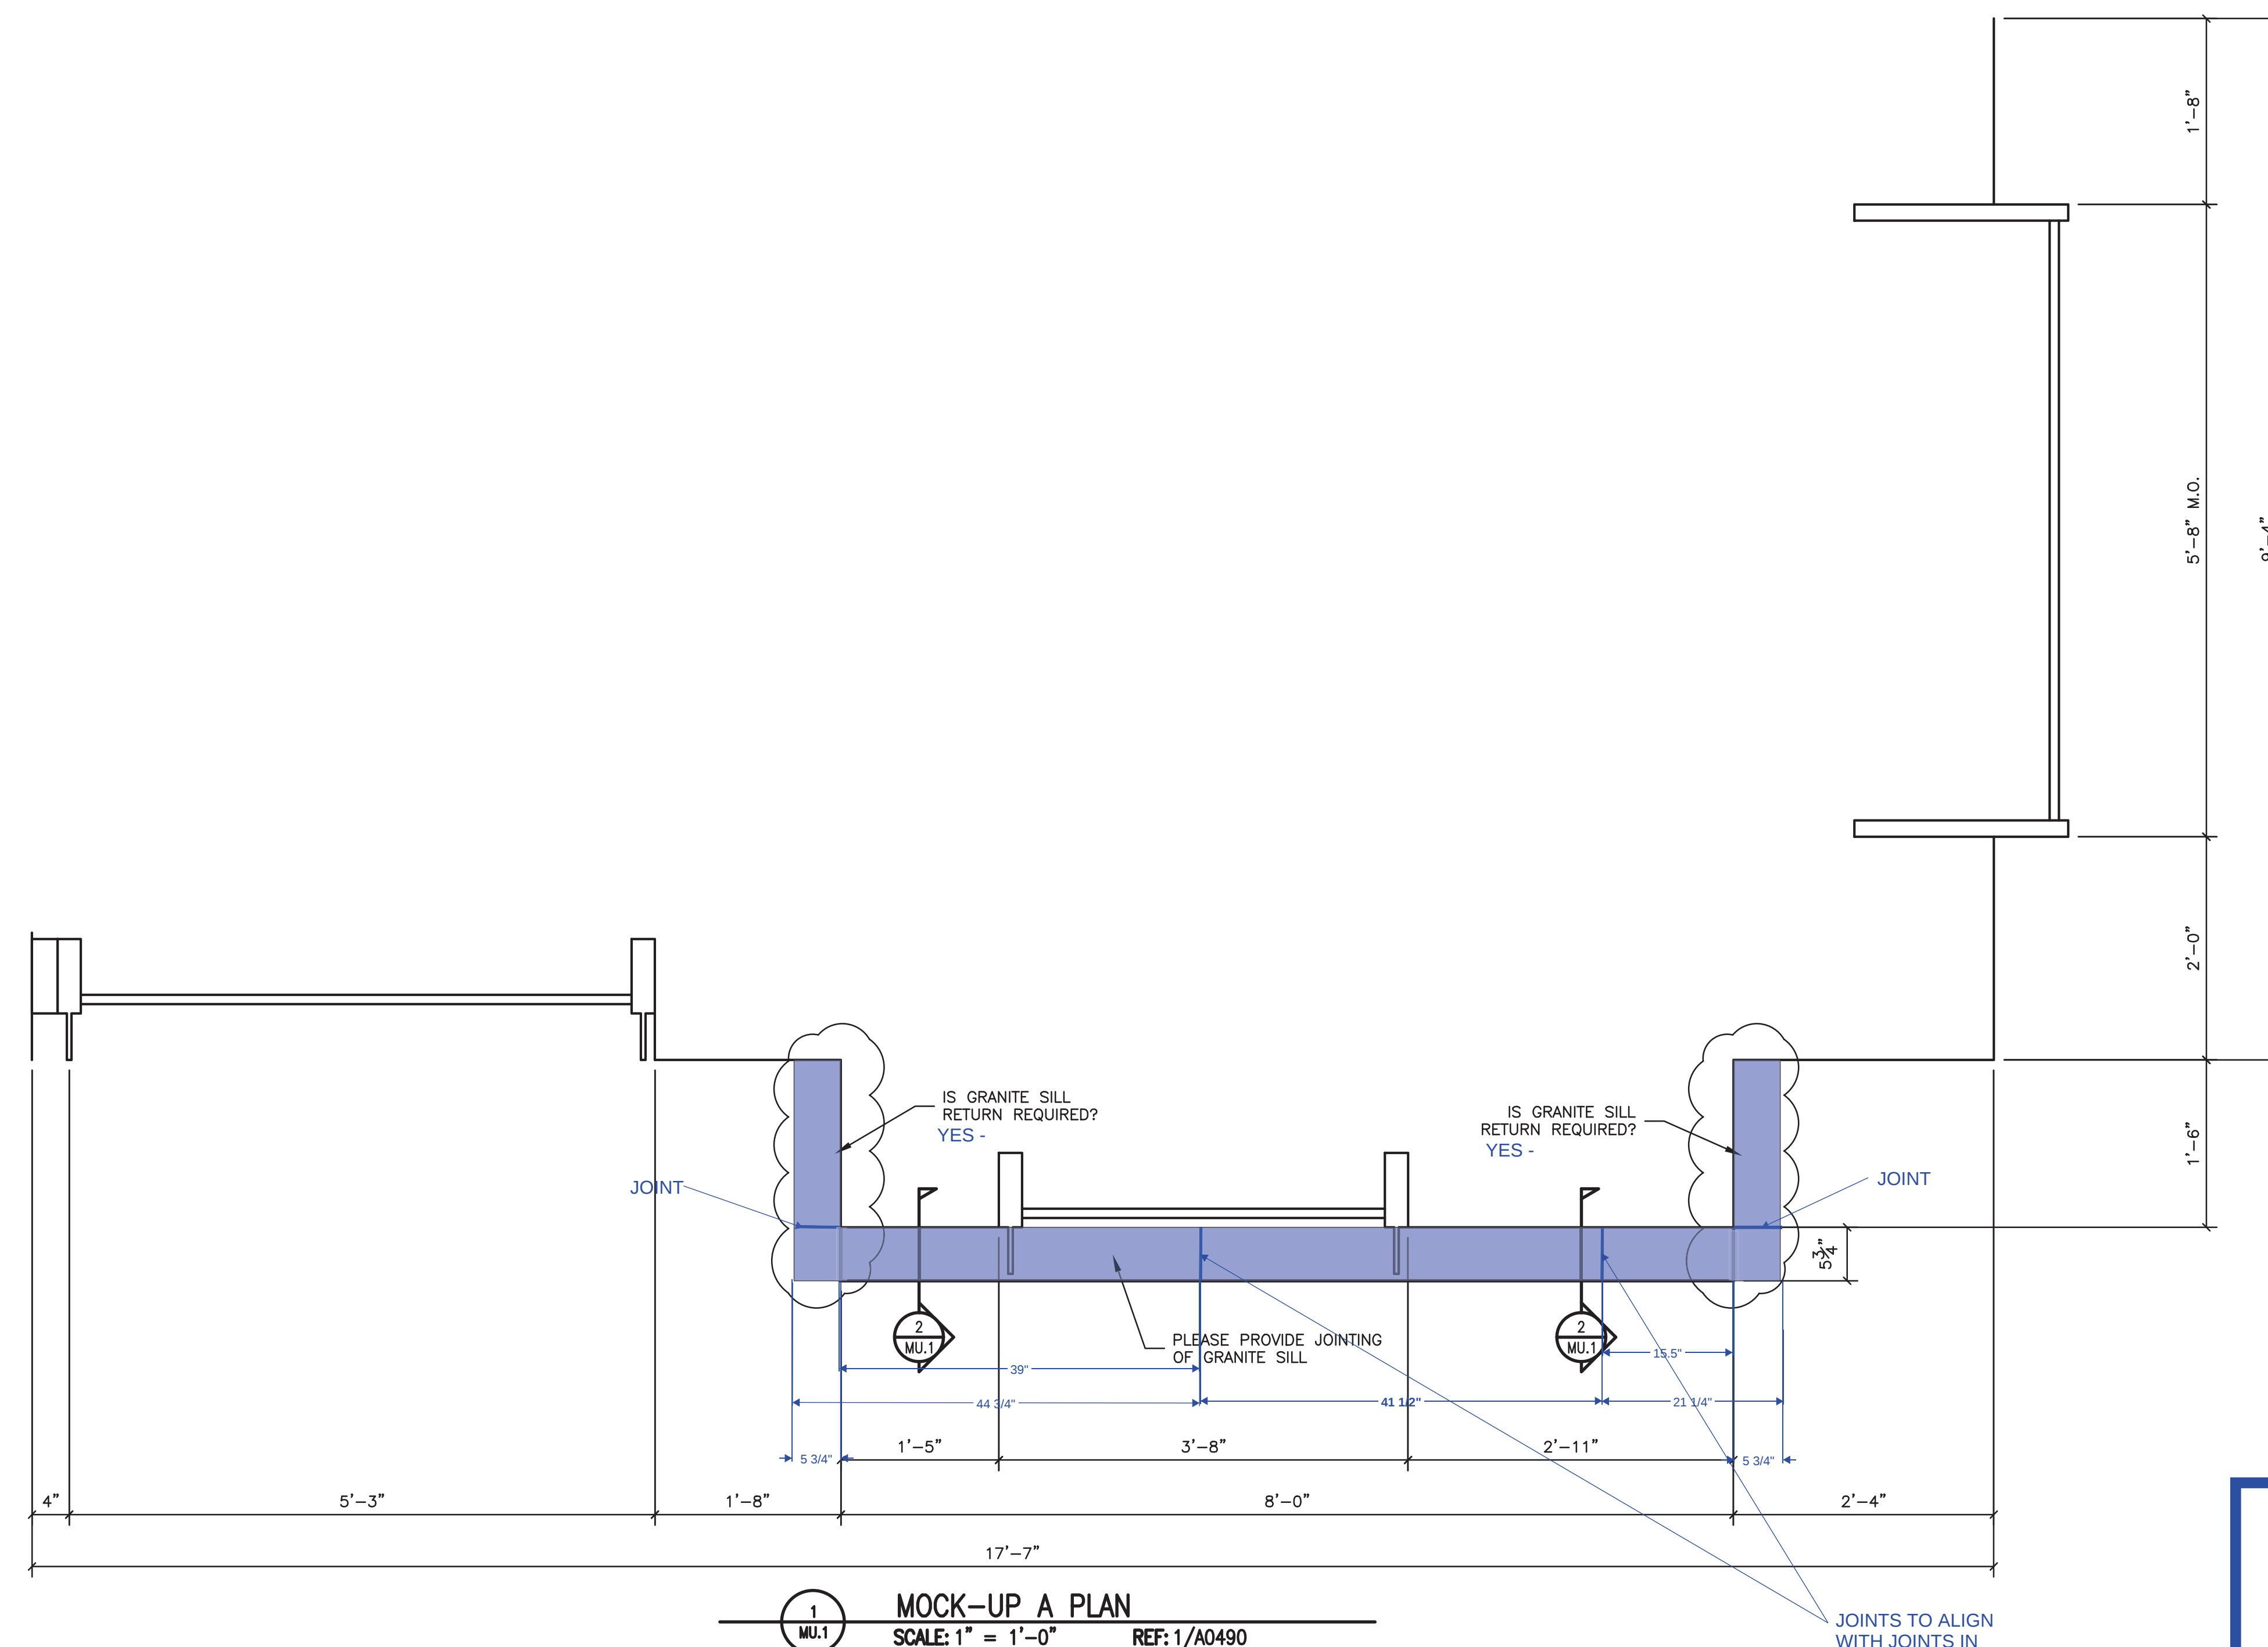

FOR 1ST APPROVAL
Delivery schedule and sequence contingent
upon return date of approved drawings, with
all cutting information. See contract for
specific details. Not for Construction.