

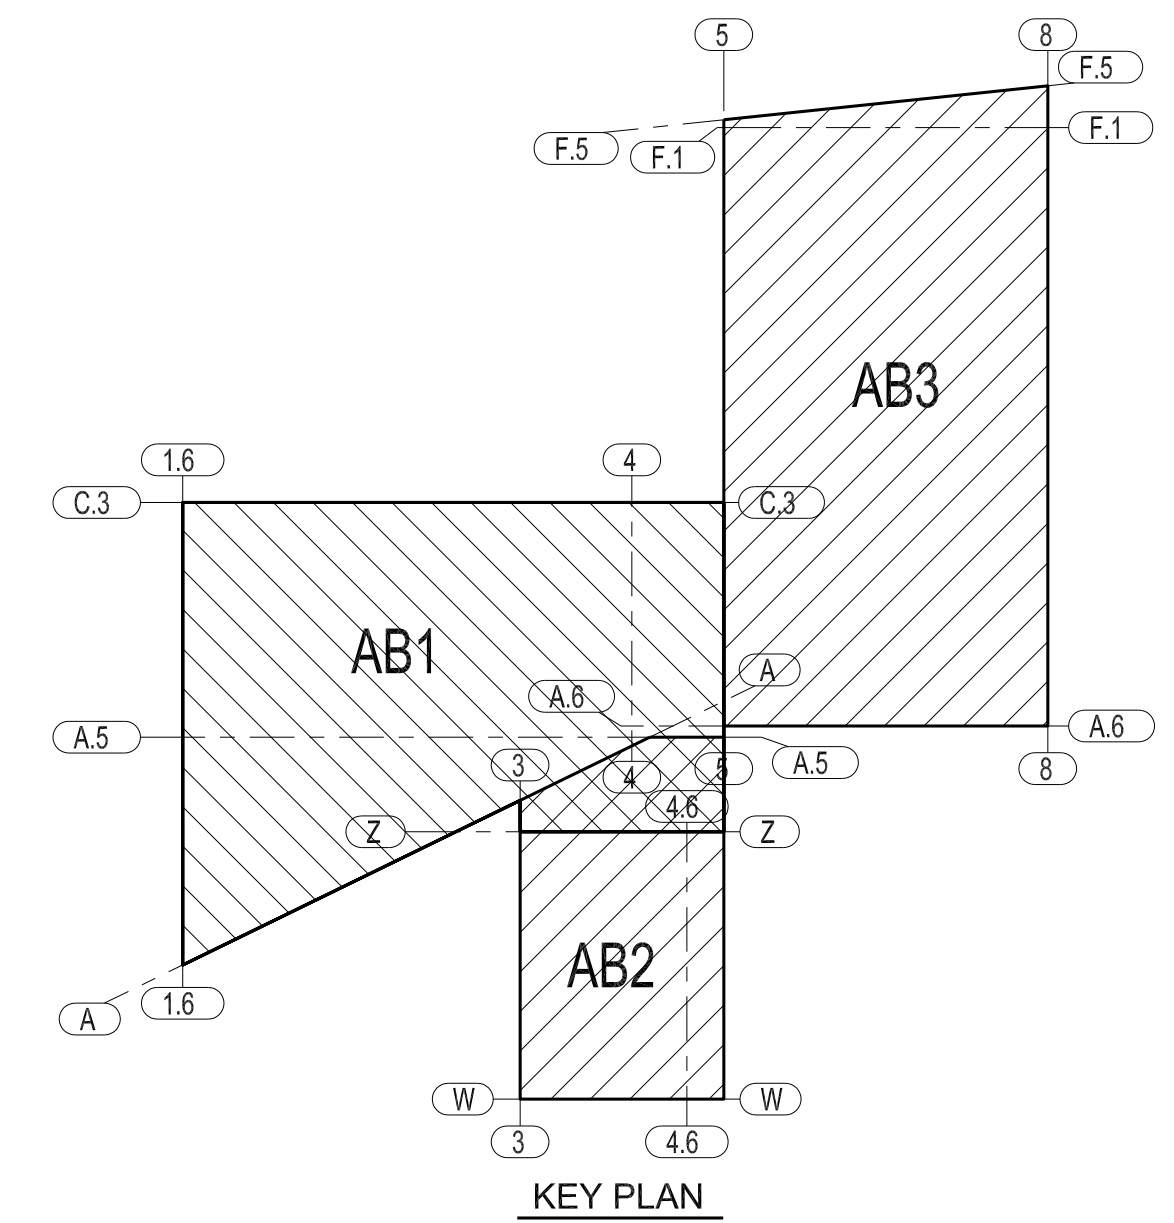


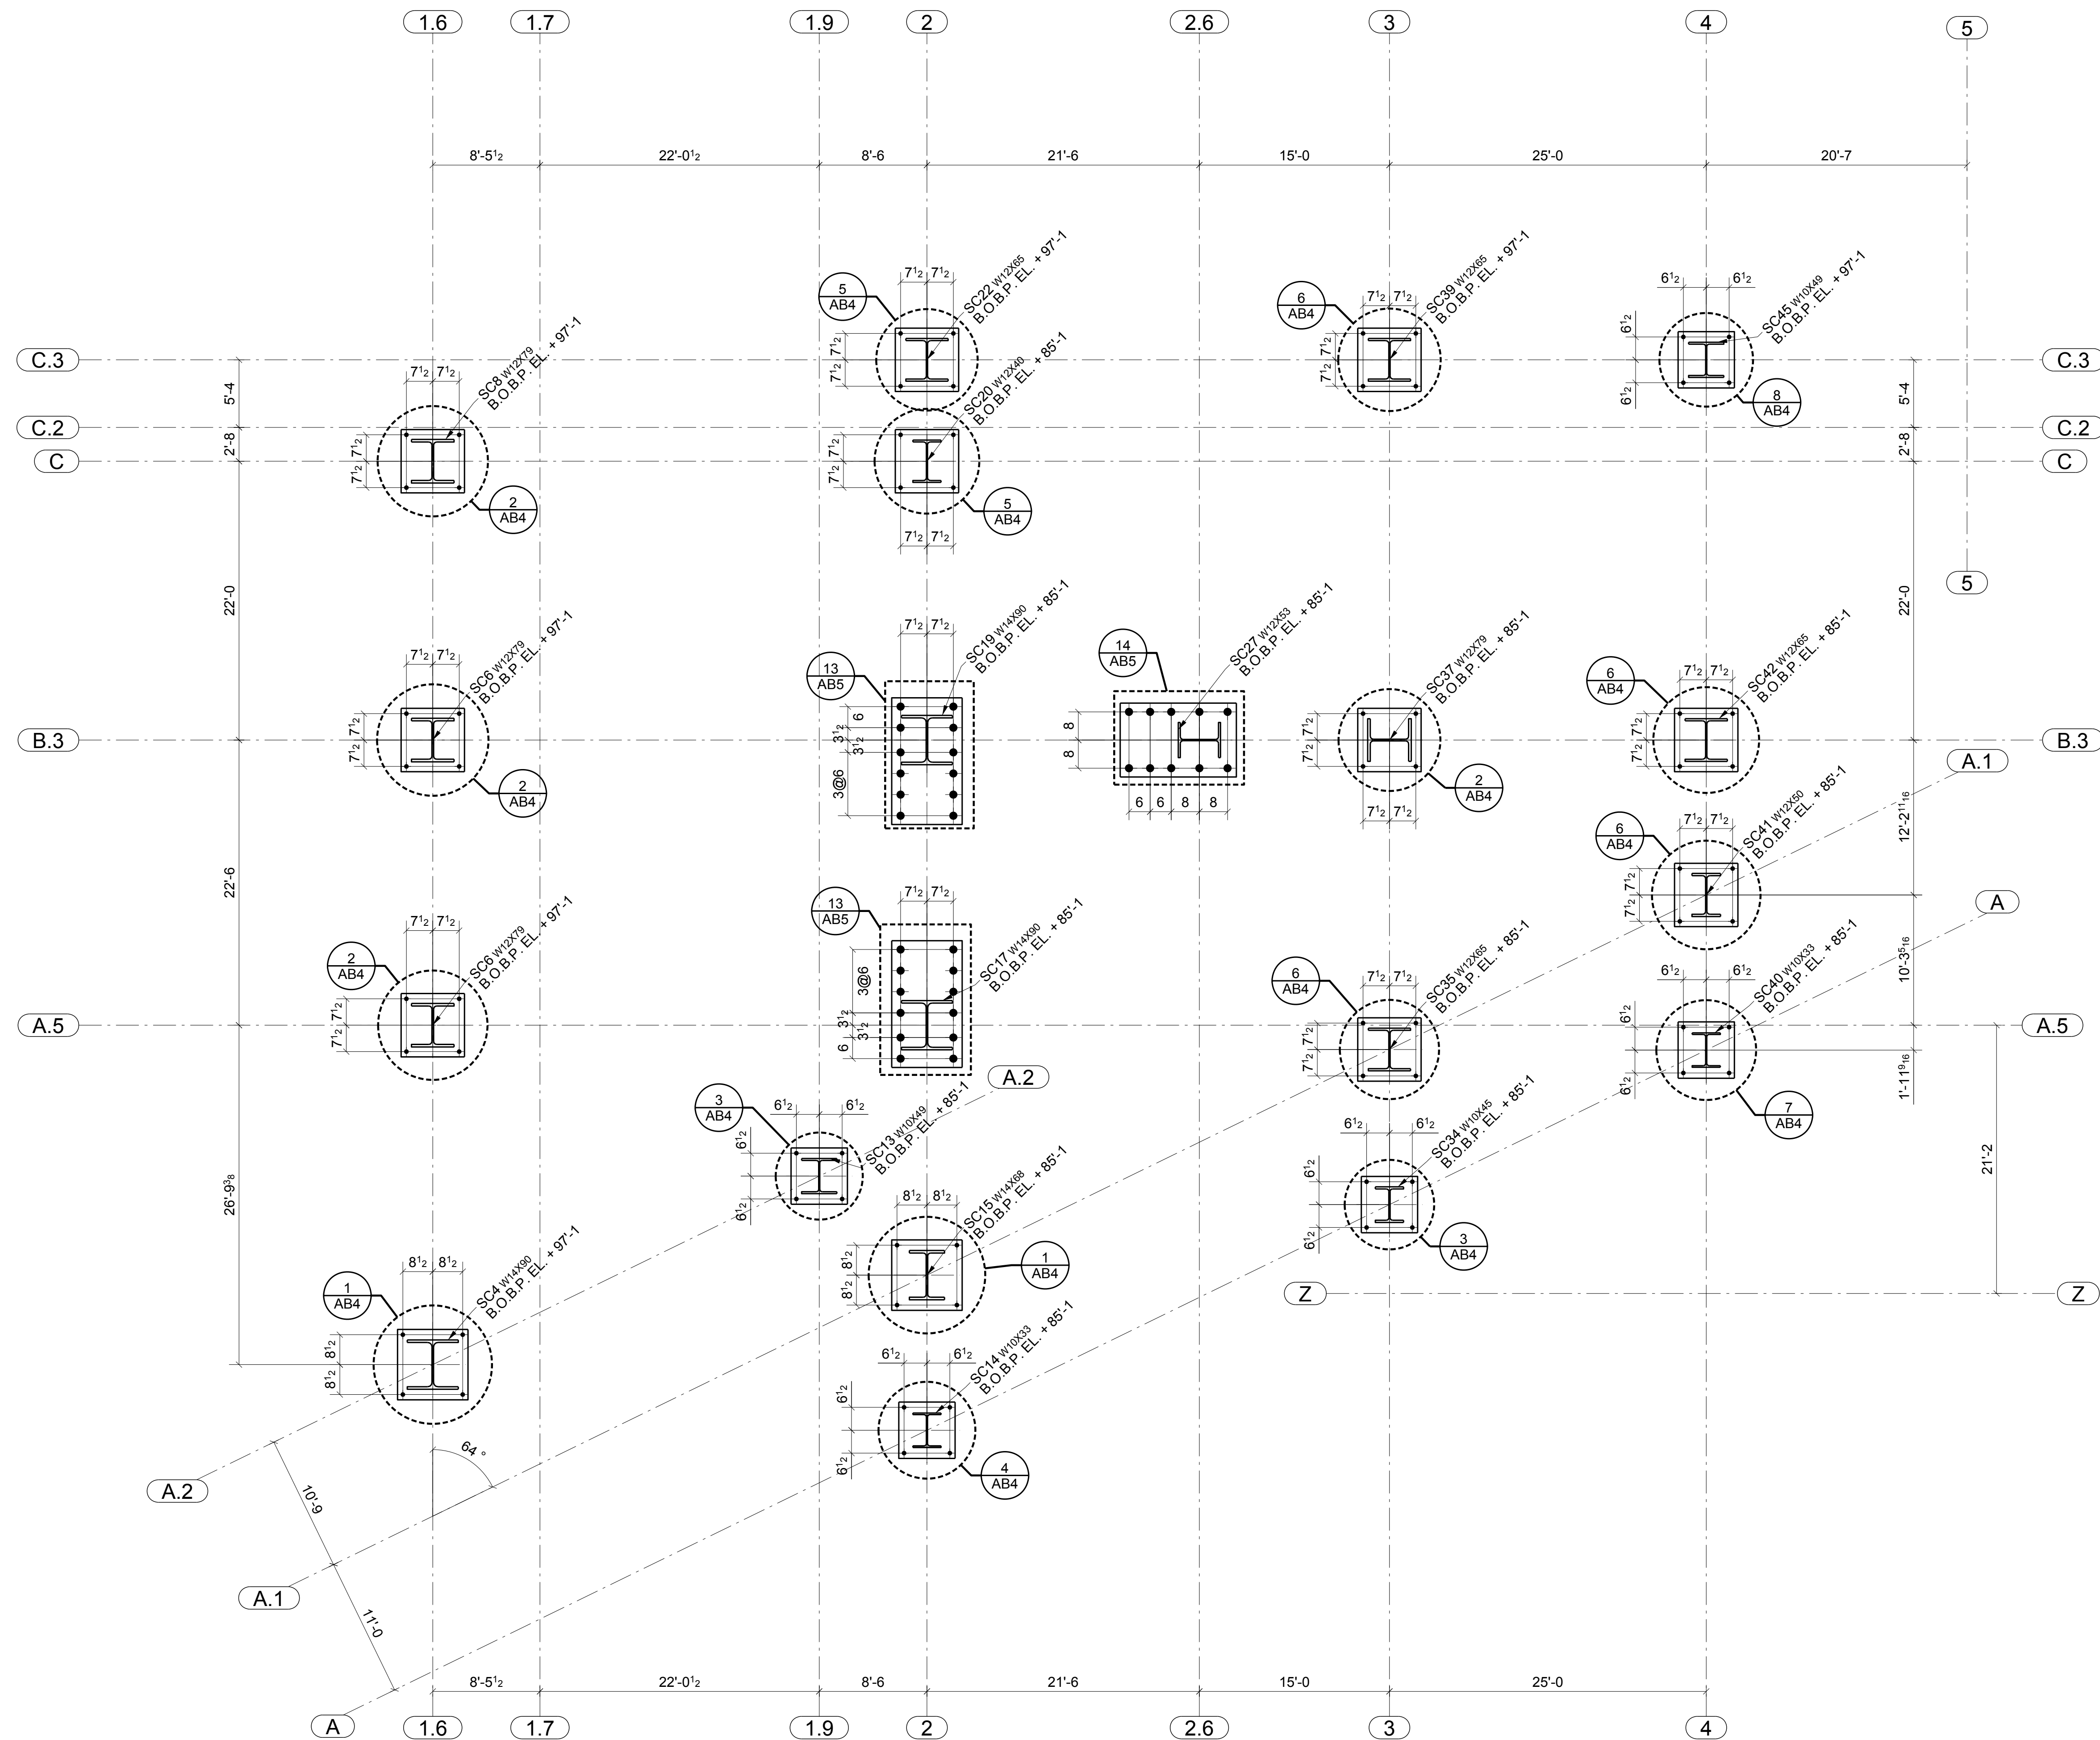

ANCHOR BOLT SETTING PLAN

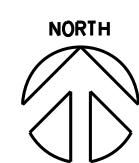


ATLAS IRON WORKS
ST. LOUIS, MO.


Project: WEBSTER UNIVERSITY INTERDISCIPLINARY SCIENCE BUILDING
Customer: PARIC CORPORATION
Owner: WEBSTER UNIVERSITY
Location: WEBSTER GUOVES, MO 63119
Dwn: WT Date: 05/16/2016 Ckd: LJ Date: 05/17/2016
Job No. A16013 BAT: DWG#: AB1

FOR APPROVAL

05/17/16

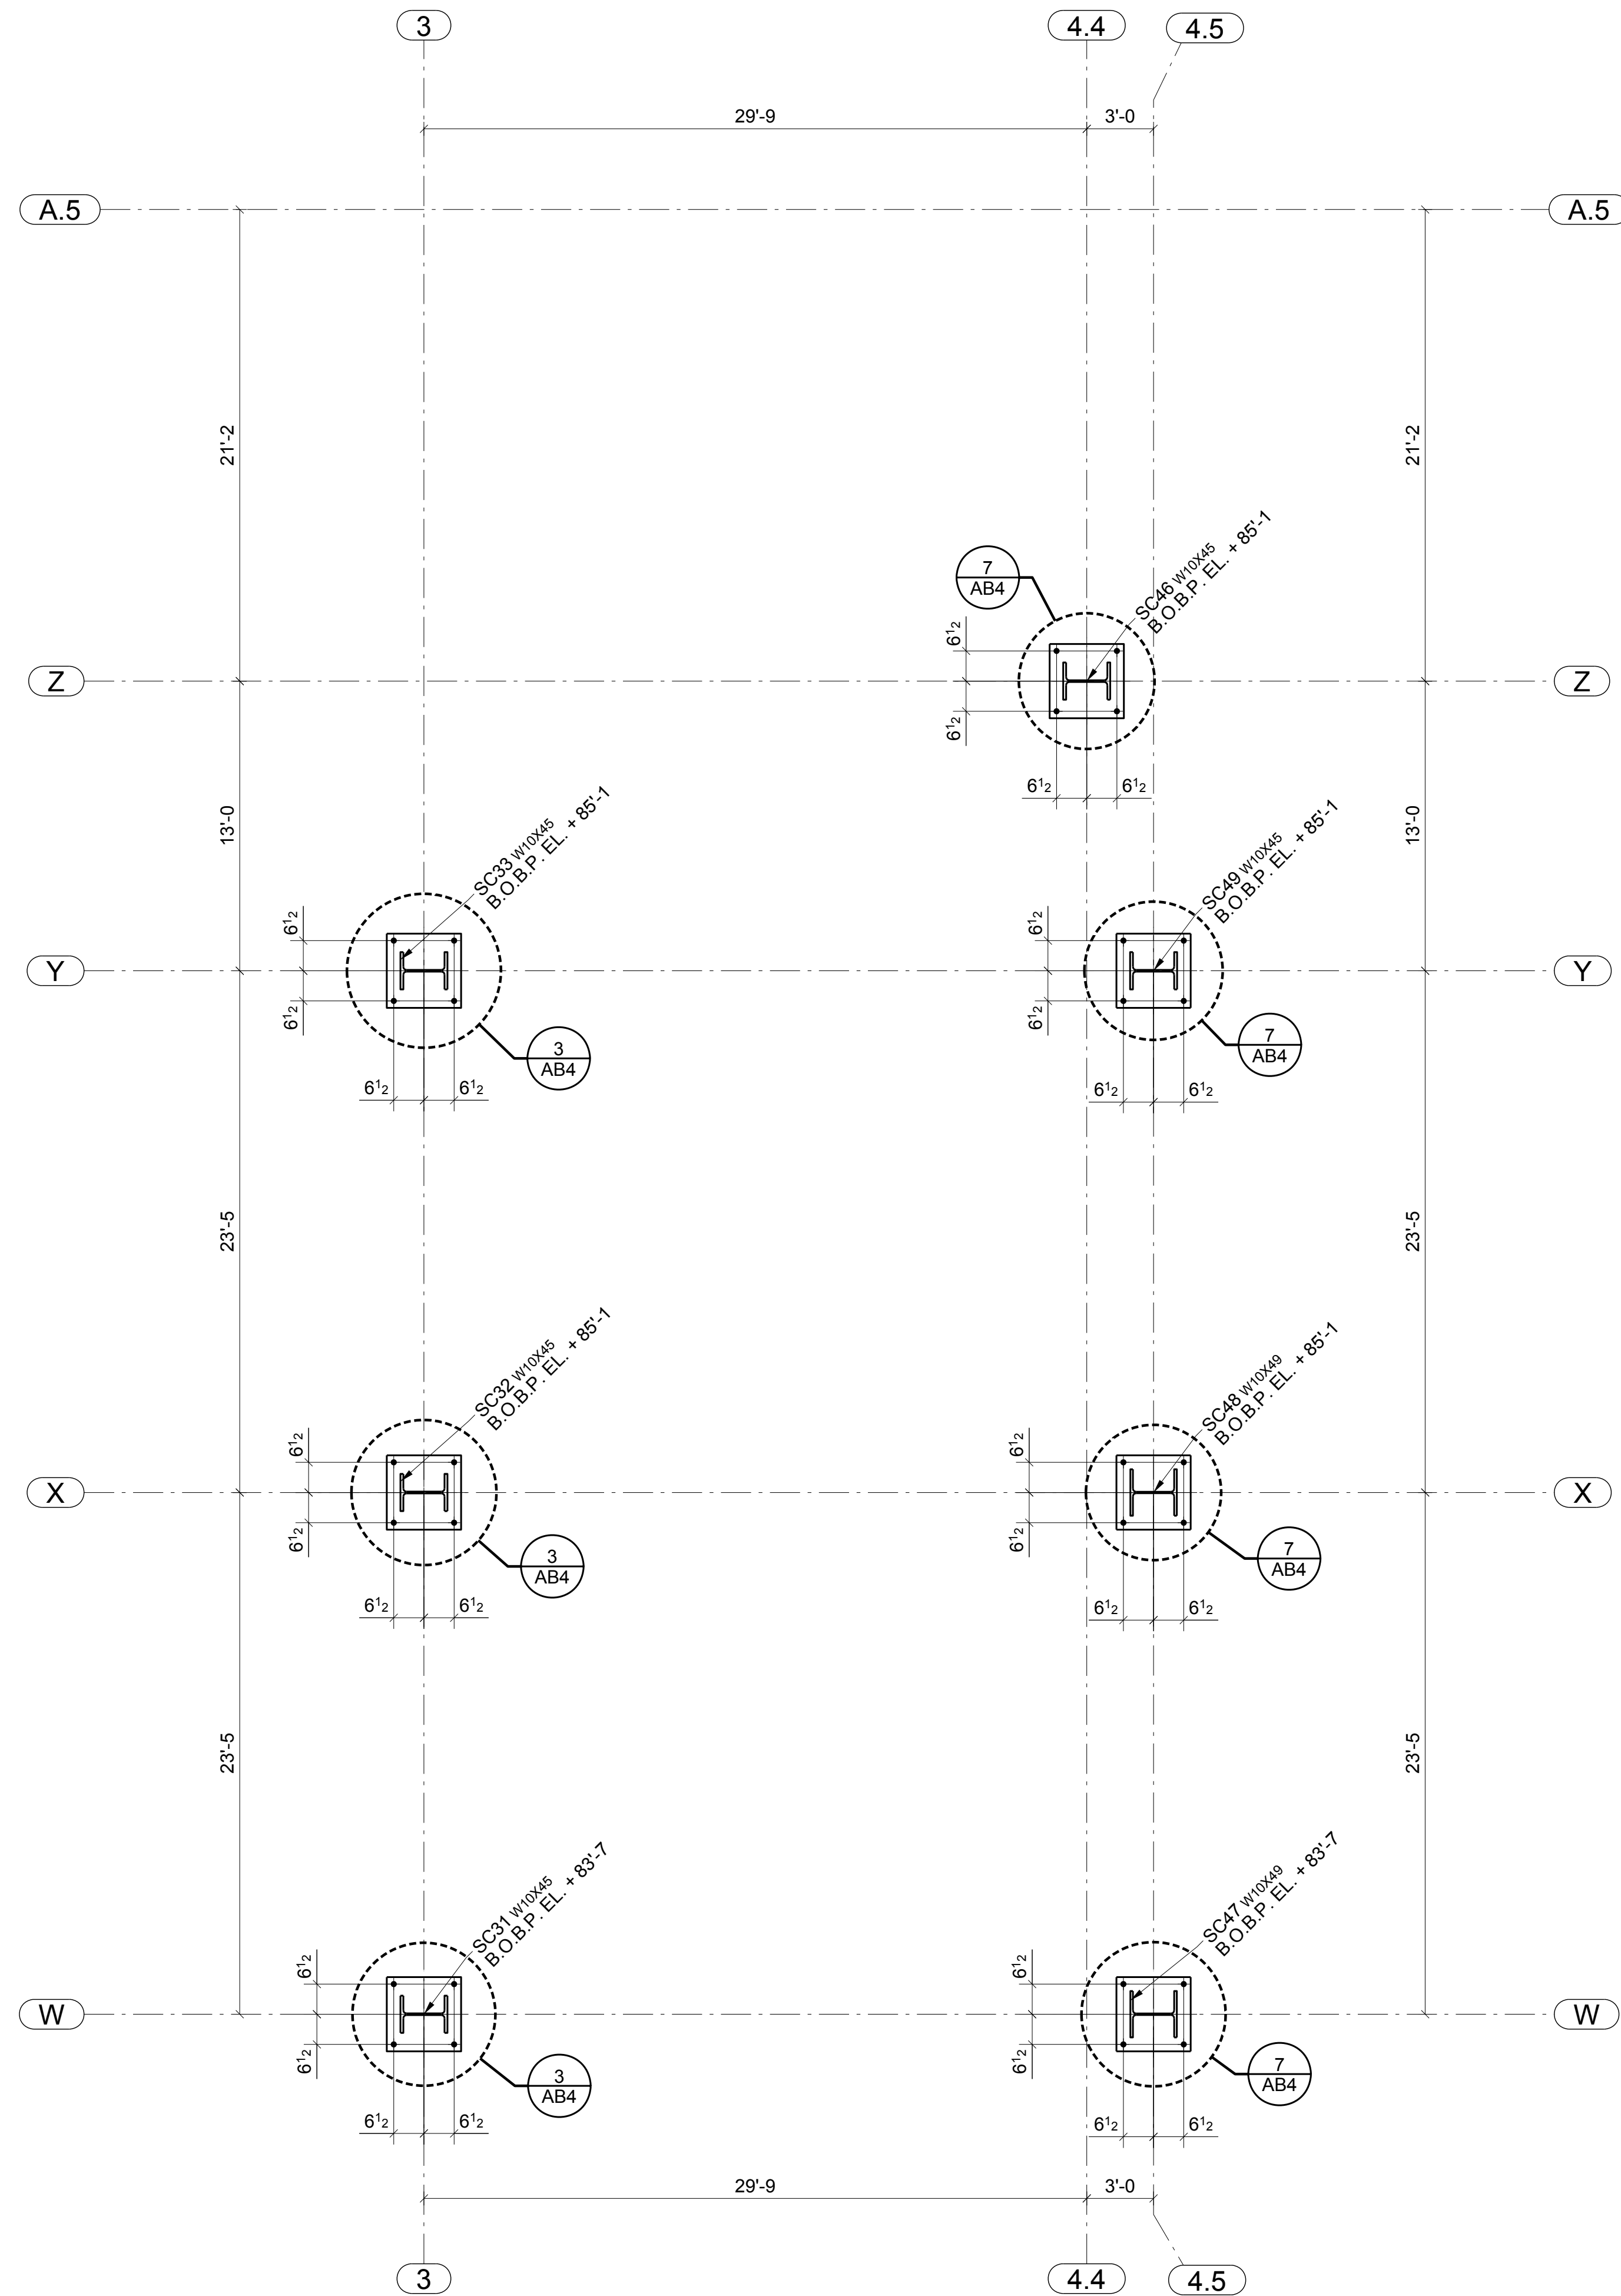

ANCHOR BOLT SETTING PLAN
(REF: S0101)


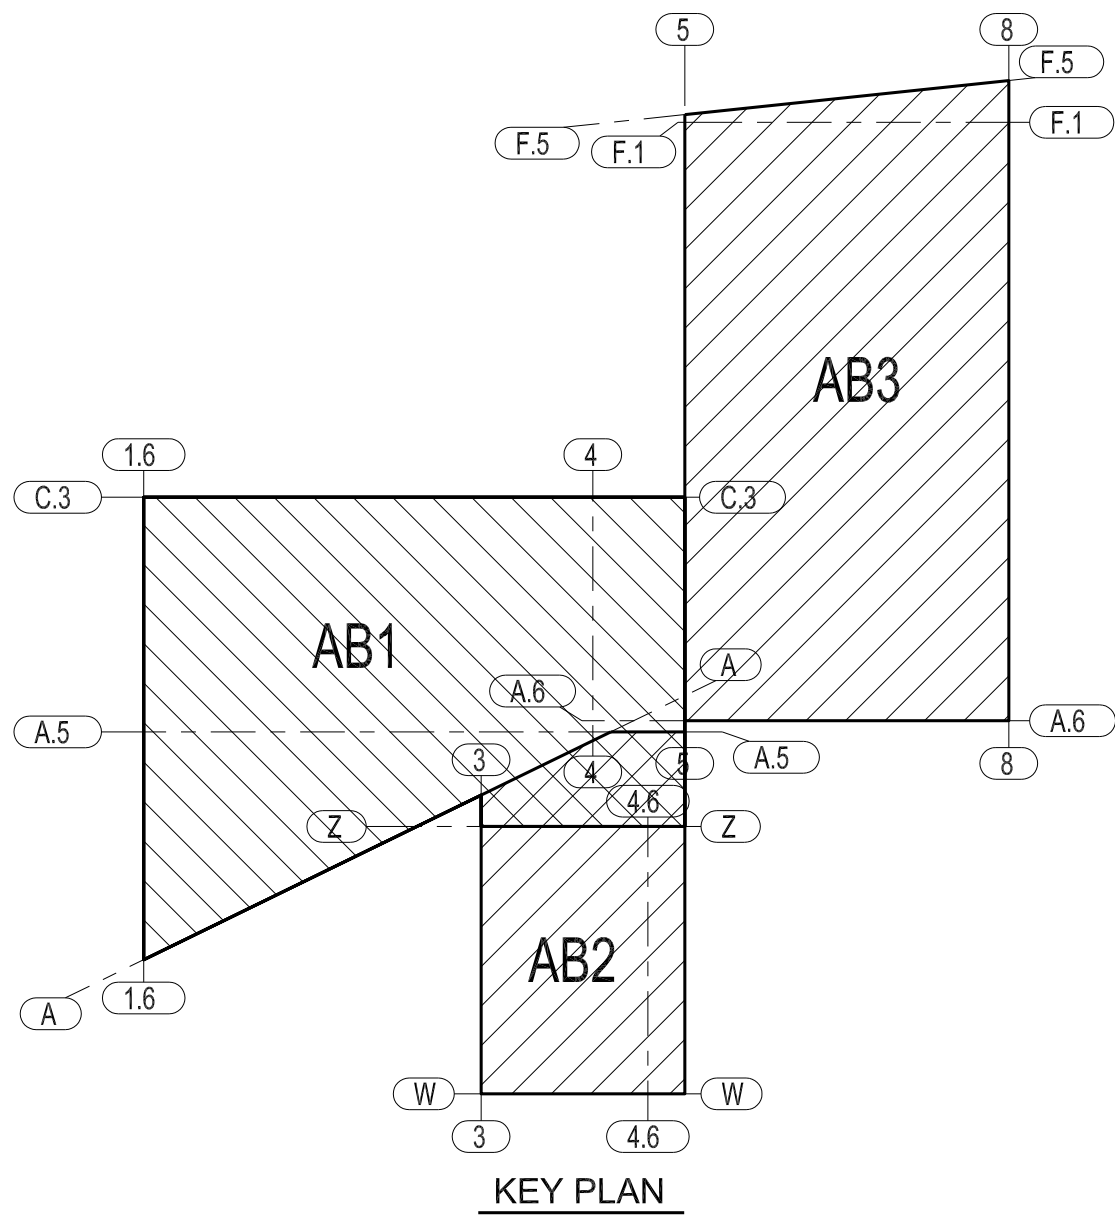


ATLAS IRON WORKS
ST. LOUIS, MO.

Project: WEBSTER UNIVERSITY INTERDISCIPLINARY SCIENCE BUILDING
Customer: PARIC CORPORATION
Owner: WEBSTER UNIVERSITY
Location: WEBSTER GUOVES, MO 63119
Dwn: WT Date: 05/17/2016 Ckd: LJ Date: 05/17/2016
Job No. A16013 BAT: DWG#: AB2

FOR APPROVAL

05/17/16

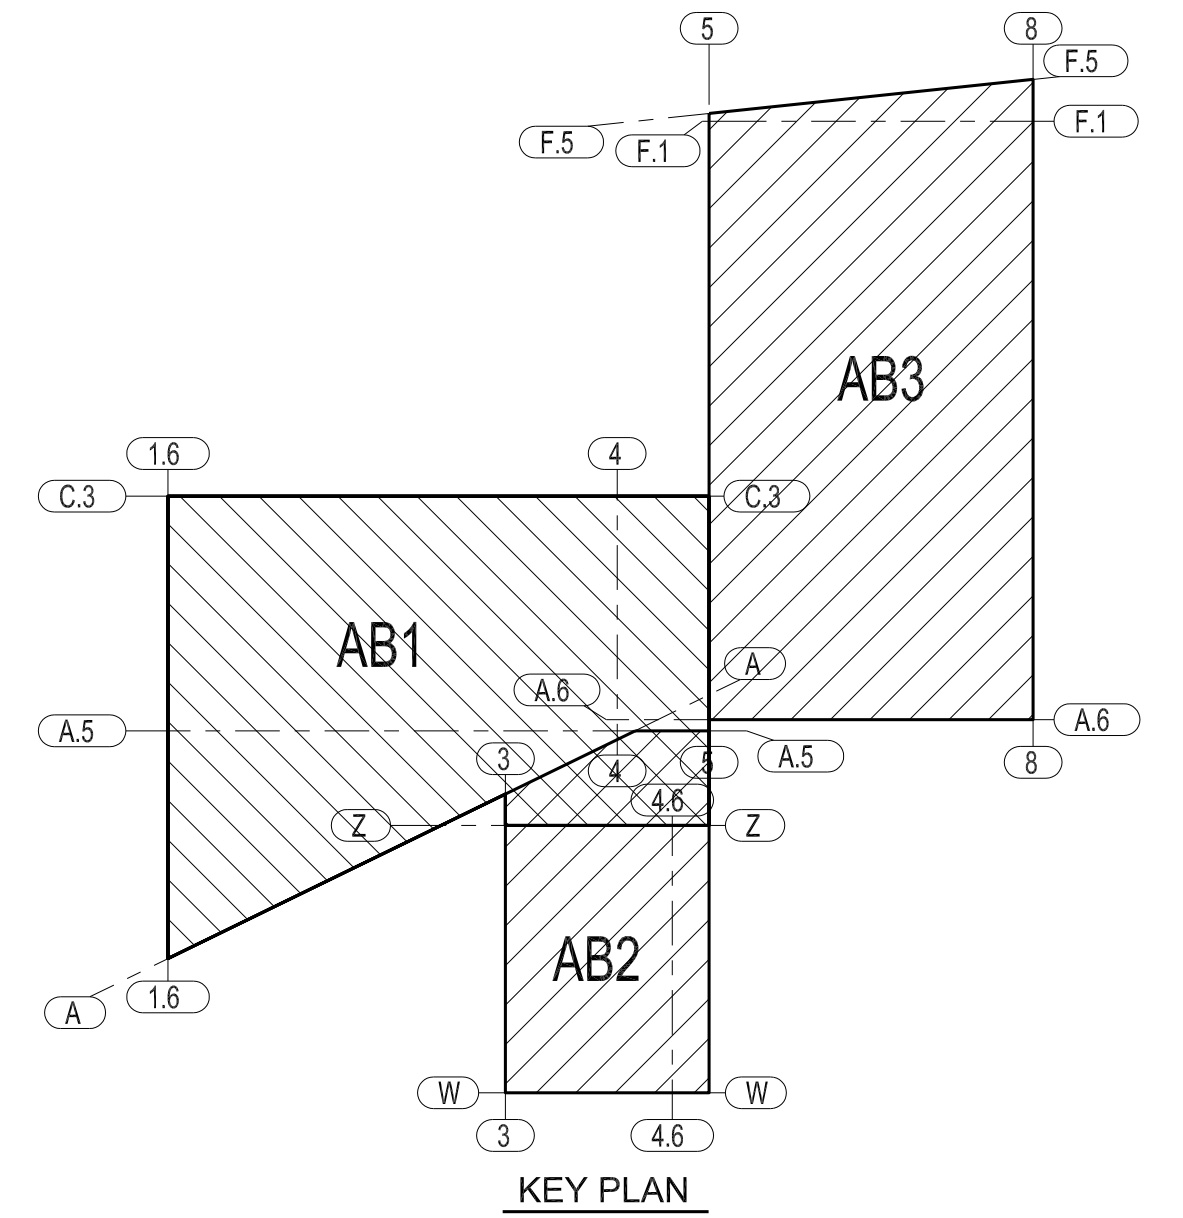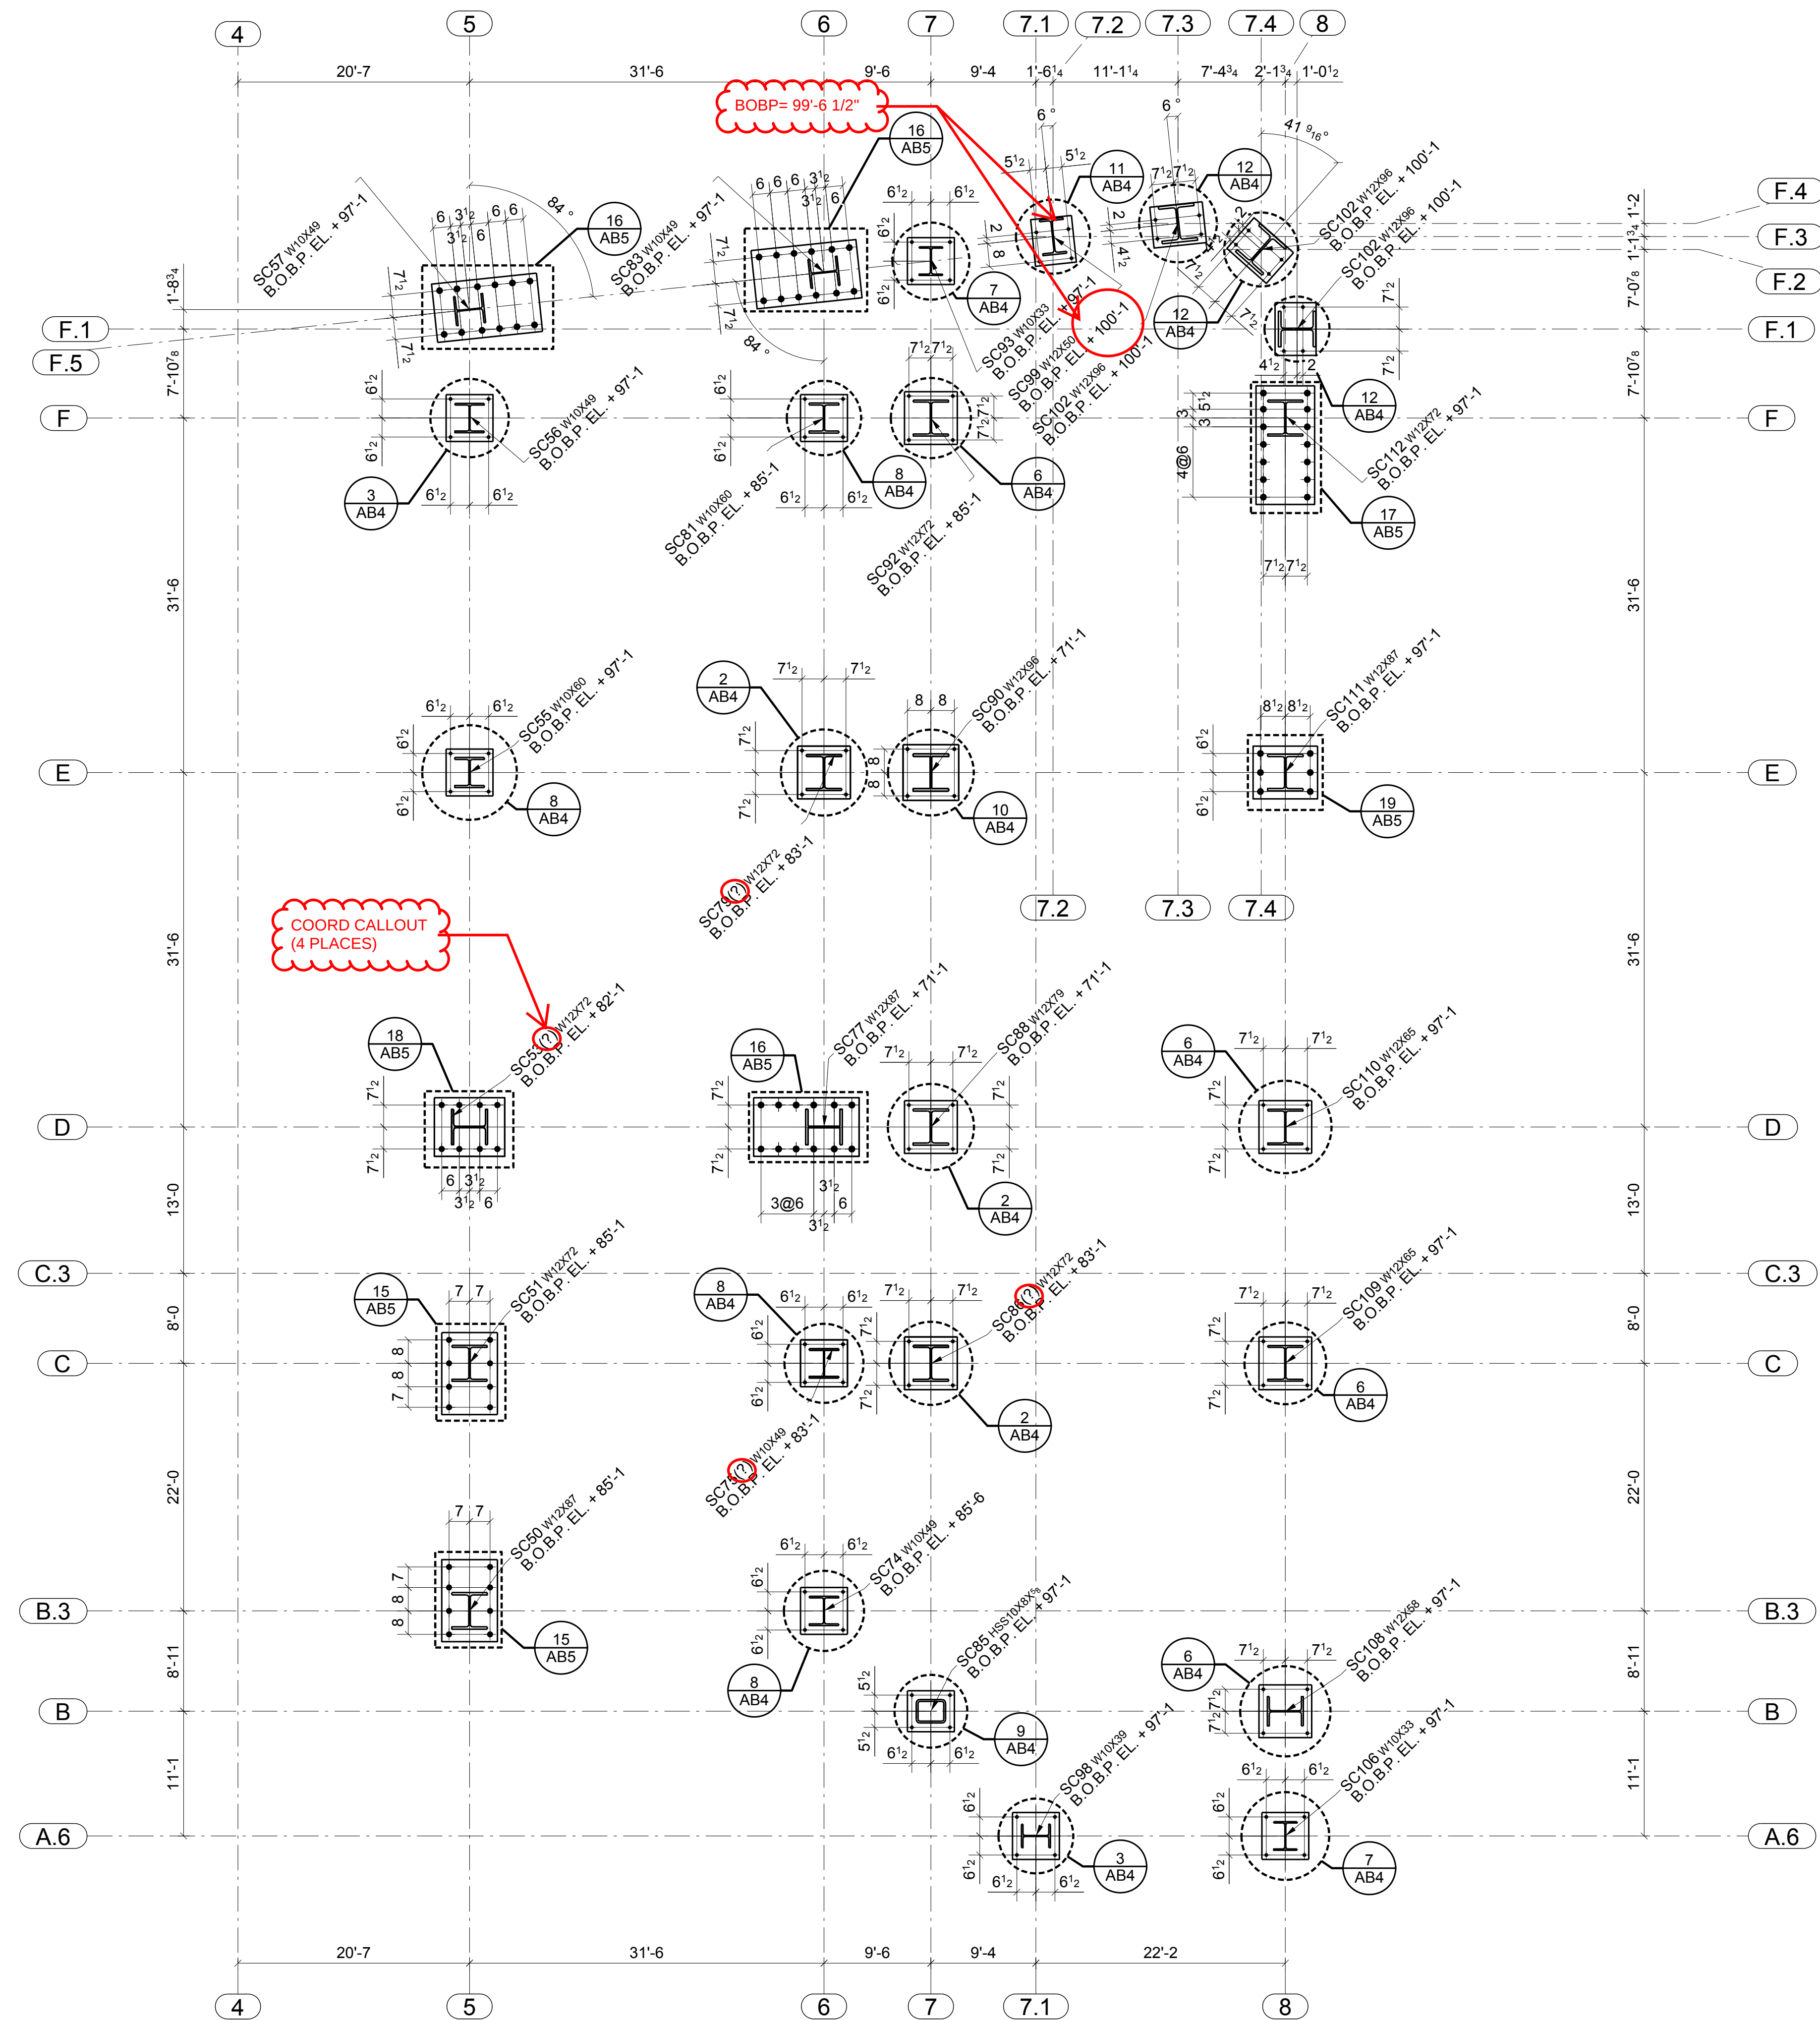


ANCHOR BOLT SETTING PLAN
(REF: S0101)




ATLAS IRON WORKS ST. LOUIS, MO.

Project: WEBSTER UNIVERSITY INTERDISCIPLINARY SCIENCE BUILDING
Customer: PARIC CORPORATION
Owner: WEBSTER UNIVERSITY
Location: WEBSTER GUOVES, MO 63119
Dwn: WT Date: 05/17/2016 Ckd: LJ Date: 05/17/2016
Job No. A16013 BAT: DWG#: AB3

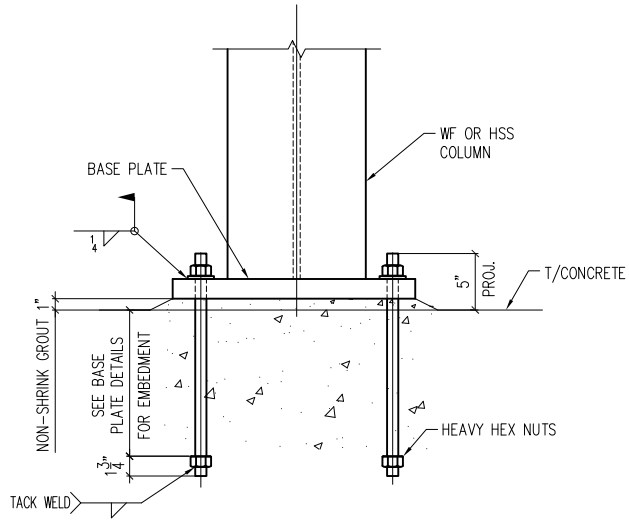


TYPICAL BASE PLATE DETAIL. U.N.O.

(REF: S0503)

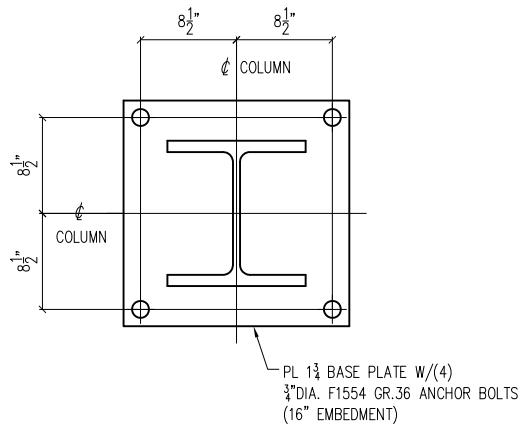


DETAIL 1

(REF: S0503)

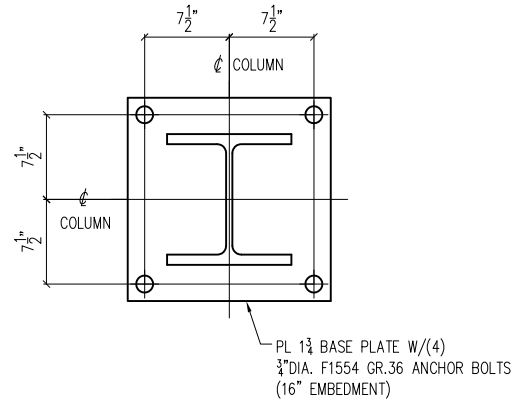


DETAIL 2

(REF: S0503)

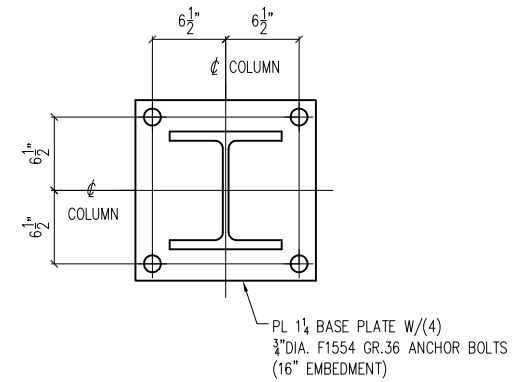


DETAIL 3

(REF: S0503)

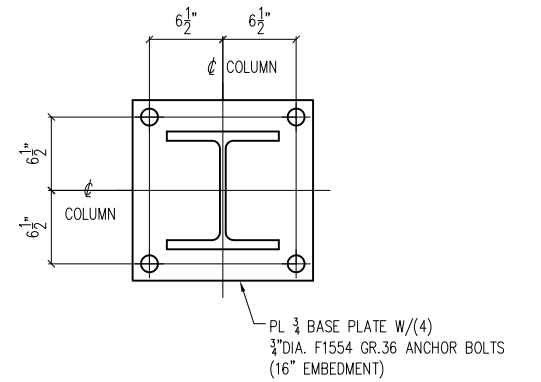


DETAIL 4

(REF: S0503)

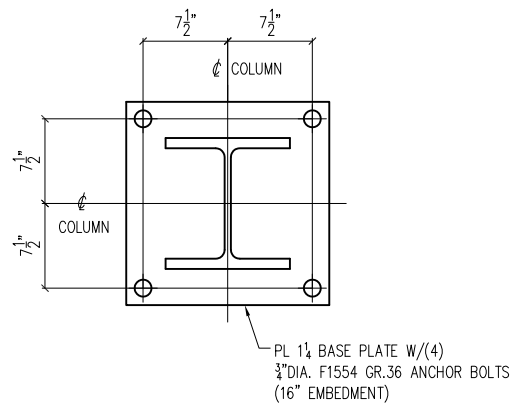


DETAIL 5

(REF: S0503)

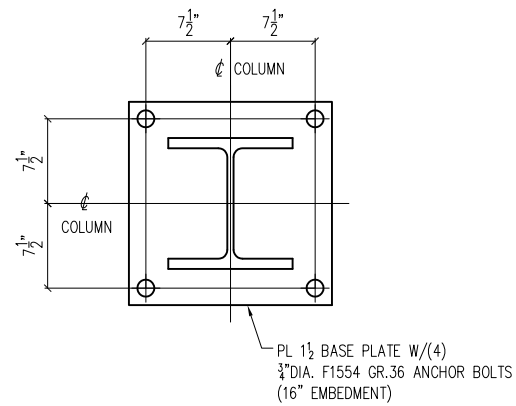


DETAIL 6

(REF: S0503)

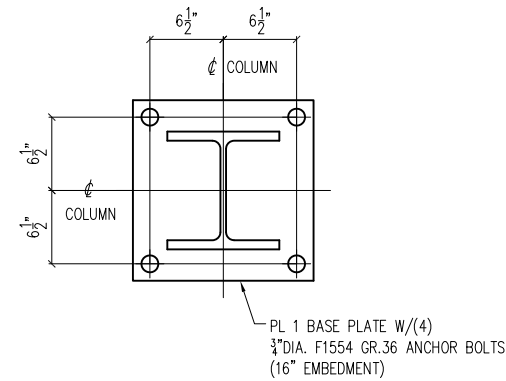


DETAIL 7

(REF: S0503)

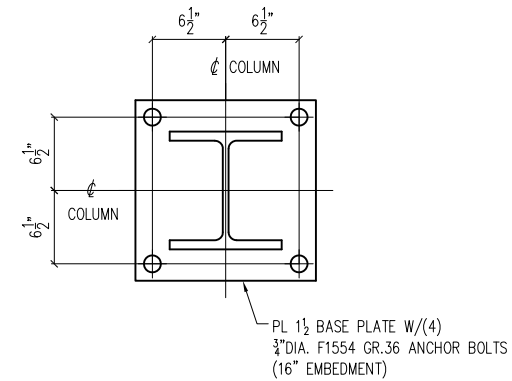


DETAIL 8

(REF: S0503)

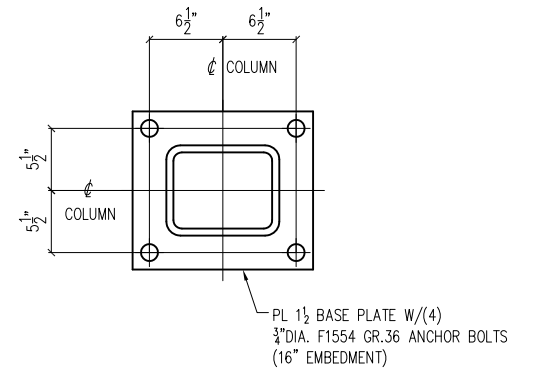


DETAIL 9

(REF: S0503)

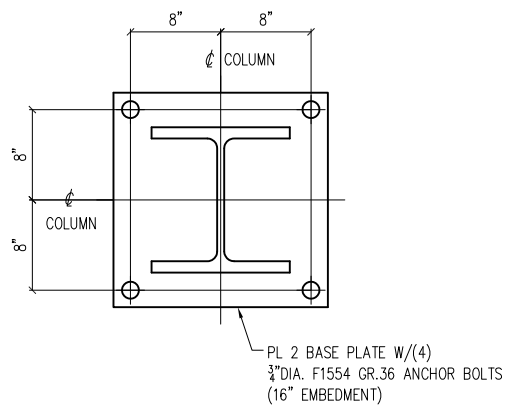


DETAIL 10

(REF: S0503)

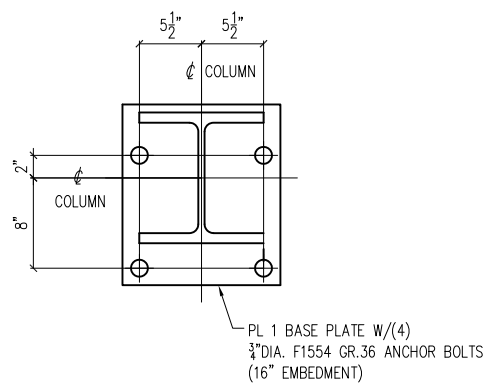

DETAIL 11

(REF: S0503)

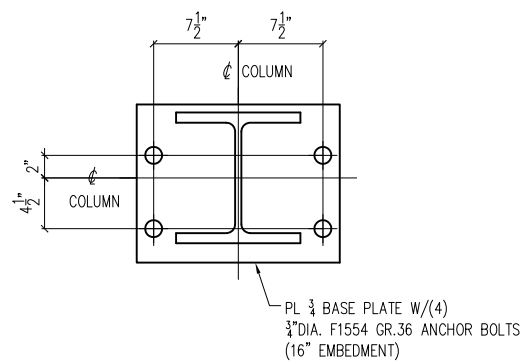

DETAIL 12

(REF: S0503)

PROVIDE ANCHOR ROD
ASSEMBLY CALLOUTS.
VERIFY ALL ASSEMBLIES
THIS SHEET ARE "12A"

NOTE:
1. COLUMN DIRECTION SEE PLAN.



Romac By: _____	Checked By: _____
Beamline By: _____	Checked By: _____
ATLAS IRON WORKS ST. LOUIS, MO.	
Project: WEBSTER UNIVERSITY INTERDISCIPLINARY SCIENCE BUILDING	
Customer: PARIC CORPORATION	
Owner: WEBSTER UNIVERSITY	
Location: WEBSTER GUVES, MO 63119	
Dwn: WT	Date: 05/17/16 Ckd: LJ Date: 05/17/16
Job No. A16013	BAT: _____ DWG#: AB4








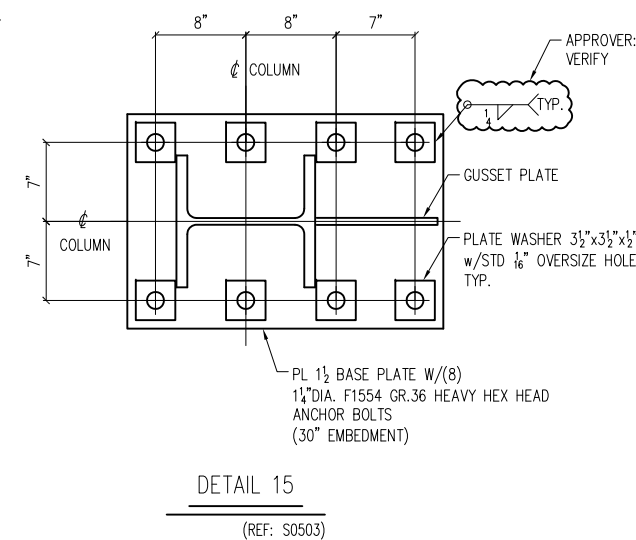


PLATE WASHERS ARE FIELD WELDED TYPICAL

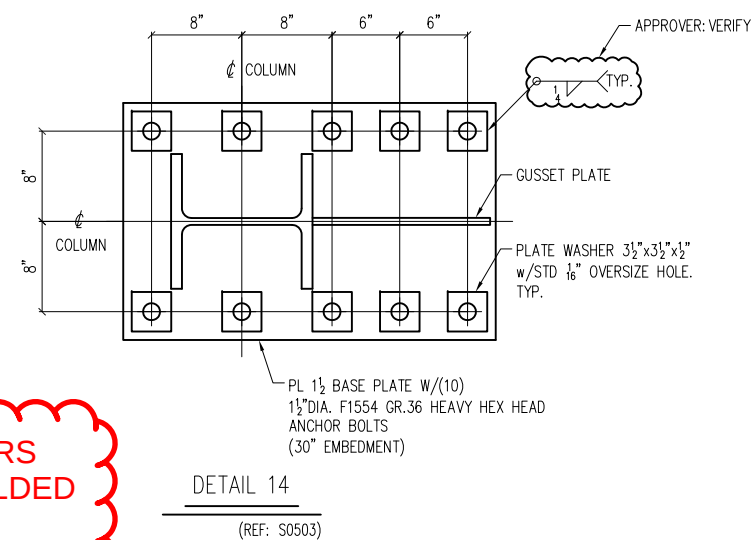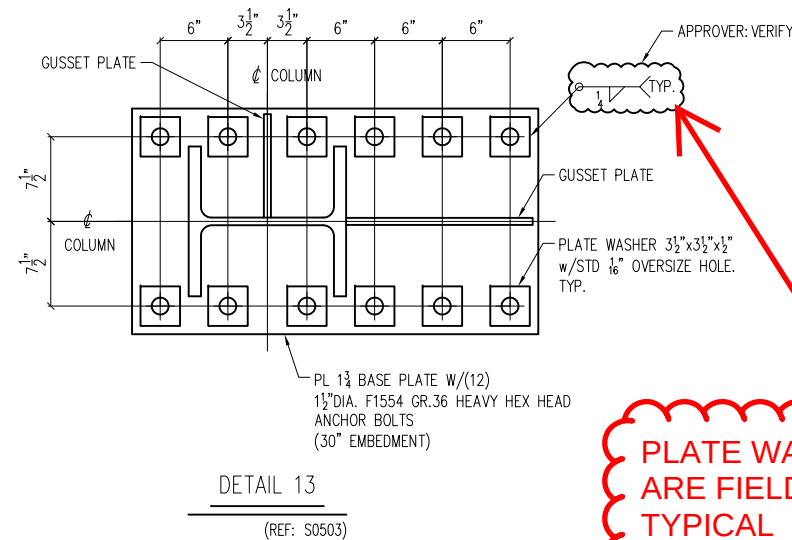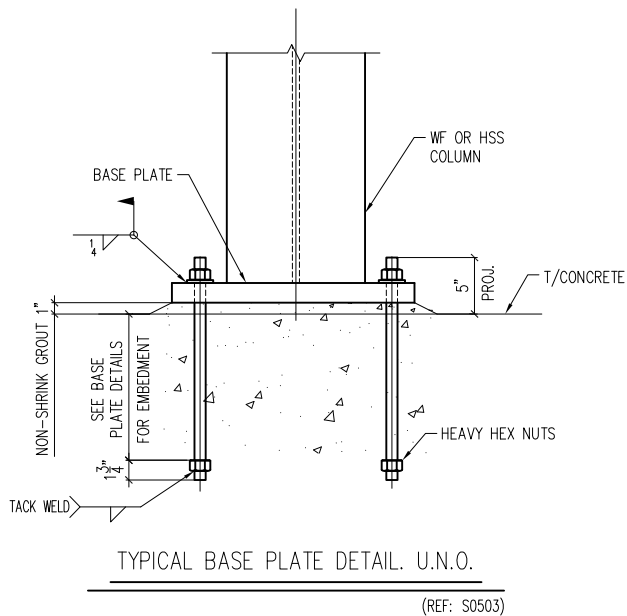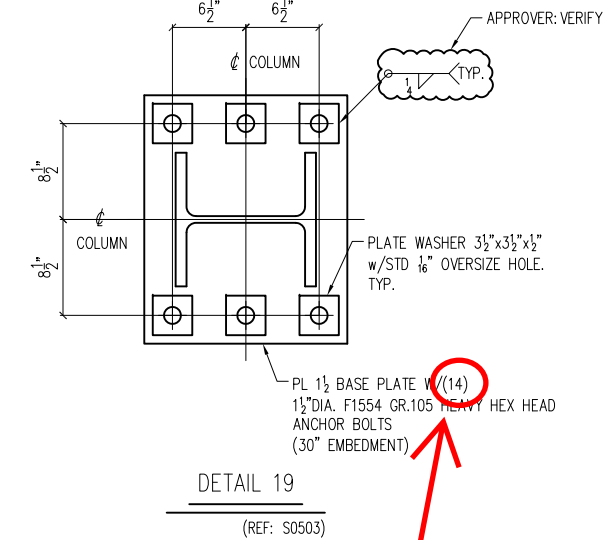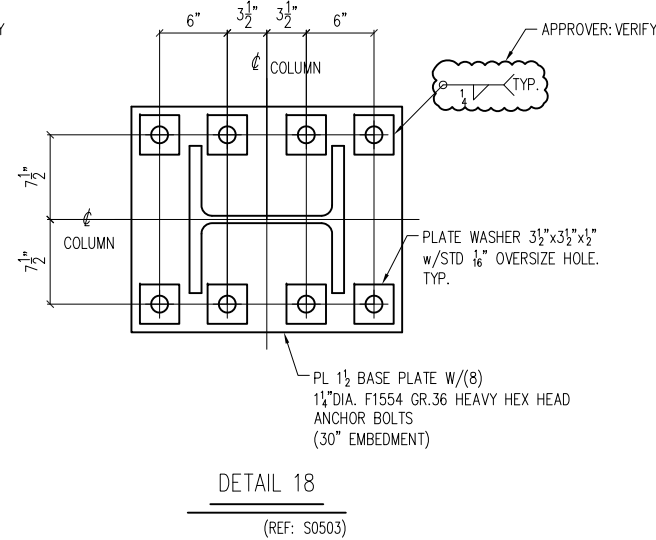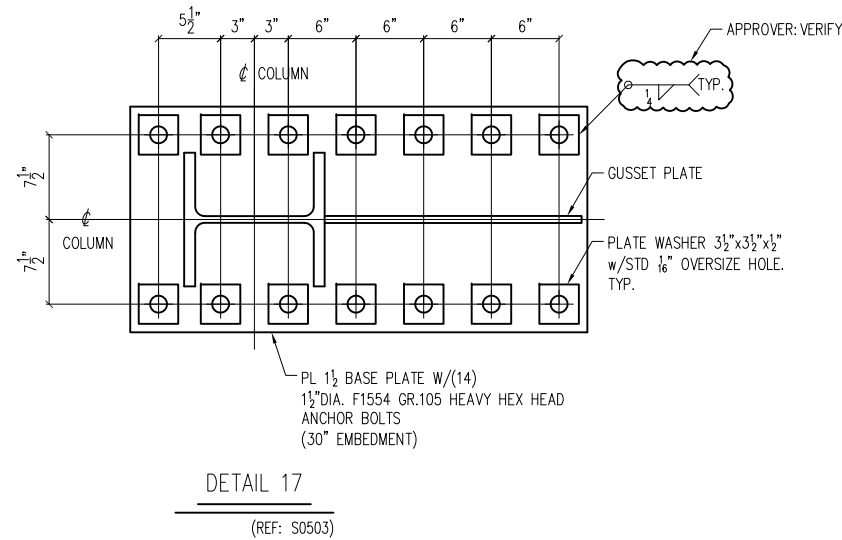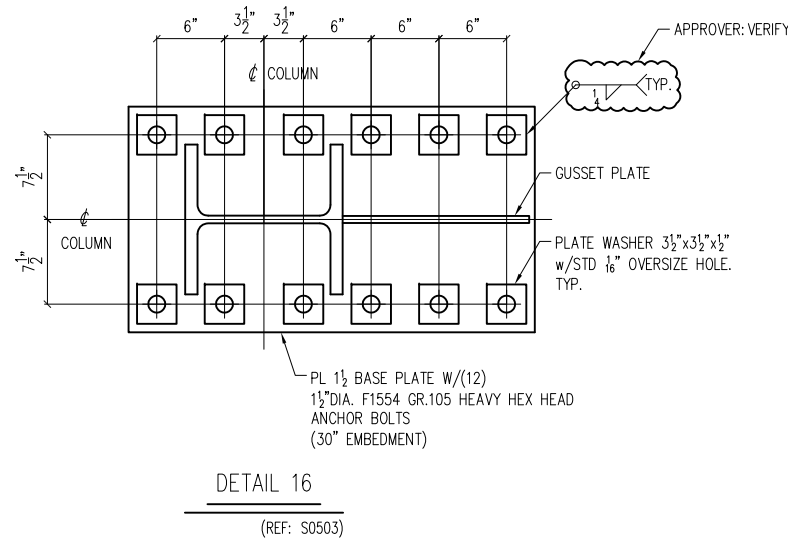


PROVIDE ANCHOR ROD ASSEMBLY CALLOUTS FROM DWG #12

QUANTITY = 6

NOTE:
1. COLUMN DIRECTION SEE PLAN.

FOR APPROVAL 05-17-16

Romac By: _____	Checked By: _____
Beamline By: _____	Checked By: _____
ATLAS IRON WORKS ST. LOUIS, MO.	
Project: WEBSTER UNIVERSITY INTERDISCIPLINARY SCIENCE BUILDING	
Customer: PARIC CORPORATION	
Owner: WEBSTER UNIVERSITY	
Location: WEBSTER GROVES, MO 63119	
Dwn: WT	Date: 05/17/16 Ckd: LJ Date: 05/17/16
Job No. A16013	BAT: _____ DWG#: AB5

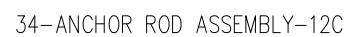

Roman By: _____ Checked By: _____

Beamline By: _____ Checked By: _____

ATLAS IRON WORKS

ST. LOUIS, MO.

Project: WEBSTER UNIVERSITY INTERDISCIPLINARY SCIENCE BUILDING

Customer: PARIC CORPORATION

Owner: WEBSTER UNIVERSITY

Location: WEBSTER GUOVES, MO 63119

Dwn: WT Date: 05/17/16 Ckd: LJ Date: 01/17/16

Job No. A16013 BAT: _____ DWG#: 12

SUBMITTAL IDENTIFICATION SHEET

To be completed by Contractor/CM

PROJECT NAME	
ADDRESS	
NUMBER	
OWNER	
ARCHITECT / ENGINEER	
SUBMITTED BY	
CONTRACTOR / CM SUBMITTAL NO.	CANNON DESIGN SUBMITTAL NO.
DRAWING / DETAIL REFERENCE	SPECIFICATION SECTION / PARAGRAPH
MANUFACTURER / SUPPLIER	ITEM / PRODUCT ID
REQUIRED DATE	PRIORITY
☐ CRITICAL	

ITEM BEING SUBMITTED (check only one)

- | | | |
|---|--|--|
| ☐ Shop Drawings | ☐ Certification / Qualifications | ☐ Coordination Drawing |
| ☐ Samples (____ copies) | ☐ Record Documents | ☐ Calculations |
| ☐ LEED Submittal | ☐ Product Data | ☐ Schedules |
| ☐ Other _____ | ☐ O&M Manuals | |

ITEM BEING SUBMITTED FOR (check only one)

- ☐ Action
 ☐ Information Only
 ☐ Record

REMARKS OR DEVIATIONS

CONTRACTOR / CM CERTIFICATION (SUBMITTALS NOT CERTIFIED WILL BE RETURNED WITHOUT REVIEW)



PARIC CORPORATION
SUBMITTAL STAMP

THIS SHOP DRAWING HAS BEEN REVIEWED BY PARIC CORPORATION

Subcontractor remains responsible for dimensions, quantities, coordination with other trades and compliance with contract documents.

By:
Devin D. Gates

To be completed by Reviewer

CANNON DESIGN SUBMITTAL NUMBER	
RECEIVED DATE	
☐ A. No Exceptions Taken No further review of submittal is required.	
☐ B. Make Corrections Noted Incorporate corrections in work; resubmission is not required.	
☐ C. Revise and Resubmit Revise as noted, and resubmit for review.	
☐ D. Rejected Submittal is not in compliance with Contract Documents; provide new submittal.	
☐ E. For Record / Information Only Submittal was reviewed for Record / Information purposes only.	
☐ F. Not Required for Review Submittal is not required by Contract Documents and has not been reviewed.	

Review is for conformance with the design concept of this project and for general compliance with contract documents. Contractor is responsible for quantities, dimensions and compliance with contract documents and for information that pertains to fabrication processes, construction techniques and coordination of this work with all trades which will be affected thereby. This review is null and void if submittal deviates from contract documents and does not indicate or note deviations.

A/E COMMENTS

☐ See attached sheet(s) for additional comments

SHOP DRAWING / SUBMITTAL REVIEW	
☐ NO EXCEPTION TAKEN	☒ EXCEPTIONS NOTED, RESUBMITTAL NOT REQUIRED
☐ REJECTED	
☐ REVIEWED FOR INFORMATION ONLY	☐ REVISE AND RESUBMIT AS NOTED
Checking is only for general conformance with the design concept of the project and general compliance with the information given in the Contract Documents. Any action shown is subject to the requirements of the plans and specifications. Contractor is responsible for: Dimensions which shall be confirmed and correlated at the job site, fabrication processes and techniques of the construction, coordination of his work with that of all other trades and the satisfactory performance of his work.	
DAVID MASON & ASSOCIATES, INC.	
REVIEW BY: JYW	DATE: 06/02/2016

REVIEWED BY

DATE

REVIEWED BY

DATE



77 Westport Plaza
Suite 250
St. Louis, MO 63146

TRANSMITTAL

No. 15051-0039

Paric Corporation

PROJECT: Webster University Interdisciplinary Science Building

DATE: 05/18/2016

TO: Cannon Design
1100 Clark Ave
St Louis MO 63102

RE: Anchor bolt shop drawings

ATTN: Kelvin Patel

JOB: 15051

WE ARE SENDING:	SUBMITTED FOR:	ACTION TAKEN:
☒ Shop Drawings	☒ Approval	☐ Approved as Submitted
☐ Letter	☐ Your Use	☐ Approved as Noted
☐ Prints	☐ As Requested	☐ Returned After Loan
☐ Change Order	☐ Review and Comment	☐ Resubmit
☐ Plans		☐ Submit
☐ Samples	SENT VIA:	☐ Returned
☐ Specifications	☐ Attached	☐ Returned for Corrections
☐ Other:	☐ Separate Cover Via:	☒ Due Date: 06/13/2016

<i>Item</i>	<i>Package</i>	<i>Code</i>	<i>Rev.</i>	<i>Copies</i>	<i>Date</i>	<i>Description</i>	<i>Status</i>
Submittal		054000-002	1		05/18/2016	Anchor bolt shop drawings	Submitted

NOTES:

CC: Paric Corporation, Kathy Bathe

Project Coordinator: Paric Corporation, Kathy Bathe

Signed: _____
Devin Gates