CANNONDESIGN

SUBMITTAL IDENTIFICATION SHEET

To be completed by Contractor/CM

WEBSTER UNIVERSITY ISB
PROJECT NAME

8274 BIG BEND BLVD
ADDRESS

NUMBER

WEBSTER UNIVERSITY
OWNER

CANNON DESIGN
ARCHITECT / ENGINEER

DEVIN D GATES
SUBMITTED BY

055213-006
CONTRACTOR / CM SUBMITTAL NO.

CANNON DESIGN SUBMITTAL NO.

DRAWING / DETAIL REFERENCE

055213
SPECIFICATION SECTION / PARAGRAPH

MANUFACTURER / SUPPLIER

ITEM / PRODUCT ID

REQUIRED DATE

PRIORITY

◯ CRITICAL

ITEM BEING SUBMITTED (check only one)

- ◉ Shop Drawings
- ◯ Samples (_____ copies)
- ◯ LEED Submittal
- ◯ Certification / Qualifications
- ◯ Record Documents
- ◯ Product Data
- ◯ Coordination Drawing
- ◯ Calculations
- ◯ Schedules
- ◯ O&M Manuals
- ◯ Other _____

ITEM BEING SUBMITTED FOR (check only one)

◉ Action ◯ Information Only ◯ Record

REMARKS OR DEVIATIONS

Please advise if locations are acceptable so that shop drawings can be produced

CONTRACTOR / CM CERTIFICATION
(SUBMITTALS NOT CERTIFIED WILL BE RETURNED WITHOUT REVIEW)

PARIC

PARIC CORPORATION
SUBMITTAL STAMP

THIS SHOP DRAWING HAS BEEN REVIEWED BY PARIC CORPORATION

Subcontractor remains responsible for dimensions, quantities, coordination with other trades and compliance with contract documents.

By:
Devin D. Gates

DEVIN D GATES — REVIEWED BY
1/6/16 — DATE

To be completed by Reviewer

05 5213-006
CANNON DESIGN SUBMITTAL NUMBER

1/6/17
RECEIVED DATE

- ◯ A. No Exceptions Taken
  No further review of submittal is required.
- ◉ B. Make Corrections Noted
  Incorporate corrections in work; resubmission is not required.
- ◯ C. Revise and Resubmit
  Revise as noted, and resubmit for review.
- ◯ D. Rejected
  Submittal is not in compliance with Contract Documents; provide new submittal.
- ◯ E. For Record / Information Only
  Submittal was reviewed for Record / Information purposes only.
- ◯ F. Not Required for Review
  Submittal is not required by Contract Documents and has not been reviewed.

Review is for conformance with the design concept of this project and for general compliance with contract documents. Contractor is responsible for quantities, dimensions and compliance with contract documents and for information that pertains to fabrication processes, construction techniques and coordination of this work with all trades which will be affected thereby. This review is null and void if submittal deviates from contract documents and does not indicate or note deviations.

A/E COMMENTS ◯ See attached sheet(s) for additional comments

Contractor to coordinate with. Jill Walker (DMA) if needed.

Kelvin Patel — REVIEWED BY
Digitally signed by Kelvin Patel
DN: C=US, E=kpatel@cannondesign.com, O=Cannon Design, OU=Architect, CN=Kelvin Patel
Date: 2017.01.23 17:40:09-06'00'
1/23/17 — DATE

A/E - Please confirm if blockout locations are acceptable to proceed with shop drawings.
-dg

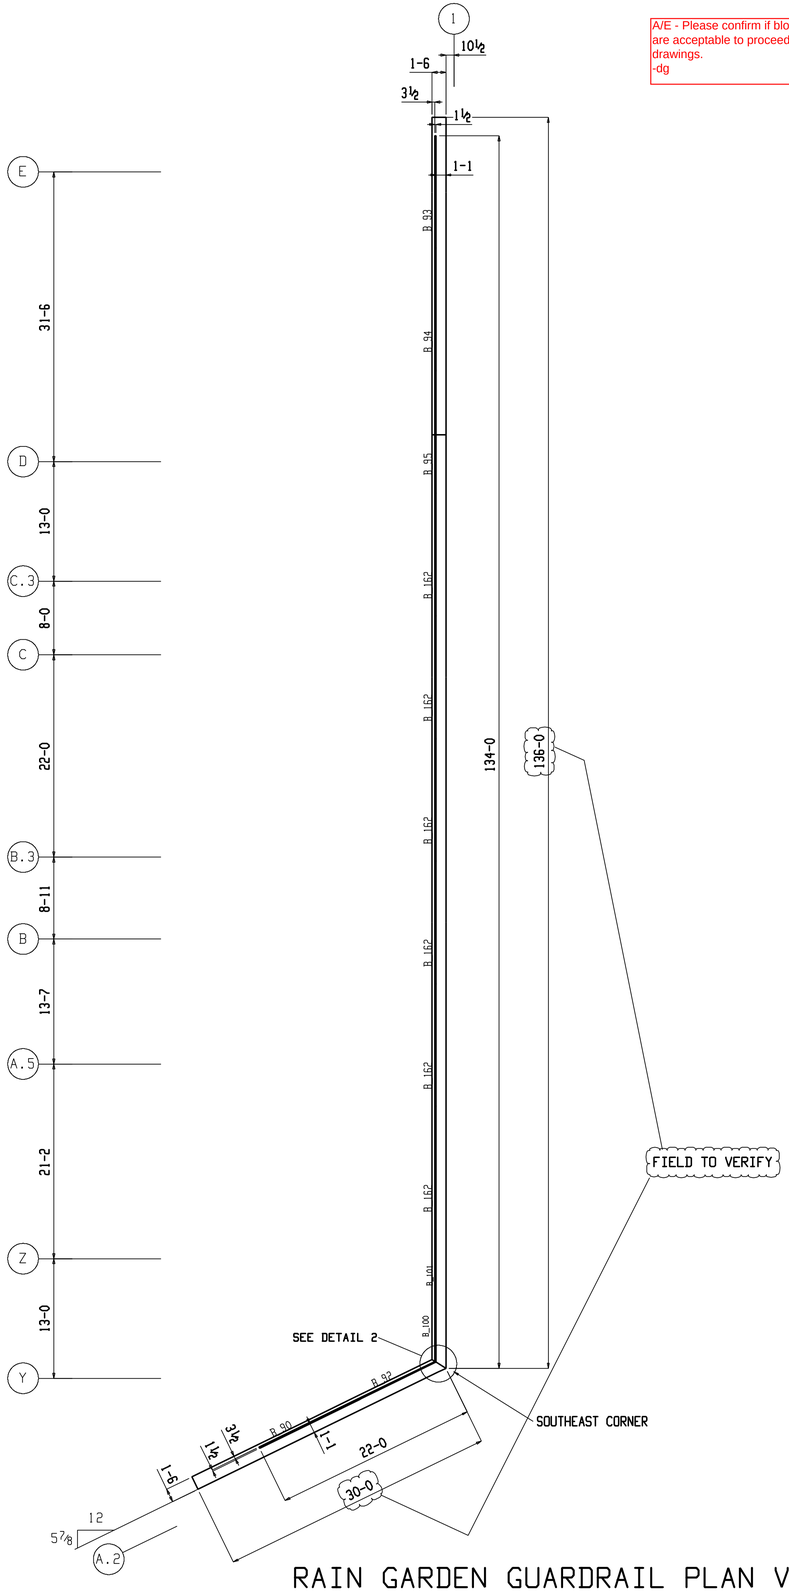

RAIN GARDEN GUARDRAIL PLAN VIEW

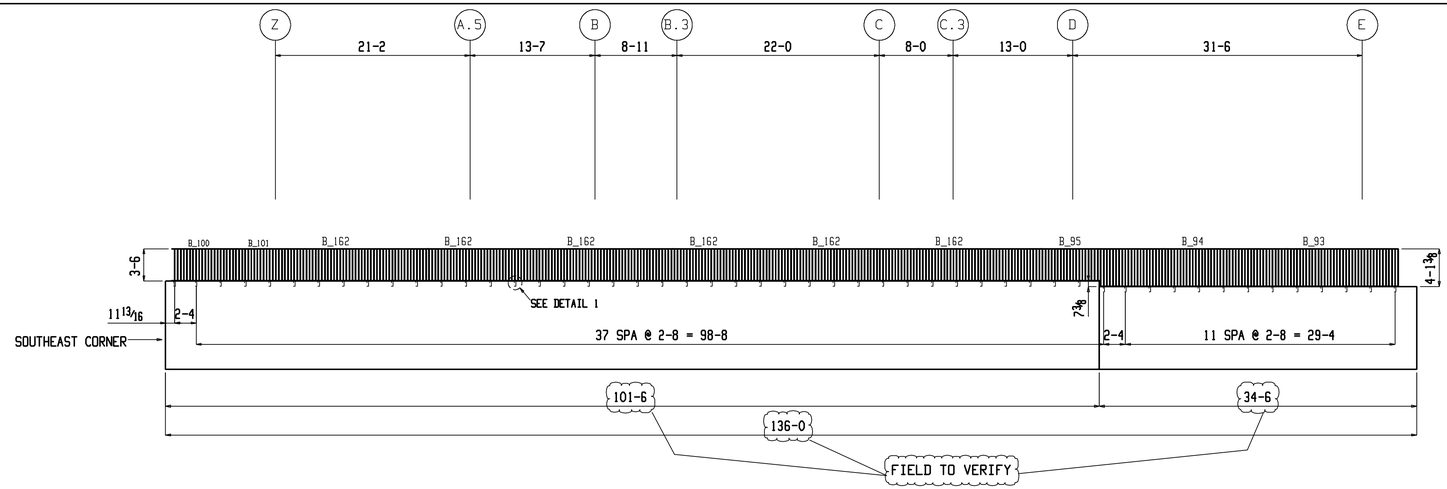

GRADE 50 STEEL LUG REQ'D
AS FOLLOWS:
42" HEIGHT = 3/4" X 3-1/2"
w/1/4" ALL AROUND WELD
49-3/8" HEIGHT = 3/4" X 4"
W/5/16" ALL AROUND WELD

RAIN GARDEN VIEW A

ELEVATION VIEW LOCATING POCKETS ALONG LINE 1
ALL DIMENSIONS GIVEN ARE TO CENTER
OF POCKET AT TOP OF WALL

Blockouts to be coordinated with concrete reinforcement shop drawings.
-dg

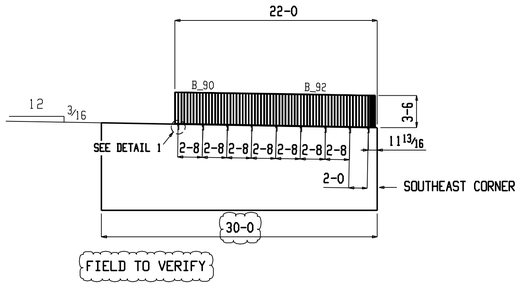

RAIN GARDEN ELEVATION B

ELEVATION VIEW LOCATING POCKETS ALONG LINE A.2
ALL DIMENSIONS GIVEN ARE TO CENTER
OF POCKET AT TOP OF WALL

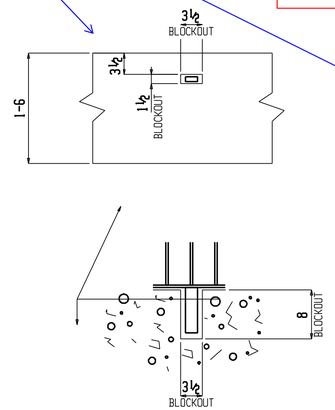

DETAIL 1

(TYPICAL CONCRETE BLOCKOUT DETAIL)

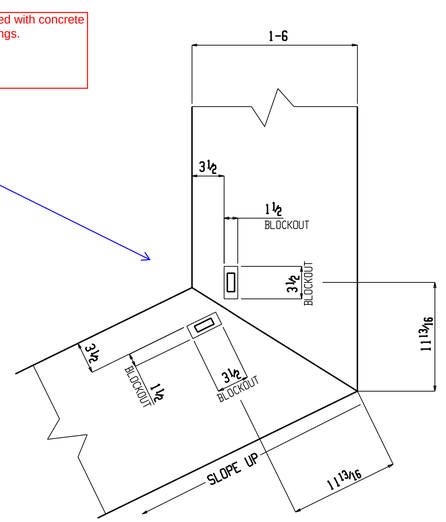

DETAIL 2

(CONCRETE BLOCKOUT DETAIL @ SOUTHEAST CORNER)

△
△

ATLAS IRON WORKS — EST. 1922

Project: WEBSTER UNIVERSITY
Customer: PARIC
Owner: WEBSTER UNIVERSITY
Location: WEBSTER GROVES, MO.
Dwn: KRT Date: 12-7-16 Ckd: XX Date: XX-XX-16
Job No. A16013M DWG#: E4

A/E - Please confirm if blockout locations are acceptable to proceed with shop drawings.
- dg

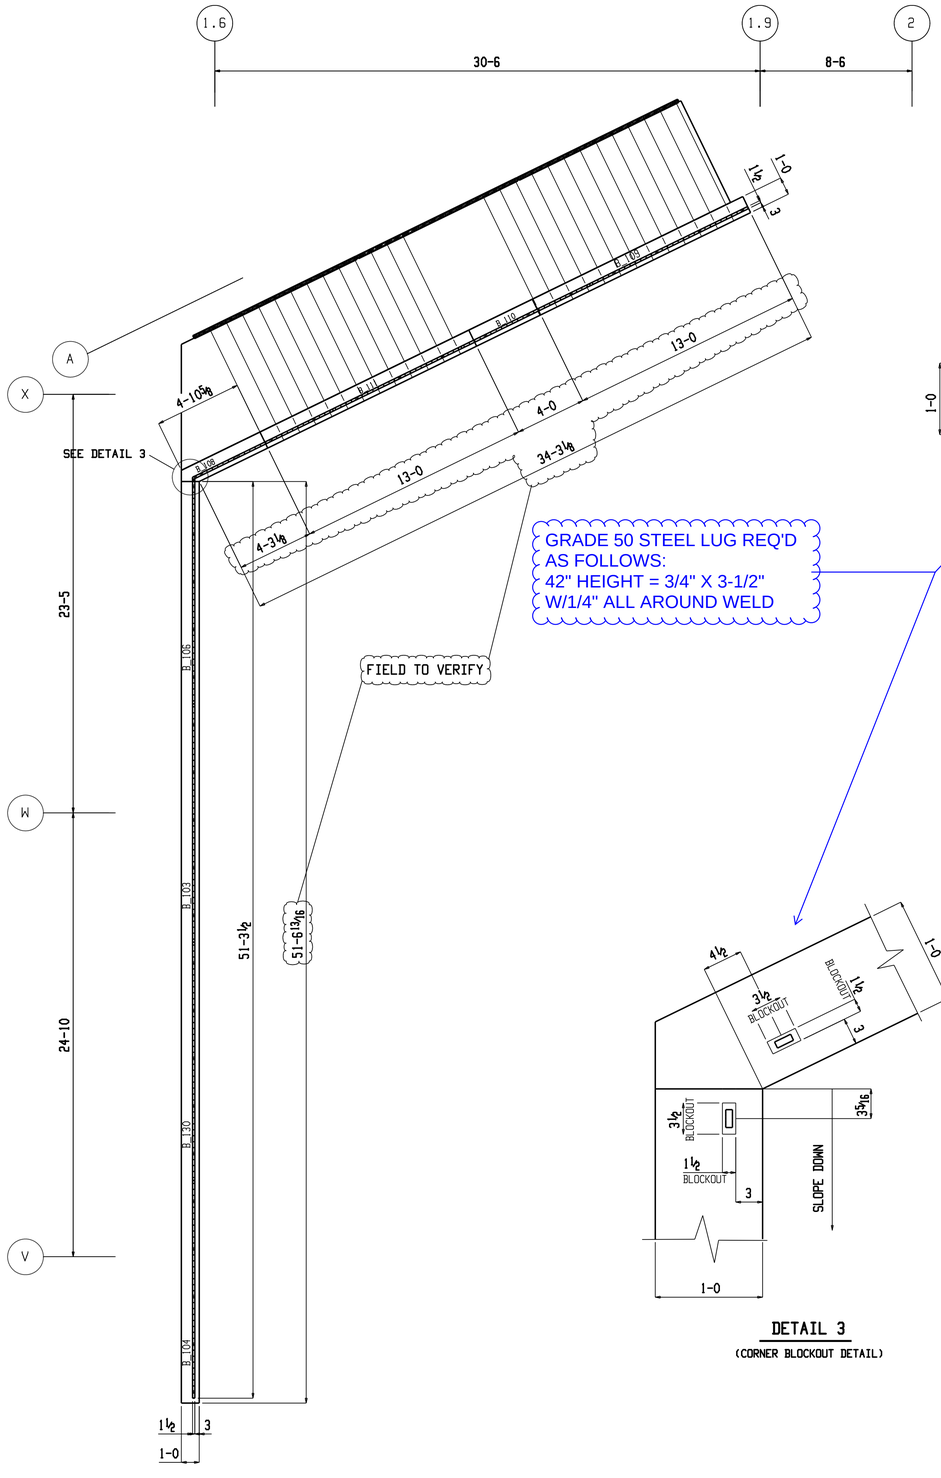

GRADE 50 STEEL LUG REQ'D AS FOLLOWS:
42" HEIGHT = 3/4" X 3-1/2"
W/1/4" ALL AROUND WELD

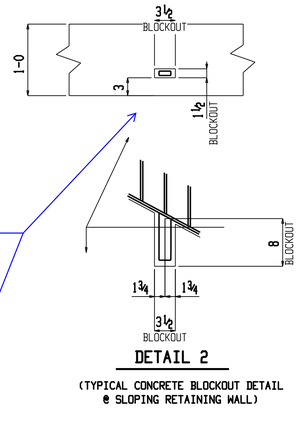

DETAIL 2

(TYPICAL CONCRETE BLOCKOUT DETAIL @ SLOPING RETAINING WALL)

Blockouts to be coordinated with concrete reinforcement shop drawings.
-dg

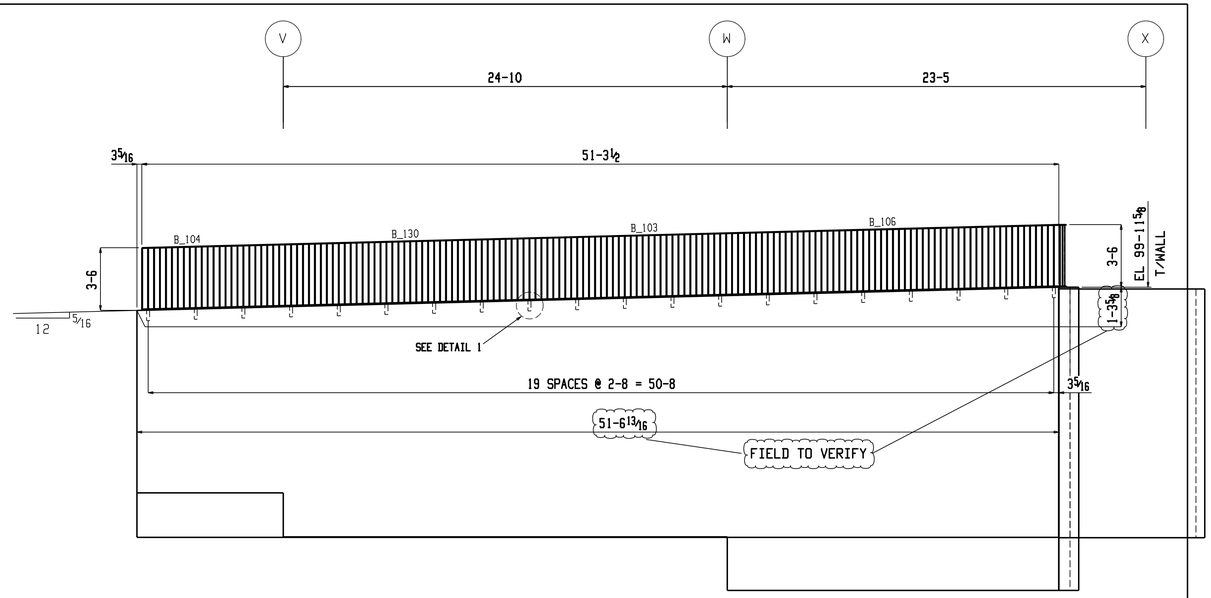

WEST COURTYARD RAIL VIEW A

ELEVATION VIEW LOCATING POCKETS ALONG LINE 1.6
ALL DIMENSIONS GIVEN ARE TO CENTER
OF POCKET AT TOP OF WALL

DETAIL 3

(CORNER BLOCKOUT DETAIL)

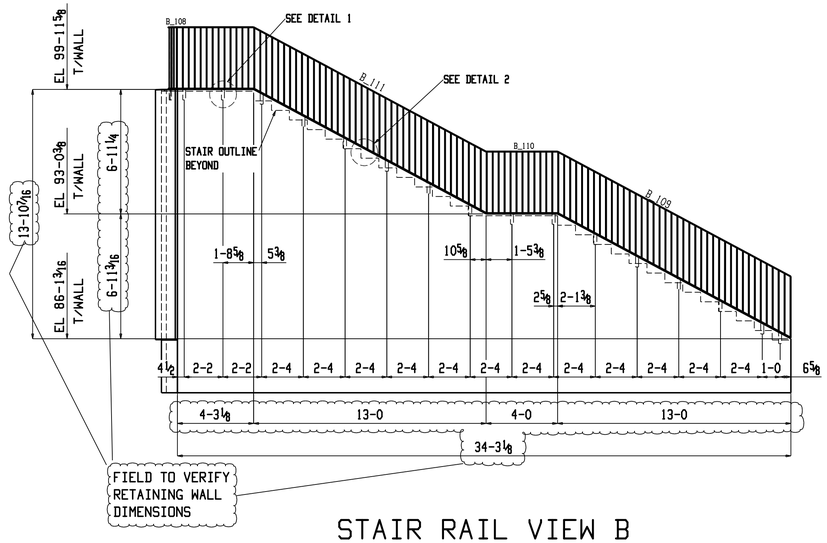

STAIR RAIL VIEW B

ELEVATION VIEW LOCATING POCKETS ON WALL
ALL DIMENSIONS GIVEN ARE TO CENTER
OF POCKET AT TOP OF WALL

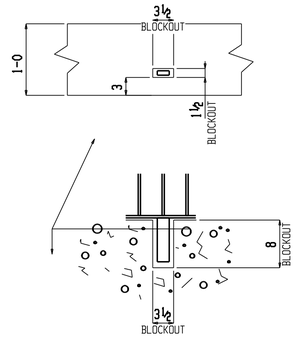

DETAIL 1

(TYPICAL CONCRETE BLOCKOUT DETAIL)

WEST COURTYARD GUARDRAIL PLAN VIEW

FOR APPROVAL

ATLAS IRON WORKS — EST. 1925

Project: WEBSTER UNIVERSITY
Customer: PARIC
Owner: WEBSTER UNIVERSITY
Location: WEBSTER GROVES, MO.
Dwn: KRT Date: 12-12-16 Ckd: XX Date: XX-XX-16
Job No. A16013M DWG#: E5