

SUBMITTAL IDENTIFICATION SHEET

To be completed by Contractor/CM

PROJECT NAME	
ADDRESS	
NUMBER	
OWNER	
ARCHITECT / ENGINEER	
SUBMITTED BY	
CONTRACTOR / CM SUBMITTAL NO.	CANNON DESIGN SUBMITTAL NO.
DRAWING / DETAIL REFERENCE	SPECIFICATION SECTION / PARAGRAPH
MANUFACTURER / SUPPLIER	ITEM / PRODUCT ID
REQUIRED DATE	PRIORITY
CRITICAL	☐

To be completed by Reviewer

CANNON DESIGN SUBMITTAL NUMBER
RECEIVED DATE

- ☐ **A. No Exceptions Taken**
No further review of submittal is required.
- ☐ **B. Make Corrections Noted**
Incorporate corrections in work;
resubmission is not required.
- ☐ **C. Revise and Resubmit**
Revise as noted, and resubmit for review.
- ☐ **D. Rejected**
Submittal is not in compliance with Contract Documents;
provide new submittal.
- ☐ **E. For Record / Information Only**
Submittal was reviewed for Record / Information
purposes only.
- ☐ **F. Not Required for Review**
Submittal is not required by Contract Documents
and has not been reviewed.

Review is for conformance with the design concept of this project and for general compliance with contract documents. Contractor is responsible for quantities, dimensions and compliance with contract documents and for information that pertains to fabrication processes, construction techniques and coordination of this work with all trades which will be affected thereby. This review is null and void if submittal deviates from contract documents and does not indicate or note deviations.

ITEM BEING SUBMITTED (check only one)

- ☐ Shop Drawings ☐ Certification / Qualifications ☐ Coordination Drawing
☐ Samples ☐ Record Documents ☐ Calculations
 (_____ copies) ☐ Product Data ☐ Schedules
☐ LEED Submittal ☐ O&M Manuals
☐ Other

ITEM BEING SUBMITTED FOR (check only one)

- ☐ Action ☐ Information Only ☐ Record

REMARKS OR DEVIATIONS

CONTRACTOR / CM CERTIFICATION
(SUBMITTALS NOT CERTIFIED WILL BE RETURNED WITHOUT REVIEW)



PARIC CORPORATION
SUBMITTAL STAMP

THIS SHOP DRAWING HAS BEEN REVIEWED BY PARIC CORPORATION

Subcontractor remains responsible for dimensions, quantities, coordination with other trades and compliance with contract documents.

Ry:

By:
Devin D. Gates

REVIEWED BY	DATE

A/E COMMENTS

- ☐
- See attached sheet(s) for additional comments

REVIEWED BY	DATE



77 Westport Plaza
Suite 250
St. Louis, MO 63146

TRANSMITTAL

No. 15051-0524

Paric Corporation

PROJECT: 15051-Webster University Interdisciplinary Science Building

DATE: 03/06/2017

TO: Cannon Design
1100 Clark Ave
St Louis MO 63102

Fax;
314-241-2203

RE: Glass Handrail Shop Drawings for Stair 1

ATTN: Kelvin Patel

JOB: 15051



WE ARE SENDING:	SUBMITTED FOR:	ACTION TAKEN:
☒ Shop Drawings	☒ Approval	☐ Approved as Submitted
☐ Letter	☐ Your Use	☐ Approved as Noted
☐ Prints	☐ As Requested	☐ Returned After Loan
☐ Change Order	☐ Review and Comment	☐ Resubmit
☐ Plans		☐ Submit
☐ Samples	SENT VIA:	☐ Returned
☐ Specifications	☐ Attached	☐ Returned for Corrections
☐ Other:	☐ Separate Cover Via:	☐ Due Date:

Item	Package	Code	Rev.	Copies	Date	Description	Status
Submittal		057100-010	1		03/06/2017	Glass Handrail Shop Drawings for Stair 1	Submitted

NOTES:

CC:

Signed: _____
Devin Gates

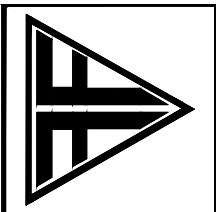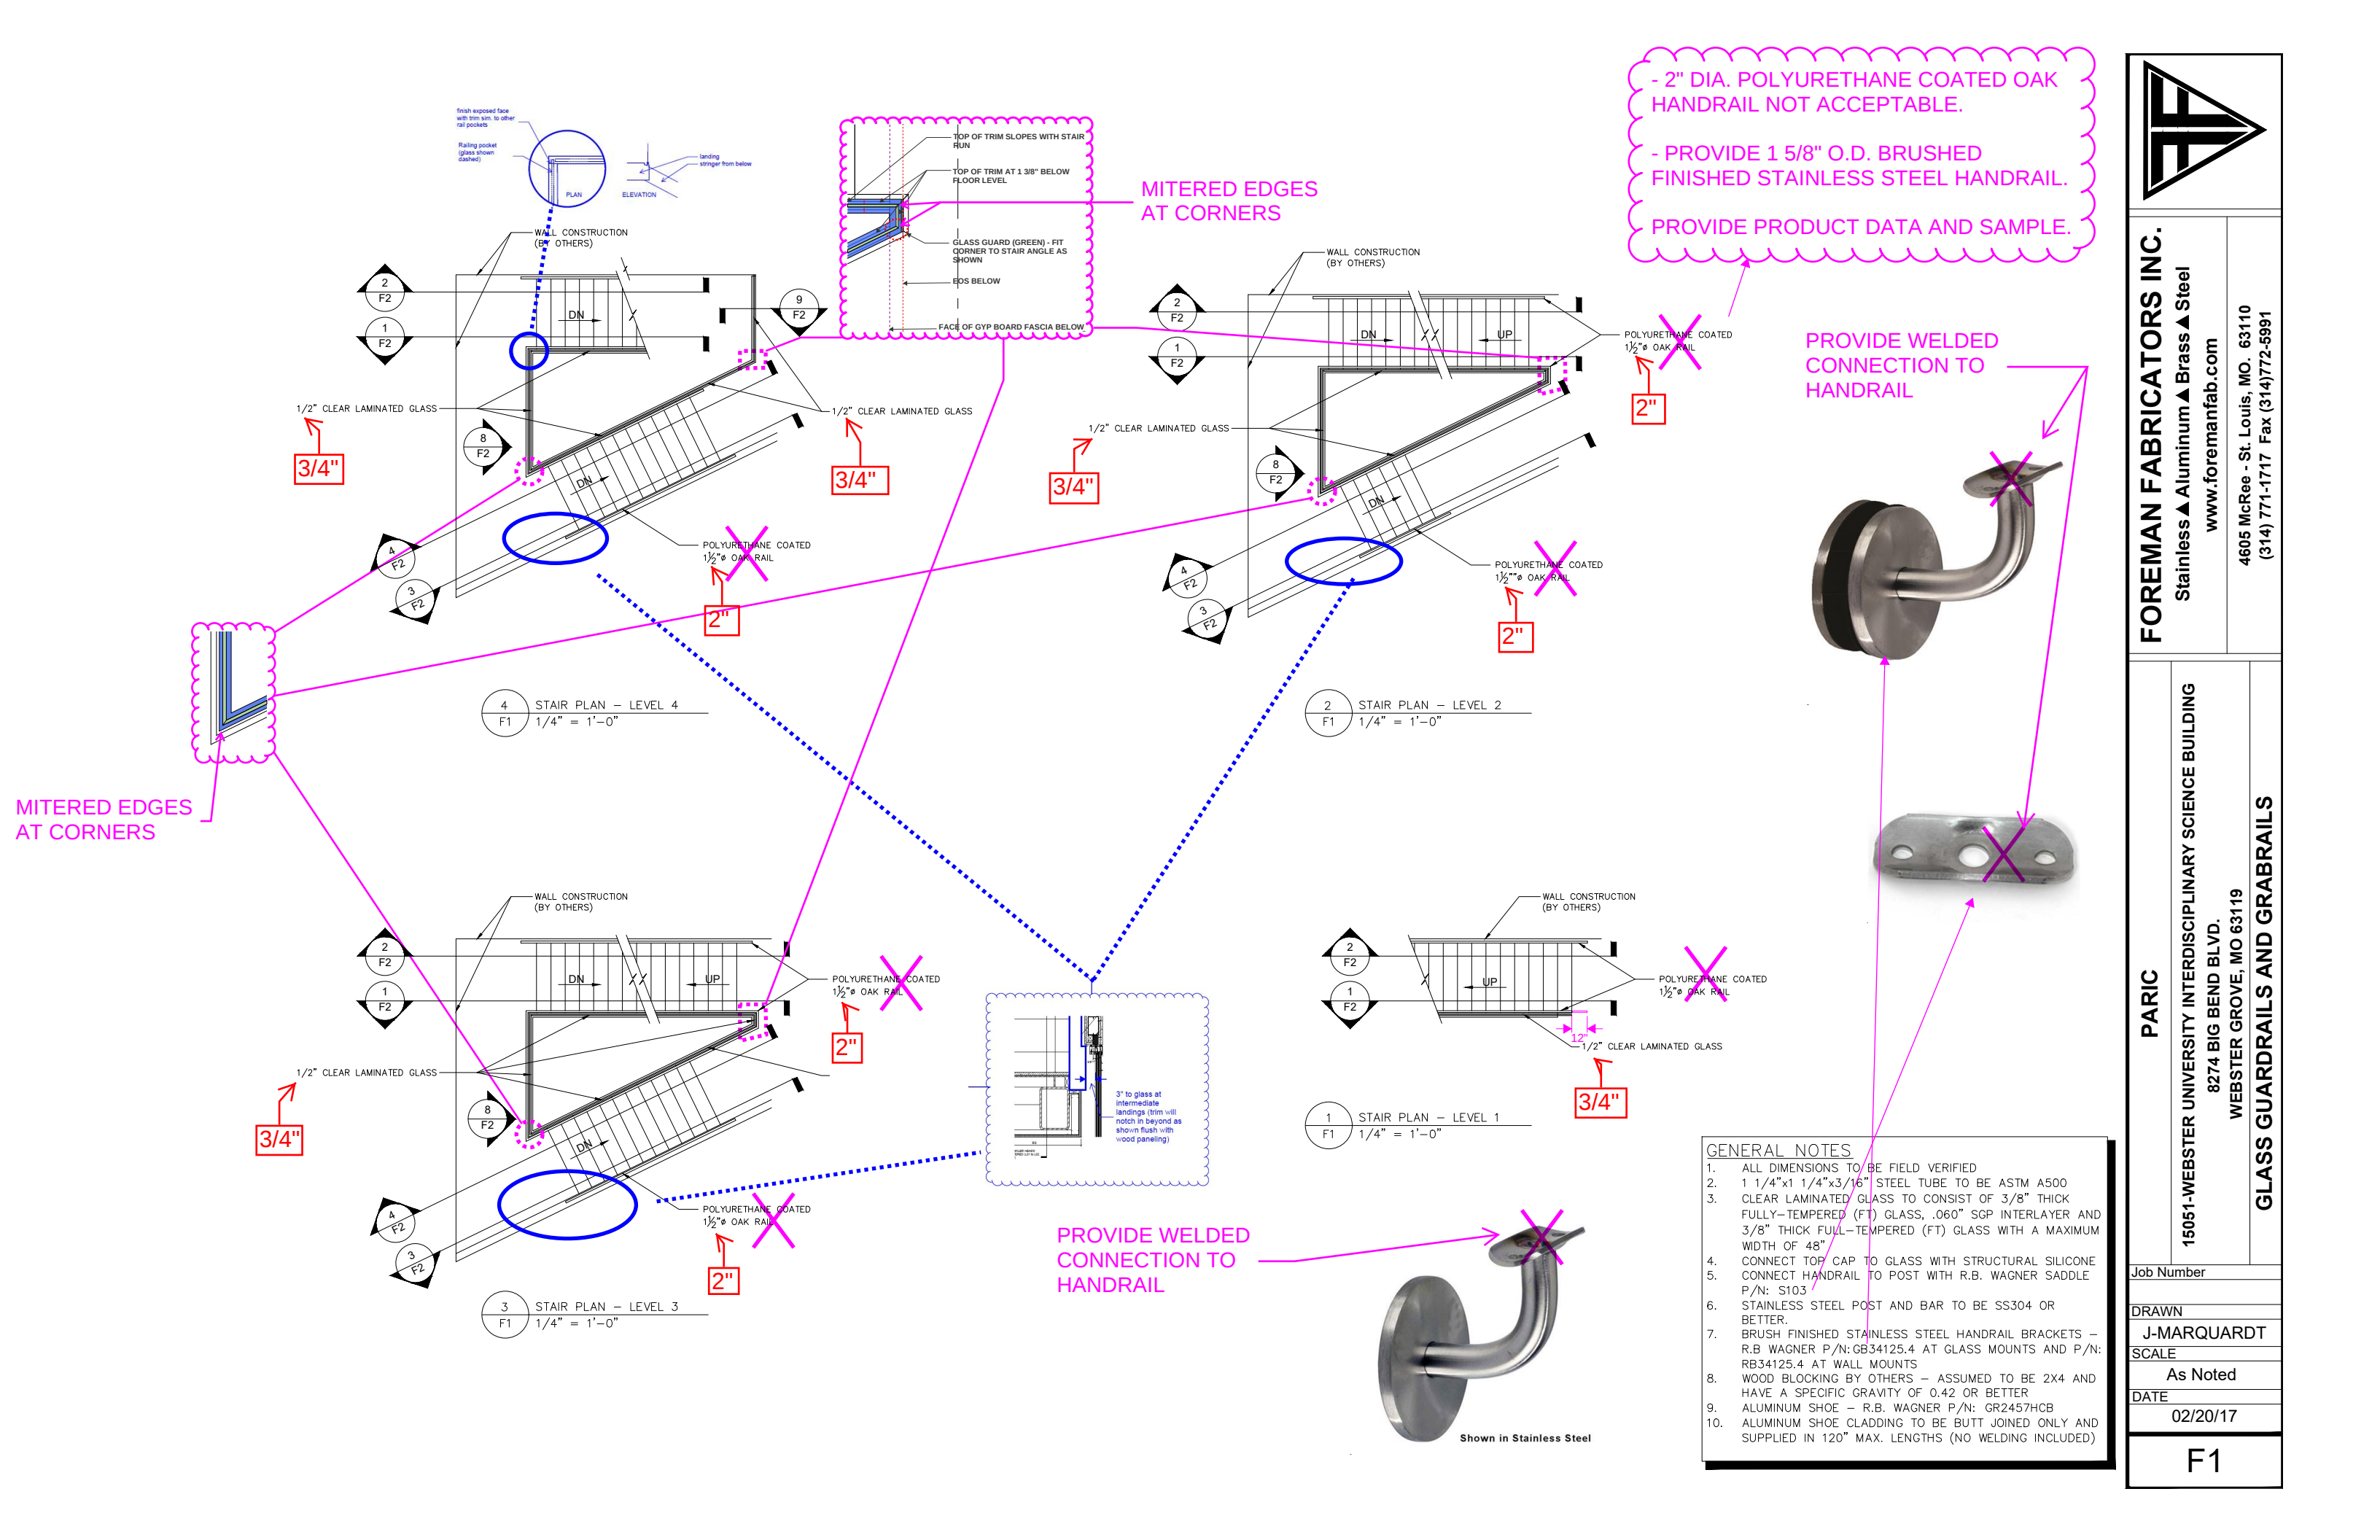

FOREMAN FABRICATORS INC.
Stainless Aluminum Brass Steel
www.foremanfab.com
4605 McRee - St. Louis, MO. 63110
(314) 771-1717 Fax (314) 772-5991

PARIC
15051-WEBSTER UNIVERSITY INTERDISCIPLINARY SCIENCE BUILDING
8274 BIG BEND BLVD.
WEBSTER GROVE, MO 63119
GLASS GUARDRAILS AND GRABRAILS

Job Number
DRAWN
J-MARQUARDT
SCALE
As Noted
DATE
02/20/17
F1

- GENERAL NOTES**
1. ALL DIMENSIONS TO BE FIELD VERIFIED
 2. 1 1/4"x1 1/4"x3/16" STEEL TUBE TO BE ASTM A500
 3. CLEAR LAMINATED GLASS TO CONSIST OF 3/8" THICK FULLY-TEMPERED (FT) GLASS, .060" SGP INTERLAYER AND 3/8" THICK FULL-TEMPERED (FT) GLASS WITH A MAXIMUM WIDTH OF 48"
 4. CONNECT TOP CAP TO GLASS WITH STRUCTURAL SILICONE
 5. CONNECT HANDRAIL TO POST WITH R.B. WAGNER SADDLE P/N: S103
 6. STAINLESS STEEL POST AND BAR TO BE SS304 OR BETTER.
 7. BRUSH FINISHED STAINLESS STEEL HANDRAIL BRACKETS - R.B. WAGNER P/N: GB34125.4 AT GLASS MOUNTS AND P/N: RB34125.4 AT WALL MOUNTS
 8. WOOD BLOCKING BY OTHERS - ASSUMED TO BE 2X4 AND HAVE A SPECIFIC GRAVITY OF 0.42 OR BETTER
 9. ALUMINUM SHOE - R.B. WAGNER P/N: GR2457HCB
 10. ALUMINUM SHOE CLADDING TO BE BUTT JOINED ONLY AND SUPPLIED IN 120" MAX. LENGTHS (NO WELDING INCLUDED)

