


Webster University Interdisciplinary Science Building
8274 Big Bend Blvd
Webster Groves, MO 63119

RE: 071326 Self Adhering Sheet Waterproofing (Base of Wall Foundation)

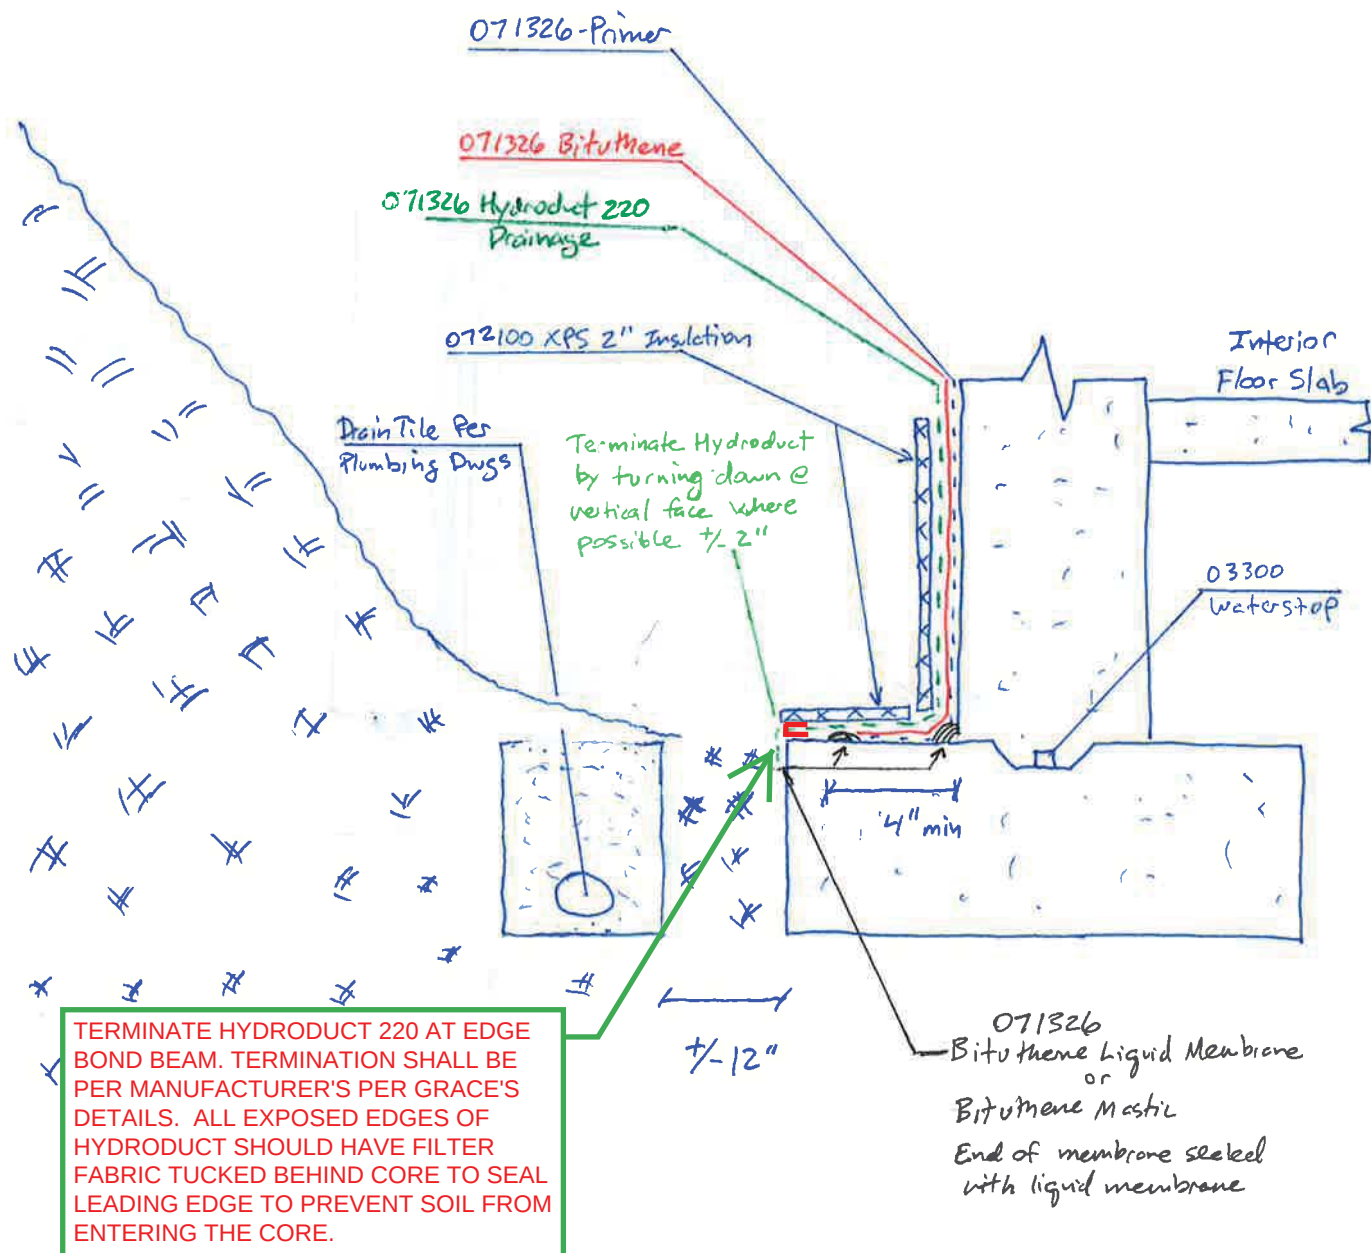

SUBMITTAL IDENTIFICATION SHEET

To be completed by Contractor/CM

WEBSTER UNIVERSITY ISB	
PROJECT NAME	
8274 BIG BEND BLVD	
ADDRESS	
NUMBER	
WEBSTER UNIVERSITY	
OWNER	
CANNON DESIGN	
ARCHITECT / ENGINEER	
DEVIN D GATES	
SUBMITTED BY	
071326-003	
CONTRACTOR / CM SUBMITTAL NO.	CANNON DESIGN SUBMITTAL NO.
	071326
DRAWING / DETAIL REFERENCE	SPECIFICATION SECTION / PARAGRAPH
MANUFACTURER / SUPPLIER	ITEM / PRODUCT ID
	HIGH
REQUIRED DATE	PRIORITY
	CRITICAL

ITEM BEING SUBMITTED (check only one)

- | | | |
|--|--|--|
| ☒ Shop Drawings | ☐ Certification / | ☐ Coordination Drawing |
| ☐ Samples | ☐ Qualifications | ☐ Calculations |
| (_____ copies) | ☐ Record Documents | ☐ Schedules |
| ☐ LEED Submittal | ☐ Product Data | ☐ O&M Manuals |
| ☐ Other _____ | | |

ITEM BEING SUBMITTED FOR (check only one)

- ☒ Action ☐ Information Only ☐ Record

REMARKS OR DEVIATIONS

CONTRACTOR / CM CERTIFICATION (SUBMITTALS NOT CERTIFIED WILL BE RETURNED WITHOUT REVIEW)

 PARIC CORPORATION SUBMITTAL STAMP THIS SHOP DRAWING HAS BEEN REVIEWED BY PARIC CORPORATION Subcontractor remains responsible for dimensions, quantities, coordination with other trades and compliance with contract documents. By: Devin D. Gates
--

DEVIN D GATES	082216
REVIEWED BY	DATE

To be completed by Reviewer

CANNON DESIGN SUBMITTAL NUMBER	
RECEIVED DATE	
☐ A. No Exceptions Taken No further review of submittal is required.	
☒ B. Make Corrections Noted Incorporate corrections in work; resubmission is not required.	
☐ C. Revise and Resubmit Revise as noted, and resubmit for review.	
☐ D. Rejected Submittal is not in compliance with Contract Documents; provide new submittal.	
☐ E. For Record / Information Only Submittal was reviewed for Record / Information purposes only.	
☐ F. Not Required for Review Submittal is not required by Contract Documents and has not been reviewed.	

Review is for conformance with the design concept of this project and for general compliance with contract documents. Contractor is responsible for quantities, dimensions and compliance with contract documents and for information that pertains to fabrication processes, construction techniques and coordination of this work with all trades which will be affected thereby. This review is null and void if submittal deviates from contract documents and does not indicate or note deviations.

A/E COMMENTS

☐ See attached sheet(s) for additional comments

TERMINATE HYDRODUCT 220 AT EDGE BOND BEAM. TERMINATION SHALL BE PER MANUFACTURER'S PER GRACE'S DETAILS. ALL EXPOSED EDGES OF HYDRODUCT SHOULD HAVE FILTER FABRIC TUCKED BEHIND CORE TO SEAL LEADING EDGE TO PREVENT SOIL FROM ENTERING THE CORE. TERMINATION AT TOP (GRADE) SHALL BE PER CONSTRUCTION DOCUMENTS.

Kathy Williams	08/24/16
REVIEWED BY	DATE

**Concrete Restoration
Masonry Restoration
Urethane Protective Coatings
Waterproofing
Joint Sealants**




SUPERIOR

Waterproofing & Restoration Co., Inc.

3001 WASHINGTON AVE.
SUITE 100
ST. LOUIS MO 63103
TEL: (314) 531-6100
FAX: (314) 531-6200

Webster University Interdisciplinary Science Building
8274 Big Bend Blvd
Webster Groves, MO 63119

RE: 071326 Self Adhering Sheet Waterproofing (Base of Wall Foundation)

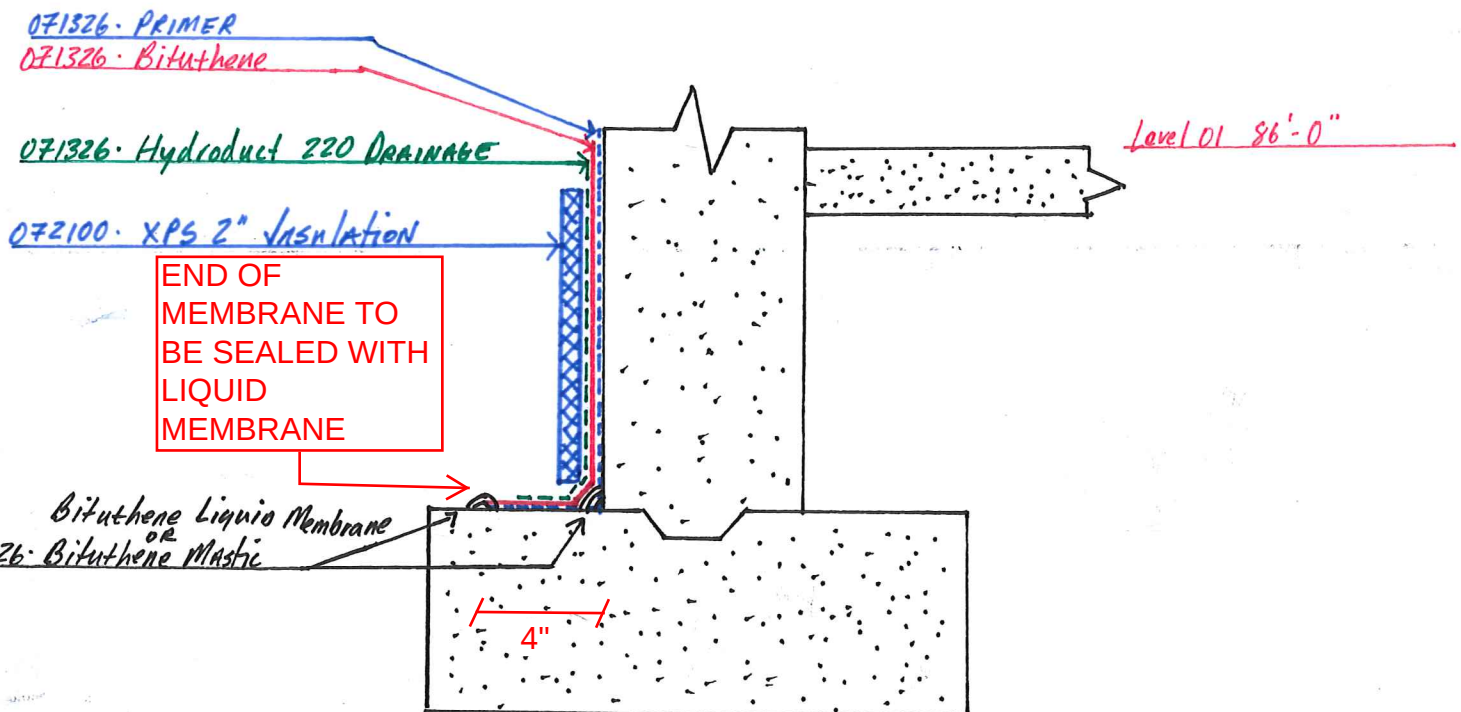



Superior Waterproofing & Restoration Co., Inc.
3310 Samuel Shepard Drive
St. Louis MO 63103
314-531-6100
314-531-6200 (fax)
www.superiorwaterproofing.com

Concrete Restoration
Masonry Restoration
Resinous Flooring
Waterproofing

TRANSMITTAL

To: Devin Gates @ Paric Co. Date: 08-09-2016

From: Joseph McGahan Pages (including cover): _____

Project Name: Webster University Interdisciplinary Science Building Project No.: _____

We are sending to you:

☐ Mail	☒ Shop Drawings	☒ For Approval
☐ Carrier	☐ Submittals	☐ For Your Information
☒ Email	☐ Specifications	☐ For Payment
	☐ Invoice	☐ Prints
	☐ Literature	☐ Other
	☐ Closeout Documents	

No. of Copies	Description	Submitted By
	071326 Self-Adhering Sheet Waterproofing	Superior Waterproofing
	• Base of Wall Waterproofing Foundation Detail	

Remarks:

This is the proposed detail issued by Superior Waterproofing following rejection of the specified manufacturer, Grace, submitted standard detail #BIT-006.

If you have any problems in receiving this transmission, please call (314) 531-6100.

SUBMITTAL IDENTIFICATION SHEET

To be completed by Contractor/CM

PROJECT NAME	
ADDRESS	
NUMBER	
OWNER	
ARCHITECT / ENGINEER	
SUBMITTED BY	
CONTRACTOR / CM SUBMITTAL NO.	CANNON DESIGN SUBMITTAL NO.
DRAWING / DETAIL REFERENCE	SPECIFICATION SECTION / PARAGRAPH
MANUFACTURER / SUPPLIER	ITEM / PRODUCT ID
REQUIRED DATE	PRIORITY
CRITICAL	☐

To be completed by Reviewer

CANNON DESIGN SUBMITTAL NUMBER
RECEIVED DATE

- ☐ **A. No Exceptions Taken**
No further review of submittal is required.
- ☐ **B. Make Corrections Noted**
Incorporate corrections in work;
resubmission is not required.
- ☐ **C. Revise and Resubmit**
Revise as noted, and resubmit for review.
- ☐ **D. Rejected**
Submittal is not in compliance with Contract Documents;
provide new submittal.
- ☐ **E. For Record / Information Only**
Submittal was reviewed for Record / Information
purposes only.
- ☐ **F. Not Required for Review**
Submittal is not required by Contract Documents
and has not been reviewed.

Review is for conformance with the design concept of this project and for general compliance with contract documents. Contractor is responsible for quantities, dimensions and compliance with contract documents and for information that pertains to fabrication processes, construction techniques and coordination of this work with all trades which will be affected thereby. This review is null and void if submittal deviates from contract documents and does not indicate or note deviations.

ITEM BEING SUBMITTED (check only one)

- ☐ Shop Drawings
☐ Samples
 (_____ copies)
☐ LEED Submittal
☐ Other
- ☐ Certification /
 Qualifications
☐ Record Documents
☐ Product Data
- ☐ Coordination Drawing
☐ Calculations
☐ Schedules
☐ O&M Manuals

ITEM BEING SUBMITTED FOR (check only one)

- ☐ Action ☐ Information Only ☐ Record

REMARKS OR DEVIATIONS

CONTRACTOR / CM CERTIFICATION
(SUBMITTALS NOT CERTIFIED WILL BE RETURNED WITHOUT REVIEW)



PARIC CORPORATION
SUBMITTAL STAMP

THIS SHOP DRAWING HAS BEEN REVIEWED BY PARIC CORPORATION

Subcontractor remains responsible for dimensions, quantities, coordination with other trades and compliance with contract documents.

Ry:

Devin D. Gates

REVIEWED BY	DATE

A/E COMMENTS

- ☐
- See attached sheet(s) for additional comments

REVIEWED BY	DATE



77 Westport Plaza
Suite 250
St. Louis, MO 63146

TRANSMITTAL

No. 15051-0184

Paric Corporation

PROJECT: 15051-Webster University Interdisciplinary Science Building

DATE: 08/10/2016

TO: Cannon Design
1100 Clark Ave
St Louis MO 63102

RE: Waterproofing shop drawings REV2

ATTN: Kelvin Patel

JOB: 15051

WE ARE SENDING:		SUBMITTED FOR:	ACTION TAKEN:
☒ Shop Drawings		☒ Approval	☐ Approved as Submitted
☐ Letter		☐ Your Use	☐ Approved as Noted
☐ Prints		☐ As Requested	☐ Returned After Loan
☐ Change Order		☐ Review and Comment	☐ Resubmit
☐ Plans			☐ Submit
☐ Samples		SENT VIA:	☐ Returned
☐ Specifications			☐ Returned for Corrections
☐ Other:			☒ Due Date: 03/28/2016

<i>Item</i>	<i>Package</i>	<i>Code</i>	<i>Rev.</i>	<i>Copies</i>	<i>Date</i>	<i>Description</i>	<i>Status</i>
Submittal		071326-003	2		08/10/2016	Waterproofing shop drawings REV2	Submitted

NOTES:

CC:

Signed: _____
Devin Gates