WEBSTER UNIVERSITY
INTERDISCIPLINARY SCIENCE BUILDING
WEBSTER GROVES, MISSOURI

ARCHITECT

Cannon Design
Saint Louis, Missouri

CUSTOMER/INSTALLER

Kuentz Heating and Sheet Metal Company
Saint Louis, Missouri

EQUITONE U110-1.00 SYSTEM

SUPPLIED EXTRUSIONS

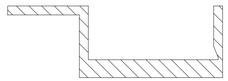

ALUMINUM J-CHANNEL
EXTRUSION
DCA-138
(PAINTED BLACK)

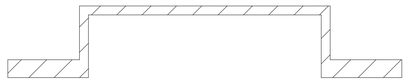

ALUMINUM HAT CHANNEL
EXTRUSION
DCA-140
(PAINTED BLACK)

ALUMINUM VENT SCREEN
EXTRUSION
110-002
(PAINTED BLACK)

(SEE DETAIL DRAWINGS FOR ACTUAL SIZE)

SUPPLIED HARDWARE

PANEL RIVET
(SUPPLIED COLOR MATCHED)

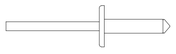

USE CENTERING TOOL TO DRILL THRU PRE-DRILLED
PANEL HOLES INTO ALUMINUM SUBFRAMING.

EXTRUSION FASTENER
1/4"-14 X 1" HWH WITH 3/8" HEX HEAD,
#3 DRILL POINT, CLIMASEAL ACR COATED

DRAWING INDEX

T1	TITLE SHEET - EQUITONE
P1	PARTIAL PLAN AT CURVED WALL
E1	ELEVATIONS
D1	FULL SIZE DETAILS
D2	FULL SIZE DETAILS
D3	FULL SIZE DETAILS
D4	FULL SIZE DETAILS
D5	FULL SIZE DETAILS
D6	FULL SIZE DETAILS

APPROVAL STAMP

KEY PLAN

NTS

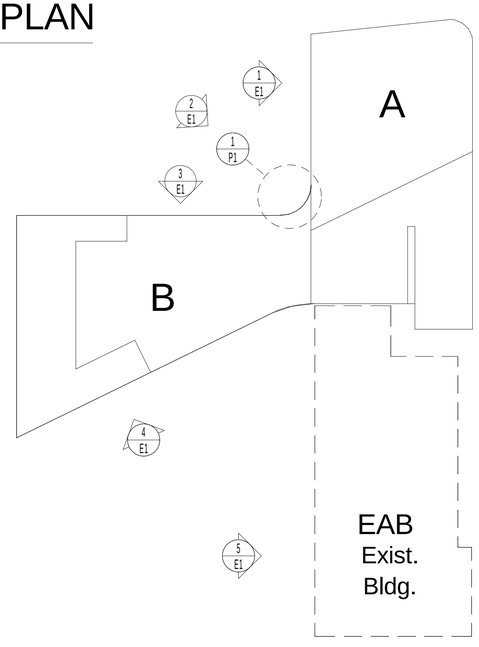

ARCHITECT/CUSTOMER NOTE

UNIVERSE CORPORATION HAS PREPARED THIS SET OF SUBMISSION DRAWINGS IN ACCORDANCE WITH CRITERIA ESTABLISHED BY OTHERS. THE CONTRACTOR SHALL BE RESPONSIBLE TO VERIFY THE INFORMATION CONTAINED HEREIN, INCLUDING ALL DIMENSIONS.

UNIVERSE CORPORATION REQUIRES A "WRITTEN RELEASE TO PROCEED WITH FABRICATION", PRIOR TO MANUFACTURING PANEL MATERIAL.

UNIVERSE CORPORATION WILL FABRICATE ALL OF IT'S MATERIALS FROM THIS APPROVAL SET. IF FIELD VERIFICATION OF DIMENSIONS IS REQUIRED, THE CUSTOMER SHALL BE RESPONSIBLE TO SUPPLY THESE DIMENSIONS TO UNIVERSE CORPORATION PRIOR TO PANEL MANUFACTURING/ENGINEERING.

DISCREPANCIES FOUND DURING FIELD VERIFICATION OF DIMENSIONS SHALL BE CORRECTED BY THE CUSTOMER AND NOT BY UNIVERSE CORPORATION.

GENERAL NOTES

1. MATERIAL TO BE 8mm EQUITONE
2. COLOR/FINISH: N074 [natura]
3. ALL DIMENSIONS TO BE VERIFIED.
4. "NBU" INDICATES MATERIAL NOT SUPPLIED BY UNIVERSE CORP.
5. ALL FRAMING TO BE MINIMUM G-90 16-GA. STEEL OR 3/4" TREATED PLYWOOD. (NOT SUPPLIED BY UNIVERSE CORP.)
6. FLUID APPLIED AIR AND MOISTURE BARRIER (N.B.U.),
7. INSULATION OF ANY TYPE (N.B.U.)
8. THESE SHOP DRAWINGS PREPARED USING ARCHITECTURAL DRAWINGS DATED 01.15.2016

SPECIAL NOTES

1. EDGES WILL BE LIGHTLY SANDED TO REMOVE ANY SHARPNESS CREATED WITH THE FABRICATION PROCESS. IF REQUIRED, LUKO WILL BE APPLIED TO EDGES AFTER FABRICATION.
2. ONCE UNIVERSE HAS RECEIVED COLOR AND SHOP DRAWING SUBMITTAL APPROVALS, THERE IS AN 12-14 WEEK LEAD TIME FOR THE PROCUREMENT OF THE EQUITONE MATERIAL. (THIS TIME DOES NOT INCLUDE ENGINEERING AND FABRICATION).
3. IN ACCORDANCE WITH EQUITONE DESIGN CRITERIA, PROPER VENTILATION AND FREE AIR MOVEMENT WITHIN THE AIRSPACE BEHIND THE EQUITONE PANELS MUST BE MAINTAINED. VENT OPENINGS AND JOINT SPACING AS DETAILED IN IN THESE SHOP DRAWINGS MUST REMAIN UNOBSTRUCTED. FAILURE TO MAINTAIN THIS VENTILATION AND AIRSPACE REQUIREMENTS WILL GREATLY AFFECT THE PERFORMANCE OF THESE PANELS. POSSIBLE LEADING TO PANEL SYSTEM ISSUES.

PANEL INSTALLER NOTES

A. TOP OF PANELS DESIGNATED WITH AN "H" ON BACK OF PANELS FOR "HEAD".

B. UNLESS NOTED OTHERWISE , A U7000 SYSTEM REQUIRES AN INSTALL SEQUENCE OF BOTTOM TO TOP

C. CUT-OUTS OR PENETRATIONS IN EQUITONE PANELS DUE TO LIGHT FIXTURES, SCUPPERS, ETC. TO BE FIELD CUT BY PANEL INSTALLER TO INSURE PROPER FIT. (N.B.U.)

Rev.	Date	By
2	12-5-2016	KJN
Revised Per Arch. Rev.		
1	11-14-2016	KJN
Revised Per Arch. Rev.		
-	9-16-2016	KJN
1st Submittal Shop Drawings		

Description

Drawn by KJN

CUSTOMER NAME/LOCATION:
Kuentz Heating and Sheet Metal Company
St. Charles, MO 63304

PROJECT NAME/LOCATION:
Webster University Interdisciplinary Science Bldg- EQUITONE
Webster Groves MO

SHEET DESCRIPTION:
TITLESHEET

UNIVERSE CORPORATION
3333 FOERSTER RD
ST. LOUIS, MO. 63044-3716
PHONE: (800) 989 6550
FAX: (314) 439 2801
www.universecorp.com

THE DRAWING IS THE PROPERTY OF UNIVERSE CORPORATION AND MUST BE RETURNED UPON REQUEST. ALL RIGHTS RESERVED. NO PART OF THIS DRAWING SHALL BE REPRODUCED WITHOUT WRITTEN PERMISSION FROM UNIVERSE CORPORATION.

PROJECT NUMBER:
2016-06-0556

SHEET NUMBER:
T1

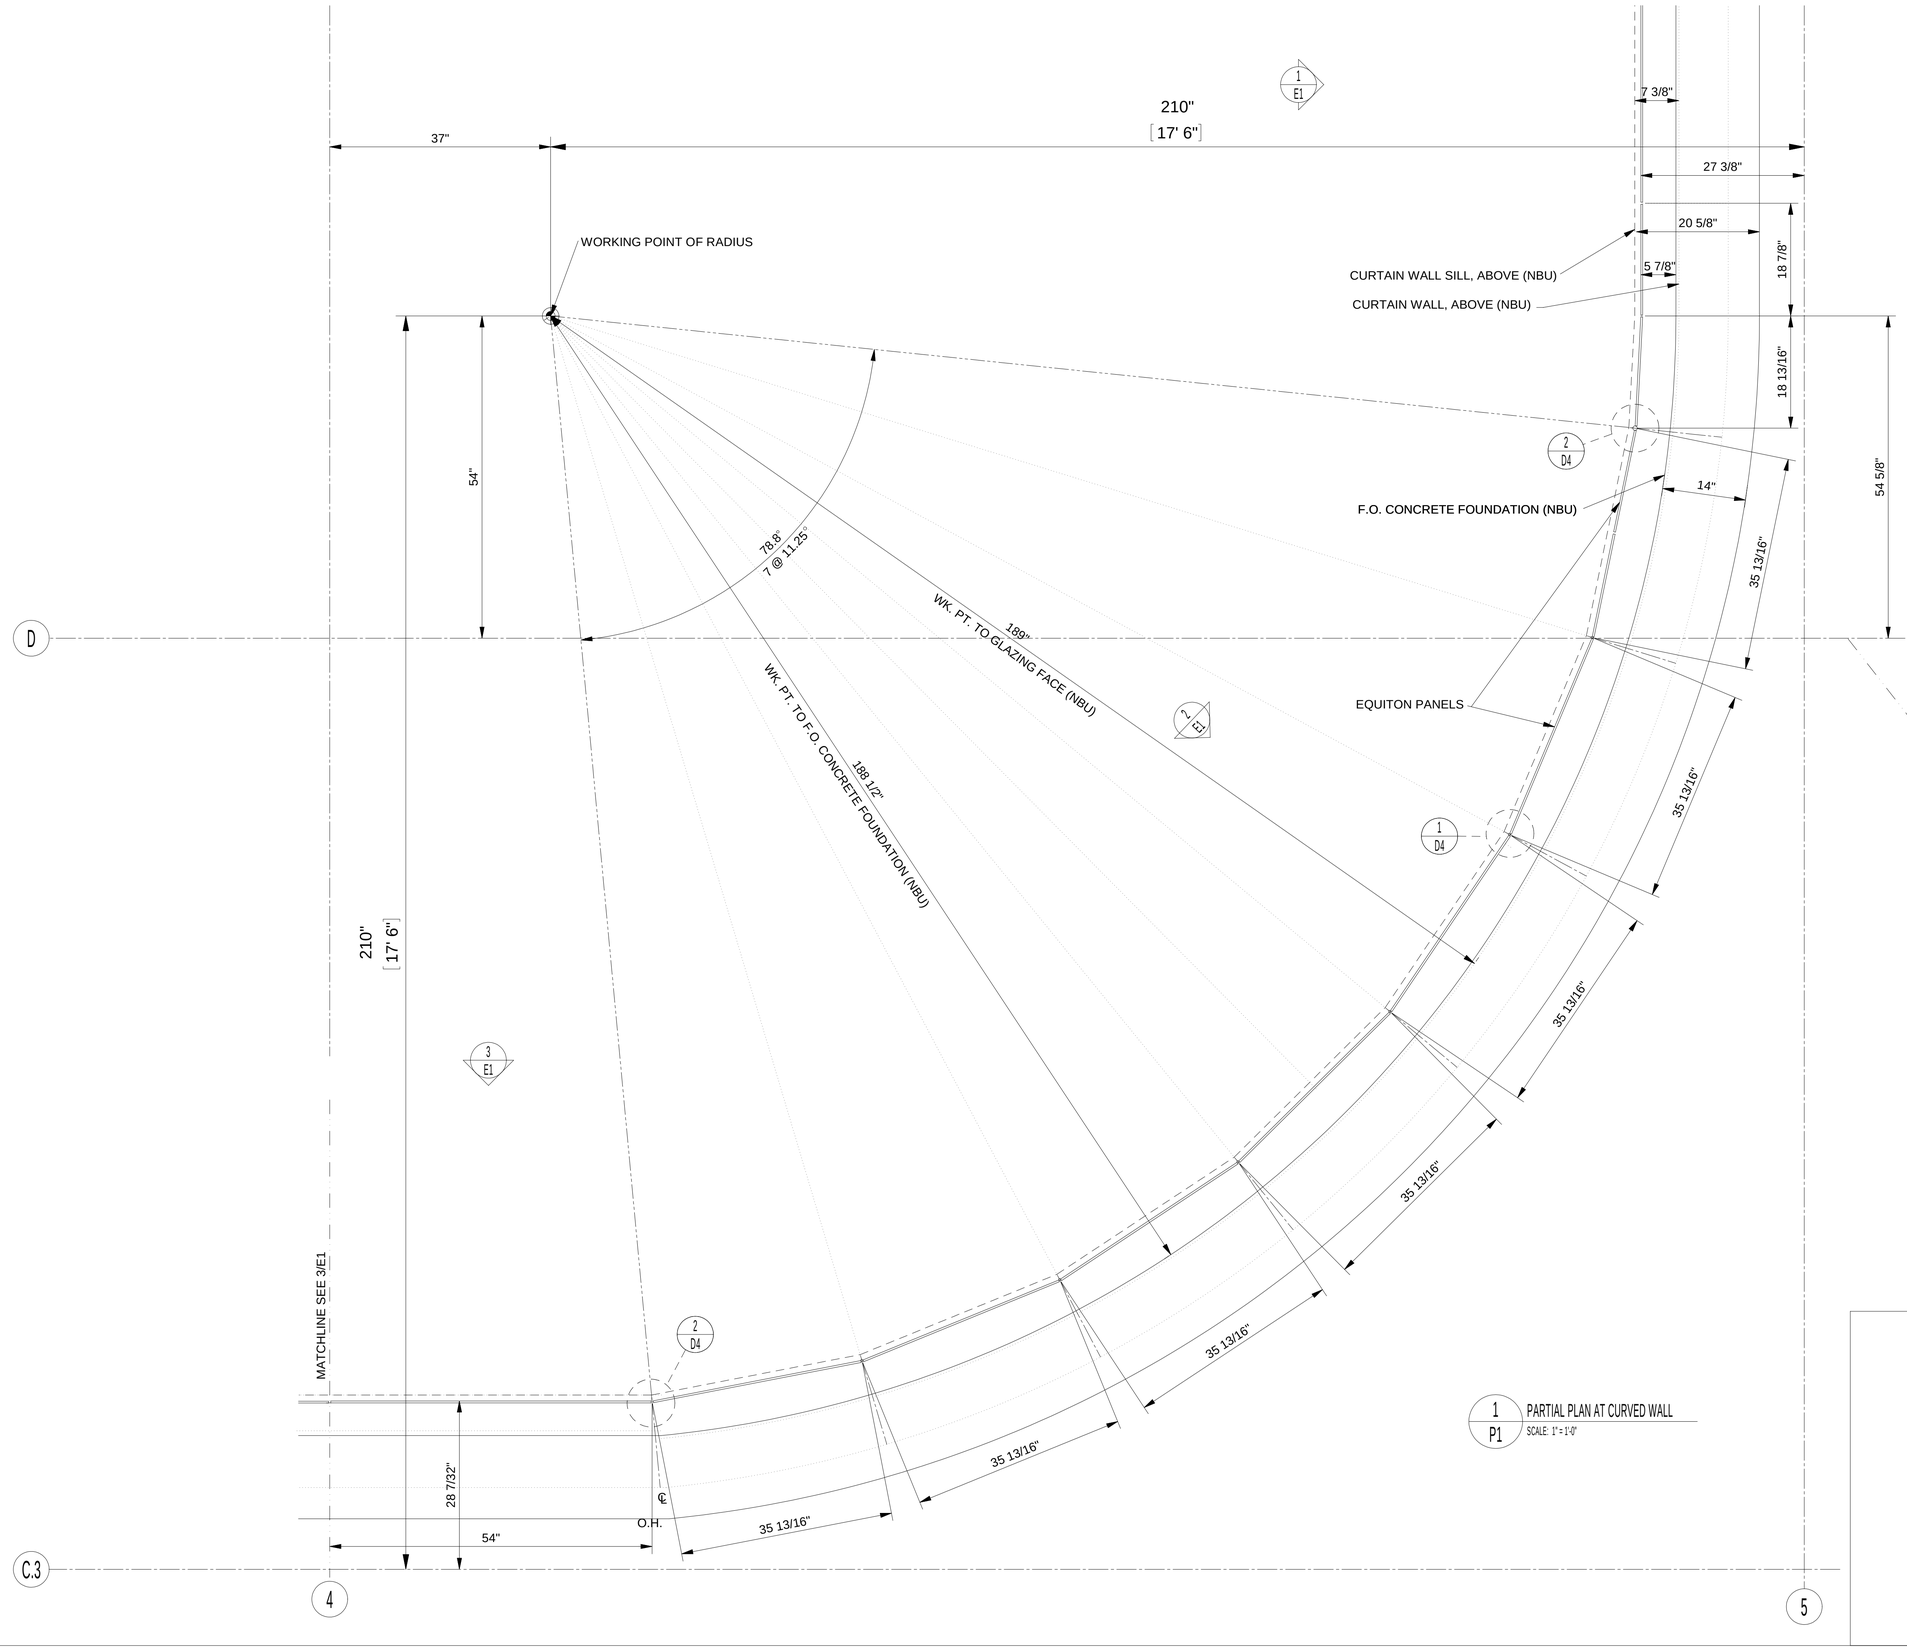

1 P1 PARTIAL PLAN AT CURVED WALL

SCALE: 1" = 1'-0"

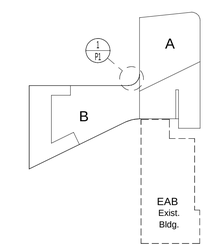

NORTH

2	12-5-2016	KJN
Revised Per Arch. Rev.		
1	11-14-2016	KJN
Revised Per Arch. Rev.		
-	9-16-2016	KJN
1st Submittal Shop Drawings		
Rev.:	Date:	By:

Description

Drawn by KJN

CUSTOMER NAME/LOCATION:
Kluenz Heating and Sheet Metal Company
St. Charles, MO 63304

PROJECT NAME/LOCATION:
Webster University Interdisciplinary Science Bldg- EQUITONE
Webster Groves MO

SHEET DESCRIPTION:
PARTIAL PLAN

UNIVERSE CORPORATION
3333 FOERSTER RD
ST. LOUIS, MO. 63044-3716
PHONE: (800) 989 6550
FAX: (314) 439 2801
www.universecorp.com

THE DRAWING IS THE PROPERTY OF UNIVERSE CORPORATION AND MUST BE RETURNED UPON REQUEST. ALL REPRODUCTIONS OR ALTERATIONS MADE HEREIN, DERIVED MAY NOT BE REPRODUCED WITHOUT WRITTEN PERMISSION FROM UNIVERSE CORPORATION.

PROJECT NUMBER:
2016-06-0556

SHEET NUMBER:
P1

= INDICATES SEGMENTED PANELS ON CURVED FOUNDATION

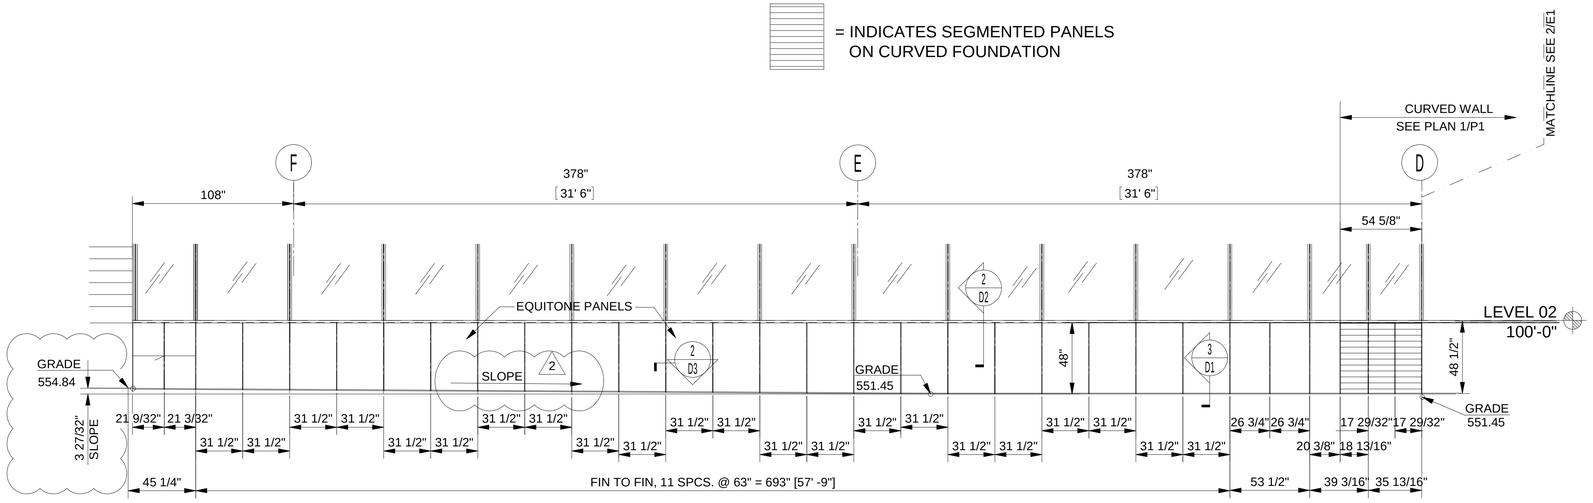

1 E1 WEST ELEVATION
SCALE: 1/4" = 1'-0" (ARCH. REF. 1/A0311)

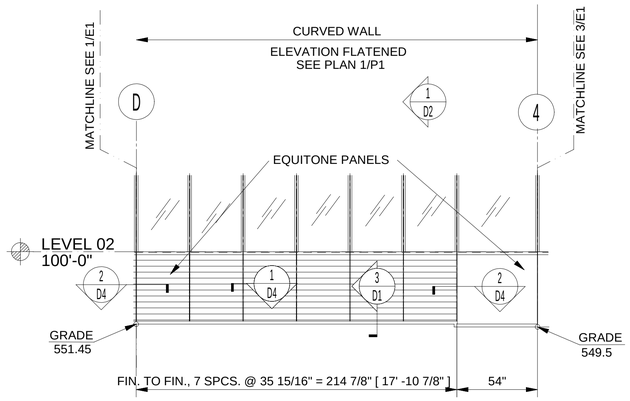

2 E1 FLATENED NORTH WEST ELEVATION AT CURVED WALL
SCALE: 1/4" = 1'-0"

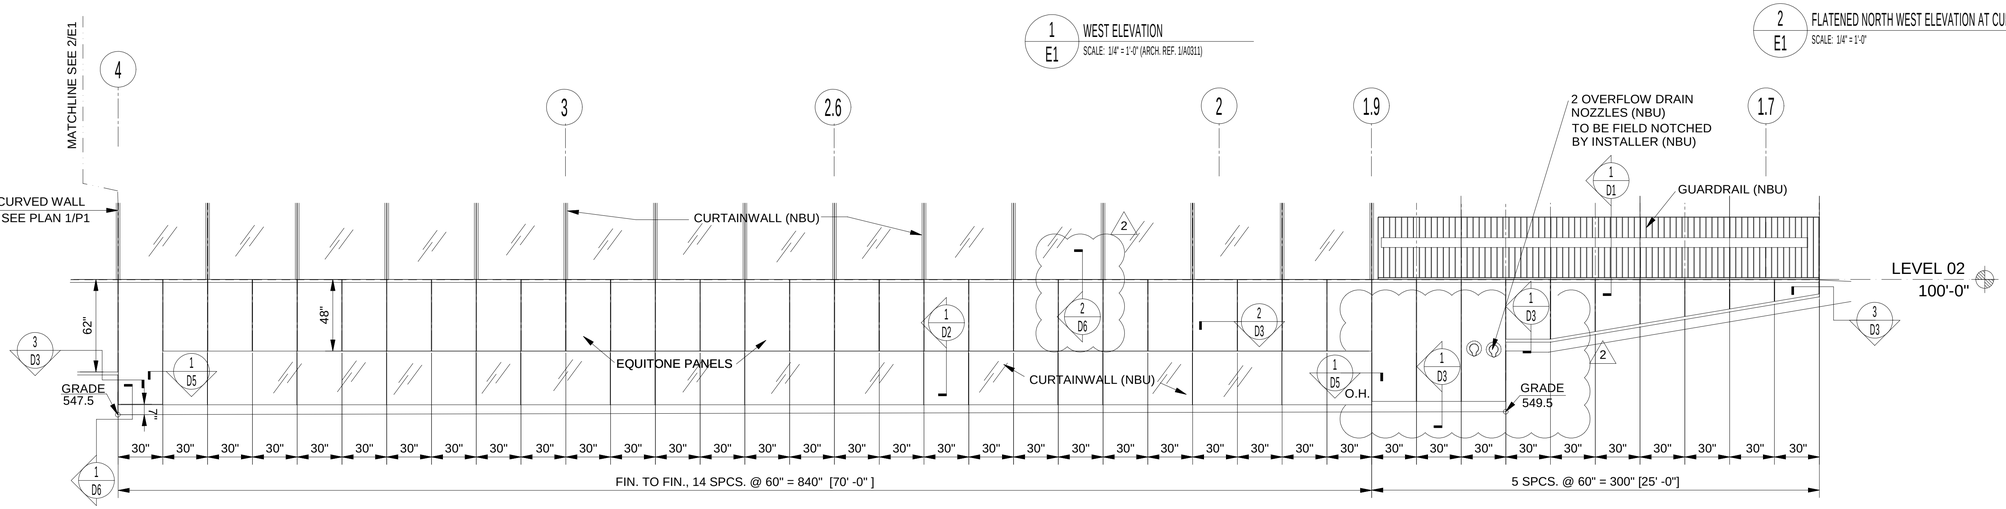

3 E1 NORTH ELEVATION
SCALE: 1/4" = 1'-0" (ARCH. REF. 2/A0312)

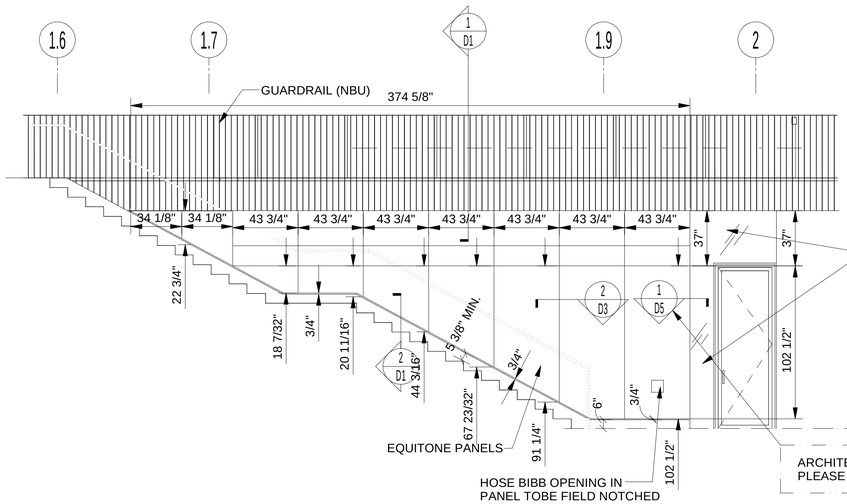

4 E1 SOUTH ELEV. AT SOUTH WING
SCALE: 1/4" = 1'-0" (ARCH. REF. 2/A0313)

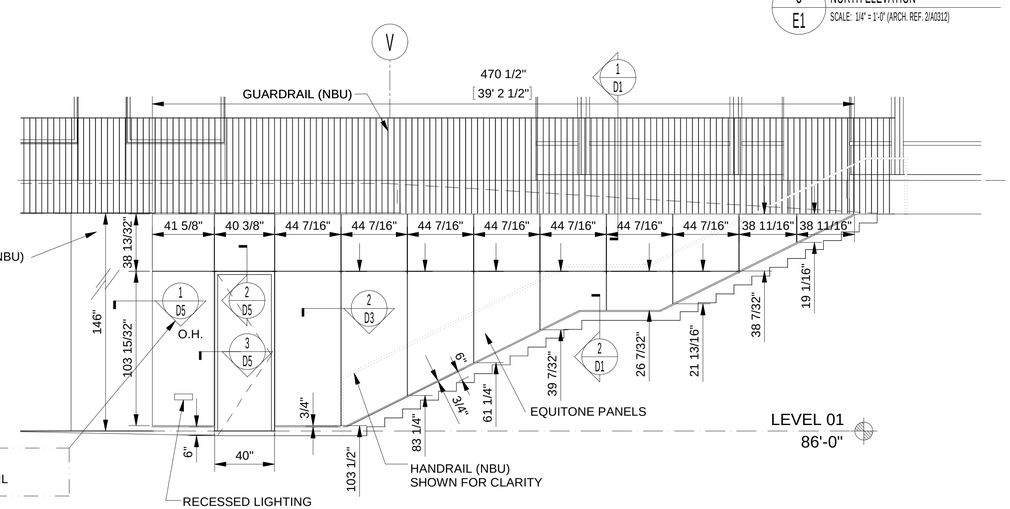

5 E1 WEST ELEV. AT SOUTH WING
SCALE: 1/4" = 1'-0" (ARCH. REF. 2/A0311)

G.C. NOTE:

COORDINATE HEIGHT OF PANELS WITH GRADES, STAIRS AND STONE SHOP DRAWINGS

LEVEL 02
100'-0"

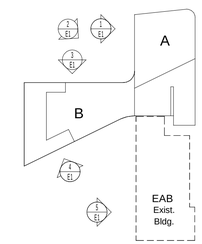

Rev.	Date	By
2	12-5-2016	KJN
Revised Per Arch. Rev.		
1	11-14-2016	KJN
Revised Per Arch. Rev.		
	9-16-2016	KJN
1st Submittal Shop Drawings		

Description

Drawn by KJN

CUSTOMER NAME/LOCATION:
Kluenz Heating and Sheet Metal Company
St. Charles, MO 63304

PROJECT NAME/LOCATION:
Webster University Interdisciplinary Science Bldg- EQUITONE
Webster Groves MO

SHEET DESCRIPTION:
ELEVATIONS

UNIVERSE CORPORATION
3333 FOERSTER RD
ST. LOUIS, MO. 63044-3716
PHONE: (800) 989 6550
FAX: (314) 439 2801
www.universecorp.com

THE DRAWING IS THE PROPERTY OF UNIVERSE CORPORATION AND MUST BE RETURNED UPON REQUEST. ALL RIGHTS RESERVED. THIS DRAWING OR PORTIONS THEREOF MAY NOT BE REPRODUCED WITHOUT WRITTEN PERMISSION FROM UNIVERSE CORPORATION.

PROJECT NUMBER:
2016-06-0556

SHEET NUMBER:
E1

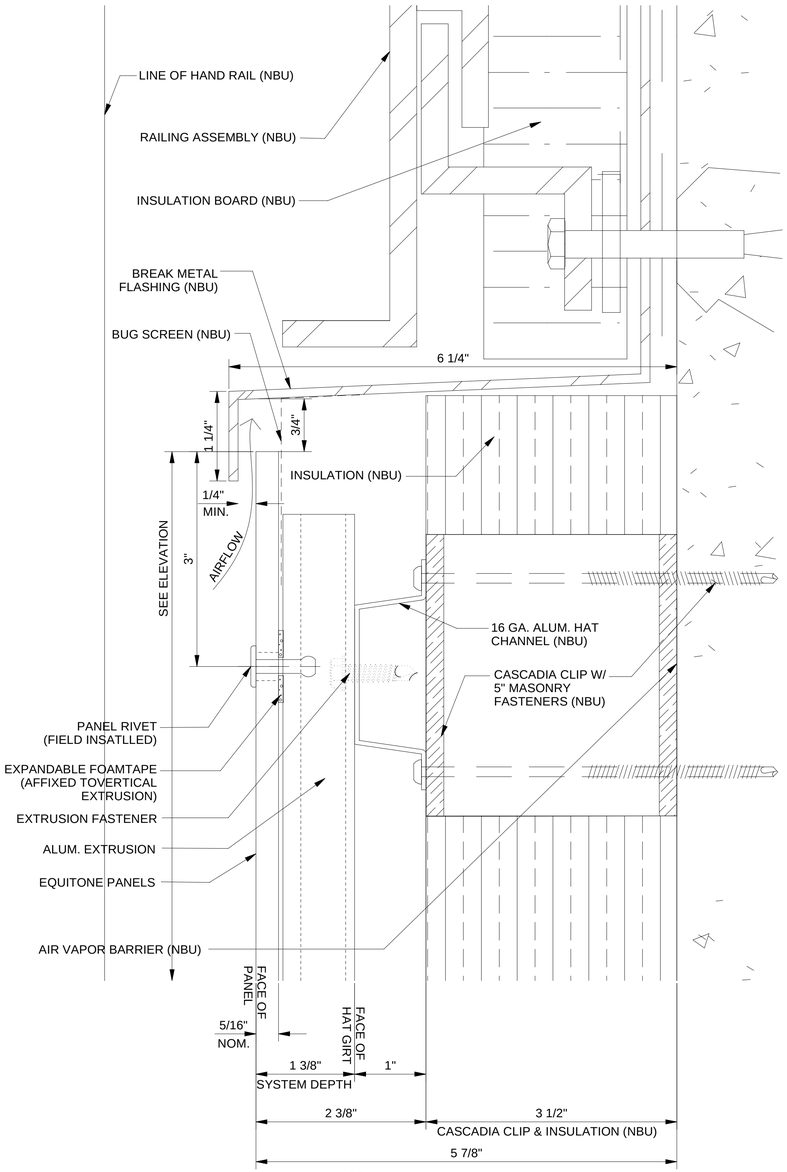

1 D1 DETAIL AT WALKING SURFACE - NORTH AREAWAY
FULLSCALE (ARCH. REF. 7/A0454)

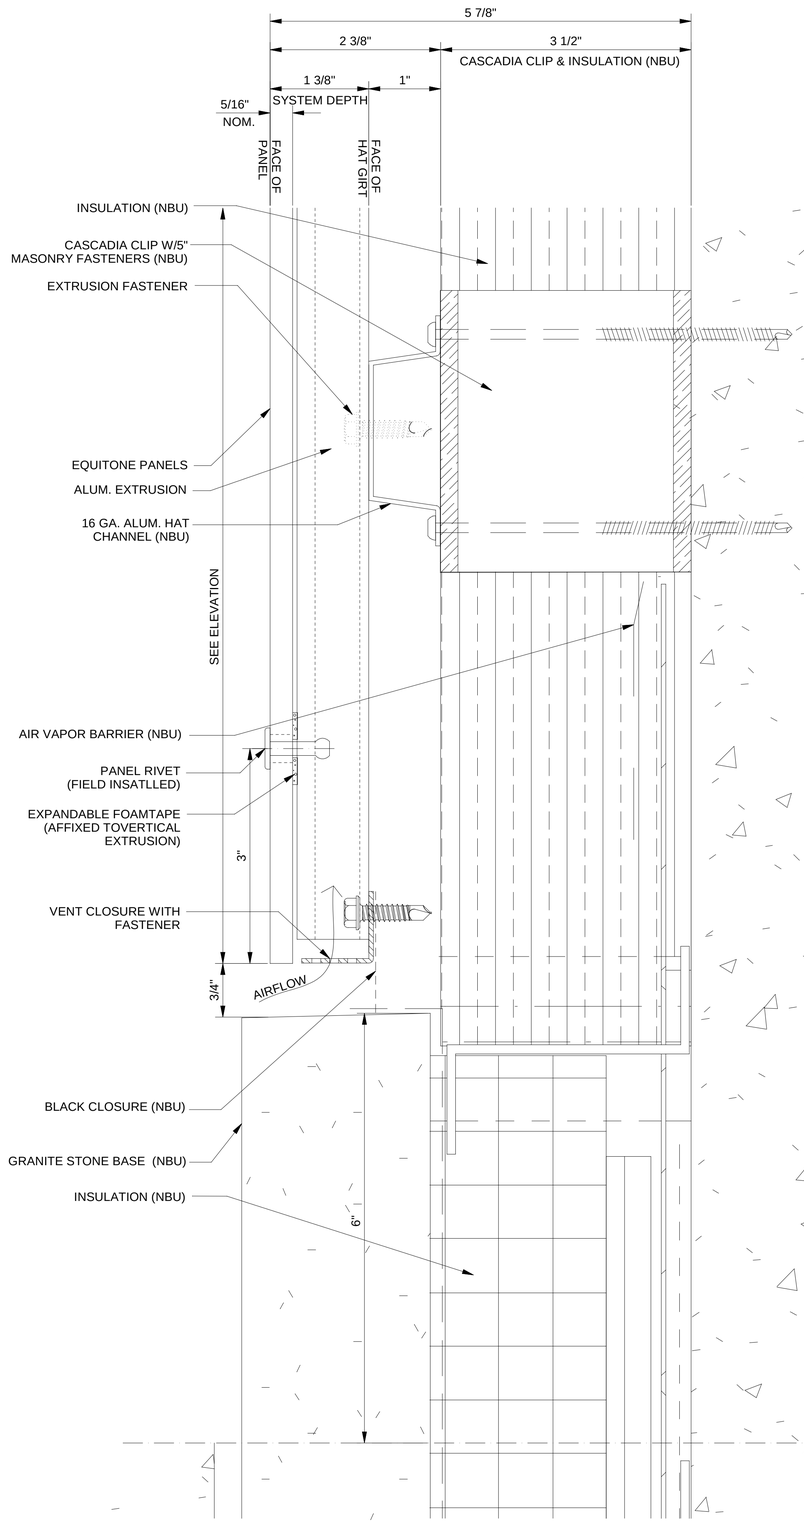

2 D1 DETAIL TERMINATION AT CONC. PAVERS
FULL SCALE (ARCH. REF. 3/A0454)

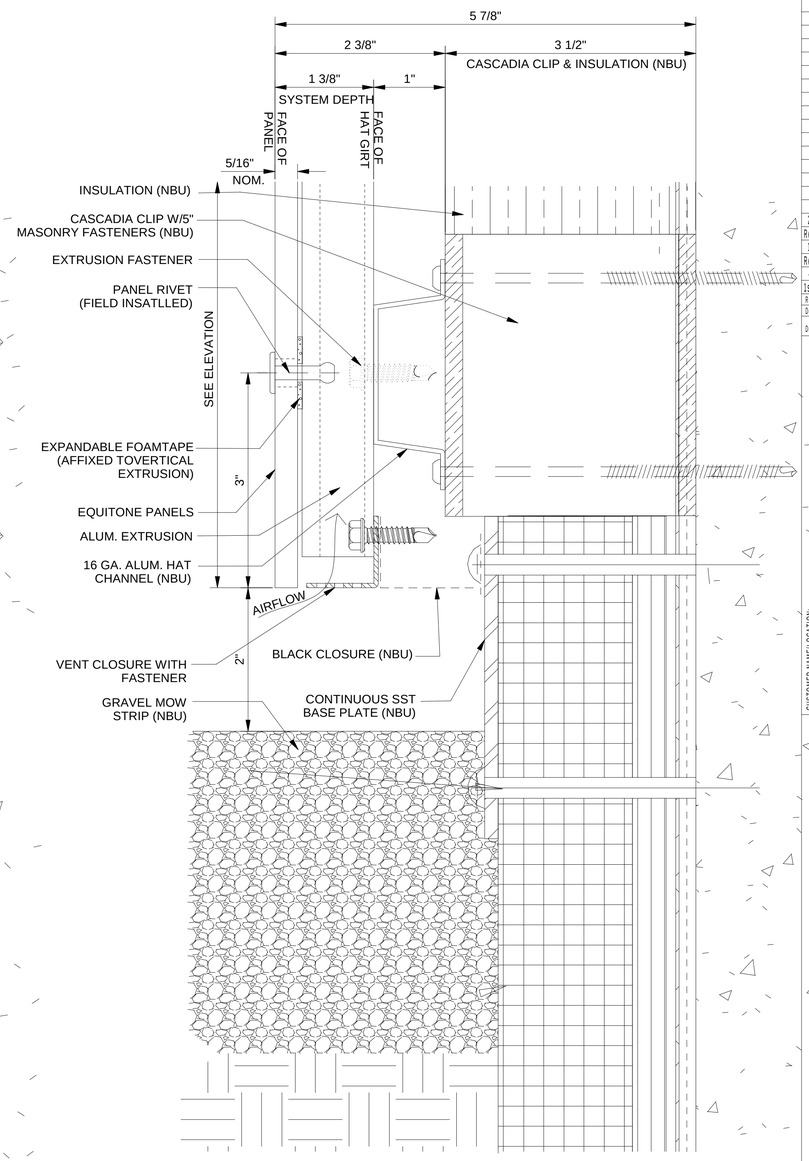

3 D1 DETAIL TERMINATION AT GRAVEL MOW STRIP
FULL SCALE (ARCH. REF. 2/A0451)

2	12-5-2016	KJN
Revised Per Arch. Rev.		
1	11-14-2016	KJN
Revised Per Arch. Rev.		
-	9-16-2016	KJN
1st Submittal Shop Drawings		
Rev.	Date	By
Description		

Drawn by KJN

CUSTOMER NAME/LOCATION:
Kuenz Heating and Sheet Metal Company
St. Charles, MO 63304

PROJECT NAME/LOCATION:
Webster University Interdisciplinary Science Bldg- EQUITONE
Webster Groves MO

SHEET DESCRIPTION:
SECTION DETAILS

UNIVERSE CORPORATION
3333 FOERSTER RD.
ST. LOUIS, MO. 63044-3716
PHONE: (800) 989 6550
FAX: (314) 439 2001
www.universecorp.com

THE DRAWING IS THE PROPERTY OF UNIVERSE CORPORATION AND MUST BE RETURNED UPON REQUEST. ALL REPRODUCTIONS, IN WHOLE OR IN PART, AND ANY USE OF THE DESIGN DEPICTED MAY NOT BE REPRODUCED WITHOUT WRITTEN PERMISSION FROM UNIVERSE CORPORATION.

PROJECT NUMBER:
2016-06-0556

SHEET NUMBER:
D1

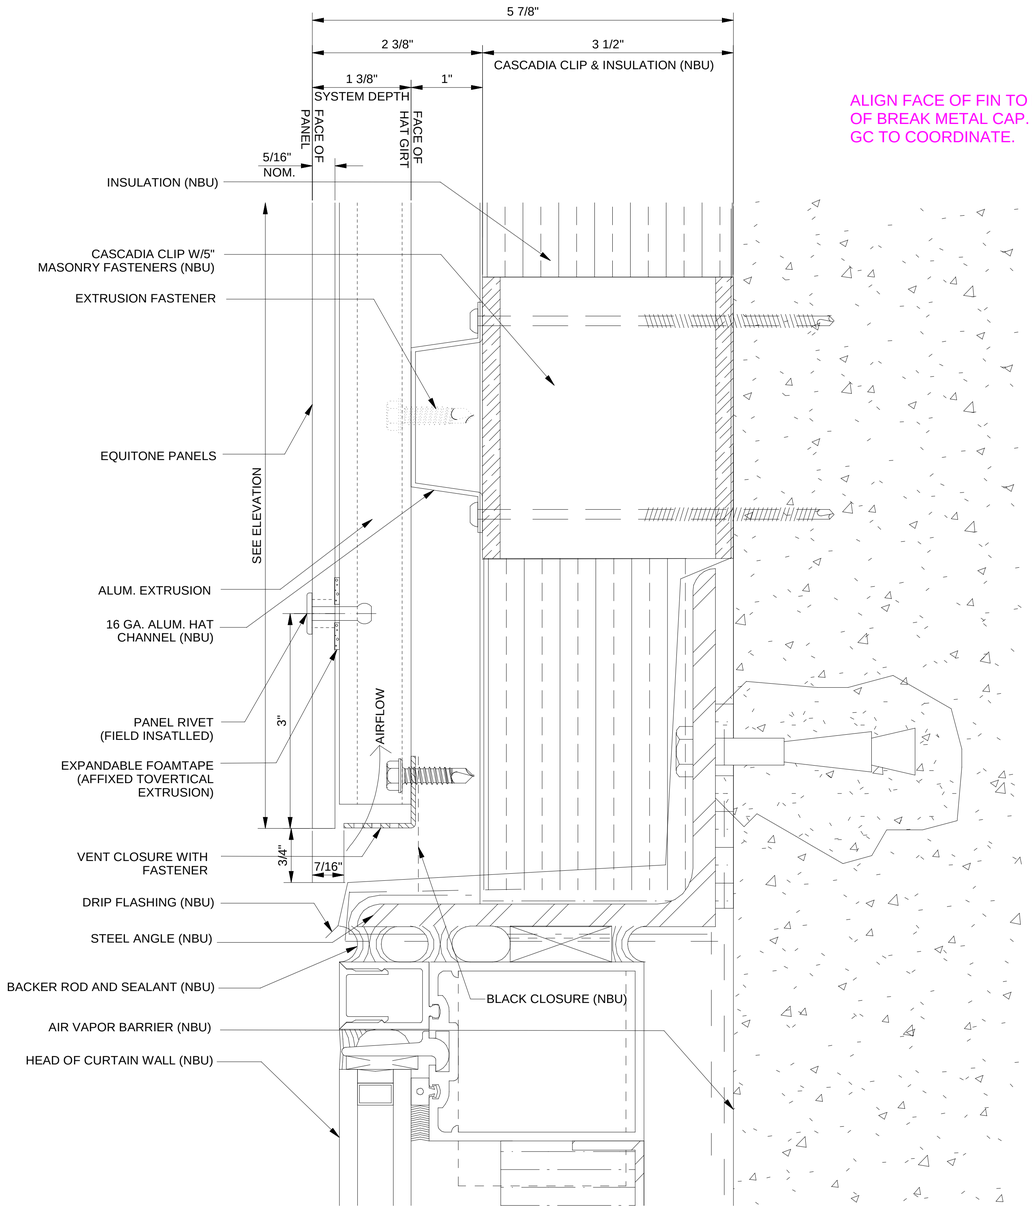

1 / D2 DETAIL AT HEAD OF SPANDREL GLAZING
FULL SCALE (ARCH. REF. 5/A0451)

ALIGN FACE OF FIN TO FACE OF BREAK METAL CAP. GC TO COORDINATE.

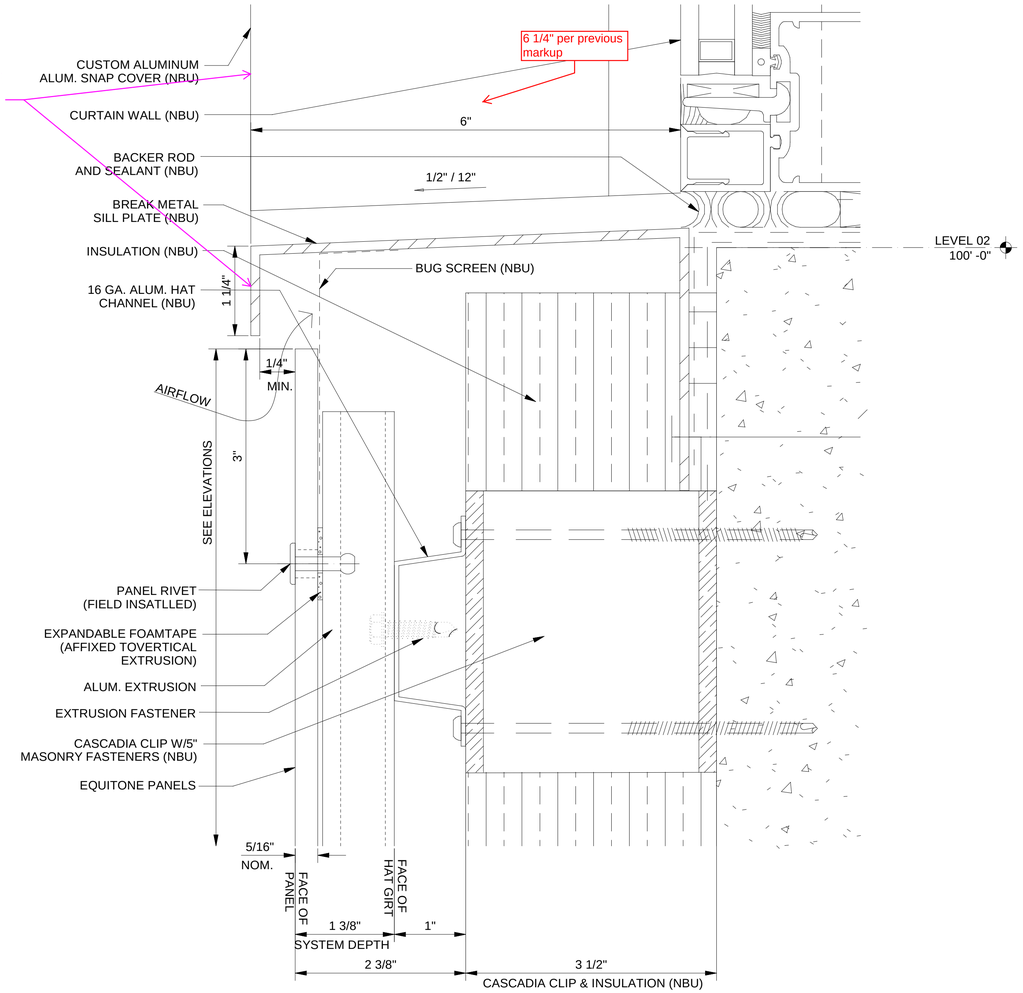

2 / D2 DETAIL AT CURTAIN WALL SILL
FULL SCALE (ARCH. REF. 1/A0451)

2	12-5-2016	KJN
Revised Per Arch. Rev.		
1	11-14-2016	KJN
Revised Per Arch. Rev.		
-	9-16-2016	KJN
1st Submittal Shop Drawings		
Rev.	Date	By
Description		

Drawn by KJN

CUSTOMER NAME/LOCATION:
Kuenz Heating and Sheet Metal Company
St. Charles, MO 63304

PROJECT NAME/LOCATION:
Webster University Interdisciplinary Science Bldg- EQUITONE
Webster Groves MO

SHEET DESCRIPTION:
SECTION DETAILS

UNIVERSE CORPORATION
3333 FOERSTER RD.
ST. LOUIS, MO. 63044-3716
PHONE:(800) 989 6550
FAX: (314) 439 2801
www.universecorp.com

THE DRAWING IS THE PROPERTY OF UNIVERSE CORPORATION AND MUST BE RETURNED UPON REQUEST. ITS USE AND/OR REPRODUCTION IS RESTRICTED AND MAY NOT BE REPRODUCED WITHOUT WRITTEN PERMISSION FROM UNIVERSE CORPORATION.

PROJECT NUMBER:
2016-06-0556

SHEET NUMBER:
D2

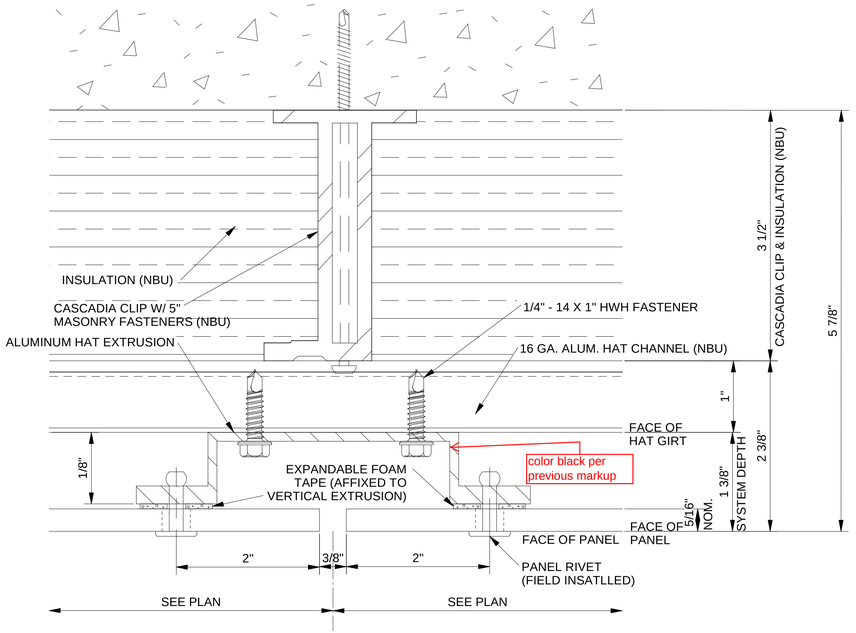

2 / D3 PLAN DETAIL AT VERT. PANEL JOINT
SCALE: FULL SIZE

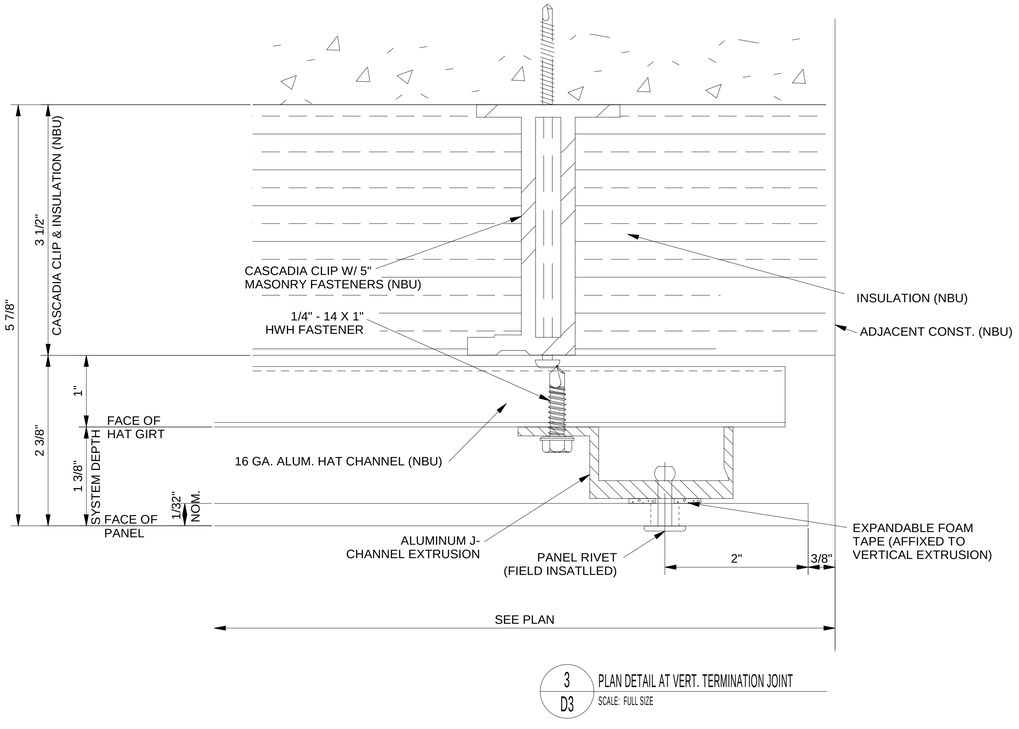

3 / D3 PLAN DETAIL AT VERT. TERMINATION JOINT
SCALE: FULL SIZE

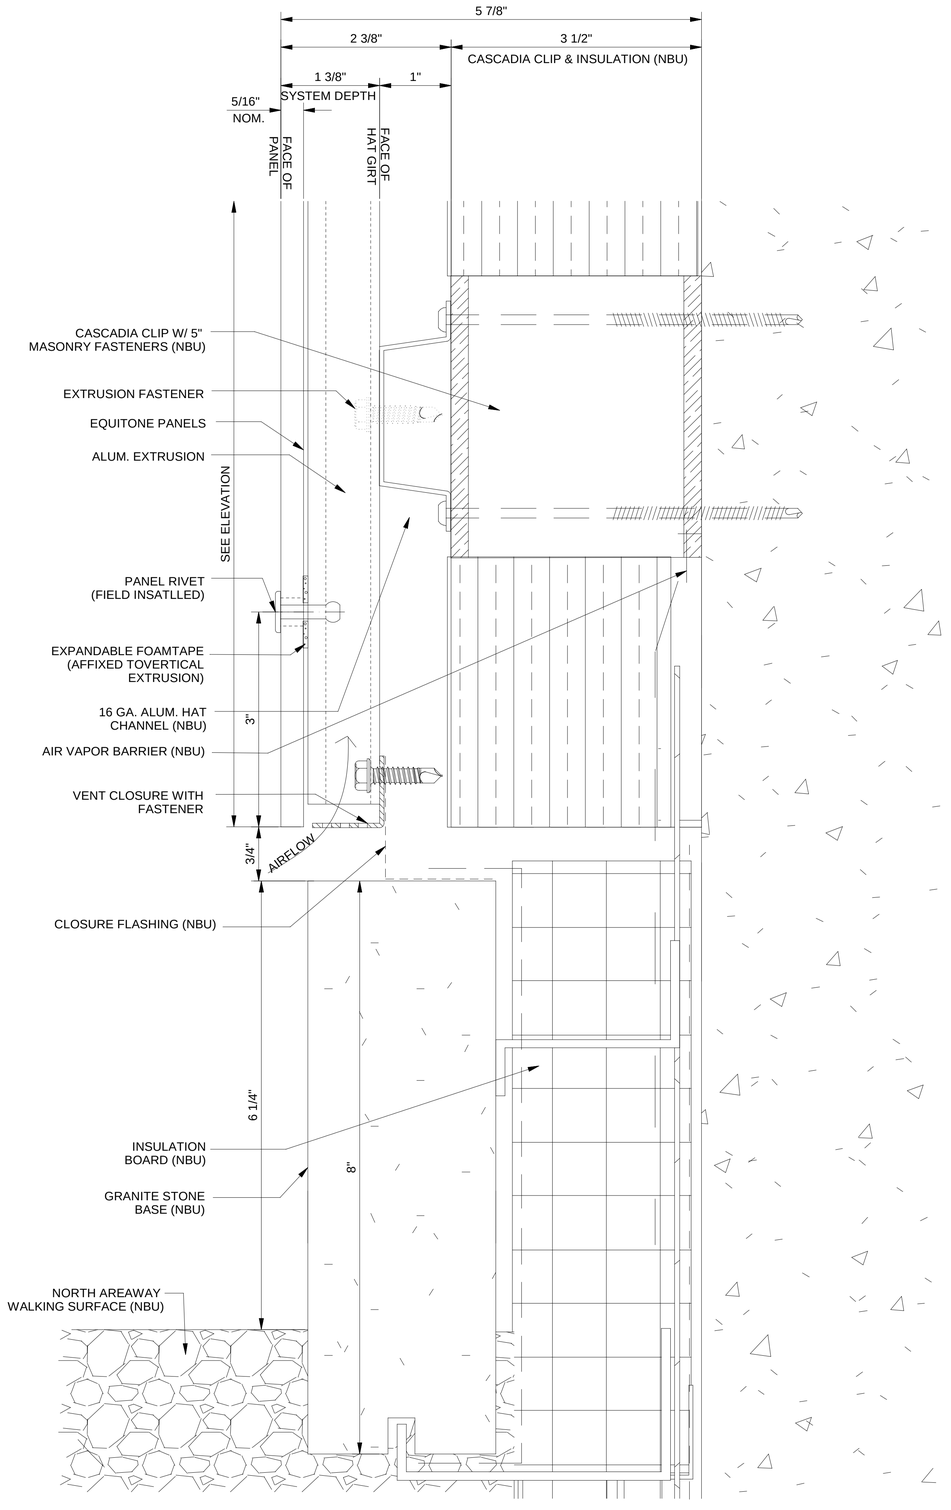

1 / D3 DETAIL AT GRADE TERMINATION
FULL SCALE (ARCH. REF. 7/AD453)

2	12-5-2016	KJN
Revised Per Arch. Rev.		
1	11-14-2016	KJN
Revised Per Arch. Rev.		
-	9-16-2016	KJN
1st Submittal Shop Drawings		
Rev.:	Date	By
Description		

Drawn by KJN

CUSTOMER NAME/LOCATION:
Kluenz Heating and Sheet Metal Company
St. Charles, MO 63304

PROJECT NAME/LOCATION:
Webster University Interdisciplinary Science Bldg- EQUITONE
Webster Groves MO

SHEET DESCRIPTION:
SECTION DETAILS

UNIVERSE CORPORATION
3333 FOERSTER RD.
ST. LOUIS, MO. 63044-3716
PHONE: (800) 989 6550
FAX: (314) 439 2801
www.universecorp.com

THE DRAWING IS THE PROPERTY OF UNIVERSE CORPORATION AND MUST BE RETURNED UPON REQUEST. ALL RIGHTS RESERVED. NO PART OF THIS PRINT IS TO BE DEPICTED MAY NOT BE REPRODUCED WITHOUT WRITTEN PERMISSION FROM UNIVERSE CORPORATION.

PROJECT NUMBER:
2016-06-0556

SHEET NUMBER:
D3

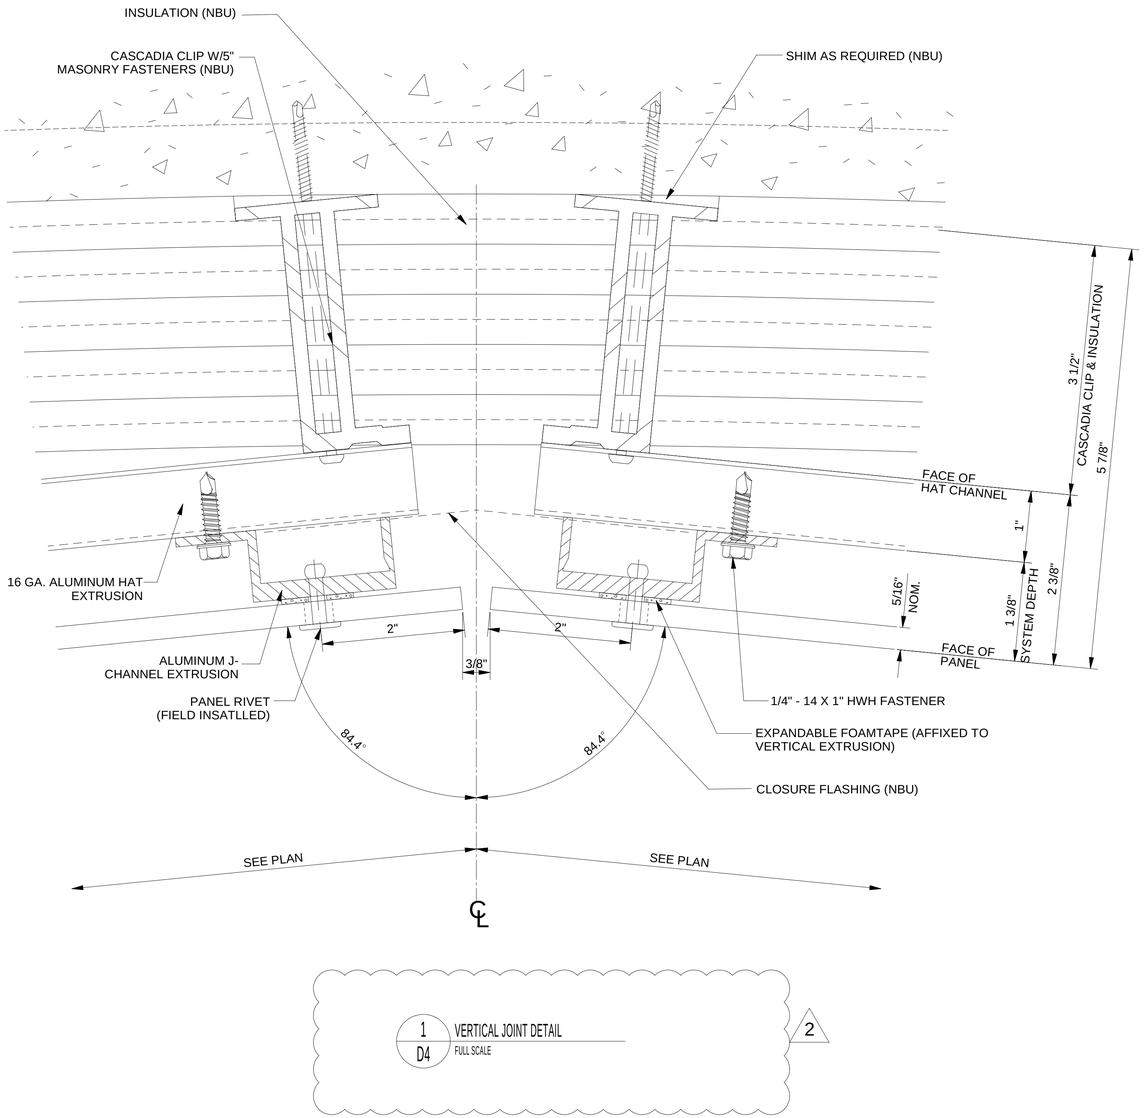

1 D4 VERTICAL JOINT DETAIL
FULL SCALE

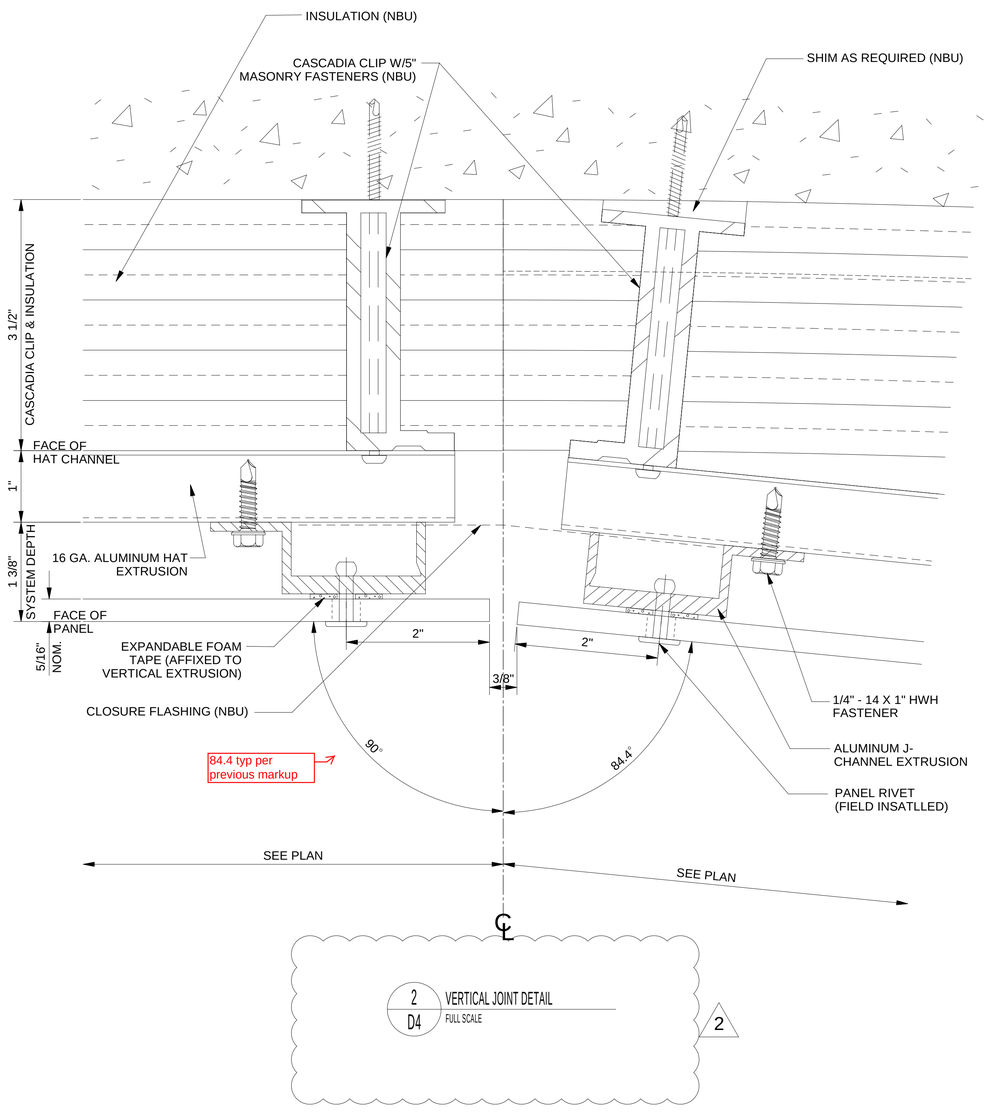

2 D4 VERTICAL JOINT DETAIL
FULL SCALE

Rev.	Date	By
2	12-5-2016	KJN
Revised Per Arch. Rev.		
1	11-14-2016	KJN
Revised Per Arch. Rev.		
-	9-16-2016	KJN
1st Submittal Shop Drawings		

Drawn by KJN

CUSTOMER NAME/LOCATION:
Kluenz Heating and Sheet Metal Company
St. Charles, MO 63304

PROJECT NAME/LOCATION:
Webster University Interdisciplinary Science Bldg- EQUITONE
Webster Groves MO

SHEET DESCRIPTION:
FULL SIZE DETAILS

UNIVERSE CORPORATION
3333 FOERSTER RD.
ST. LOUIS, MO. 63044-3716
PHONE:(800) 989 6550
FAX: (314) 439 2801
www.universecorp.com

THE DRAWING IS THE PROPERTY OF UNIVERSE CORPORATION AND MUST BE RETURNED UPON REQUEST. IT IS LOANED SUBJECT TO AGREEMENT THAT IT WILL NOT BE DISCLOSED, USED OR REPRODUCED WITHOUT THE WRITTEN PERMISSION FROM UNIVERSE CORPORATION.

PROJECT NUMBER:
2016-06-0556

SHEET NUMBER:
D4

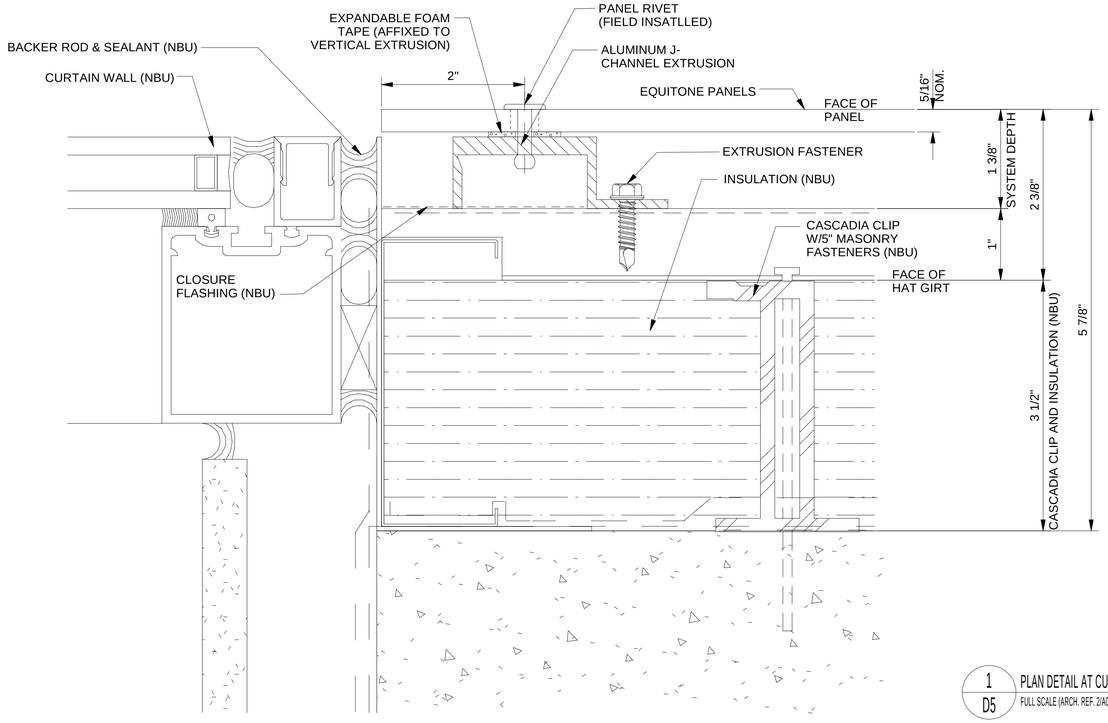

1 / D5 PLAN DETAIL AT CURTAINWALL JAMB
FULL SCALE (ARCH. REF. 2/A0422)

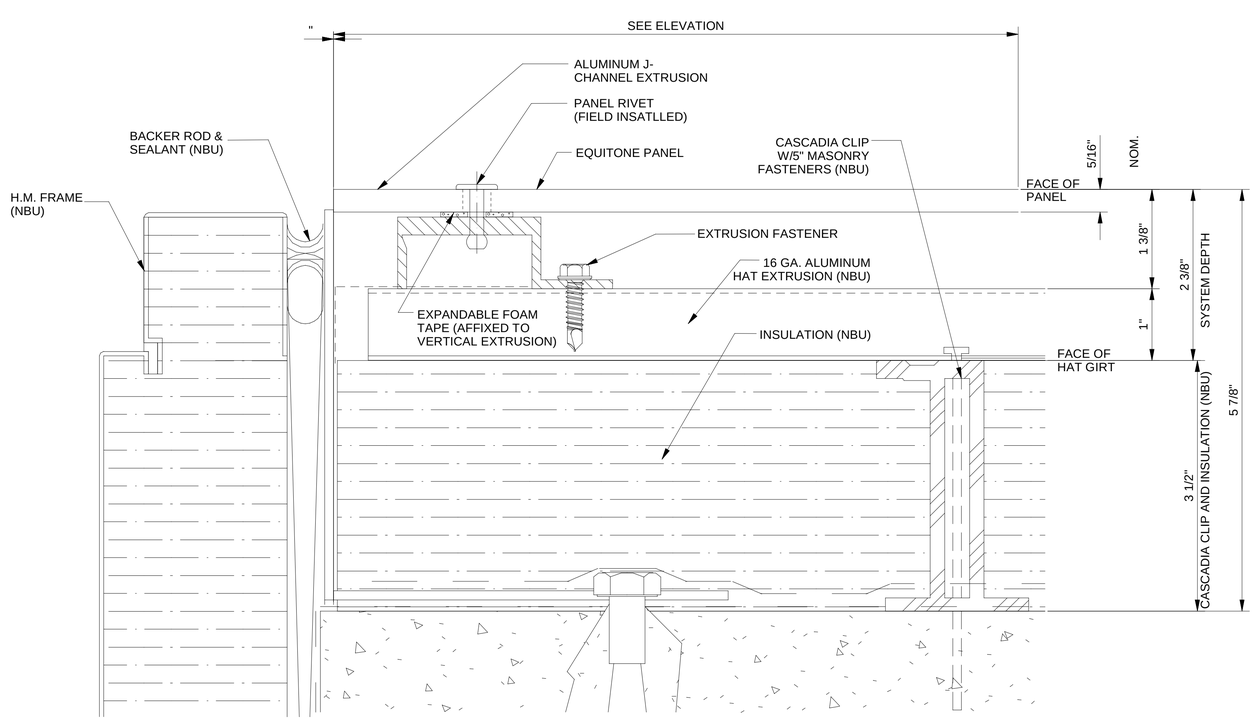

3 / D5 PLAN DETAIL AT DOOR JAMB
FULL SCALE (ARCH. REF. 3/A1011)

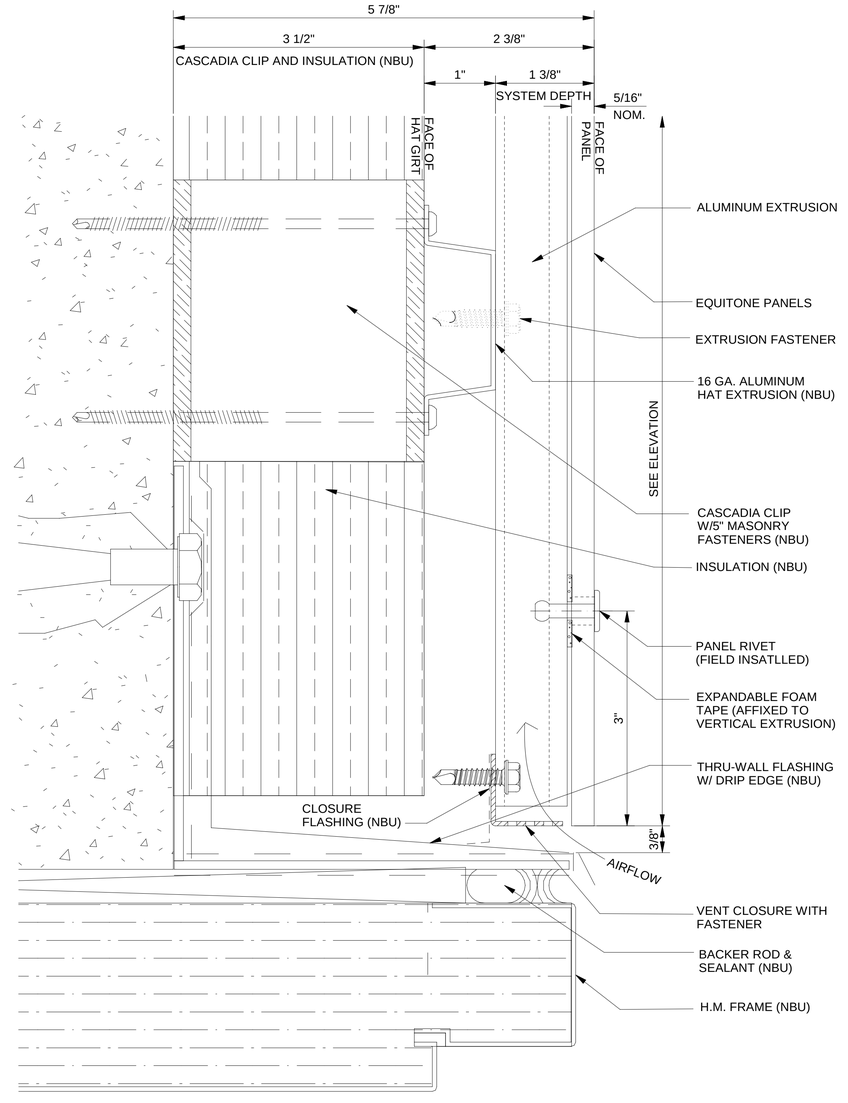

2 / D5 SECTION DETAIL AT DOOR HEAD
FULL SCALE (ARCH. REF. 7/A1011)

Rev.	Date	By
2	12-5-2016	KJN
Revised Per Arch. Rev.		
1	11-14-2016	KJN
Revised Per Arch. Rev.		
-	9-16-2016	KJN
1st Submittal Shop Drawings		

Description

Drawn by KJN

CUSTOMER NAME/LOCATION:
Kluenz Heating and Sheet Metal Company
St. Charles, MO 63304

PROJECT NAME/LOCATION:
Webster University Interdisciplinary Science Bldg- EQUITONE
Webster Groves MO

SHEET DESCRIPTION:
FULL SIZE DETAILS

UNIVERSE CORPORATION
3333 FOERSTER RD.
ST. LOUIS, MO. 63044-3716
PHONE: (800) 989 6550
FAX: (314) 439 2801
www.universecorp.com

THE DRAWING IS THE PROPERTY OF UNIVERSE CORPORATION AND MUST BE RETURNED UPON REQUEST. THE DESIGNS AND IDEAS INCORPORATED HEREIN AS DENOTED MAY NOT BE REPRODUCED WITHOUT WRITTEN PERMISSION FROM UNIVERSE CORPORATION

PROJECT NUMBER:
2016-06-0556

SHEET NUMBER:
D5

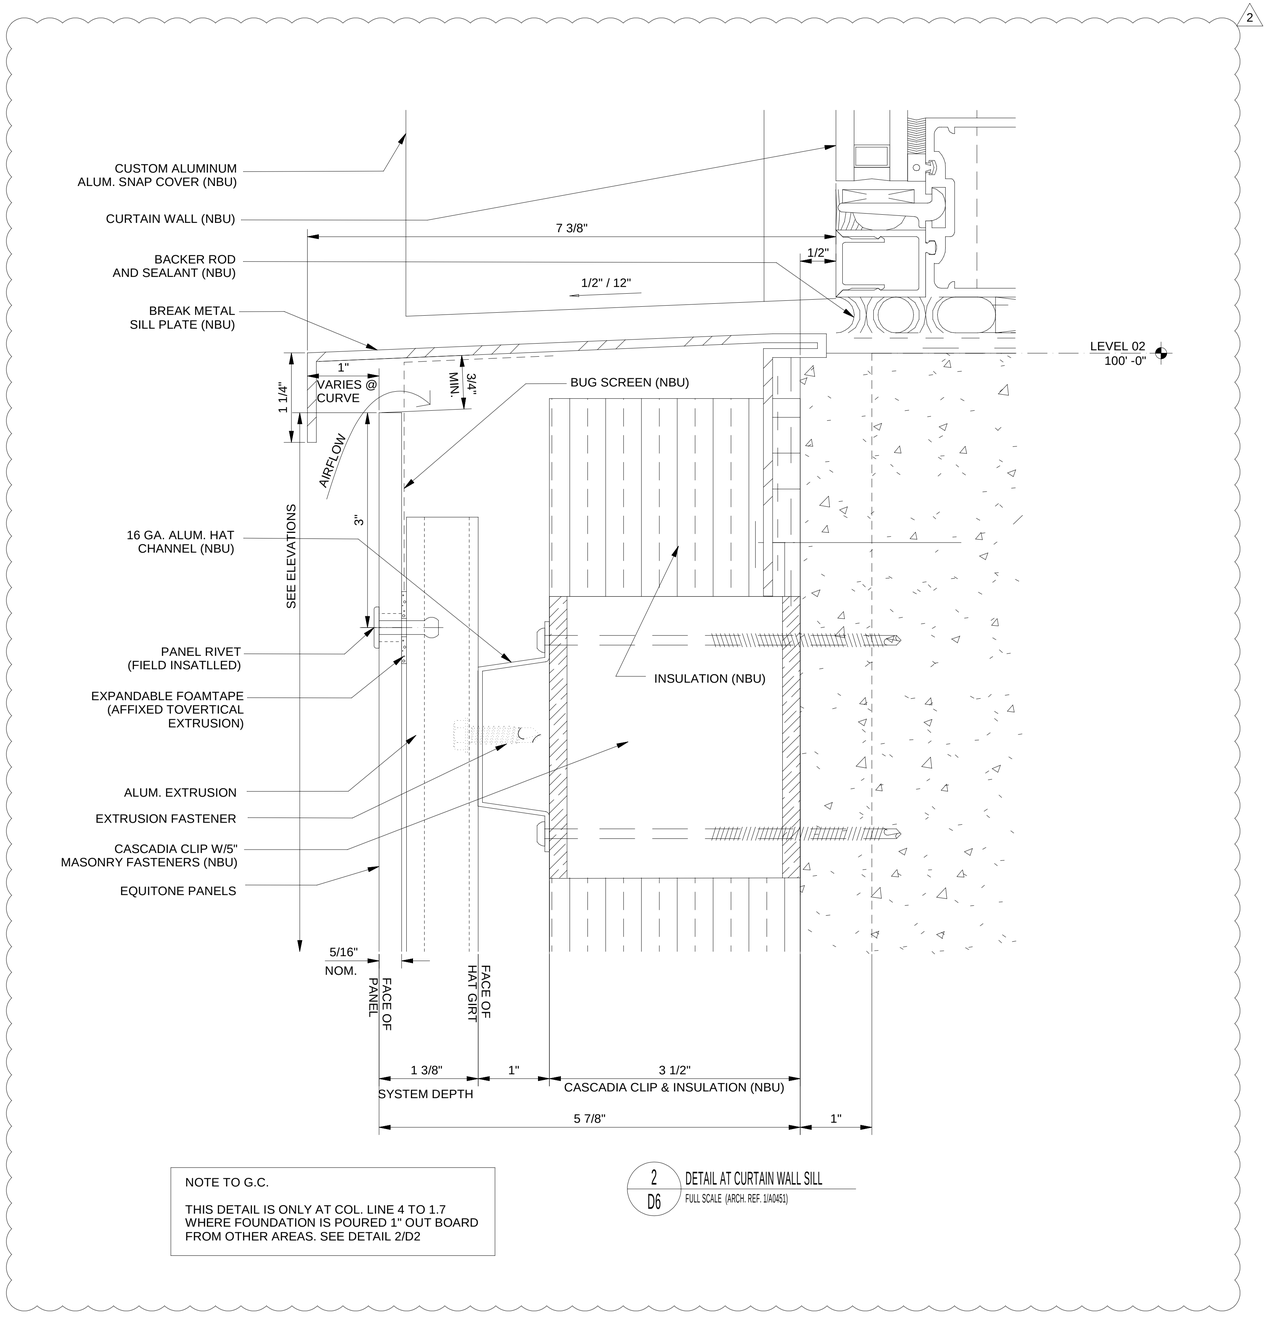

NOTE TO G.C.

THIS DETAIL IS ONLY AT COL. LINE 4 TO 1.7 WHERE FOUNDATION IS POURED 1" OUT BOARD FROM OTHER AREAS. SEE DETAIL 2/D2

2/D6 DETAIL AT CURTAIN WALL SILL
FULL SCALE (ARCH. REF. 1/A0451)

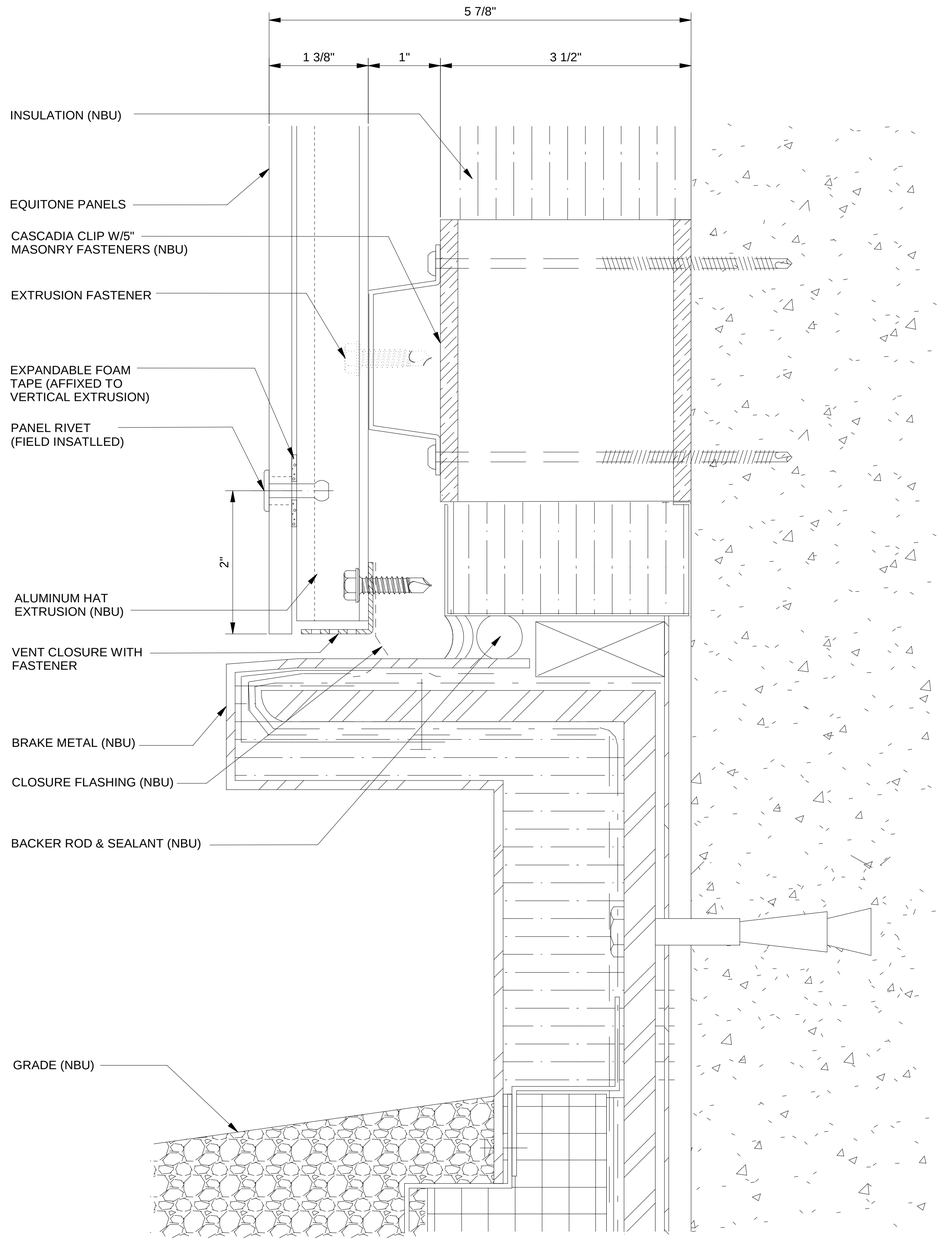

1/D6 BASE SECTION DETAIL AT GRADE
FULL SCALE (ARCH. REF. 3/A0451)

2	12-5-2016	KJN
Revised Per Arch. Rev.		
1	11-14-2016	KJN
Revised Per Arch. Rev.		
-	8-16-2016	KJN
1st Submittal Shop Drawings		
Rev.	Date	By
Description		

Drawn by KJN

CUSTOMER NAME/LOCATION:
Kluenz Heating and Sheet Metal Company
St. Charles, MO 63304

PROJECT NAME/LOCATION:
Webster University Interdisciplinary Science Bldg- EQUITONE
Webster Groves MO

SHEET DESCRIPTION:
FULL SIZE DETAILS

UNIVERSE CORPORATION
3333 FOERSTER RD
ST. LOUIS, MO. 63044-3716
PHONE: (800) 989 6550
FAX: (314) 439 2801
www.universecorp.com

THE DRAWING IS THE PROPERTY OF UNIVERSE CORPORATION AND MUST BE RETURNED UPON REQUEST. IT IS LOANED SUBJECT TO AGREEMENT THAT IT IS NOT TO BE USED IN WHOLE OR IN PART FOR ANY WORK OTHER THAN THAT DESIGNATED HEREIN, AND THAT IT SHALL NOT BE COPIED OR REPRODUCED DIRECTLY OR INDIRECTLY IN ANY MANNER WHATSOEVER, NOR SHALL THE INFORMATION DISCLOSED HEREIN BE MADE KNOWN TO ANY PERSON, FIRM OR CORPORATION OTHER THAN THOSE AUTHORIZED BY THE UNIVERSE CORPORATION, NOR SHALL IT BE USED IN ANY WAY DETRIMENTAL TO THE INTERESTS OF THE UNIVERSE CORPORATION.

PROJECT NUMBER:
2016-06-0556

SHEET NUMBER:
D6

CANNONDESIGN

SUBMITTAL IDENTIFICATION SHEET

To be completed by Contractor/CM

WEBSTER UNIVERSITY ISB
PROJECT NAME

8274 BIG BEND BLVD
ADDRESS

NUMBER

WEBSTER UNIVERSITY
OWNER

CANNON DESIGN
ARCHITECT / ENGINEER

DEVIN D GATES
SUBMITTED BY

074646-006
CONTRACTOR / CM SUBMITTAL NO.

CANNON DESIGN SUBMITTAL NO.

DRAWING / DETAIL REFERENCE

074646
SPECIFICATION SECTION / PARAGRAPH

MANUFACTURER / SUPPLIER

ITEM / PRODUCT ID

REQUIRED DATE

PRIORITY

◯ CRITICAL

ITEM BEING SUBMITTED (check only one)

- ◉ Shop Drawings
- ◯ Samples (_____ copies)
- ◯ LEED Submittal
- ◯ Certification / Qualifications
- ◯ Record Documents
- ◯ Product Data
- ◯ Coordination Drawing
- ◯ Calculations
- ◯ Schedules
- ◯ O&M Manuals
- ◯ Other _____

ITEM BEING SUBMITTED FOR (check only one)

◉ Action ◯ Information Only ◯ Record

REMARKS OR DEVIATIONS

Revised to show both conditions along north wall.

CONTRACTOR / CM CERTIFICATION
(SUBMITTALS NOT CERTIFIED WILL BE RETURNED WITHOUT REVIEW)

PARIC

PARIC CORPORATION
SUBMITTAL STAMP

THIS SHOP DRAWING HAS BEEN REVIEWED BY PARIC CORPORATION

Subcontractor remains responsible for dimensions, quantities, coordination with other trades and compliance with contract documents.

By:
Devin D. Gates

DEVIN D GATES — REVIEWED BY
12/5/16 — DATE

To be completed by Reviewer

07 4646-006 REV003
CANNON DESIGN SUBMITTAL NUMBER

12/5/16
RECEIVED DATE

- ◯ A. No Exceptions Taken
  No further review of submittal is required.
- ◯ B. Make Corrections Noted
  Incorporate corrections in work; resubmission is not required.
- ◯ C. Revise and Resubmit
  Revise as noted, and resubmit for review.
- ◯ D. Rejected
  Submittal is not in compliance with Contract Documents; provide new submittal.
- ◯ E. For Record / Information Only
  Submittal was reviewed for Record / Information purposes only.
- ◯ F. Not Required for Review
  Submittal is not required by Contract Documents and has not been reviewed.

Review is for conformance with the design concept of this project and for general compliance with contract documents. Contractor is responsible for quantities, dimensions and compliance with contract documents and for information that pertains to fabrication processes, construction techniques and coordination of this work with all trades which will be affected thereby. This review is null and void if submittal deviates from contract documents and does not indicate or note deviations.

A/E COMMENTS ◯ See attached sheet(s) for additional comments

REVIEWED BY

12/6/16 — DATE

WEBSTER UNIVERSITY
INTERDISCIPLINARY SCIENCE BUILDING
WEBSTER GROVES, MISSOURI

ARCHITECT

Cannon Design
Saint Louis, Missouri

CUSTOMER/INSTALLER

Kuentz Heating and Sheet Metal Company
Saint Louis, Missouri

EQUITONE U110-1.00 SYSTEM

SUPPLIED EXTRUSIONS

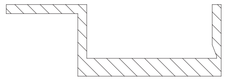

ALUMINUM J-CHANNEL
EXTRUSION
DCA-138
(PAINTED BLACK)

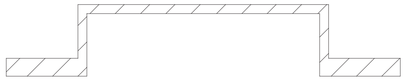

ALUMINUM HAT CHANNEL
EXTRUSION
DCA-140
(PAINTED BLACK)

ALUMINUM VENT SCREEN
EXTRUSION
110-002
(PAINTED BLACK)

(SEE DETAIL DRAWINGS FOR ACTUAL SIZE)

SUPPLIED HARDWARE

PANEL RIVET
(SUPPLIED COLOR MATCHED)

EXTRUSION FASTENER
1/4"-14 X 1" HWH WITH 3/8" HEX HEAD,
#3 DRILL POINT, CLIMASEAL ACR COATED

USE CENTERING TOOL TO DRILL THRU PRE-DRILLED
PANEL HOLES INTO ALUMINUM SUBFRAMING.

DRAWING INDEX

T1 TITLE SHEET - EQUITONE
E1 MOCK-UP ELEVATION AND PLAN

APPROVAL STAMP

KEY PLAN

NTS

SEE E1 MOCK-UP ELEVATION

NORTH

ARCHITECT/CUSTOMER NOTE

UNIVERSE CORPORATION HAS PREPARED THIS SET OF SUBMISSION DRAWINGS IN ACCORDANCE WITH CRITERIA ESTABLISHED BY OTHERS. THE CONTRACTOR SHALL BE RESPONSIBLE TO VERIFY THE INFORMATION CONTAINED HEREIN, INCLUDING ALL DIMENSIONS.

UNIVERSE CORPORATION REQUIRES A "WRITTEN RELEASE TO PROCEED WITH FABRICATION", PRIOR TO MANUFACTURING PANEL MATERIAL.

UNIVERSE CORPORATION WILL FABRICATE ALL OF IT'S MATERIALS FROM THIS APPROVAL SET. IF FIELD VERIFICATION OF DIMENSIONS IS REQUIRED, THE CUSTOMER SHALL BE RESPONSIBLE TO SUPPLY THESE DIMENSIONS TO UNIVERSE CORPORATION PRIOR TO PANEL MANUFACTURING/ENGINEERING.

DISCREPANCIES FOUND DURING FIELD VERIFICATION OF DIMENSIONS SHALL BE CORRECTED BY THE CUSTOMER AND NOT BY UNIVERSE CORPORATION.

GENERAL NOTES

1. MATERIAL TO BE 8mm EQUITONE
2. COLOR/FINISH: N074 [natura] MOCK-UP ONLY
3. ALL DIMENSIONS TO BE VERIFIED.
4. "NBU" INDICATES MATERIAL NOT SUPPLIED BY UNIVERSE CORP.
5. ALL FRAMING TO BE MINIMUM G-90 16-GA. STEEL OR 3/4" TREATED PLYWOOD. (NOT SUPPLIED BY UNIVERSE CORP.)
6. FLUID APPLIED AIR AND MOISTURE BARRIER (N.B.U.),
7. INSULATION OF ANY TYPE (N.B.U.)
8. THESE SHOP DRAWINGS PREPARED USING ARCHITECTURAL DRAWINGS DATED 01.15.2016

SPECIAL NOTES

1. EDGES WILL BE LIGHTLY SANDED TO REMOVE ANY SHARPNESS CREATED WITH THE FABRICATION PROCESS. IF REQUIRED, LUKO WILL BE APPLIED TO EDGES AFTER FABRICATION.
2. ONCE UNIVERSE HAS RECEIVED COLOR AND SHOP DRAWING SUBMITTAL APPROVALS, THERE IS AN 12-14 WEEK LEAD TIME FOR THE PROCUREMENT OF THE EQUITONE MATERIAL. (THIS TIME DOES NOT INCLUDE ENGINEERING AND FABRICATION).
3. IN ACCORDANCE WITH EQUITONE DESIGN CRITERIA, PROPER VENTILATION AND FREE AIR MOVEMENT WITHIN THE AIRSPACE BEHIND THE EQUITONE PANELS MUST BE MAINTAINED. VENT OPENINGS AND JOINT SPACING AS DETAILED IN IN THESE SHOP DRAWINGS MUST REMAIN UNOBSTRUCTED. FAILURE TO MAINTAIN THIS VENTILATION AND AIRSPACE REQUIREMENTS WILL GREATLY AFFECT THE PERFORMANCE OF THESE PANELS. POSSIBLE LEADING TO PANEL SYSTEM ISSUES.

PANEL INSTALLER NOTES

A. TOP OF PANELS DESIGNATED WITH AN "H" ON BACK OF PANELS FOR "HEAD".

B. UNLESS NOTED OTHERWISE , A U7000 SYSTEM REQUIRES AN INSTALL SEQUENCE OF BOTTOM TO TOP

C. CUT-OUTS OR PENETRATIONS IN EQUITONE PANELS DUE TO LIGHT FIXTURES, SCUPPERS, ETC. TO BE FIELD CUT BY PANEL INSTALLER TO INSURE PROPER FIT. (N.B.U.)

Rev.	Date	By
A	8-29-2016	KJN
Description	Rev. 1st Sub. Mock-Up Shop Drawings	
1	8-22-2016	KJN
Description	1st Submittal Mock-Up Shop Drawings	

Drawn by KJN

CUSTOMER NAME/LOCATION:
Kuenz Heating and Sheet Metal Company
St. Charles, MO 63304

PROJECT NAME/LOCATION:
Webster University Interdisciplinary Science Bldg- EQUITONE
Webster Groves MO

SHEET DESCRIPTION:
MOCK-UP TITLESHEET

UNIVERSE CORPORATION
3333 FOERSTER RD
ST. LOUIS, MO. 63044-3716
PHONE: (800) 989 6550
FAX: (314) 439 2801
www.universecorp.com

THE DRAWING IS THE PROPERTY OF UNIVERSE CORPORATION AND MUST BE RETURNED UPON REQUEST. ALL REPRODUCTIONS OR USE FOR ANY PURPOSE NOT DIRECTED MAY NOT BE REPRODUCED WITHOUT WRITTEN PERMISSION FROM UNIVERSE CORPORATION.

PROJECT NUMBER:
2016-06-0556

SHEET NUMBER:
T1

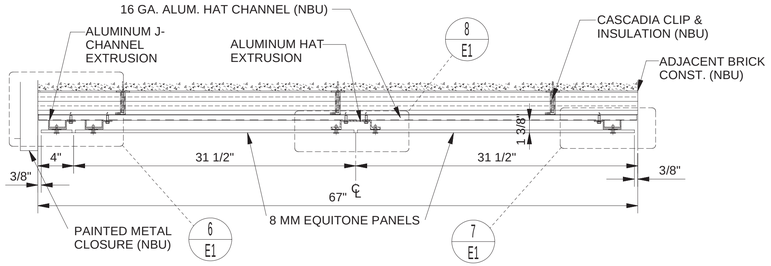

5 E1 MOCK-UP PLAN
SCALE: 1 1/2" = 1'-0"

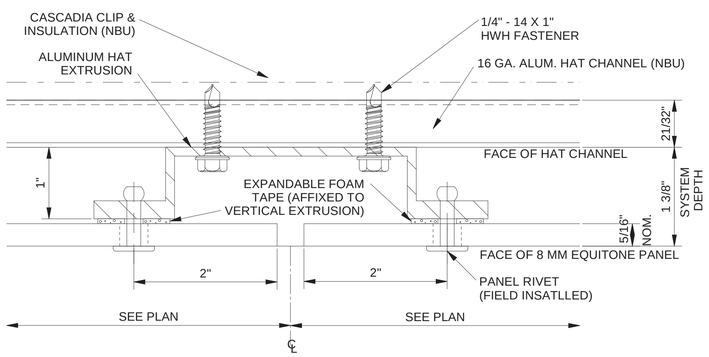

8 E1 DETAIL AT PANEL JOINT WITH HAT CHANNEL
SCALE: FULL SIZE

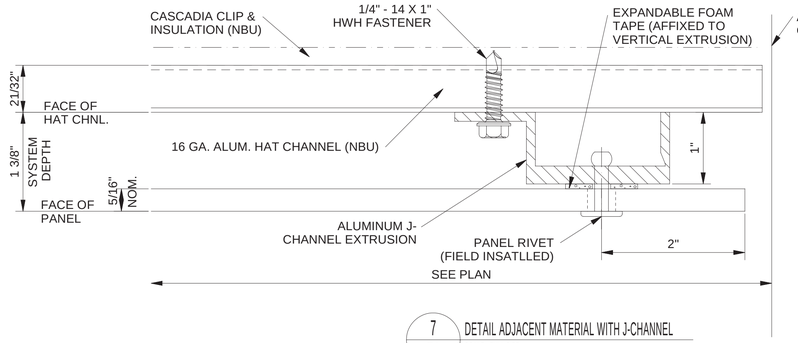

7 E1 DETAIL ADJACENT MATERIAL WITH J-CHANNEL
SCALE: FULL SIZE

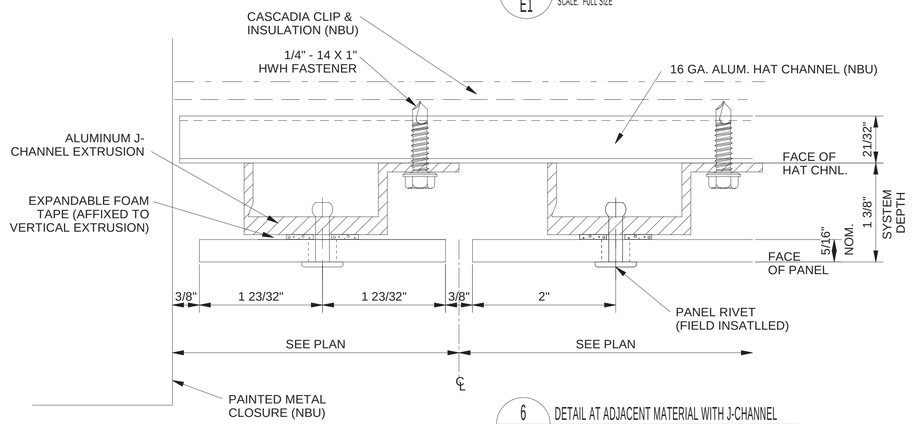

6 E1 DETAIL AT ADJACENT MATERIAL WITH J-CHANNEL
SCALE: FULL SIZE

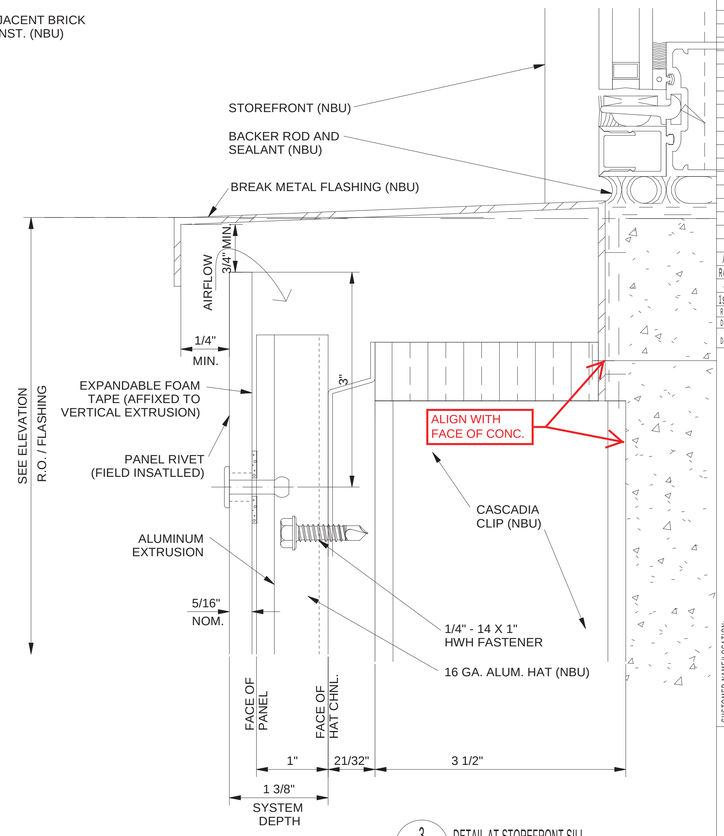

3 E1 DETAIL AT STOREFRONT SILL
SCALE: FULL SIZE

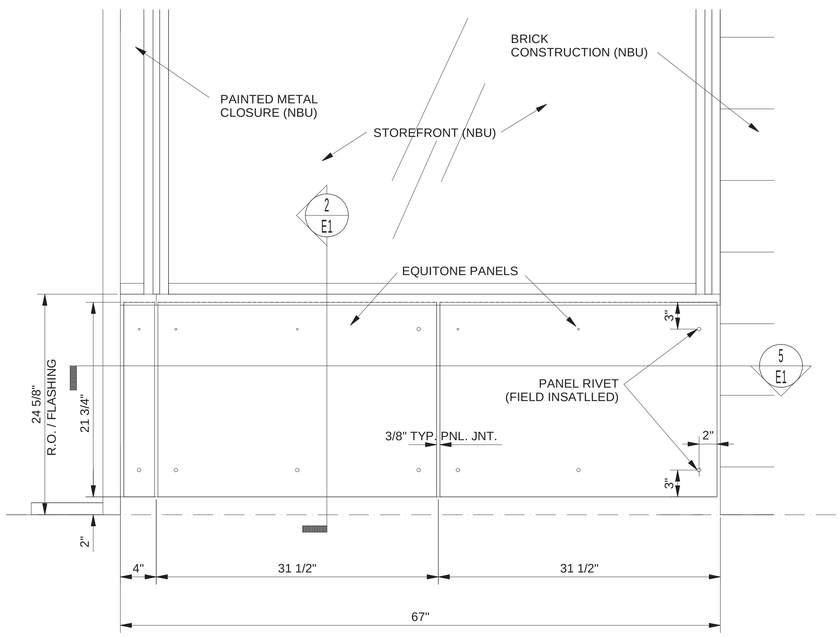

1 E1 ELEVATION AT MOCK-UP
SCALE: 1 1/2" = 1'-0"

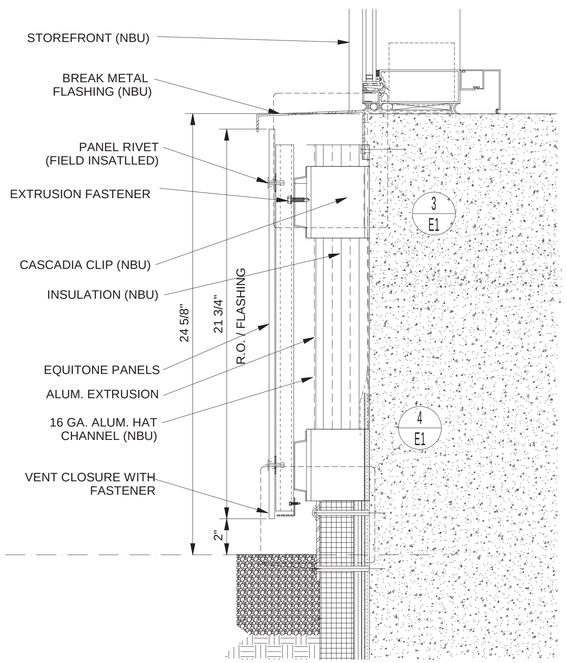

2 E1 SECTION AT MOCK-UP
SCALE: 1 1/2" = 1'-0"

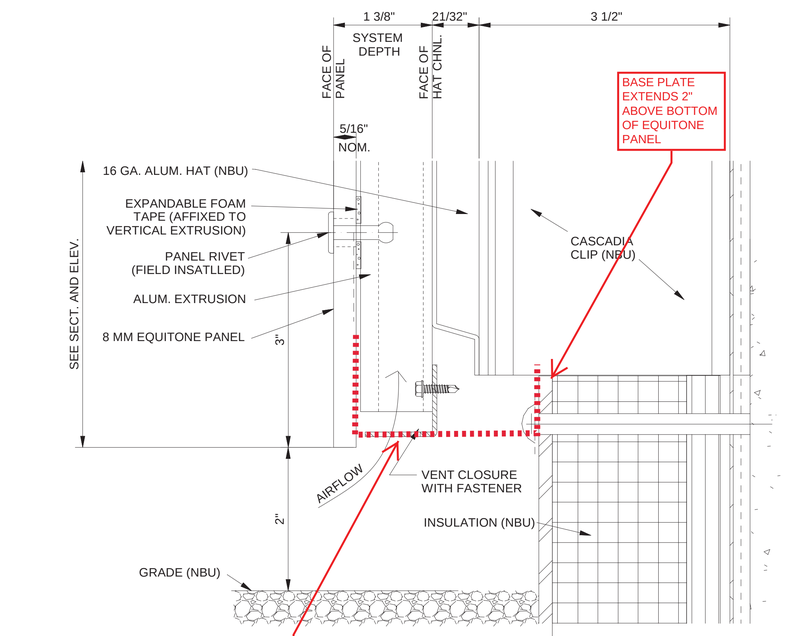

4 E1 DETAIL AT BASE
SCALE: FULL SIZE

A	8-28-2016	KJN
Rev. 1st Sub. Mock-Up Shop Drawings		
-	8-22-2016	KJN
1st Submittal Mock-Up Shop Drawings		
Rev.	Date	By
Description		

Drawn by KJN

CUSTOMER NAME/LOCATION:
Kluenz Heating and Sheet Metal Company
St. Charles, MO 63304

PROJECT NAME/LOCATION:
Webster University Interdisciplinary Science Bldg- EQUITONE
Webster Groves MO

SHEET DESCRIPTION:
MOCK-UP
ELEVATION AND PLANS

UNIVERSE CORPORATION
3333 FOERSTER RD.
ST. LOUIS, MO. 63044-3716
PHONE: (800) 989 6550
FAX: (314) 439 2801
www.universecorp.com

THE DRAWING IS THE PROPERTY OF UNIVERSE CORPORATION AND MUST BE RETURNED UPON REQUEST. ALL RIGHTS RESERVED. NO PART OF THIS DRAWING DEPICTED MAY NOT BE REPRODUCED WITHOUT WRITTEN PERMISSION FROM UNIVERSE CORPORATION.

PROJECT NUMBER:
2016-06-0556

SHEET NUMBER:
E1

CANNONDESIGN

SUBMITTAL IDENTIFICATION SHEET

To be completed by Contractor/CM

WEBSTER UNIVERSITY ISB
PROJECT NAME

8274 BIG BEND BLVD
ADDRESS

NUMBER

WEBSTER UNIVERSITY
OWNER

CANNON DESIGN
ARCHITECT / ENGINEER

Joe Voypick
SUBMITTED BY

074646-005
CONTRACTOR / CM SUBMITTAL NO.

CANNON DESIGN SUBMITTAL NO.

DRAWING / DETAIL REFERENCE

074646
SPECIFICATION SECTION / PARAGRAPH

Kuenz Heating and Sheet
MANUFACTURER / SUPPLIER

ITEM / PRODUCT ID

REQUIRED DATE

PRIORITY

CRITICAL

ITEM BEING SUBMITTED (check only one)

- (●) Shop Drawings
- ( ) Samples (_____ copies)
- ( ) LEED Submittal
- ( ) Certification / Qualifications
- ( ) Record Documents
- ( ) Product Data
- ( ) Coordination Drawing
- ( ) Calculations
- ( ) Schedules
- ( ) O&M Manuals
- ( ) Other _____

ITEM BEING SUBMITTED FOR (check only one)

- (●) Action
- ( ) Information Only
- ( ) Record

REMARKS OR DEVIATIONS

CONTRACTOR / CM CERTIFICATION
(SUBMITTALS NOT CERTIFIED WILL BE RETURNED WITHOUT REVIEW)

PARIC

PARIC CORPORATION
SUBMITTAL STAMP

THIS SHOP DRAWING HAS BEEN REVIEWED BY PARIC CORPORATION

Subcontractor remains responsible for dimensions, quantities, coordination with other trades and compliance with contract documents.

By:
Devin D. Gates

Joe Voypick
REVIEWED BY

8/31/16
DATE

To be completed by Reviewer

07 4646-005
CANNON DESIGN SUBMITTAL NUMBER

9/1/16
RECEIVED DATE

- ( ) A. No Exceptions Taken
  No further review of submittal is required.
- (●) B. Make Corrections Noted
  Incorporate corrections in work; resubmission is not required.
- ( ) C. Revise and Resubmit
  Revise as noted, and resubmit for review.
- ( ) D. Rejected
  Submittal is not in compliance with Contract Documents; provide new submittal.
- ( ) E. For Record / Information Only
  Submittal was reviewed for Record / Information purposes only.
- ( ) F. Not Required for Review
  Submittal is not required by Contract Documents and has not been reviewed.

Review is for conformance with the design concept of this project and for general compliance with contract documents. Contractor is responsible for quantities, dimensions and compliance with contract documents and for information that pertains to fabrication processes, construction techniques and coordination of this work with all trades which will be affected thereby. This review is null and void if submittal deviates from contract documents and does not indicate or note deviations.

A/E COMMENTS

( ) See attached sheet(s) for additional comments

See comments below

Kathy Williams
REVIEWED BY

9/14/16
DATE

77 Westport Plaza
Suite 250
St. Louis, MO 63146

TRANSMITTAL

No. 15051-0205

Paric Corporation

PROJECT: 15051-Webster University Interdisciplinary Science Building

DATE: 08/31/2016

TO: Cannon Design
1100 Clark Ave
St Louis MO 63102

RE: Fiber Cement Siding Shop Drawings

ATTN: Kelvin Patel

JOB: 15051

WE ARE SENDING:	SUBMITTED FOR:	ACTION TAKEN:
☑ Shop Drawings	☑ Approval	☐ Approved as Submitted
☐ Letter	☐ Your Use	☐ Approved as Noted
☐ Prints	☐ As Requested	☐ Returned After Loan
☐ Change Order	☐ Review and Comment	☐ Resubmit
☐ Plans		☐ Submit
☐ Samples	**SENT VIA:**	☐ Returned
☐ Specifications	☐ Attached	☐ Returned for Corrections
☐ Other:	☐ Separate Cover Via:	☐ Due Date:

Item	*Package*	*Code*	*Rev.*	*Copies*	*Date*	*Description*	*Status*
Submittal		074646-005	1		08/31/2016	Fiber Cement Siding Shop Drawings	Submitted

NOTES:

CC:

Signed: _____

Devin Gates