


Custom Coping Detail

Arch. Ref:

INSTALL 072726 - SELF-ADHERED FLEXIBLE FLASHING - PER ROOF MEMBRANE MANUFACTURER TO TOP OF MASONRY AND EPDM ROOF MEMBRANE. INSTALL BACKER ROD TO SUPPORT FLEXIBLE FLASHING

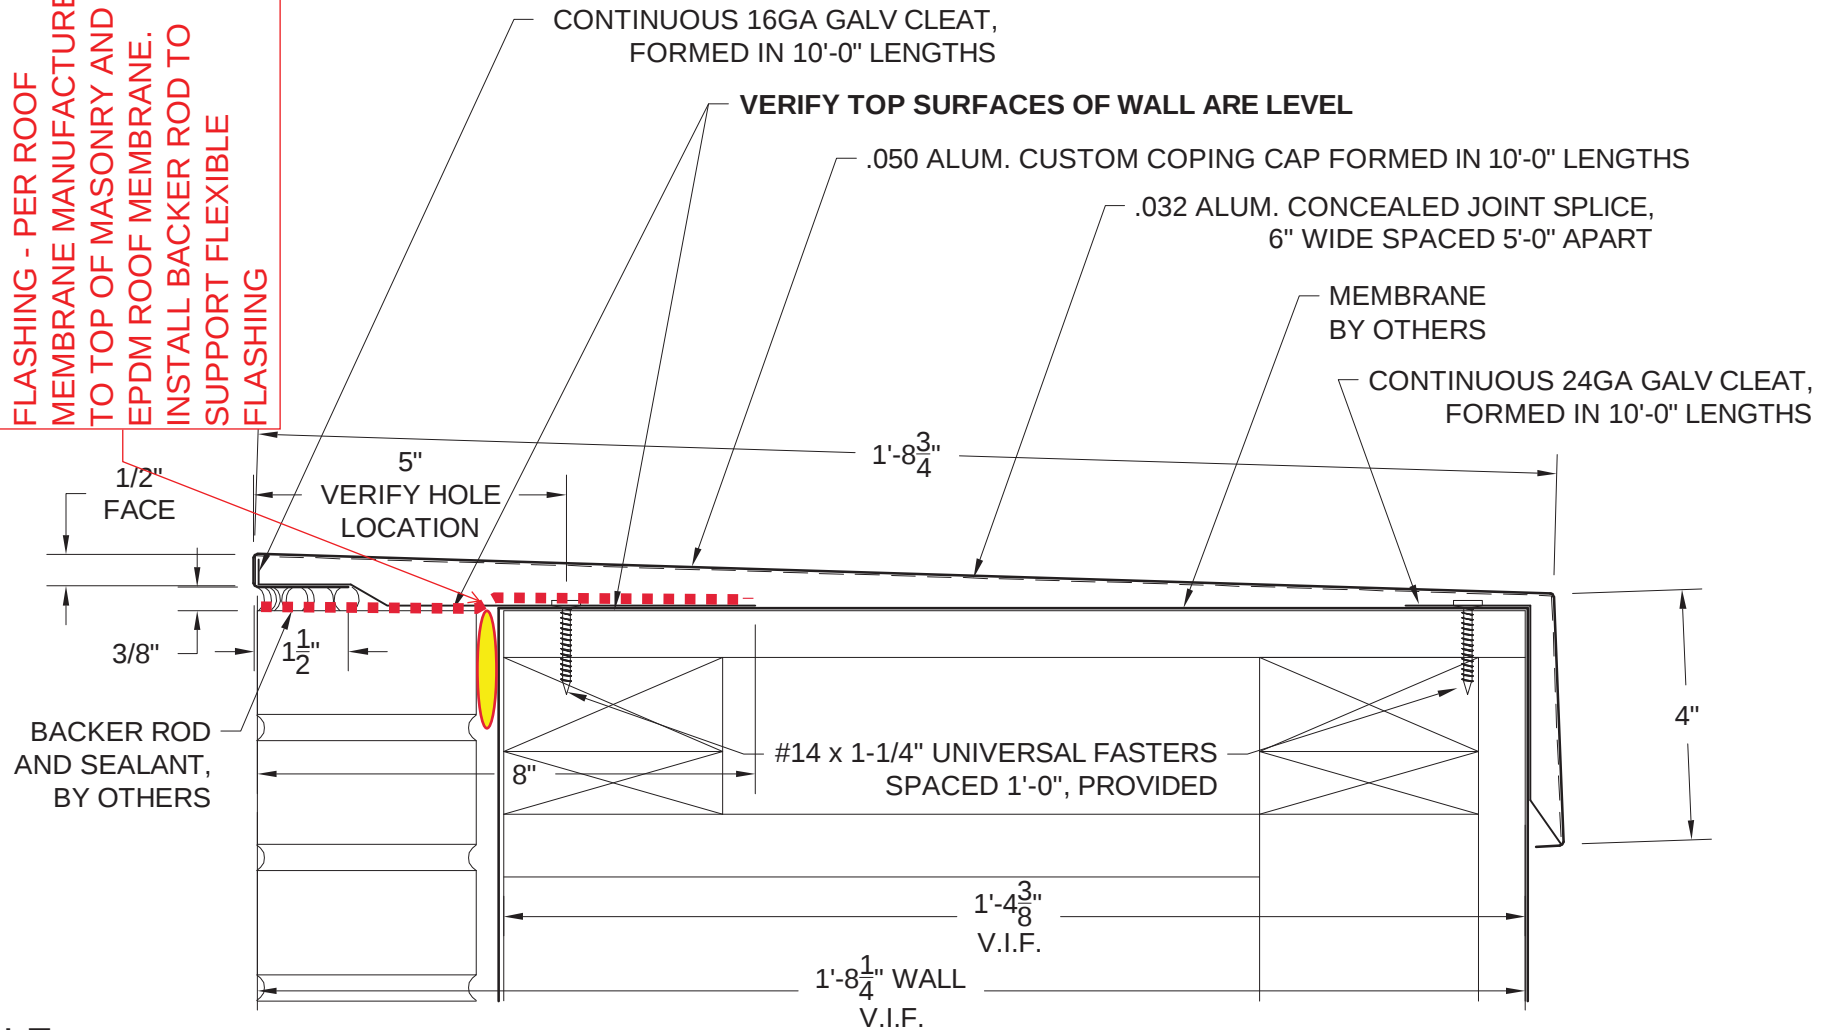

SCALE:

Job Name: WEBSTER SCIENCE	Job #: 27297	<u>TRANSMITTAL</u> ☐ Request for Quotation ☐ Submit as Quotation ☐ Submit for Approval ☐ Request for Information ☐ Confirming Telcon ☐ For Your Files	<u>CUSTOMER APPROVAL</u> ☐ Approved for Fabrication ☐ Approved with Changes ☐ Disapproved, Resubmit	
Location:	Date: 4/3/17			
Customer: VOGEL SHEET METAL & HEATING	By: SJ			
Representative: EIGEL ARCHITECTURAL PRODUCT	Sheet			
Architect:	1 of 1			
			Authorized Customer Signature TitleDate	

SUBMITTAL IDENTIFICATION SHEET

To be completed by Contractor/CM

WEBSTER UNIVERSITY ISB	
PROJECT NAME	
8274 BIG BEND BLVD	
ADDRESS	
NUMBER	
WEBSTER UNIVERSITY	
OWNER	
CANNON DESIGN	
ARCHITECT / ENGINEER	
Joe Voypick	
SUBMITTED BY	
077100-012	
CONTRACTOR / CM SUBMITTAL NO.	CANNON DESIGN SUBMITTAL NO.
	077100
DRAWING / DETAIL REFERENCE	SPECIFICATION SECTION / PARAGRAPH
MANUFACTURER / SUPPLIER	ITEM / PRODUCT ID
REQUIRED DATE	PRIORITY
	CRITICAL

ITEM BEING SUBMITTED (check only one)

- | | | |
|---|--|--|
| ☐ Shop Drawings | ☐ Certification / Qualifications | ☐ Coordination Drawing |
| ☐ Samples (____ copies) | ☐ Record Documents | ☐ Calculations |
| ☐ LEED Submittal | ☒ Product Data | ☐ Schedules |
| ☐ Other _____ | | ☐ O&M Manuals |

ITEM BEING SUBMITTED FOR (check only one)

- ☒ Action ☐ Information Only ☐ Record

REMARKS OR DEVIATIONS

additional cut sheet for 8/A452 not included with original submittal. Paric has confirmed this will be covered in the total warranty

CONTRACTOR / CM CERTIFICATION (SUBMITTALS NOT CERTIFIED WILL BE RETURNED WITHOUT REVIEW)



PARIC CORPORATION
SUBMITTAL STAMP

THIS SHOP DRAWING HAS BEEN REVIEWED BY PARIC CORPORATION

Subcontractor remains responsible for dimensions, quantities, coordination with other trades and compliance with contract documents.

By:

Devin D. Gates

To be completed by Reviewer

07 7100-012
CANNON DESIGN SUBMITTAL NUMBER
4/11/17
RECEIVED DATE

- ☐ A. No Exceptions Taken
No further review of submittal is required.
- ☒ B. Make Corrections Noted
Incorporate corrections in work; resubmission is not required.
- ☐ C. Revise and Resubmit
Revise as noted, and resubmit for review.
- ☐ D. Rejected
Submittal is not in compliance with Contract Documents; provide new submittal.
- ☐ E. For Record / Information Only
Submittal was reviewed for Record / Information purposes only.
- ☐ F. Not Required for Review
Submittal is not required by Contract Documents and has not been reviewed.

Review is for conformance with the design concept of this project and for general compliance with contract documents. Contractor is responsible for quantities, dimensions and compliance with contract documents and for information that pertains to fabrication processes, construction techniques and coordination of this work with all trades which will be affected thereby. This review is null and void if submittal deviates from contract documents and does not indicate or note deviations.

A/E COMMENTS

☐ See attached sheet(s) for additional comments

INSTALL 072726 - SELF-ADHERED FLEXIBLE FLASHING - PER ROOF MEMBRANE MANUFACTURER TO TOP OF MASONRY AND EPDM ROOF MEMBRANE. INSTALL BACKER ROD TO SUPPORT FLEXIBLE FLASHING.

Joe Voypick	4/11/17
REVIEWED BY	DATE

Kathy Williams	04/17/17
REVIEWED BY	DATE



77 Westport Plaza
Suite 250
St. Louis, MO 63146

TRANSMITTAL

No. 15051-0548

Paric Corporation

PROJECT: 15051-Webster University Interdisciplinary Science Building

DATE: 04/11/2017

TO: Cannon Design
1100 Clark Ave
St Louis MO 63102

Fax;
314-241-2203

RE: Additional Coping Product Data for 8.A452

ATTN: Kelvin Patel

JOB: 15051

WE ARE SENDING:	SUBMITTED FOR:	ACTION TAKEN:
☐ Shop Drawings	☒ Approval	☐ Approved as Submitted
☐ Letter	☐ Your Use	☐ Approved as Noted
☐ Prints	☐ As Requested	☐ Returned After Loan
☐ Change Order	☐ Review and Comment	☐ Resubmit
☐ Plans		☐ Submit
☐ Samples	SENT VIA:	☐ Returned
☐ Specifications	☐ Attached	☐ Returned for Corrections
☒ Other: Product Data	☐ Separate Cover Via:	☐ Due Date:

Item	Package	Code	Rev.	Copies	Date	Description	Status
Submittal		077100-012	1		04/11/2017	Additional Coping Product Data for 8.A452	Submitted

NOTES:

CC:

Signed: _____
Devin Gates