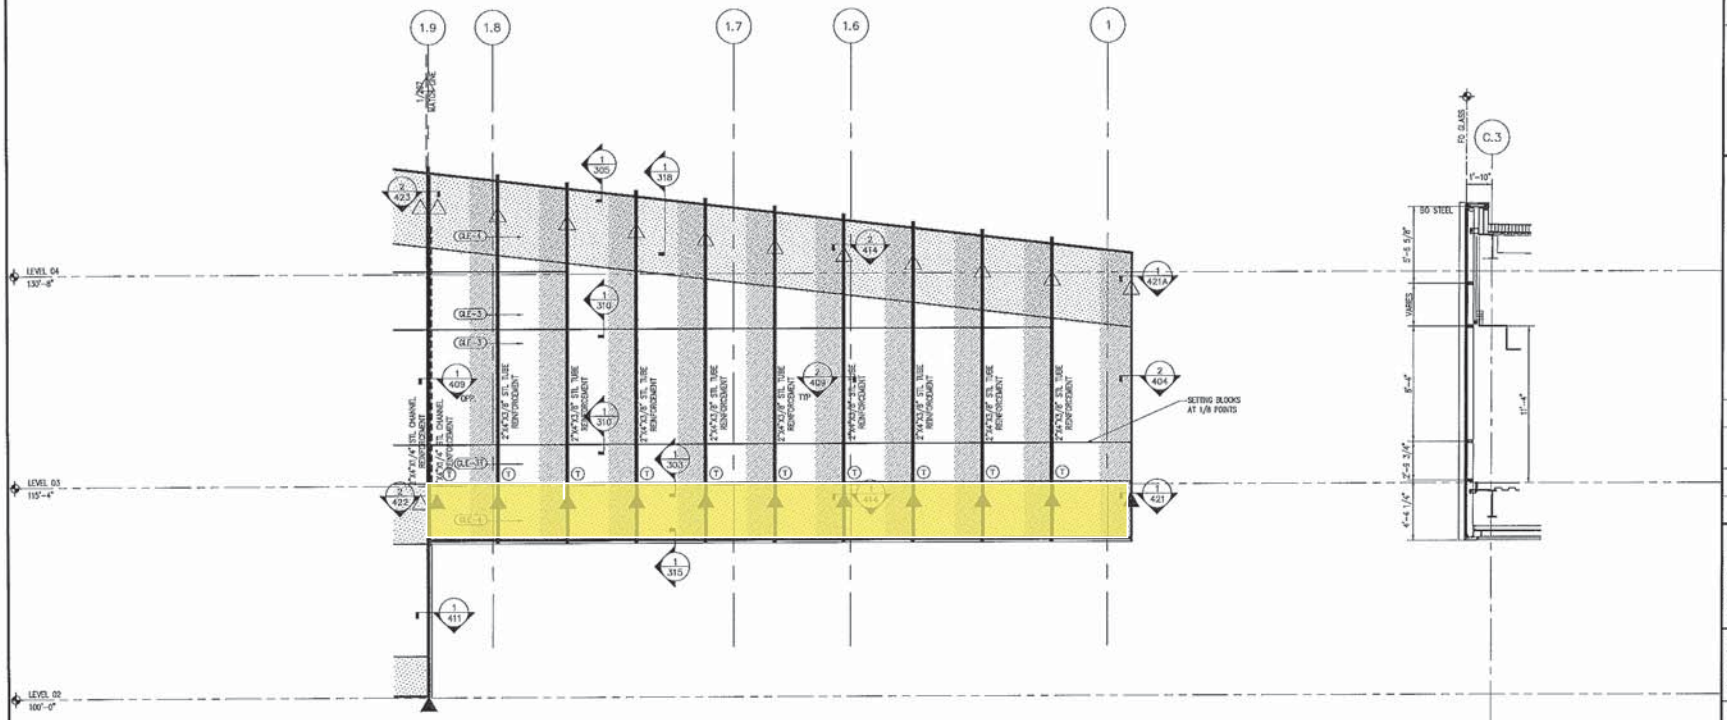

1 NORTH ELEVATION
Scale: 3/4"=1'-0"
EGS-1
COLOR: PEWTER

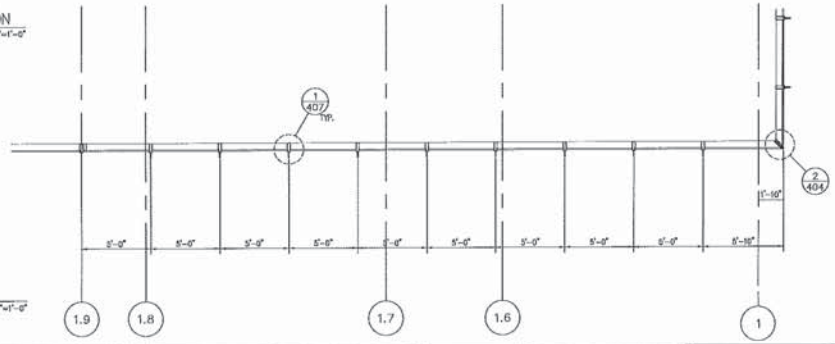

2 PLAN
Scale: 3/4"=1'-0"

3 SECTION
Scale: 3/4"=1'-0"
ARCH REF: 1/A0401

NGG LTD

NGG LTD, INCORPORATED
1850 Craigshire Road Suite 202
St. Louis, Missouri 63146

Tel 314-336-2515
Fax 314-336-2521

STEPHEN P. SIEKE
PE-24362
07/02/2016
PROFESSIONAL ENGINEER

The seals on these plans are not valid with out electronic seal on cover.

Sub. No.	Rev. No.	Date	Prepared By	Submittal/Revision Description
4	3	11/28/16	IY	4TH SUBMISSION
3	2	11/9/16	IY	3RD SUBMISSION
2	1	10/19/16	IY	2ND SUBMISSION
1	-	9/15/16	IY	1ST SUBMISSION

Proprietary Notice

This drawing sheet and contents herein are property of NGG. Use of this drawing, contents or design concepts for purposes other than estimating, drawing preparation and/or manufacturing for NGG shall be cause for legal recourse by NGG.

Project Name
WEBSTER UNIVERSITY
Location
St. Louis, Missouri

Architect
CANNON DESIGN
Location
St. Louis, Missouri

Contractor
PARIC
Location
St. Louis, Missouri

Owner
WEBSTER UNIVERSITY
Location
St. Louis, Missouri

Drawn Date	Scale
08/10/16	AS NOTED

NGG Project No.

Drawing Title
EMBED TITLE SHEET

Drawn By	Sheet No.
IY	208

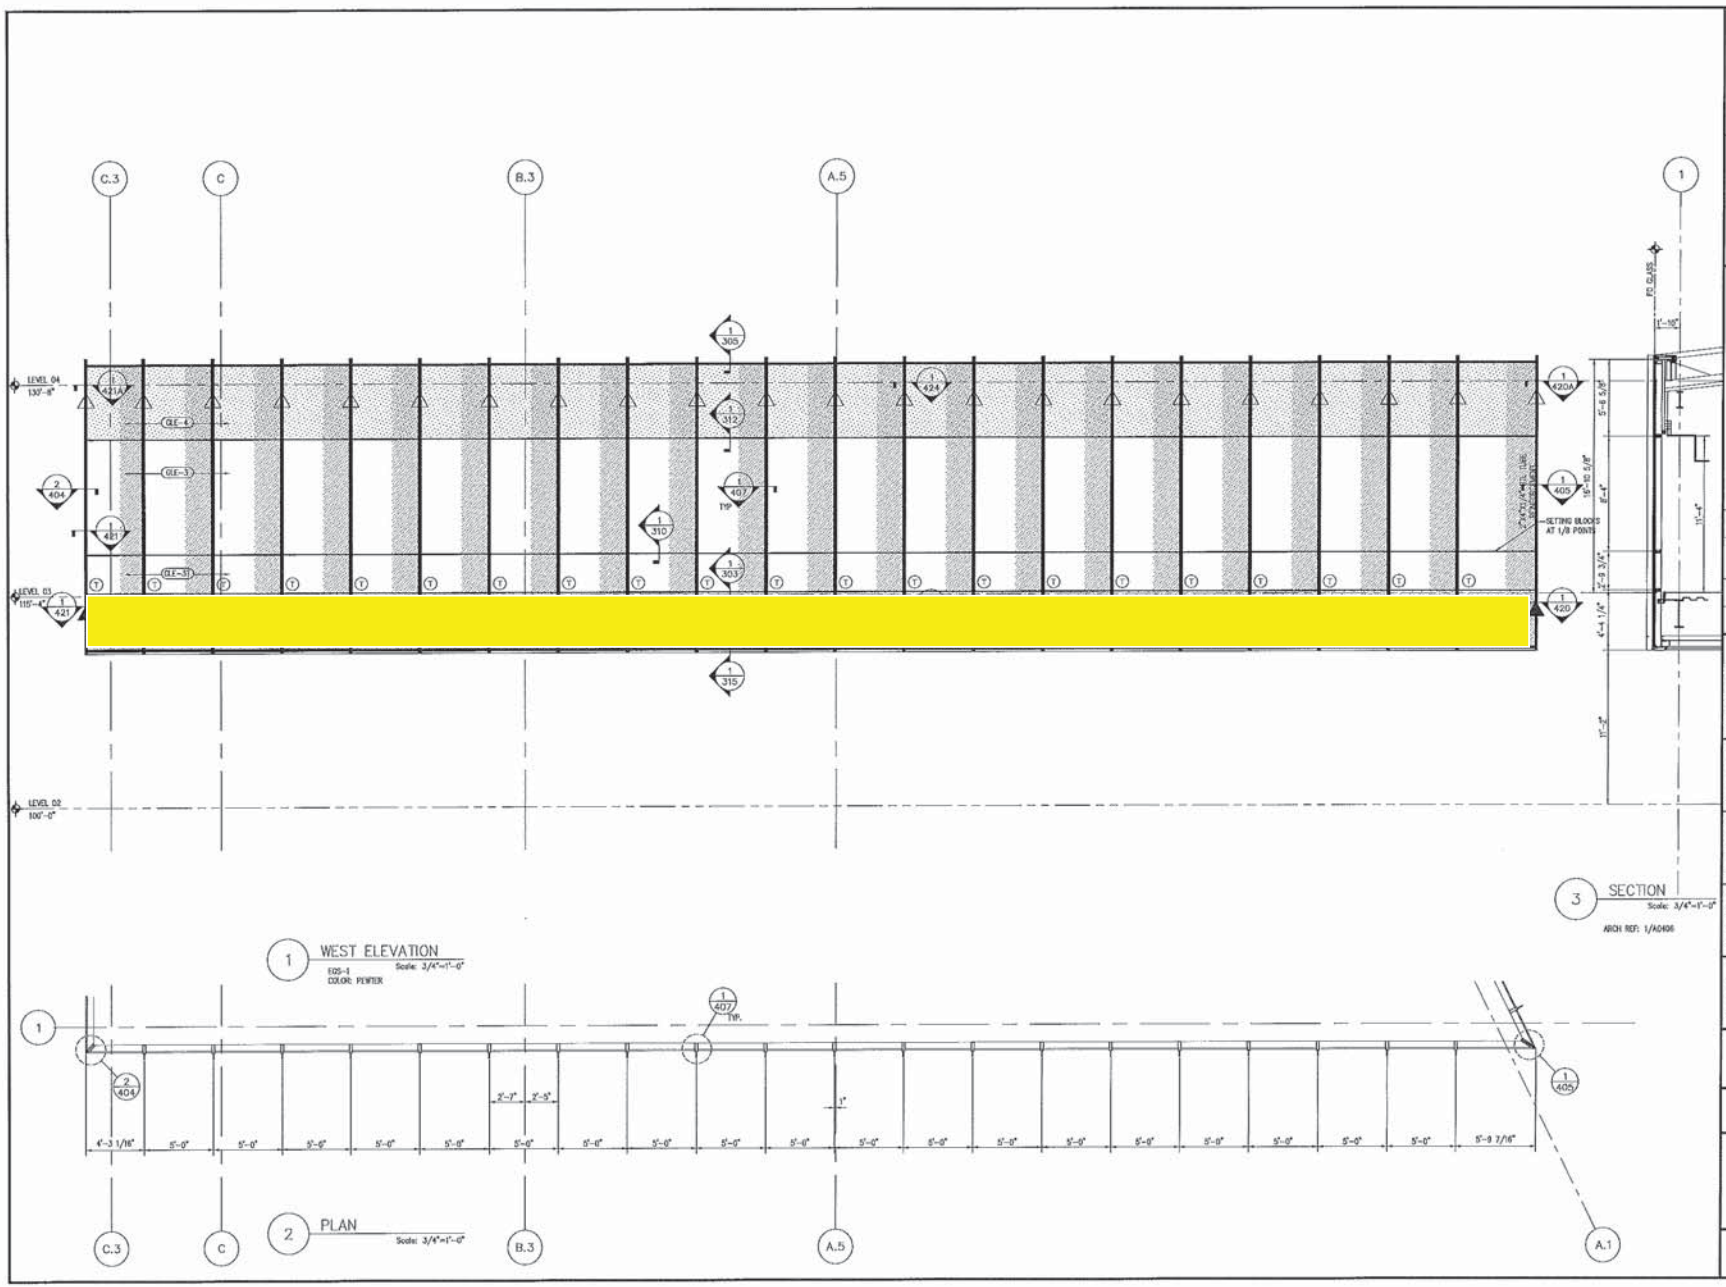

NGG LTD

NGG LTD, INCORPORATED
1600 Craigshire Road Suite 202
St. Louis, Missouri 63146

Tel 314-336-2515
Fax 314-336-2521

STATE OF MISSOURI
STEWART H. NGG
PE-24902
PROFESSIONAL ENGINEER
10/22/2018

The seals on these plans are not valid with out electronic seal on cover.

Sub. No.	Rev. No.	Date	Drawn By	Submittal/Revision Description
4	3	11/26/18	IY	4TH SUBMISSION
3	2	11/9/18	IY	3RD SUBMISSION
2	1	10/19/18	IY	2ND SUBMISSION
1	-	8/16/18	IY	1ST SUBMISSION

Proprietary Notice

This drawing sheet and contents herein are property of NGG. Use of this drawing, contents or design concepts for purposes other than estimating, drawing preparation and/or manufacturing for NGG shall be cause for legal recourse by NGG.

Project Name
WEBSTER UNIVERSITY
Location
St. Louis, Missouri

Architect
CANNON DESIGN
Location
St. Louis, Missouri

Contractor
PARIC
Location
St. Louis, Missouri

Owner
WEBSTER UNIVERSITY
Location
St. Louis, Missouri

Drawn Date	Scale
08/16/18	AS NOTED

NGG Project No.

Drawing Title
EMBED TITLE SHEET

Drawn By	Sheet No.
IY	209

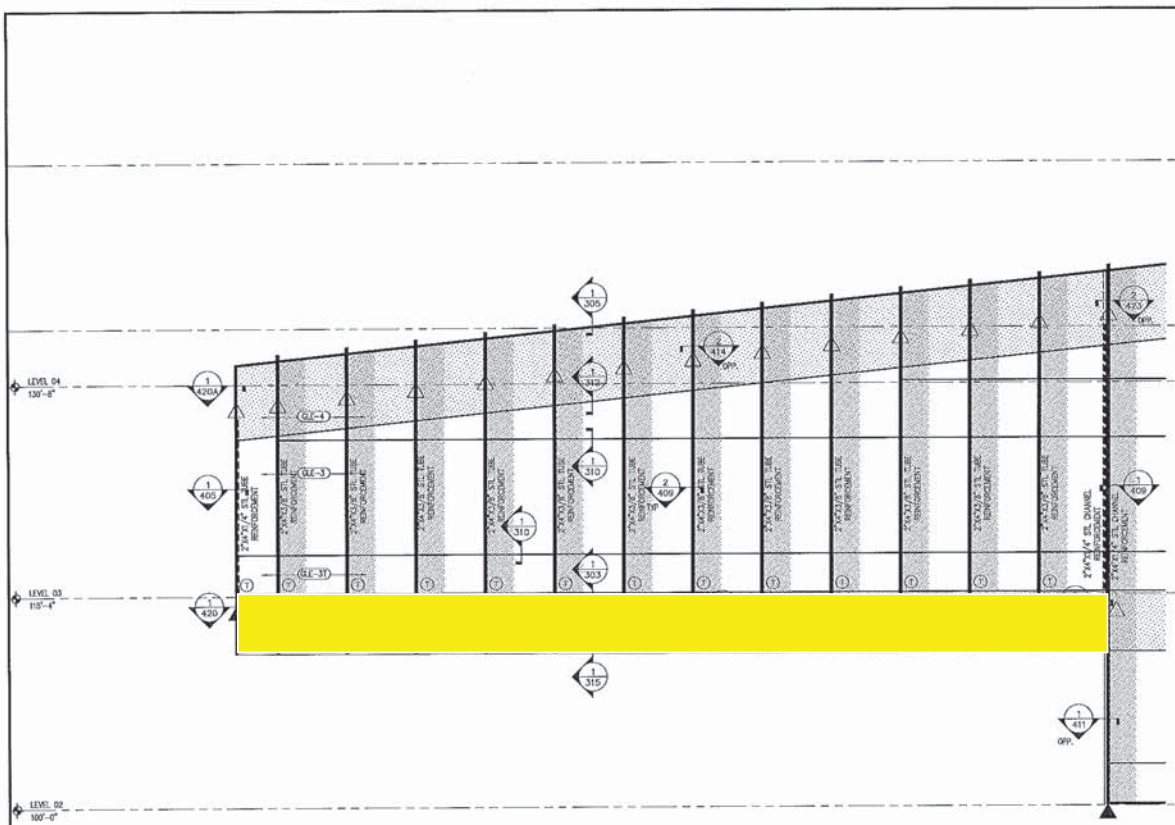

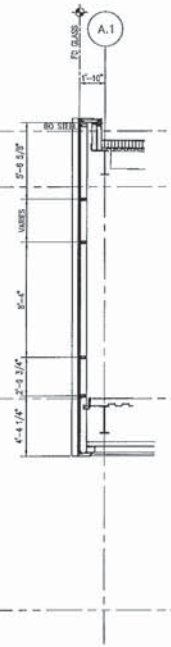

1 SOUTH ELEVATION
Scale: 3/4"=1'-0"
EGS-1
COLOR: PEWTER

3 SECTION
Scale: 3/4"=1'-0"
ARCH REF: 1/A0405

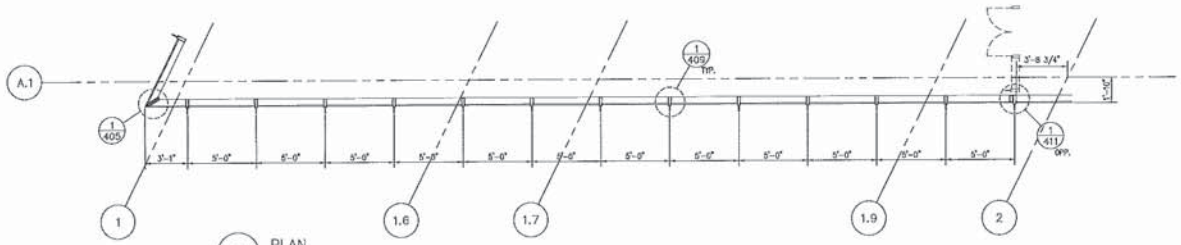

2 PLAN
Scale: 3/4"=1'-0"

NGG LTD

NGG LTD, INCORPORATED
1850 Craigshire Road Suite 202
St. Louis, Missouri 63146

Tel 314-336-2516
Fax 314-336-2521

The seals on these plans are not valid with out electronic seal on cover.

No.	Rev. No.	Date	Drawn By	Submittal/Revision Description
4	6	11/20/15	IY	4TH SUBMISSION
3	5	11/6/15	IY	3RD SUBMISSION
2	4	10/19/15	IY	2ND SUBMISSION
1	-	8/10/15	IY	1ST SUBMISSION

Proprietary Notice

This drawing sheet and contents herein are property of NGG. Use of this drawing, contents or design concepts for purposes other than estimating, drawing preparation and/or manufacturing for NGG shall be causes for legal recourse by NGG.

Project Name
WEBSTER UNIVERSITY
Location
St. Louis, Missouri

Architect
CANNON DESIGN
Location
St. Louis, Missouri

Contractor
PASIC
Location
St. Louis, Missouri

Owner
WEBSTER UNIVERSITY
Location
St. Louis, Missouri

Drawn Date	Scale
08/10/15	AS NOTED

NGG Project No.

Drawing Title
EMBED TITLE SHEET

Drawn By	Sheet No.
IY	210

CANNONDESIGN

SUBMITTAL IDENTIFICATION SHEET

To be completed by Contractor/CM

WEBSTER UNIVERSITY ISB
PROJECT NAME

8274 BIG BEND BLVD
ADDRESS

NUMBER

WEBSTER UNIVERSITY
OWNER

CANNON DESIGN
ARCHITECT / ENGINEER

DEVIN D GATES
SUBMITTED BY

078446-002
CONTRACTOR / CM SUBMITTAL NO.

CANNON DESIGN SUBMITTAL NO.

DRAWING / DETAIL REFERENCE

078446
SPECIFICATION SECTION / PARAGRAPH

MANUFACTURER / SUPPLIER

ITEM / PRODUCT ID

REQUIRED DATE

PRIORITY

CRITICAL

ITEM BEING SUBMITTED (check only one)

- ○ Shop Drawings
- ○ Samples (_____ copies)
- ○ LEED Submittal
- ○ Certification / Qualifications
- ○ Record Documents
- ◉ Product Data
- ○ Coordination Drawing
- ○ Calculations
- ○ Schedules
- ○ O&M Manuals
- ○ Other _____

ITEM BEING SUBMITTED FOR (check only one)

◉ Action ○ Information Only ○ Record

REMARKS OR DEVIATIONS

For use at static locations only. A separate submittal will be forwarded for dynamic locations. See attached plan for locations.

CONTRACTOR / CM CERTIFICATION
(SUBMITTALS NOT CERTIFIED WILL BE RETURNED WITHOUT REVIEW)

PARIC

PARIC CORPORATION
SUBMITTAL STAMP

THIS SHOP DRAWING HAS BEEN REVIEWED BY PARIC CORPORATION

Subcontractor remains responsible for dimensions, quantities, coordination with other trades and compliance with contract documents.

By:
Devin D. Gates

DEVIN D GATES
REVIEWED BY

1/26/17
DATE

To be completed by Reviewer

07 8446-002 REV004
CANNON DESIGN SUBMITTAL NUMBER

1/27/17
RECEIVED DATE

- ○ A. No Exceptions Taken
  No further review of submittal is required.
- ◉ B. Make Corrections Noted
  Incorporate corrections in work; resubmission is not required.
- ○ C. Revise and Resubmit
  Revise as noted, and resubmit for review.
- ○ D. Rejected
  Submittal is not in compliance with Contract Documents; provide new submittal.
- ○ E. For Record / Information Only
  Submittal was reviewed for Record / Information purposes only.
- ○ F. Not Required for Review
  Submittal is not required by Contract Documents and has not been reviewed.

Review is for conformance with the design concept of this project and for general compliance with contract documents. Contractor is responsible for quantities, dimensions and compliance with contract documents and for information that pertains to fabrication processes, construction techniques and coordination of this work with all trades which will be affected thereby. This review is null and void if submittal deviates from contract documents and does not indicate or note deviations.

A/E COMMENTS ○ See attached sheet(s) for additional comments

1) Provide separate submittal for fire-resistive joint assembly or engineering judgment for dynamic condition.

2) Provide Identification post-installation per specification 078446-002, 3.4, A.

Kelvin Patel
Digitally signed by Kelvin Patel
DN: C=US, E=kpatel@cannondesign.com, O=Cannon Design, OU=Architect, CN=Kelvin Patel
Date: 2017.02.03 14:27:27-06'00'
REVIEWED BY

02/03/17
DATE