079500-1.2.A for
F-1 per 3.5.C

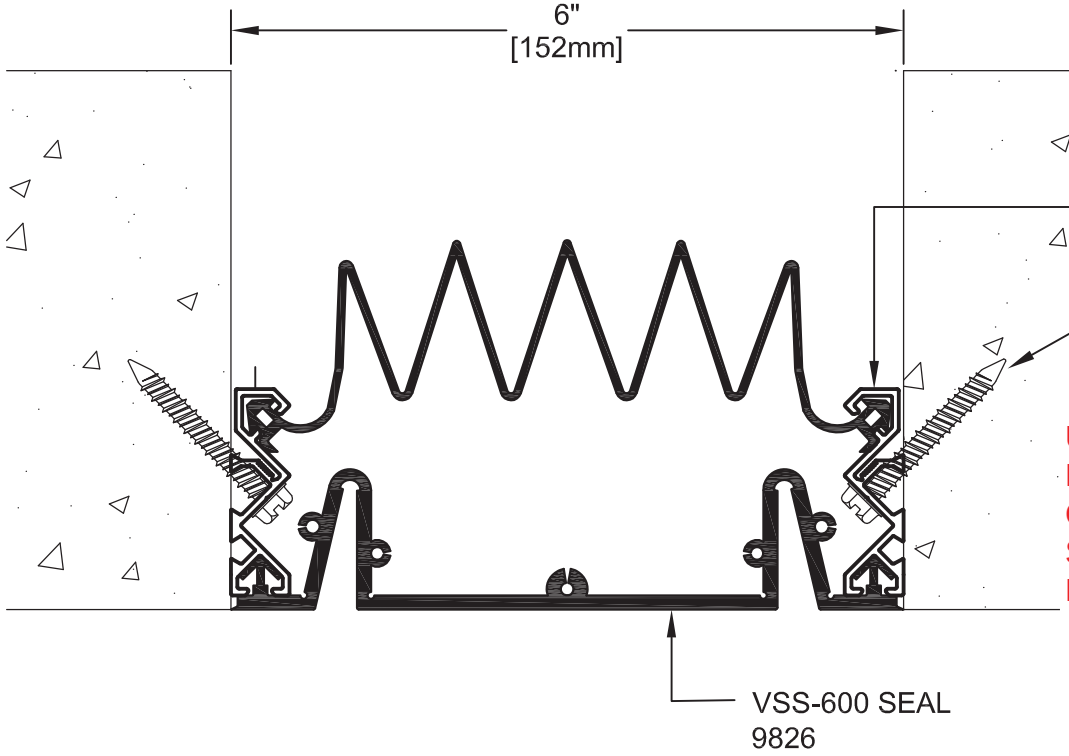

US APPROPRIATE FASTENERS FOR INSTALATION IS ON GLASS MAT GYP BOARD SHEATHING & METAL STUDS - MODEL: VSS-600-E

Model	Nominal "JT"	Joint Opening "JT"				Total Movement	Mat. Code
		Seismic Min.	Thermal Min.	Thermal Max.	Seismic Max.		
VSS-600-E_~~CONC~~	6" (152)	1.75" (44)	4.5" (102)	9" (229)	12" (3050	10.25" (260)	VS1005

( ) IN MOVEMENT TABLE DENOTES mm IN METRIC.

NOTE THAT EXTERIOR SEAL WILL DISENGAGE IF MOVEMENT EXCEEDS THERMAL MAXIMUM BUT WATER-TIGHTNESS WILL BE MAINTAINED BY INTERIOR SEAL UP TO SEISMIC MAXIMUM

ARCHITECT/CONTRACTOR NOTE:
ALL SUBASSEMBLY COMPONENTS TO BE PROVIDED IN 10'-0" OR 20'-0" STOCK LENGTHS UNLESS OTHERWISE NOTED. THE SPECIFIC SYSTEMS DICTATE THE LENGTHS PROVIDED.

Approved by:_____ Date:_____

SEAL NOTE: SPECIFY SEAL COLOR

STANDARD COLORS:
☐ CARBON (BLACK) ☐ PRAIRIE (BEIGE)
☐ FOG (GRAY) ☐ LUNAR (WHITE)

*CUSTOM COLOR AVAILABLE IN MINIMUM QUANTITIES 100 LF. CONTACT MM FOR PRICING & AVAILABILITY.

Representative:	Customer:	Project:	Location:	Project Number:

M M
MM SYSTEMS
50 MM WAY
PENDERGRASS, GA. 30567
PHONE: 706-824-7500
800-241-3460
FAX: 706-824-7501
www.mmsystemscorp.com
For Spec-Data, Installation Guides, or movement requirements, contact MMSC

RIGHTS OF DESIGN
All rights of design, detail, engineering and/or invention contained herein are the property of MM Systems Corporation and hereby reserved and are not to be reproduced or provided to any other party. MM Systems Corporation reserves the right to amend or withdraw any information contained herein without notice and will not be liable for any inaccuracy or ambiguity of said information.

Model: VSS-600-E_~~CONC~~

Drawn by:	Scale:	Drawing Number:
LMP	NTS	VS1005
SHT. . OF .	Issue Date: 10-20-14	

CANNONDESIGN

SUBMITTAL IDENTIFICATION SHEET

To be completed by Contractor/CM

WEBSTER UNIVERSITY ISB
PROJECT NAME

8274 BIG BEND BLVD
ADDRESS

NUMBER

WEBSTER UNIVERSITY
OWNER

CANNON DESIGN
ARCHITECT / ENGINEER

DEVIN D GATES
SUBMITTED BY

079500-005
CONTRACTOR / CM SUBMITTAL NO.

CANNON DESIGN SUBMITTAL NO.

DRAWING / DETAIL REFERENCE

079500
SPECIFICATION SECTION / PARAGRAPH

MANUFACTURER / SUPPLIER

ITEM / PRODUCT ID

REQUIRED DATE

PRIORITY

CRITICAL

ITEM BEING SUBMITTED (check only one)

- ○ Shop Drawings
- ◉ Samples (_____ copies)
- ○ LEED Submittal
- ○ Certification / Qualifications
- ○ Record Documents
- ○ Product Data
- ○ Coordination Drawing
- ○ Calculations
- ○ Schedules
- ○ O&M Manuals
- ○ Other _____

ITEM BEING SUBMITTED FOR (check only one)

◉ Action ○ Information Only ○ Record

REMARKS OR DEVIATIONS

CONTRACTOR / CM CERTIFICATION
(SUBMITTALS NOT CERTIFIED WILL BE RETURNED WITHOUT REVIEW)

PARIC

PARIC CORPORATION
SUBMITTAL STAMP

THIS SHOP DRAWING HAS BEEN REVIEWED BY PARIC CORPORATION

Subcontractor remains responsible for dimensions, quantities, coordination with other trades and compliance with contract documents.

By:
Devin D. Gates

DEVIN D GATES
REVIEWED BY

02/01/17
DATE

To be completed by Reviewer

07 9500-005
CANNON DESIGN SUBMITTAL NUMBER

2/1/17
RECEIVED DATE

- ○ A. No Exceptions Taken
  No further review of submittal is required.
- ◉ B. Make Corrections Noted
  Incorporate corrections in work; resubmission is not required.
- ○ C. Revise and Resubmit
  Revise as noted, and resubmit for review.
- ○ D. Rejected
  Submittal is not in compliance with Contract Documents; provide new submittal.
- ○ E. For Record / Information Only
  Submittal was reviewed for Record / Information purposes only.
- ○ F. Not Required for Review
  Submittal is not required by Contract Documents and has not been reviewed.

Review is for conformance with the design concept of this project and for general compliance with contract documents. Contractor is responsible for quantities, dimensions and compliance with contract documents and for information that pertains to fabrication processes, construction techniques and coordination of this work with all trades which will be affected thereby. This review is null and void if submittal deviates from contract documents and does not indicate or note deviations.

A/E COMMENTS ○ See attached sheet(s) for additional comments

Cannon to provide color selections

Kathy Williams
REVIEWED BY

2/2/2017
DATE