


092900-2.6.F

Control Joints to be installed per
092900-3.5.B and ASTM C 840

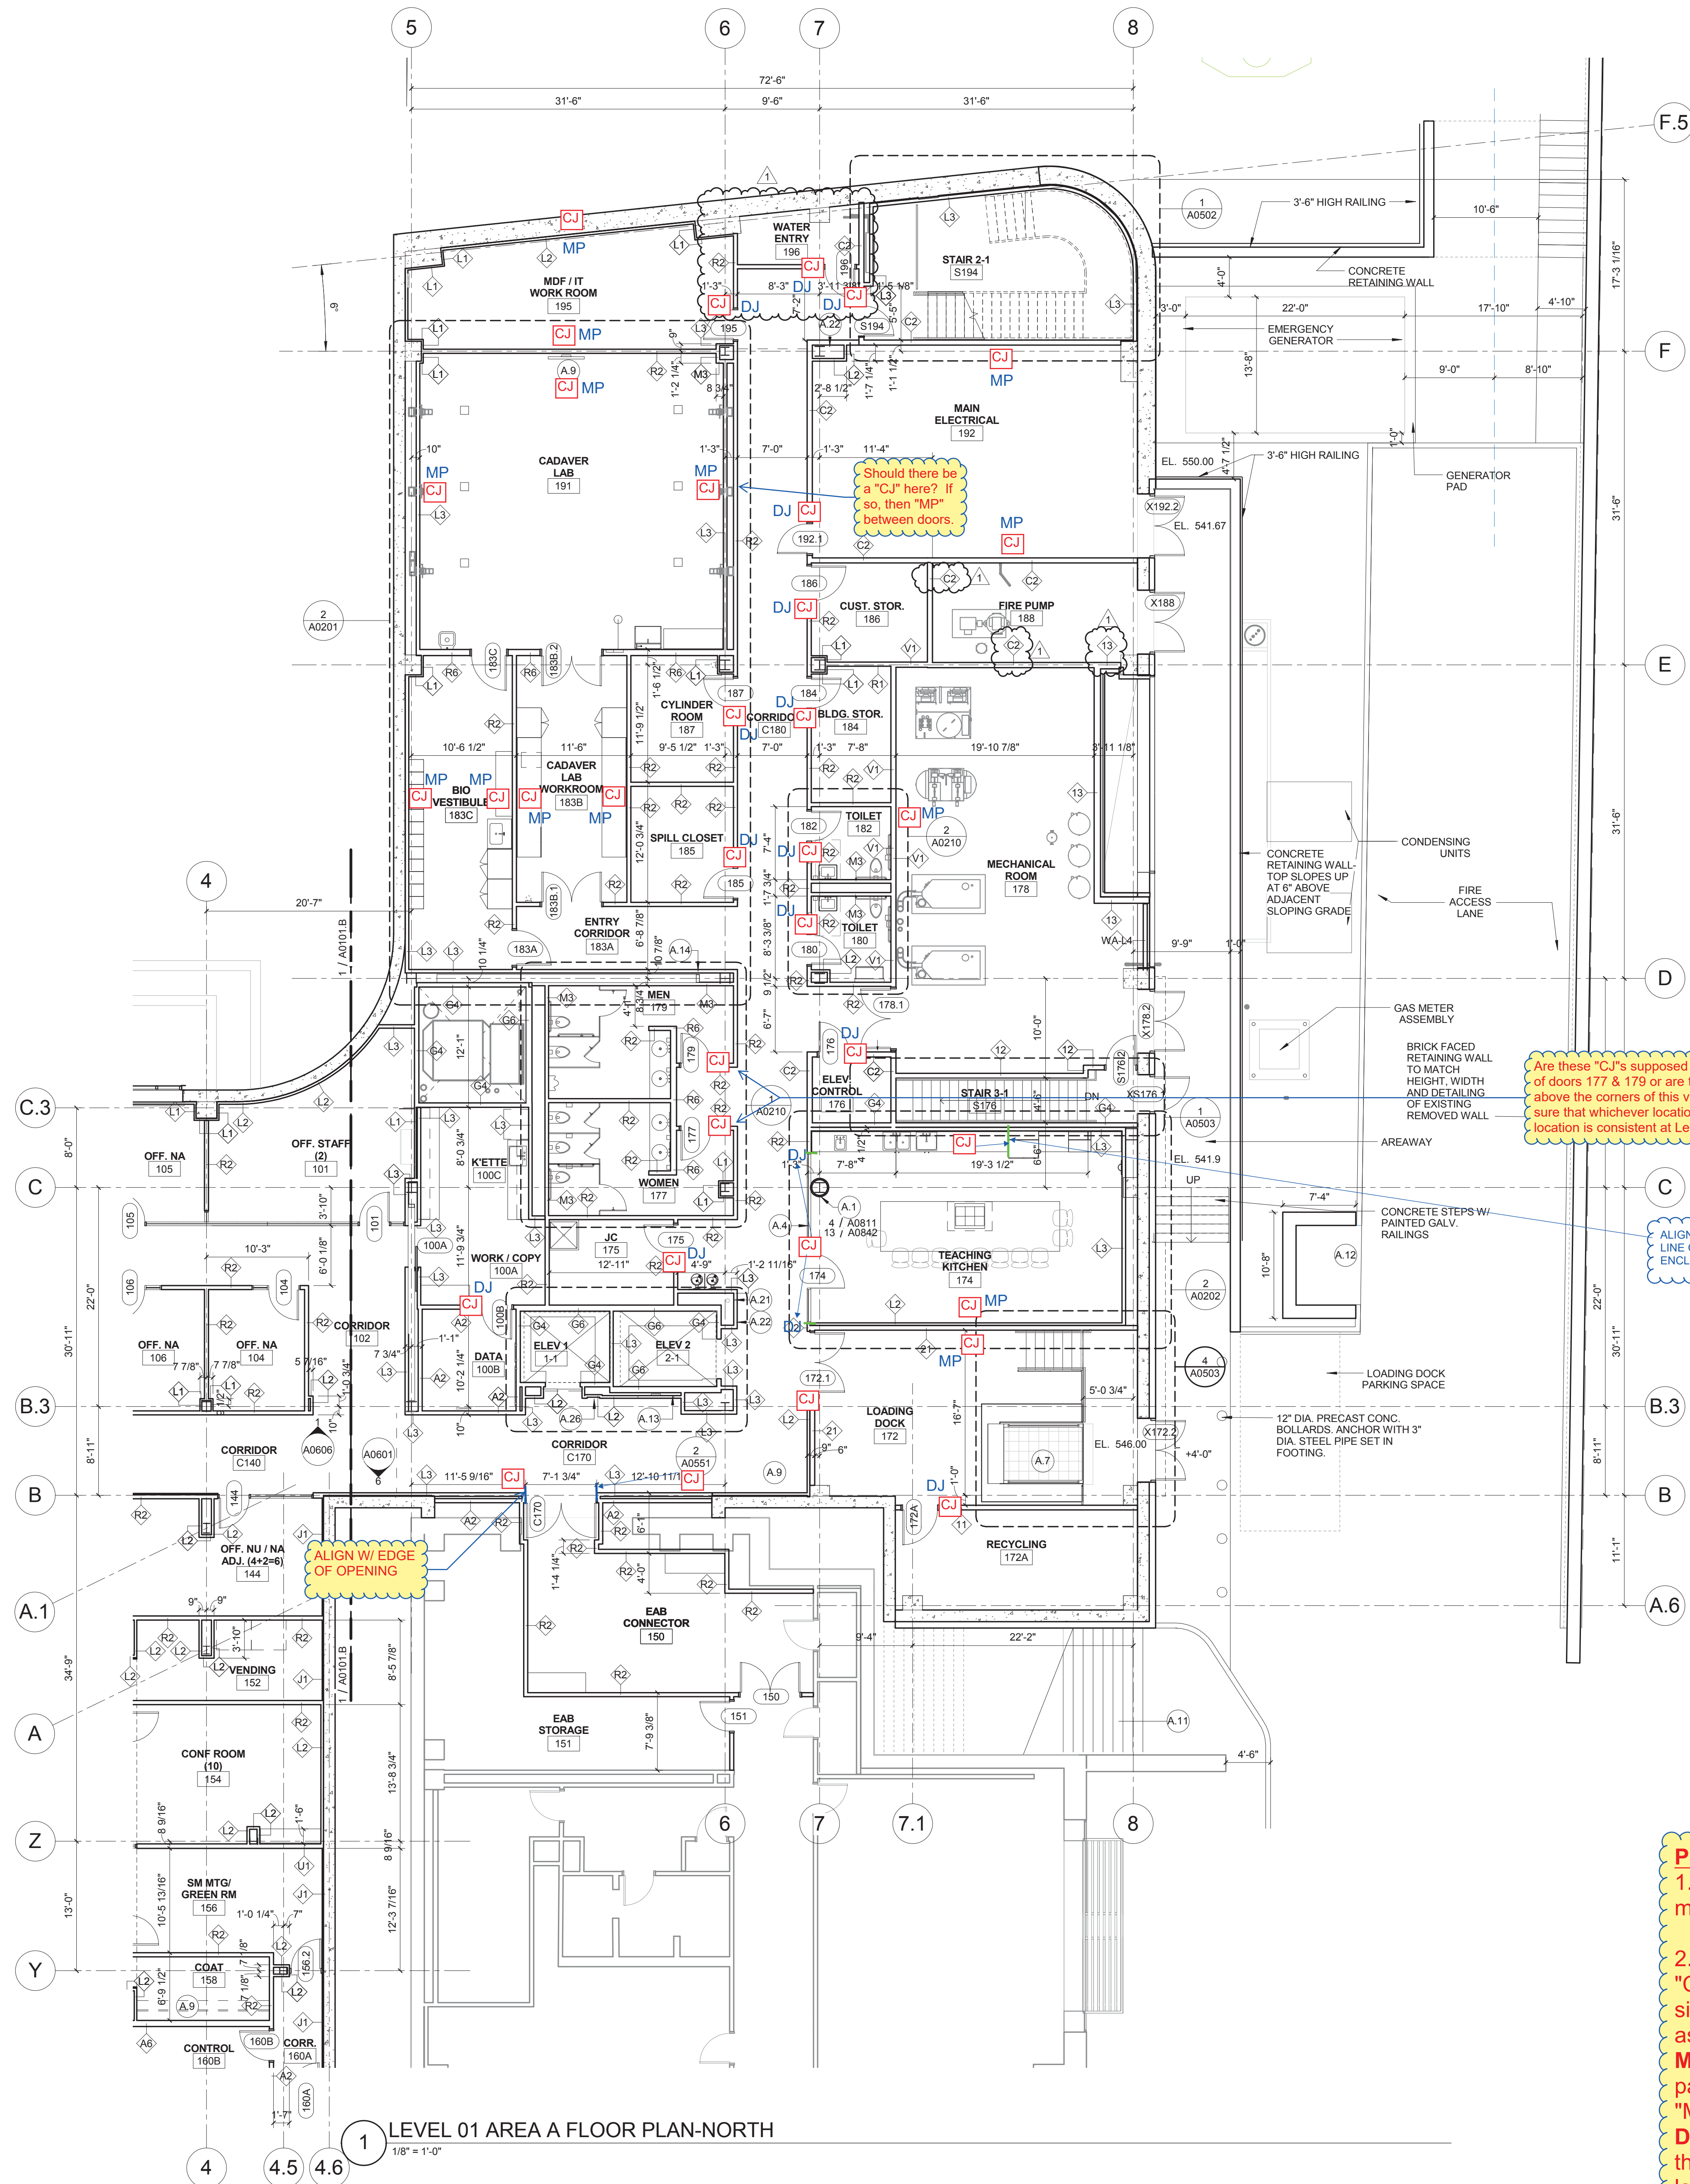

LEVEL 01 AREA A FLOOR PLAN-NORTH

1/8" = 1'-0"

KEYED NOTE LEGEND - PLAN

- A.1 092700 GRC COLUMN COVER TO 3" ABOVE CEILING - 20" DIA. TYP. SEE DETAIL A10811 AND A10842.
- A.2 081216 INTERIOR GLAZING SYSTEM: IGS-1. REFER TO TYPICAL INT. ELEVATIONS 1 AND 2 ON SHEET A0603
- A.3 081216 INTERIOR GLAZING SYSTEM IGS-2. SEE TYPICAL ELEVATION 5 AND 6 A0603
- A.4 081216 INTERIOR GLAZING SYSTEM: IGS-3. REFER TO INTERIOR ELEVATIONS
- A.5 088813 FIRE RATED GLAZING- 120 MIN. FIRE RATED GLAZING 10'-0" HIGH. BASIS OF DESIGN: VETROTECH CONTRAFRAMM STRUTTURA - WITH BUTT JOINTS AND PERIMETER FRAMING
- A.6 088813 FIRE RATED GLAZING AND FRAME- 120 MIN. FIRE RATED GLAZING 1'-8" HIGH X 5'-0" WIDE. BASIS OF DESIGN: VETROTECH CONTRAFRAMM WITH PERIMETER FRAMING
- A.7 111519 LOADING DOCK LIFT - STATIONARY - 6W X 8' DEEPW/ 14' PIT
- A.8 ALTERNATING TREAD STAIRWAY UP TO ROOF HATCH
- A.9 UNDERSLAB DRAINAGE SYSTEM PER OWNER'S GEOTECHNICAL CONSULTANT RECOMMENDATION TYPICAL ALL SLAB ON GRADE AREAS
- A.11 NEW CONCRETE STEPS TO MATCH EXISTING REMOVED FOR CONSTRUCTION
- A.12 553006 BRICK FACED CONCRETE DUMPSTER ENCLOSURE TOP OF WALL
- A.13 LCD SIGNAGE SCREEN IN WALL RECESS (OFCI)
- A.14 MARKERBOARD SURFACE
- A.15 WOOD SCREEN W/ SOLID LUMBER
- A.17 VIDEO WALL - 24 55" SCREENS
- A.18 LCD SCREEN LOCATION (OFCI)
- A.19 AIR PLENUM - INSULATED PLENUM CONSTRUCTION BY DIVISION 23
- A.20 12200 CURTAIN LOCATION
- A.21 104313 AED CABINET LOCATION
- A.22 10 4413 FEC WITH FIRE EXTINGUISHER
- A.23 08 4423 SULL SASH LOCATION: PROVIDE 1/4" TEMPERED CLEAR GLAZING AT INTERIOR FACE OF CURTAIN WALL MULLIONS FOR ACOUSTICAL SEPARATION.
- A.24 6" X 8" FORMED CONCRETE TRENCH IN FLOOR W/ METAL PLATE COVER. PROVIDE BLIND SIDE WATERPROOFING
- A.25 BUILT IN SALT WATER FISH TANK LOCATION. SIZE APPROX. 7'-6" X 2'-4" X 2'-6" HIGH. LOW IRON GLASS VIEW WINDOW ON CORRIDOR SIDE. SLIDING DOOR ON LAB SIDE. FISH TANK EQUIPMENT BELOW TANK W/ CABINET DOOR ACCESS ON LAB SIDE. FINISHED INTERIOR FACE OF WALLS AND CEILING INSIDE CAVITY W/ WATER RESISTANT GYP BOARD AND EPOXY PAINT.
- A.26 LCD SIGNAGE SCREEN IN WALL RECESS (OFCI)
- A.27 CONSTRUCT 2 HOUR RATED SEPARATION BETWEEN BOTTOM OF STAIR AND UTILITY PIPING CROSSING THIS AREA. USE HORIZ. GYP BD. ENCLOSURE ON SHEET A1002

Partition Control Joint Notes:

1. All partition acoustical (stc) ratings and/or fire ratings must be maintained if a control joint is installed in them.

2. It is assumed that where ever there is a box with a "CJ" in it, that there is to be a control joint only at one side of the partition that this "CJ" box is next to. If this assumption is correct, then:

MP = Locate this control joint at the mid-point of this partition on the side of the partition that this abbreviation "MP" is located.

DJ = Locate this control joint above the door jamb on the side of the partition that this abbreviation "DJ" is located.

1100 Clark Avenue
St. Louis, Missouri 63102
T: 314.241.6250
F: 314.241.2570

William Tao & Associates, Inc.
MERFP Engineer
7955 Manchester Road, Suite 125
St. Louis, MO 63143
314-884-7600

David Mason & Associates, Inc.
Structural & Civil Engineer
800 South Vandeventer Avenue
St. Louis, MO 63110
314.534.1053

Faith Group
Technology
3101 S. Hanley Rd, Suite 100
St. Louis, MO 63143
314.591.2229

Kuhmann Leavitt, Inc.
Environmental Graphics & Signage
7400 Pershing Ave
St. Louis, MO 63130
314.725.6616

KWA Architects
Architecture
9721 Litzinger Road
St. Louis, MO 63124
314.962.2560

Spellman Brady & Company
Interior Designer
8251 Maryland Avenue, Suite 300
St. Louis, MO 63105
314.862.0070

SWT Design
Landscape Architect
7722 Big Bend Blvd
St. Louis, MO 63119
314.644.5700


Webb Engineering Services, Inc.
Planning & Fire Protection
1400 S. 3rd Street, Suite 201
St. Louis, MO 63104
314.558.0600

CONFORMED SET

01 JUL 2016

1 ADDENDUM 3-1 05 APR 2016
ISSUED FOR CONSTRUCTION (BP3) 15 MAR 2016

No. Description Date

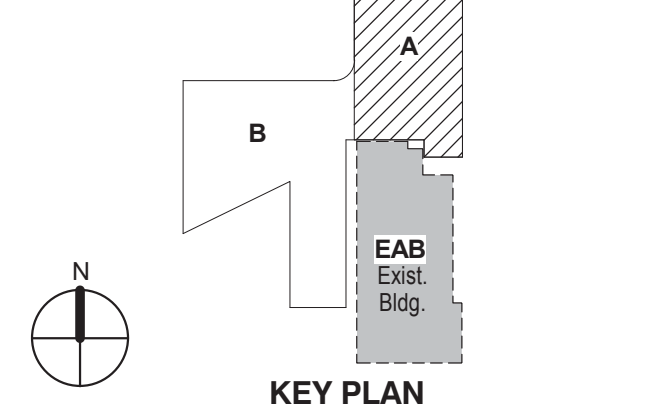

Drawing Title:

LEVEL 01 AREA A FLOOR
PLAN


Project No.: 04561.01

Checked by:

A0101.A

CONFORMED SET 01 JUL 2016

1 ADDENDUM 3-1 05 APR 2016
ISSUED FOR CONSTRUCTION (BP3) 15 MAR 2016
No. Description Date

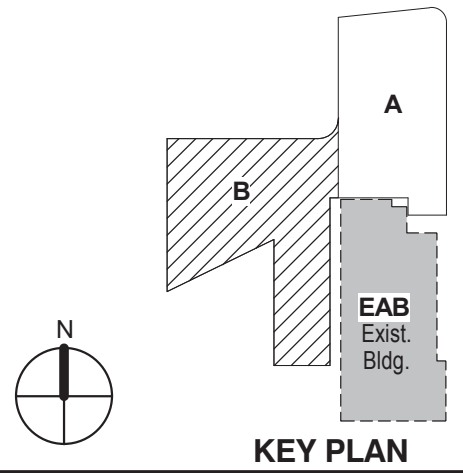

KEY PLAN

LEVEL 01 AREA B FLOOR
PLAN

Project No.: 04561.01 Checked by:

A0101.B



1 LEVEL 01 AREA B FLOOR PLAN-WEST
1/8" = 1'-0"

Partition Control Joint Notes:

1. All partition acoustical (stc) ratings and/or fire ratings must be maintained if a control joint is installed in them.


2. It is assumed that where ever there is a box with a "CJ" in it, that there is to be a control joint only at one side of the partition that this "CJ" box is next to. If this assumption is correct, then:

MP = Locate this control joint at the mid-point of this partition on the side of the partition that this abbreviation "MP" is located.

DJ = Locate this control joint above the door jamb on the side of the partition that this abbreviation "DJ" is located.

CONFORMED SET 01 JUL 2016

No.	Description	Date
1	ADDENDUM 3-2	15 APR 2016
2	ISSUED FOR CONSTRUCTION (BP3)	15 MAR 2016

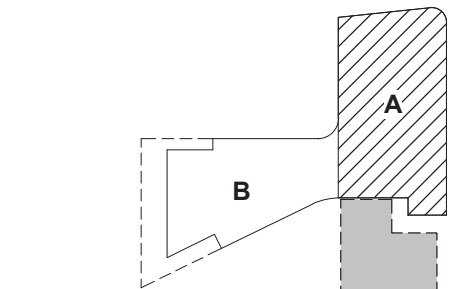


KEY PLAN

LEVEL 02 AREA A FLOOR
PLAN

Project No.: 04561.01 Checked by:

A0102.A

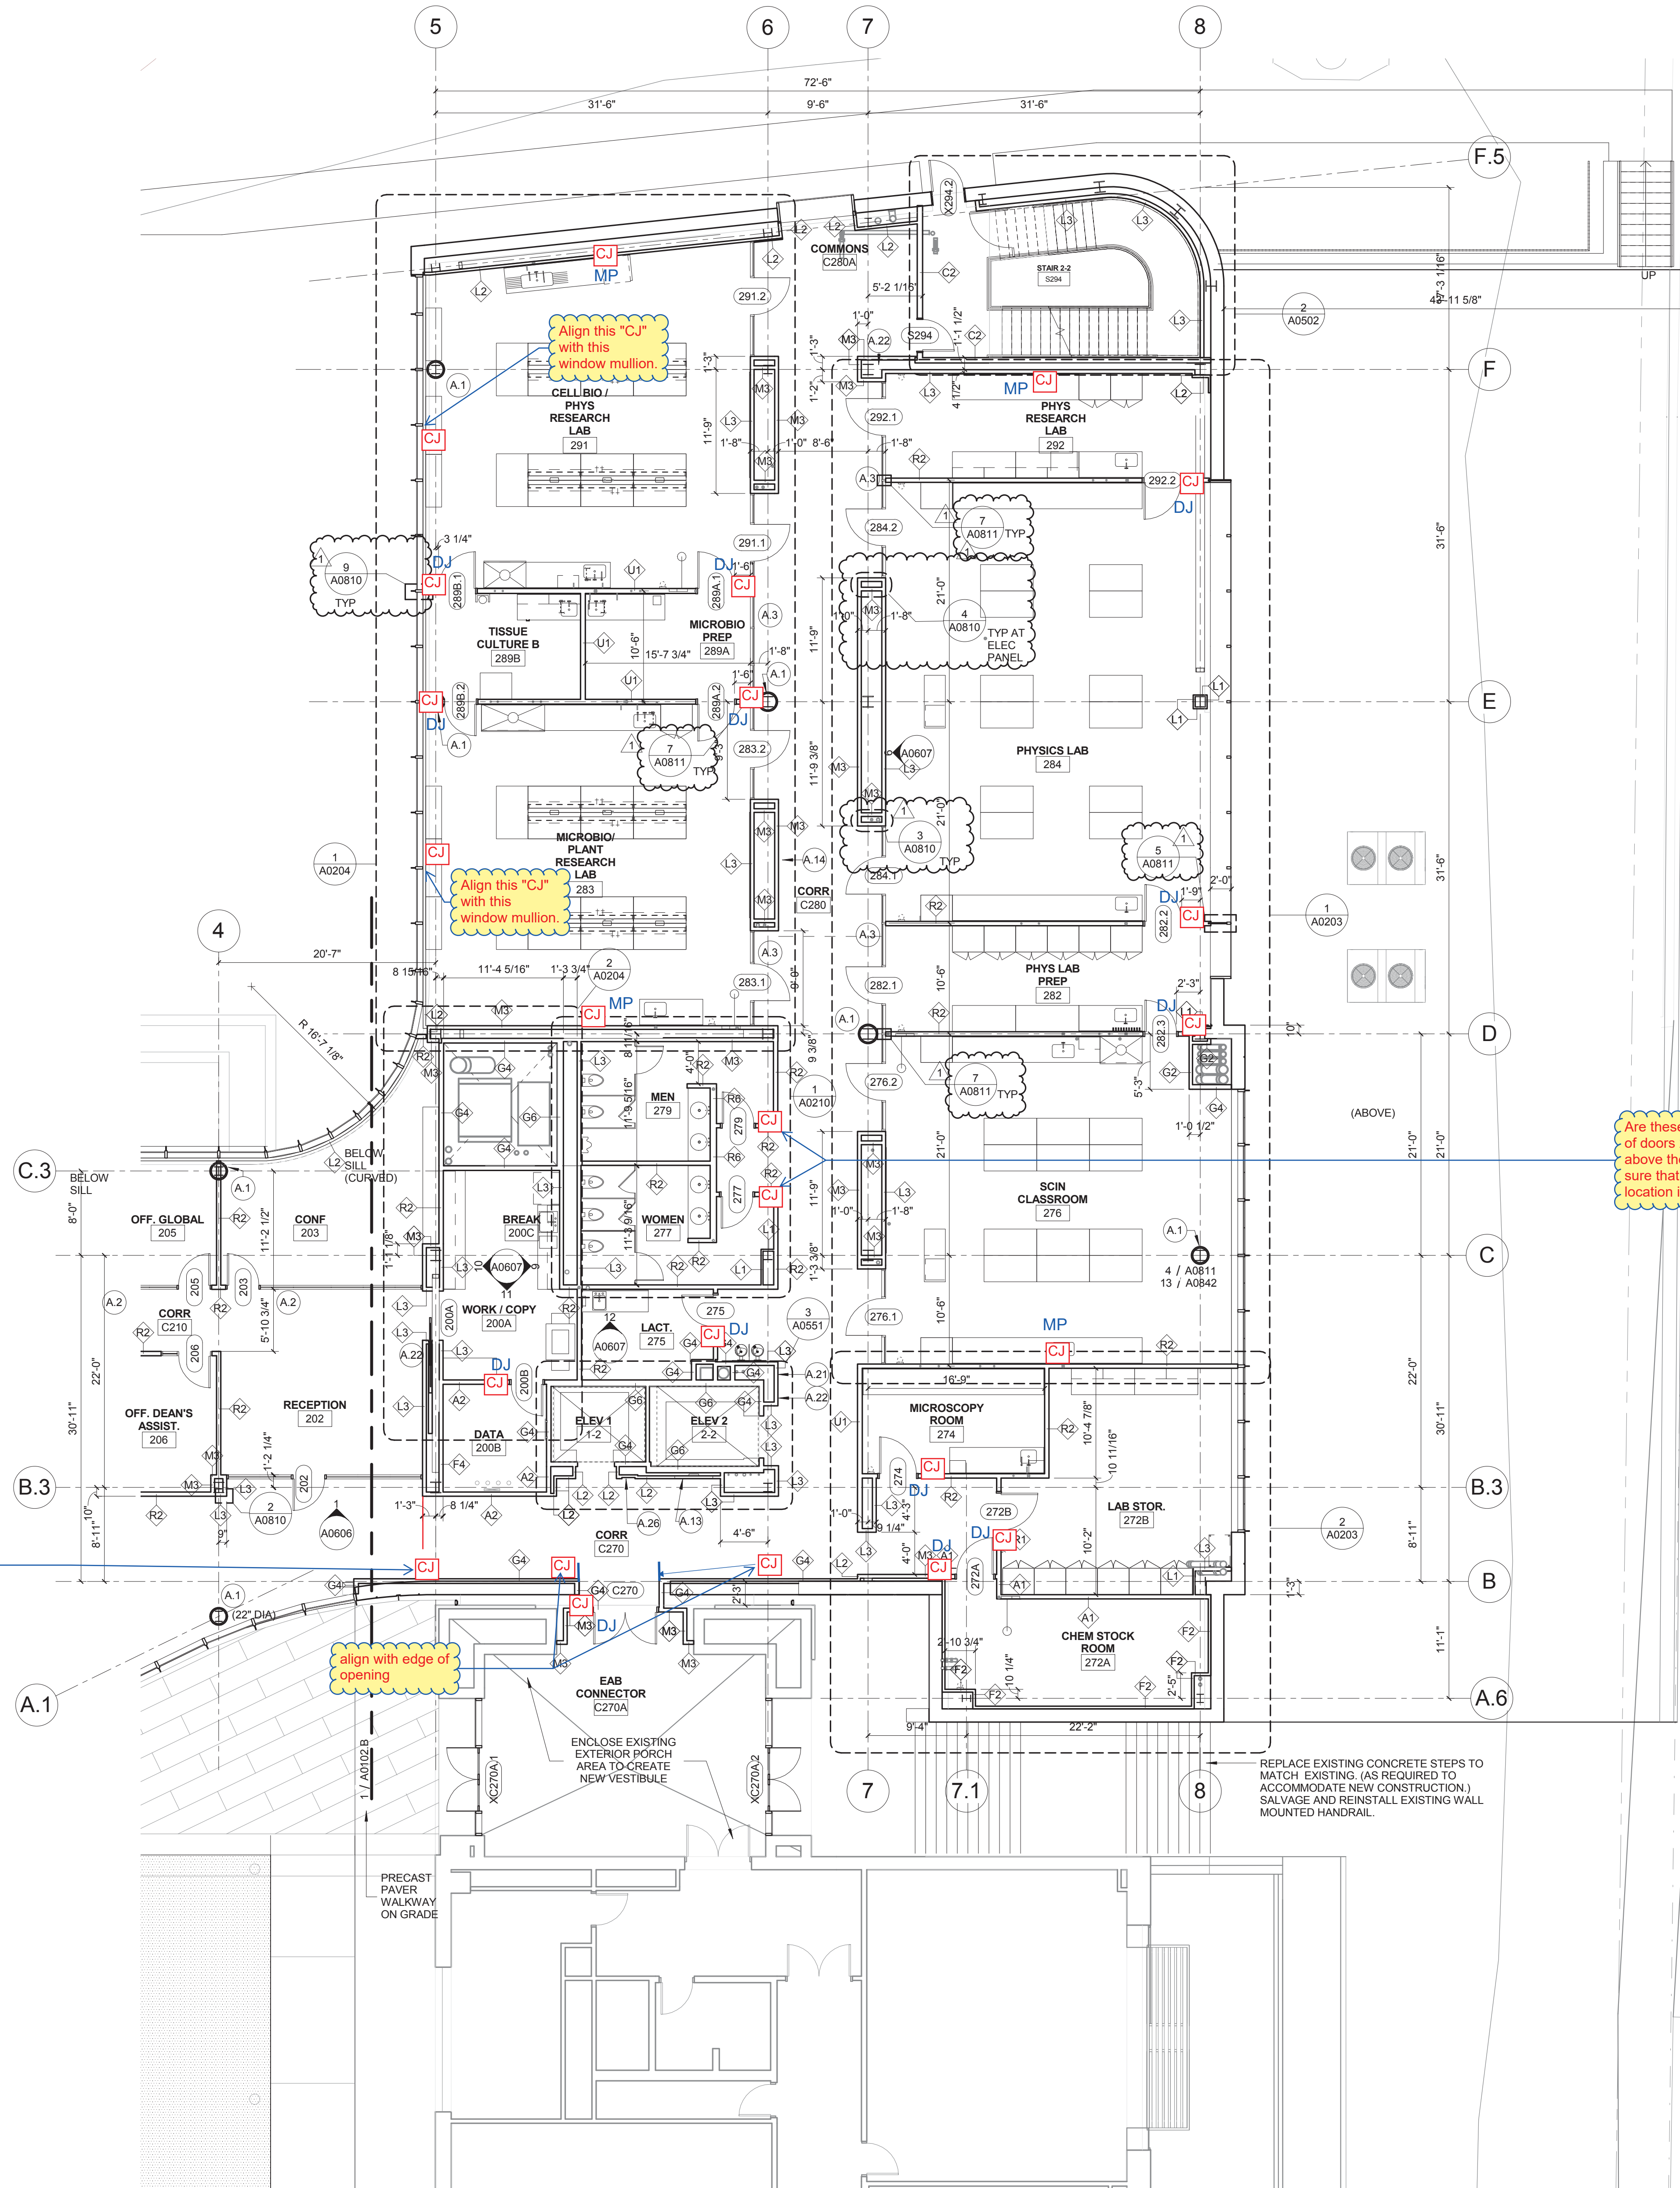

1 LEVEL 02- AREA A FLOOR PLAN
1/8" = 1'-0"

Partition Control Joint Notes:

1. All partition acoustical (stc) ratings and/or fire ratings must be maintained if a control joint is installed in them.

2. It is assumed that where ever there is a box with a "CJ" in it, that there is to be a control joint only at one side of the partition that this "CJ" box is next to. If this assumption is correct, then:


MP = Locate this control joint at the mid-point of this partition on the side of the partition that this abbreviation "MP" is located.

DJ = Locate this control joint above the door jamb on the side of the partition that this abbreviation "DJ" is located.

It is assumed that this "CJ" is to align with the edge of the opening across the corridor (and the "CJ" in the ceiling above).

align with edge of opening

Are these "CJ"s supposed to be above the jambs of doors 277 & 279 or are they supposed to be above the corners of this vestibule / alcove? Make sure that whichever location is required, that location is consistent at Levels 2, 3, & 4.

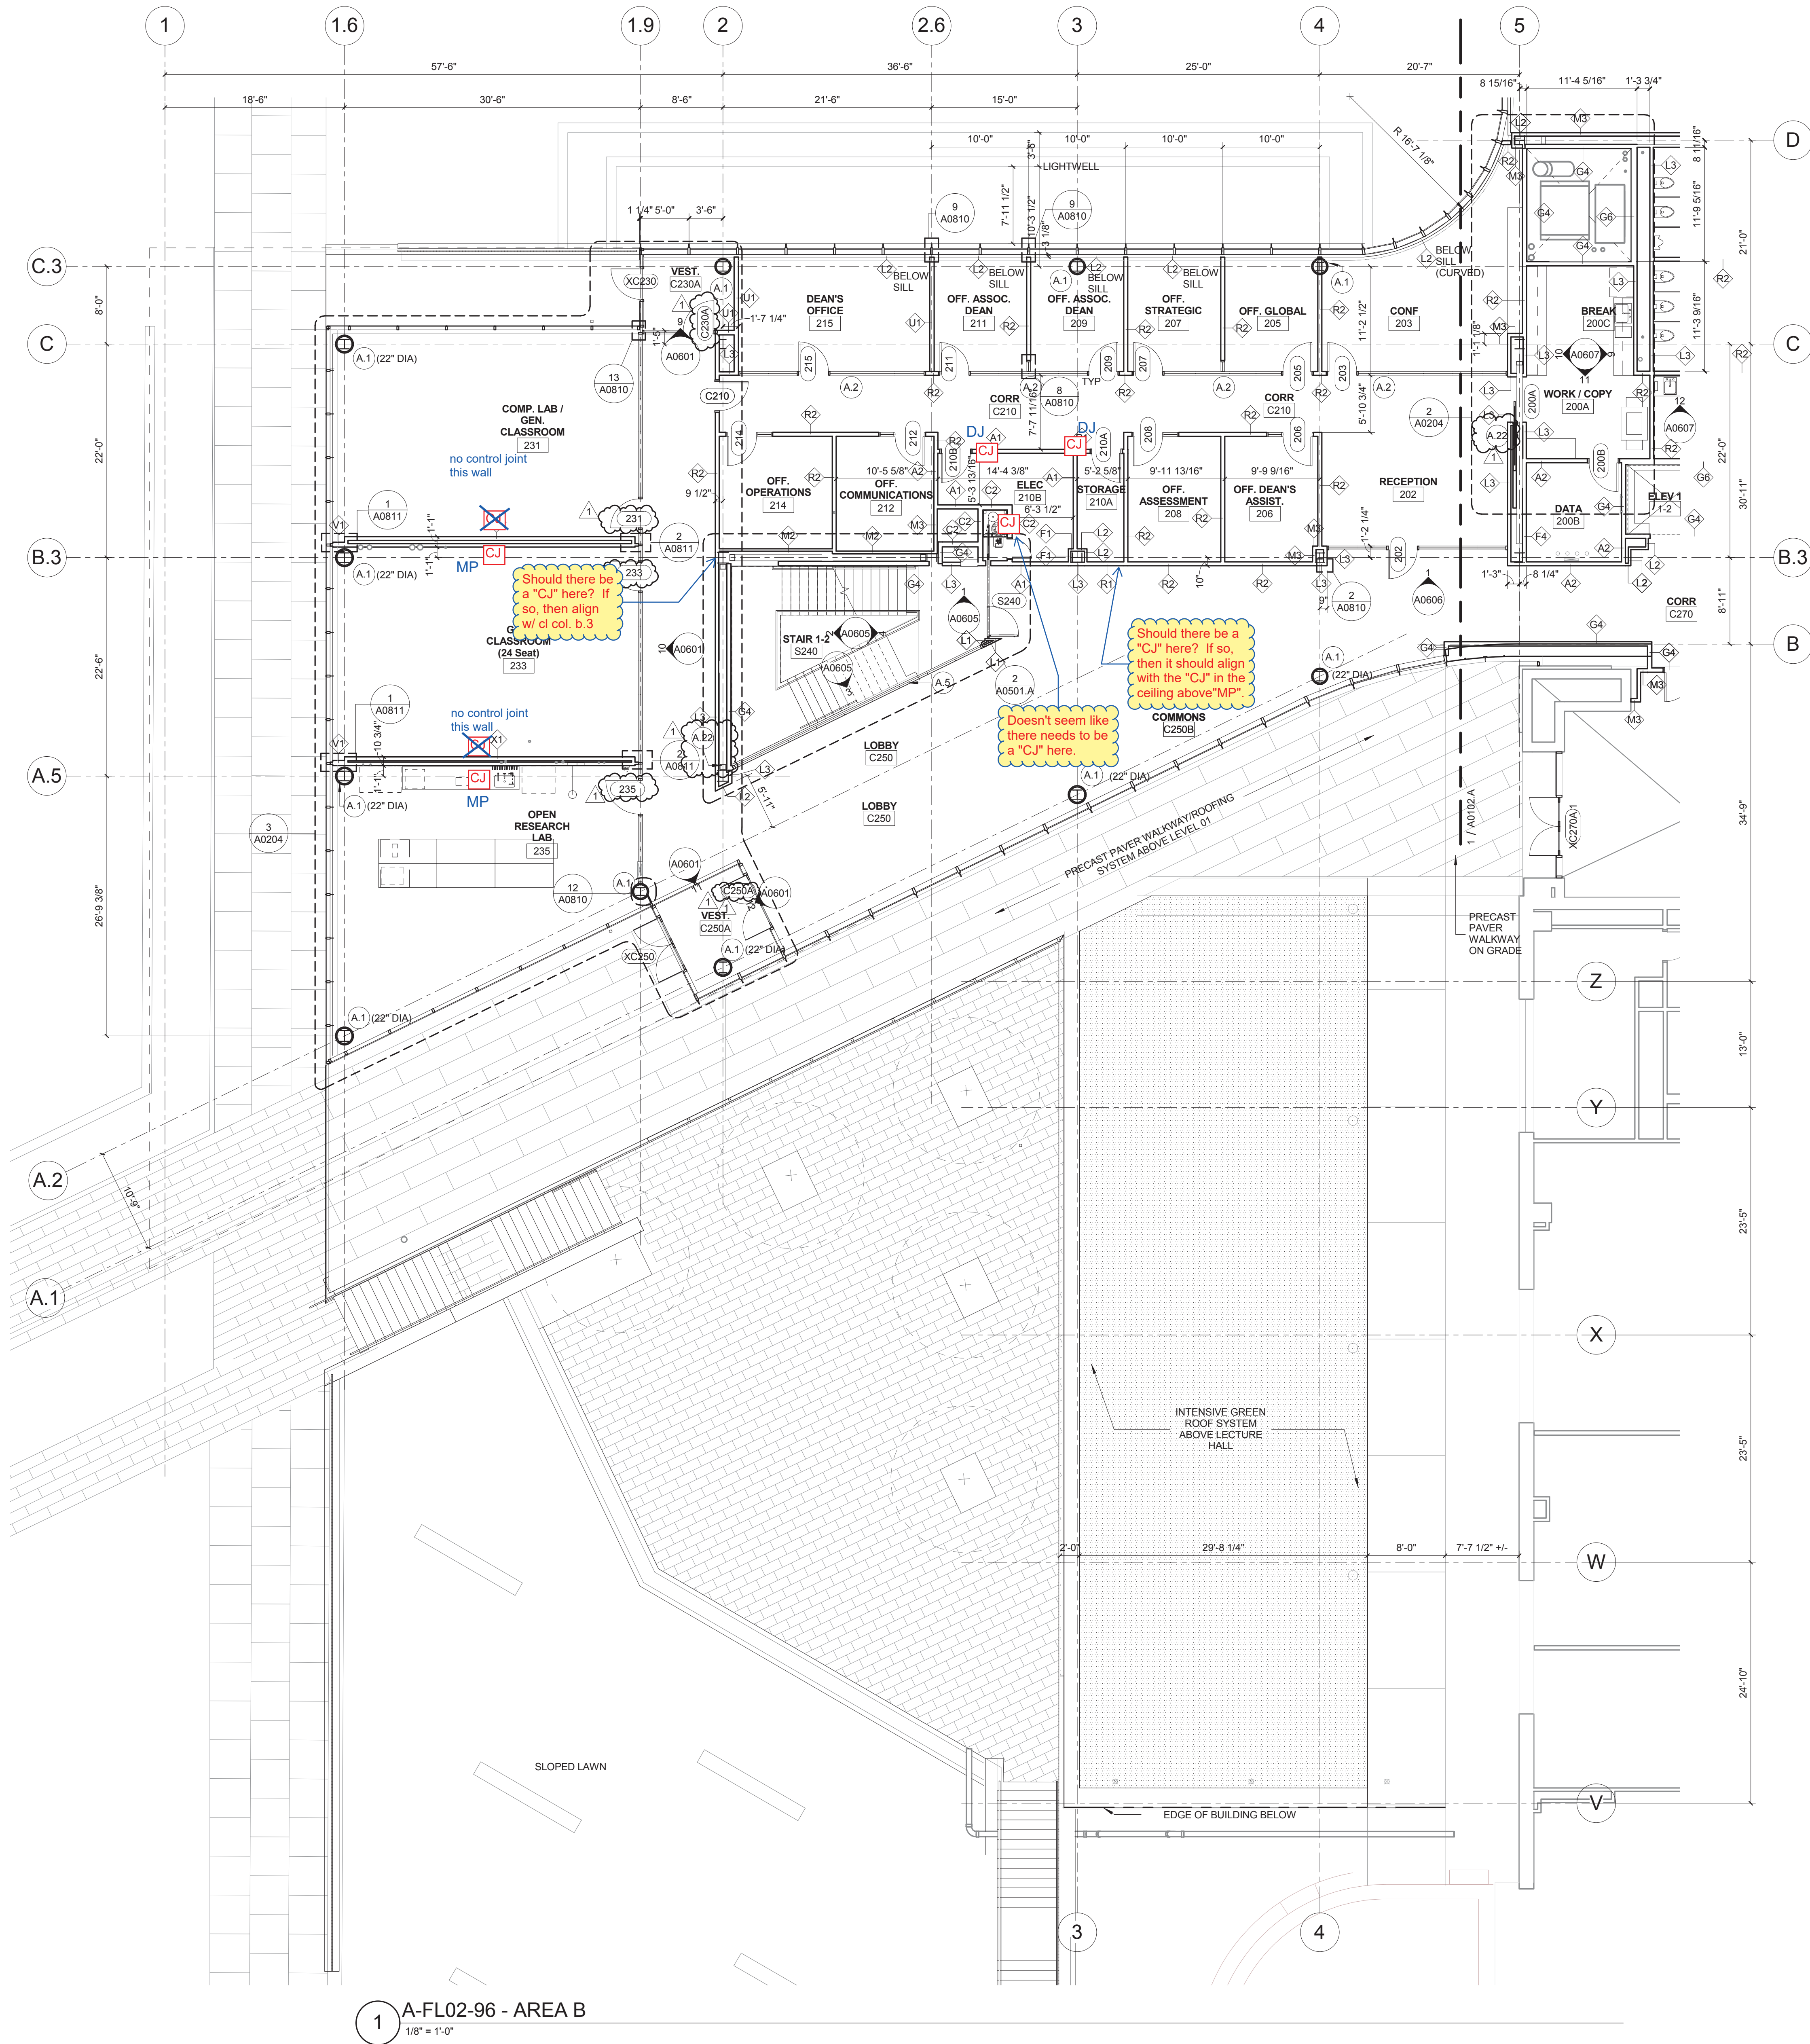

- KEYED NOTE LEGEND - PLAN**
- A.1 092700 GRG COLUMN COVER TO 3" ABOVE CEILING - 20" DIA. TYP. SEE DETAIL 4/A0811 AND 13/A0842.
 - A.2 081216 INTERIOR GLAZING SYSTEM: IGS-1. REFER TO TYPICAL INT. ELEVATIONS 1 AND 2 ON SHEET A0803
 - A.3 081216 INTERIOR GLAZING SYSTEM IGS-2. SEE TYPICAL ELEVATION 5 AND 6 A0603
 - A.4 081216 INTERIOR GLAZING SYSTEM: IGS-3. REFER TO INTERIOR ELEVATIONS
 - A.5 088813 FIRE RATED GLAZING- 120 MIN. FIRE RATED GLAZING 10'-0" HIGH. BASIS OF DESIGN: VETROTECH CONTRAFILAMM STRUTTURA - WITH BUTT JOINTS AND PERIMETER FRAMING
 - A.6 088813 FIRE RATED GLAZING AND FRAME- 120 MIN. FIRE RATED GLAZING 1'-8" HIGH X 5'-0" WIDE. BASIS OF DESIGN: VETROTECH CONTRAFILAMM WITH PERIMETER FRAMING
 - A.7 111519 LOADING DOCK LIFT - STATIONARY - 6W X 8' DEEPW/ 14" PIT
 - A.8 ALTERNATING TREAD STAIRWAY UP TO ROOF HATCH
 - A.9 UNDERSLAB DRAINAGE SYSTEM PER OWNER'S GEOTECHNICAL CONSULTANT RECOMMENDATION TYPICAL ALL SLAB ON GRADE AREAS
 - A.11 NEW CONCRETE STEPS TO MATCH EXISTING REMOVED FOR CONSTRUCTION
 - A.12 553006 BRICK FACED CONCRETE DUMPSTER ENCLOSURE TOP OF WALL
 - A.13 LCD SIGNAGE SCREEN IN WALL RECESS (OFCI)
 - A.14 MARKERBOARD SURFACE
 - A.15 WOOD SCREEN W/ SOLID LUMBER
 - A.17 VIDEO WALL - 24 55" SCREENS
 - A.18 LCD SCREEN LOCATION (OFOI)
 - A.19 AIR PLENUM - INSULATED PLENUM CONSTRUCTION BY DIVISION 23
 - A.20 122200 CURTAIN LOCATION
 - A.21 104313 AED CABINET LOCATION
 - A.22 10 4413 FEC WITH FIRE EXTINGUISHER
 - A.23 08 4423 SULL SASH LOCATION: PROVIDE 1/4" TEMPERED CLEAR GLAZING AT INTERIOR FACE OF CURTAIN WALL MULLIONS FOR ACOUSTICAL SEPARATION.
 - A.24 6" X 8" FORMED CONCRETE TRENCH IN FLOOR W/ METAL PLATE COVER. PROVIDE BLIND SIDE WATERPROOFING
 - A.25 BUILT IN SALT WATER FISH TANK LOCATION. SIZE APPROX. 7'-6" X 2'-4" X 2'-6" HIGH. LOW IRON GLASS VIEW WINDOW ON CORRIDOR SIDE. SLIDING DOOR ON LAB SIDE. FISH TANK EQUIPMENT BELOW TANK W/ CABINET DOOR ACCESS ON LAB SIDE. FINISHED INTERIOR FACE OF WALLS AND CEILING INSIDE CAVITY W/ WATER RESISTANT GYP BOARD AND EPOXY PAINT.
 - A.26 LCD SIGNAGE SCREEN IN WALL RECESS (OFCI)
 - A.27 CONSTRUCT 2 HOUR RATED SEPARATION BETWEEN BOTTOM OF STAIR AND UTILITY PIPING CROSSING THIS AREA. USE HORIZ. GYP BD. ENCLOSURE ON SHEET A1002

Partition Control Joint Notes:

1. All partition acoustical (stc) ratings and/or fire ratings must be maintained if a control joint is installed in them.

2. It is assumed that where ever there is a box with a "CJ" in it, that there is to be a control joint only at one side of the partition that this "CJ" box is next to. If this assumption is correct, then:


MP = Locate this control joint at the mid-point of this partition on the side of the partition that this abbreviation "MP" is located.

DJ = Locate this control joint above the door jamb on the side of the partition that this abbreviation "DJ" is located.

CONFORMED SET 01 JUL 2016

1 ADDENDUM 3-1 05 APR 2016
ISSUED FOR CONSTRUCTION (BP3) 15 MAR 2016

No.	Description	Date

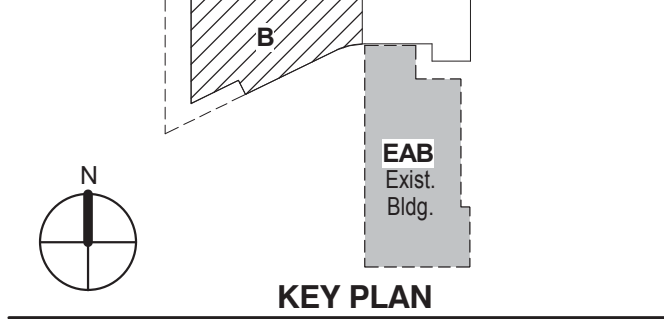

Drawing Title:


**LEVEL 02 AREA B FLOOR
PLAN**

Project No.: 04561.01 Checked by:

A0102.B

CONFORMED SET 01 JUL 2016

2	ADDENDUM 3-2	15 APR 2016
1	ADDENDUM 3-1	06 APR 2016
-	ISSUED FOR CONSTRUCTION (BP3)	15 MAR 2016
No.	Description	Date

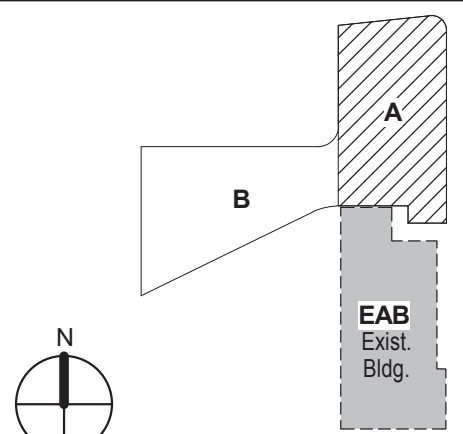


KEY PLAN

LEVEL 03 AREA A FLOOR
PLAN

Project No.: 04561.01 Checked by:

A0103.A

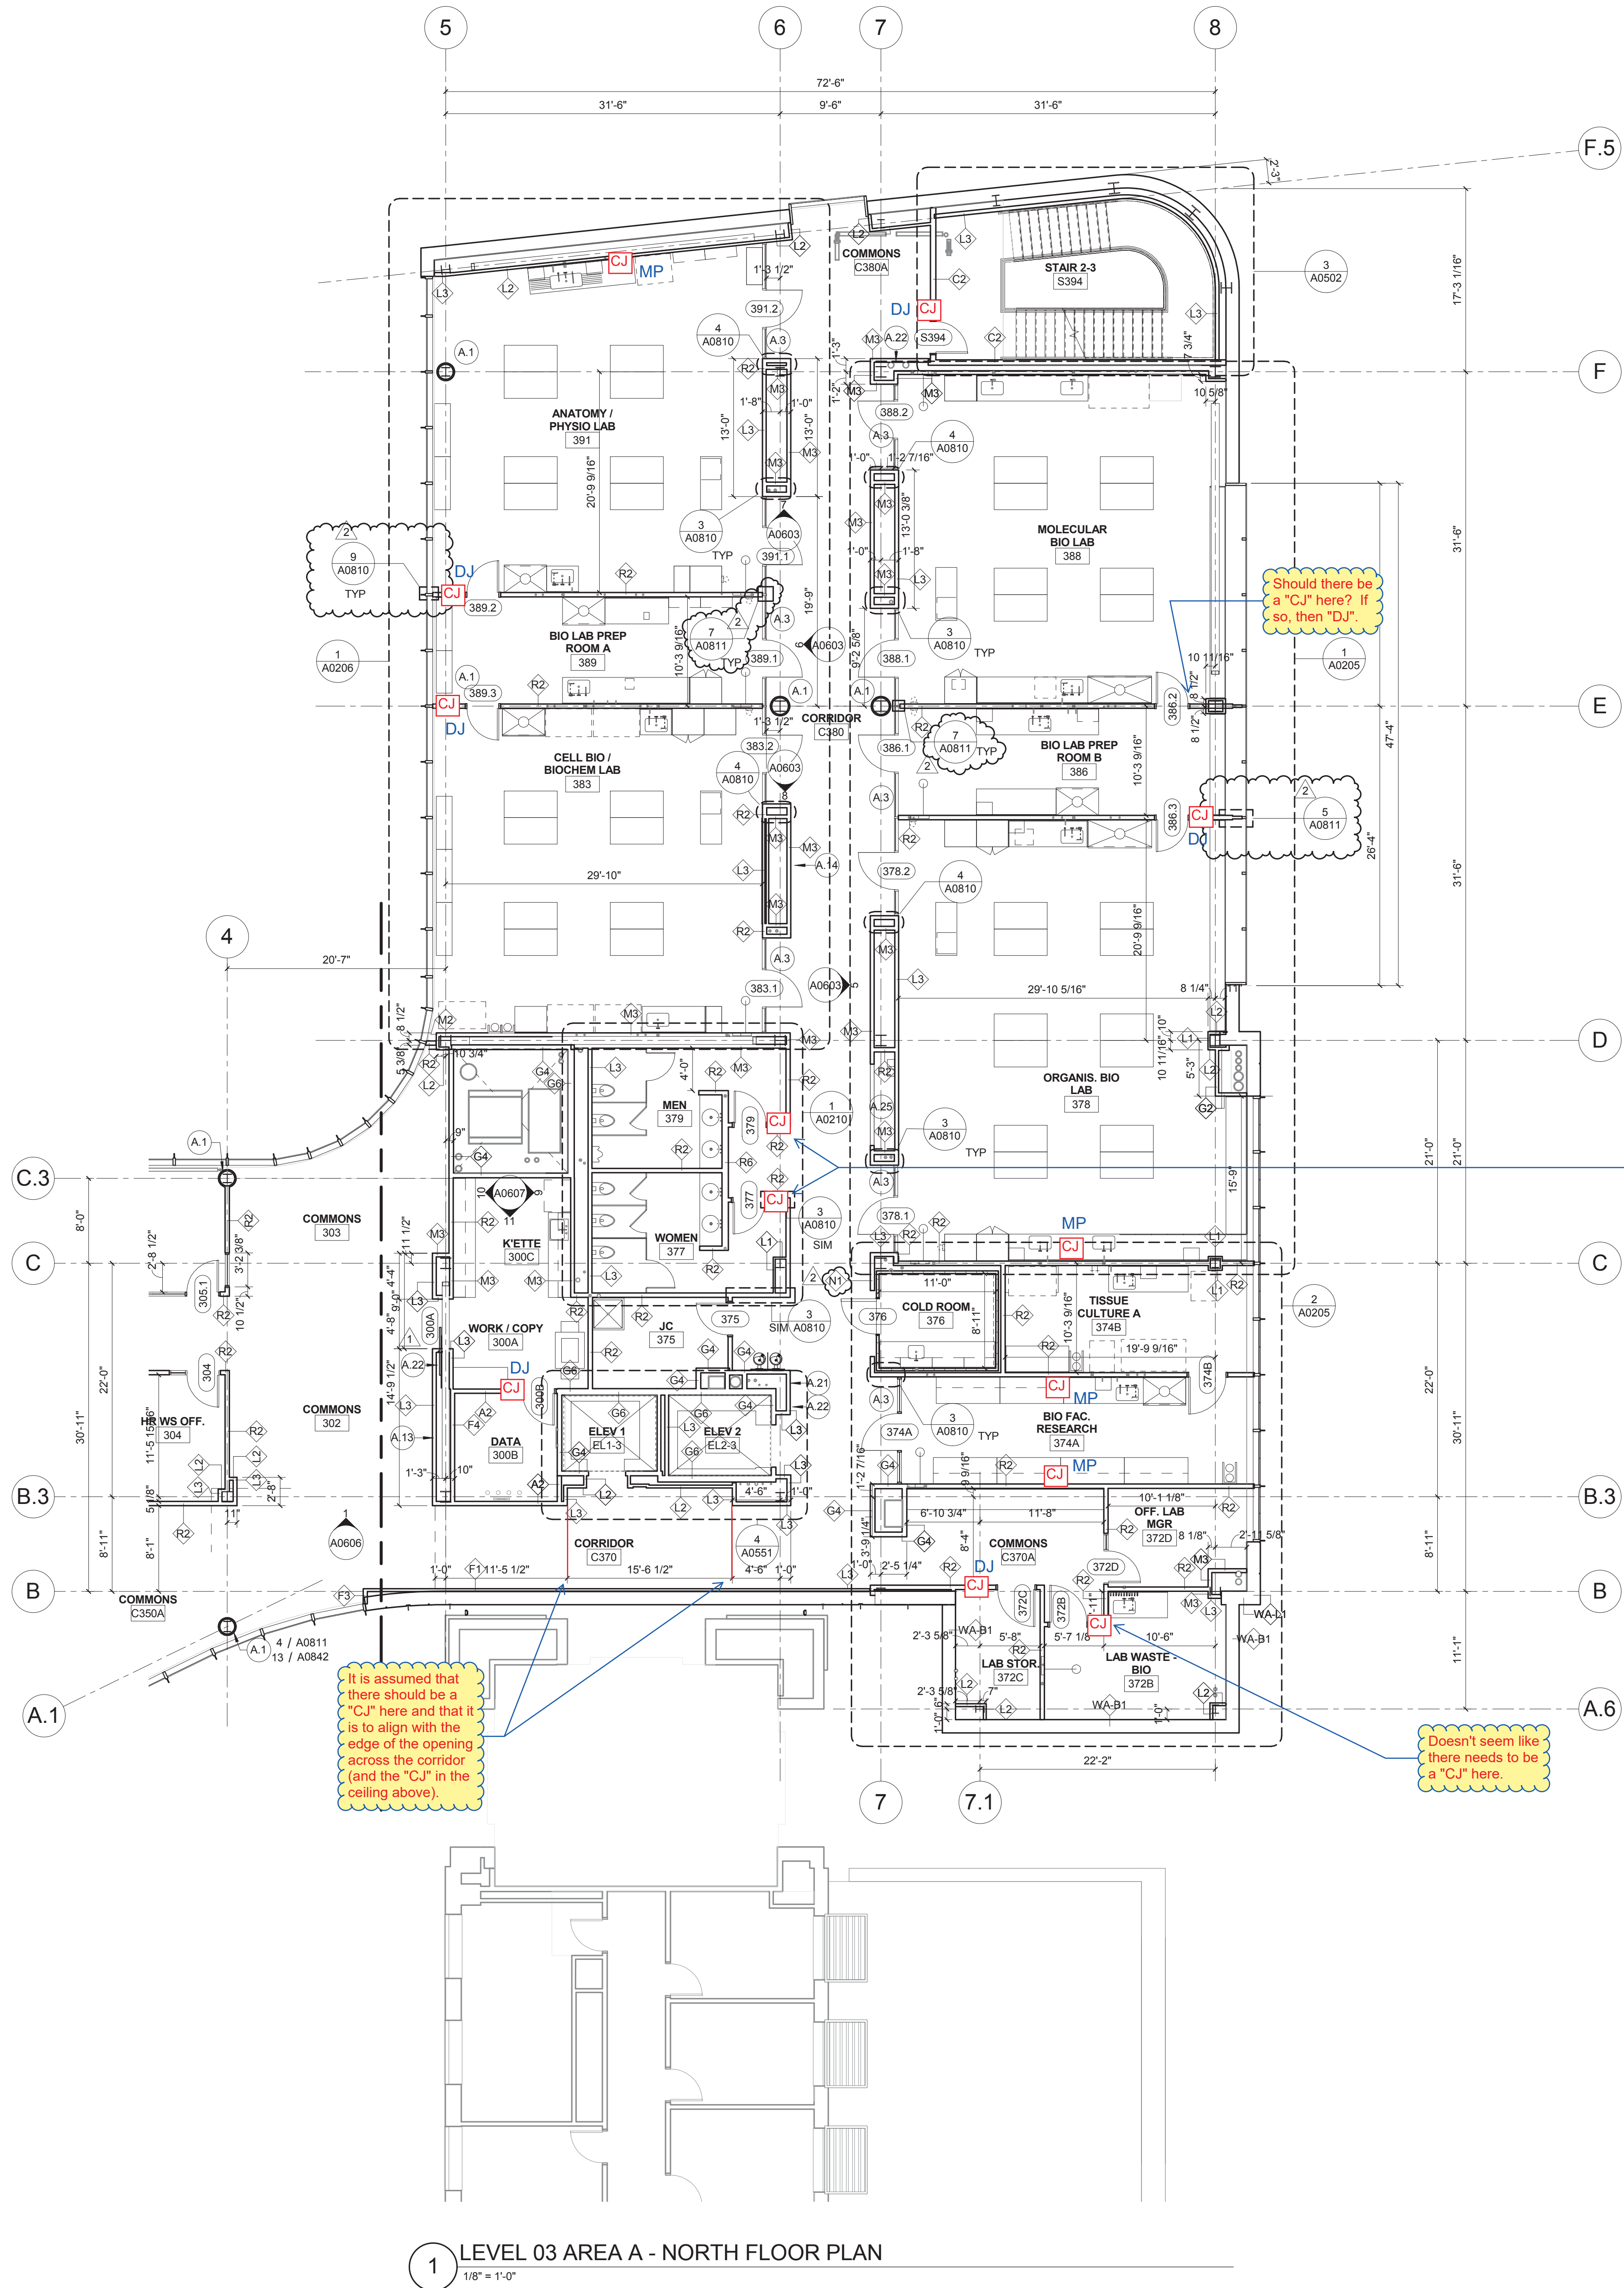

KEYED NOTE LEGEND - PLAN

- A.1 092700 GRG COLUMN COVER TO 3" ABOVE CEILING - 20" DIA. TYP. SEE DETAIL 4/A0811 AND 13/A0842.
A.2 081216 INTERIOR GLAZING SYSTEM: IGS-1: REFER TO TYPICAL INT. ELEVATIONS 1 AND 2 ON SHEET A0803
A.3 081216 INTERIOR GLAZING SYSTEM IGS-2: SEE TYPICAL ELEVATION 5 AND 6 A0603
A.4 081216 INTERIOR GLAZING SYSTEM: IGS-3: REFER TO INTERIOR ELEVATIONS
A.5 088813 FIRE RATED GLAZING- 120 MIN. FIRE RATED GLAZING 10'-0" HIGH. BASIS OF DESIGN: VETROTECH CONTRAFILAMM STRUTTURA - WITH BUTT JOINTS AND PERIMETER FRAMING
A.6 088813 FIRE RATED GLAZING AND FRAME- 120 MIN. FIRE RATED GLAZING 1'-8" HIGH X 5'-0" WIDE. BASIS OF DESIGN: VETROTECH CONTRAFILAMM WITH PERIMETER FRAMING
A.7 111519 LOADING DOCK LIFT - STATIONARY - 6W X 8' DEEPW/ 14" PIT
A.8 ALTERNATING TREAD STAIRWAY UP TO ROOF HATCH
A.9 UNDERSLAB DRAINAGE SYSTEM PER OWNER'S GEOTECHNICAL CONSULTANT RECOMMENDATION TYPICAL ALL SLAB ON GRADE AREAS
A.11 NEW CONCRETE STEPS TO MATCH EXISTING REMOVED FOR CONSTRUCTION
A.12 553006 BRICK FACED CONCRETE DUMPSTER ENCLOSURE TOP OF WALL
A.13 LCD SIGNAGE SCREEN IN WALL RECESS (OFCI)
A.14 MARKERBOARD SURFACE
A.15 WOOD SCREEN W/ SOLID LUMBER
A.17 VIDEO WALL - 24 55" SCREENS
A.18 LCD SCREEN LOCATION (OFOI)
A.19 AIR PLENUM - INSULATED PLENUM CONSTRUCTION BY DIVISION 23
A.20 122200 CURTAIN LOCATION
A.21 104313 AED CABINET LOCATION
A.22 10 4413 FEC WITH FIRE EXTINGUISHER
A.23 08 4423 SULL SASH LOCATION: PROVIDE 1/4" TEMPERED CLEAR GLAZING AT INTERIOR FACE OF CURTAIN WALL MULLIONS FOR ACoustICAL SEPARATION.
A.24 6" X 8" FORMED CONCRETE TRENCH IN FLOOR W/ METAL PLATE COVER. PROVIDE BLIND SIDE WATERPROOFING
A.25 BUILT IN SALT WATER FISH TANK LOCATION. SIZE APPROX. 7'-6" X 2'-4" X 2'-6" HIGH. LOW IRON GLASS VIEW WINDOW ON CORRIDOR SIDE. SLIDING DOOR ON LAB SIDE. FISH TANK EQUIPMENT BELOW TANK W/ CABINET DOOR ACCESS ON LAB SIDE. FINISHED INTERIOR FACE OF WALLS AND CEILING INSIDE CAVITY W/ WATER RESISTANT GYP BOARD AND EPOXY PAINT.
A.26 LCD SIGNAGE SCREEN IN WALL RECESS (OFCI)
A.27 CONSTRUCT 2 HOUR RATED SEPARATION BETWEEN BOTTOM OF STAIR AND UTILITY PIPING CROSSING THIS AREA. USE HORIZ. GYP BD. ENCLOSURE ON SHEET A1002

Should there be a "CJ" here? If so, then "DJ"

Are these "CJ"s supposed to be above the jambs of doors 377 & 379 or are they supposed to be above the corners of this vestibule / alcove? Make sure that whichever location is required, that location is consistent at Levels 2, 3, & 4.


It is assumed that there should be a "CJ" here and that it is to align with the edge of the opening across the corridor (and the "CJ" in the ceiling above)

Doesn't seem like there needs to be a "CJ" here.

1 LEVEL 03 AREA A - NORTH FLOOR PLAN
1/8" = 1'-0"

CONFORMED SET 01 JUL 2016

1 ADDENDUM 3-1 05 APR 2016
ISSUED FOR CONSTRUCTION (BP3) 15 MAR 2016
No. Description Date

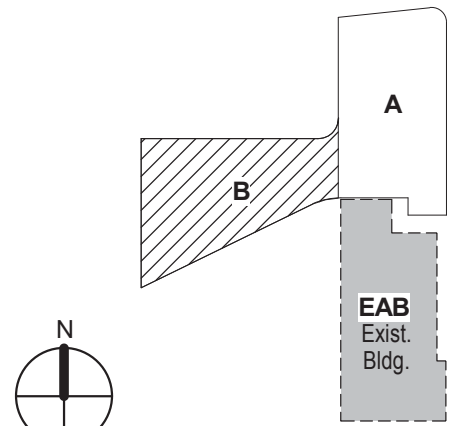


KEY PLAN

LEVEL 03 AREA B FLOOR
PLAN


Project No.: 04561.01 Checked by:

A0103.B

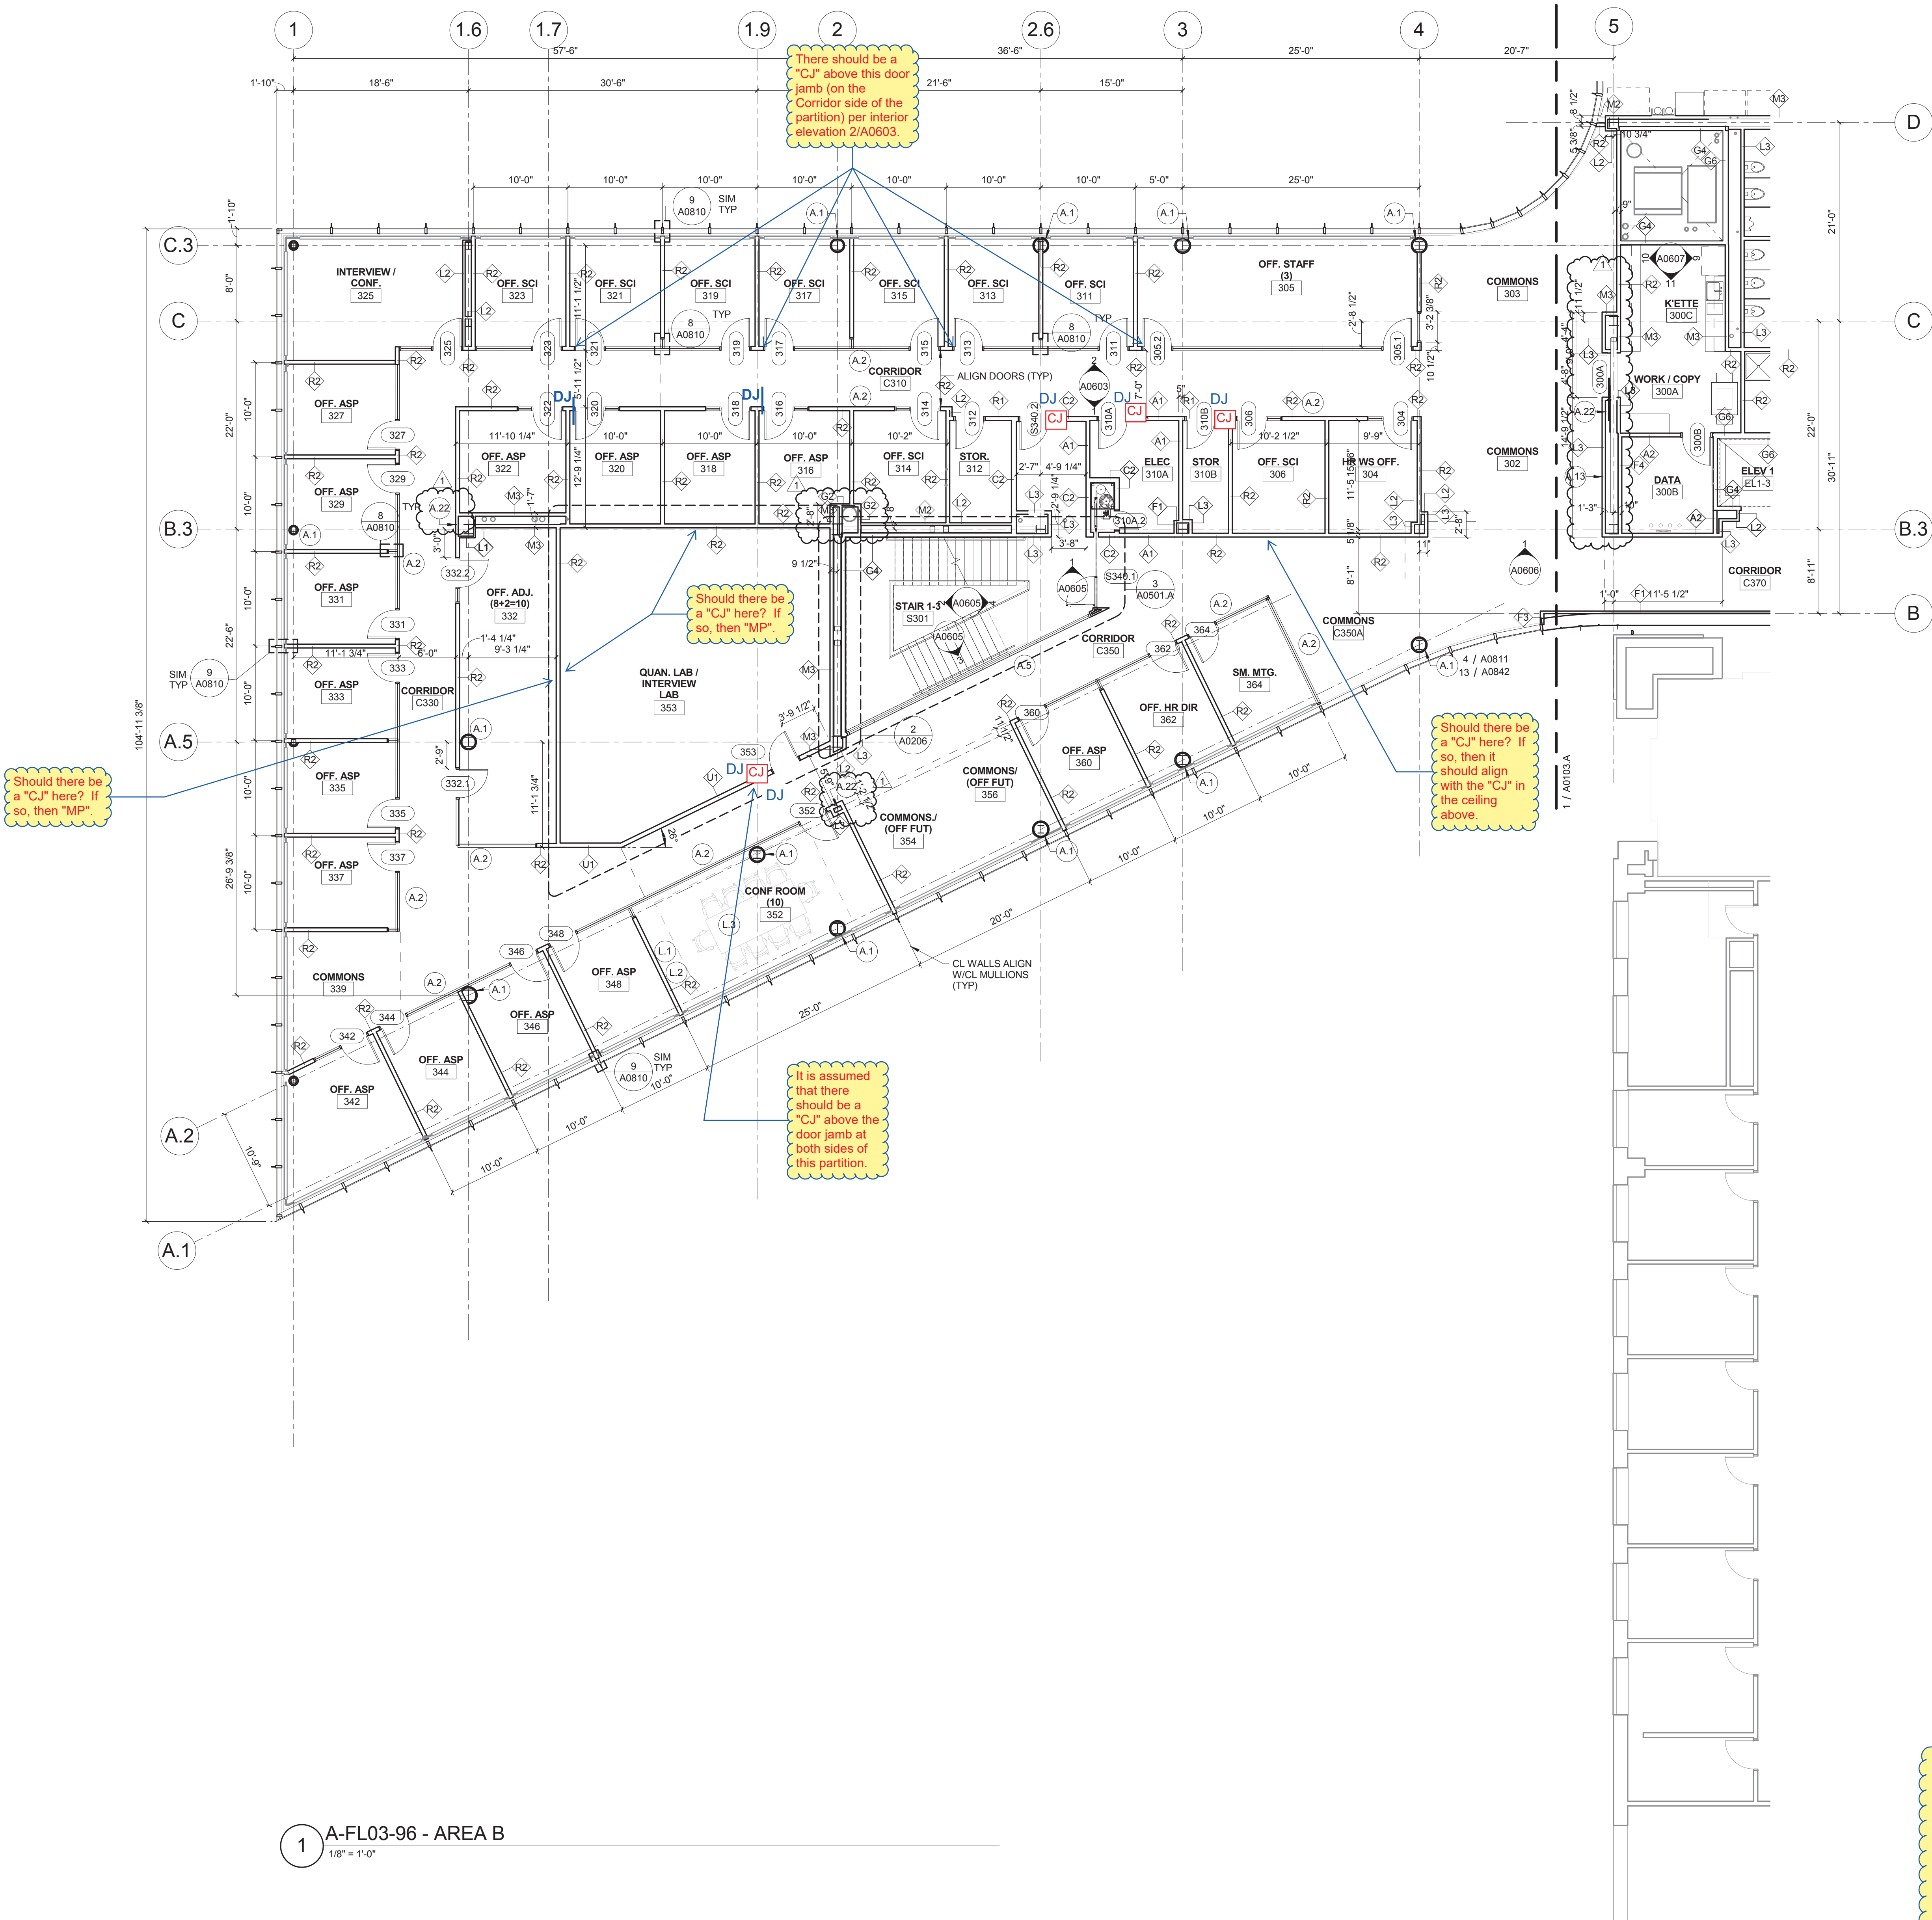

CONFORMED SET 01 JUL 2016

1 ADDENDUM 3-2 15 APR 2016
ISSUED FOR CONSTRUCTION (BP3) 15 MAR 2016
No. Description Date

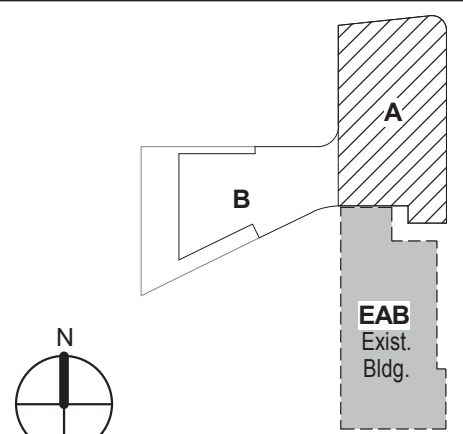


KEY PLAN

Drawing Title:

LEVEL 04 AREA A FLOOR
PLAN

Project No.: 04561.01 Checked by:

A0104.A

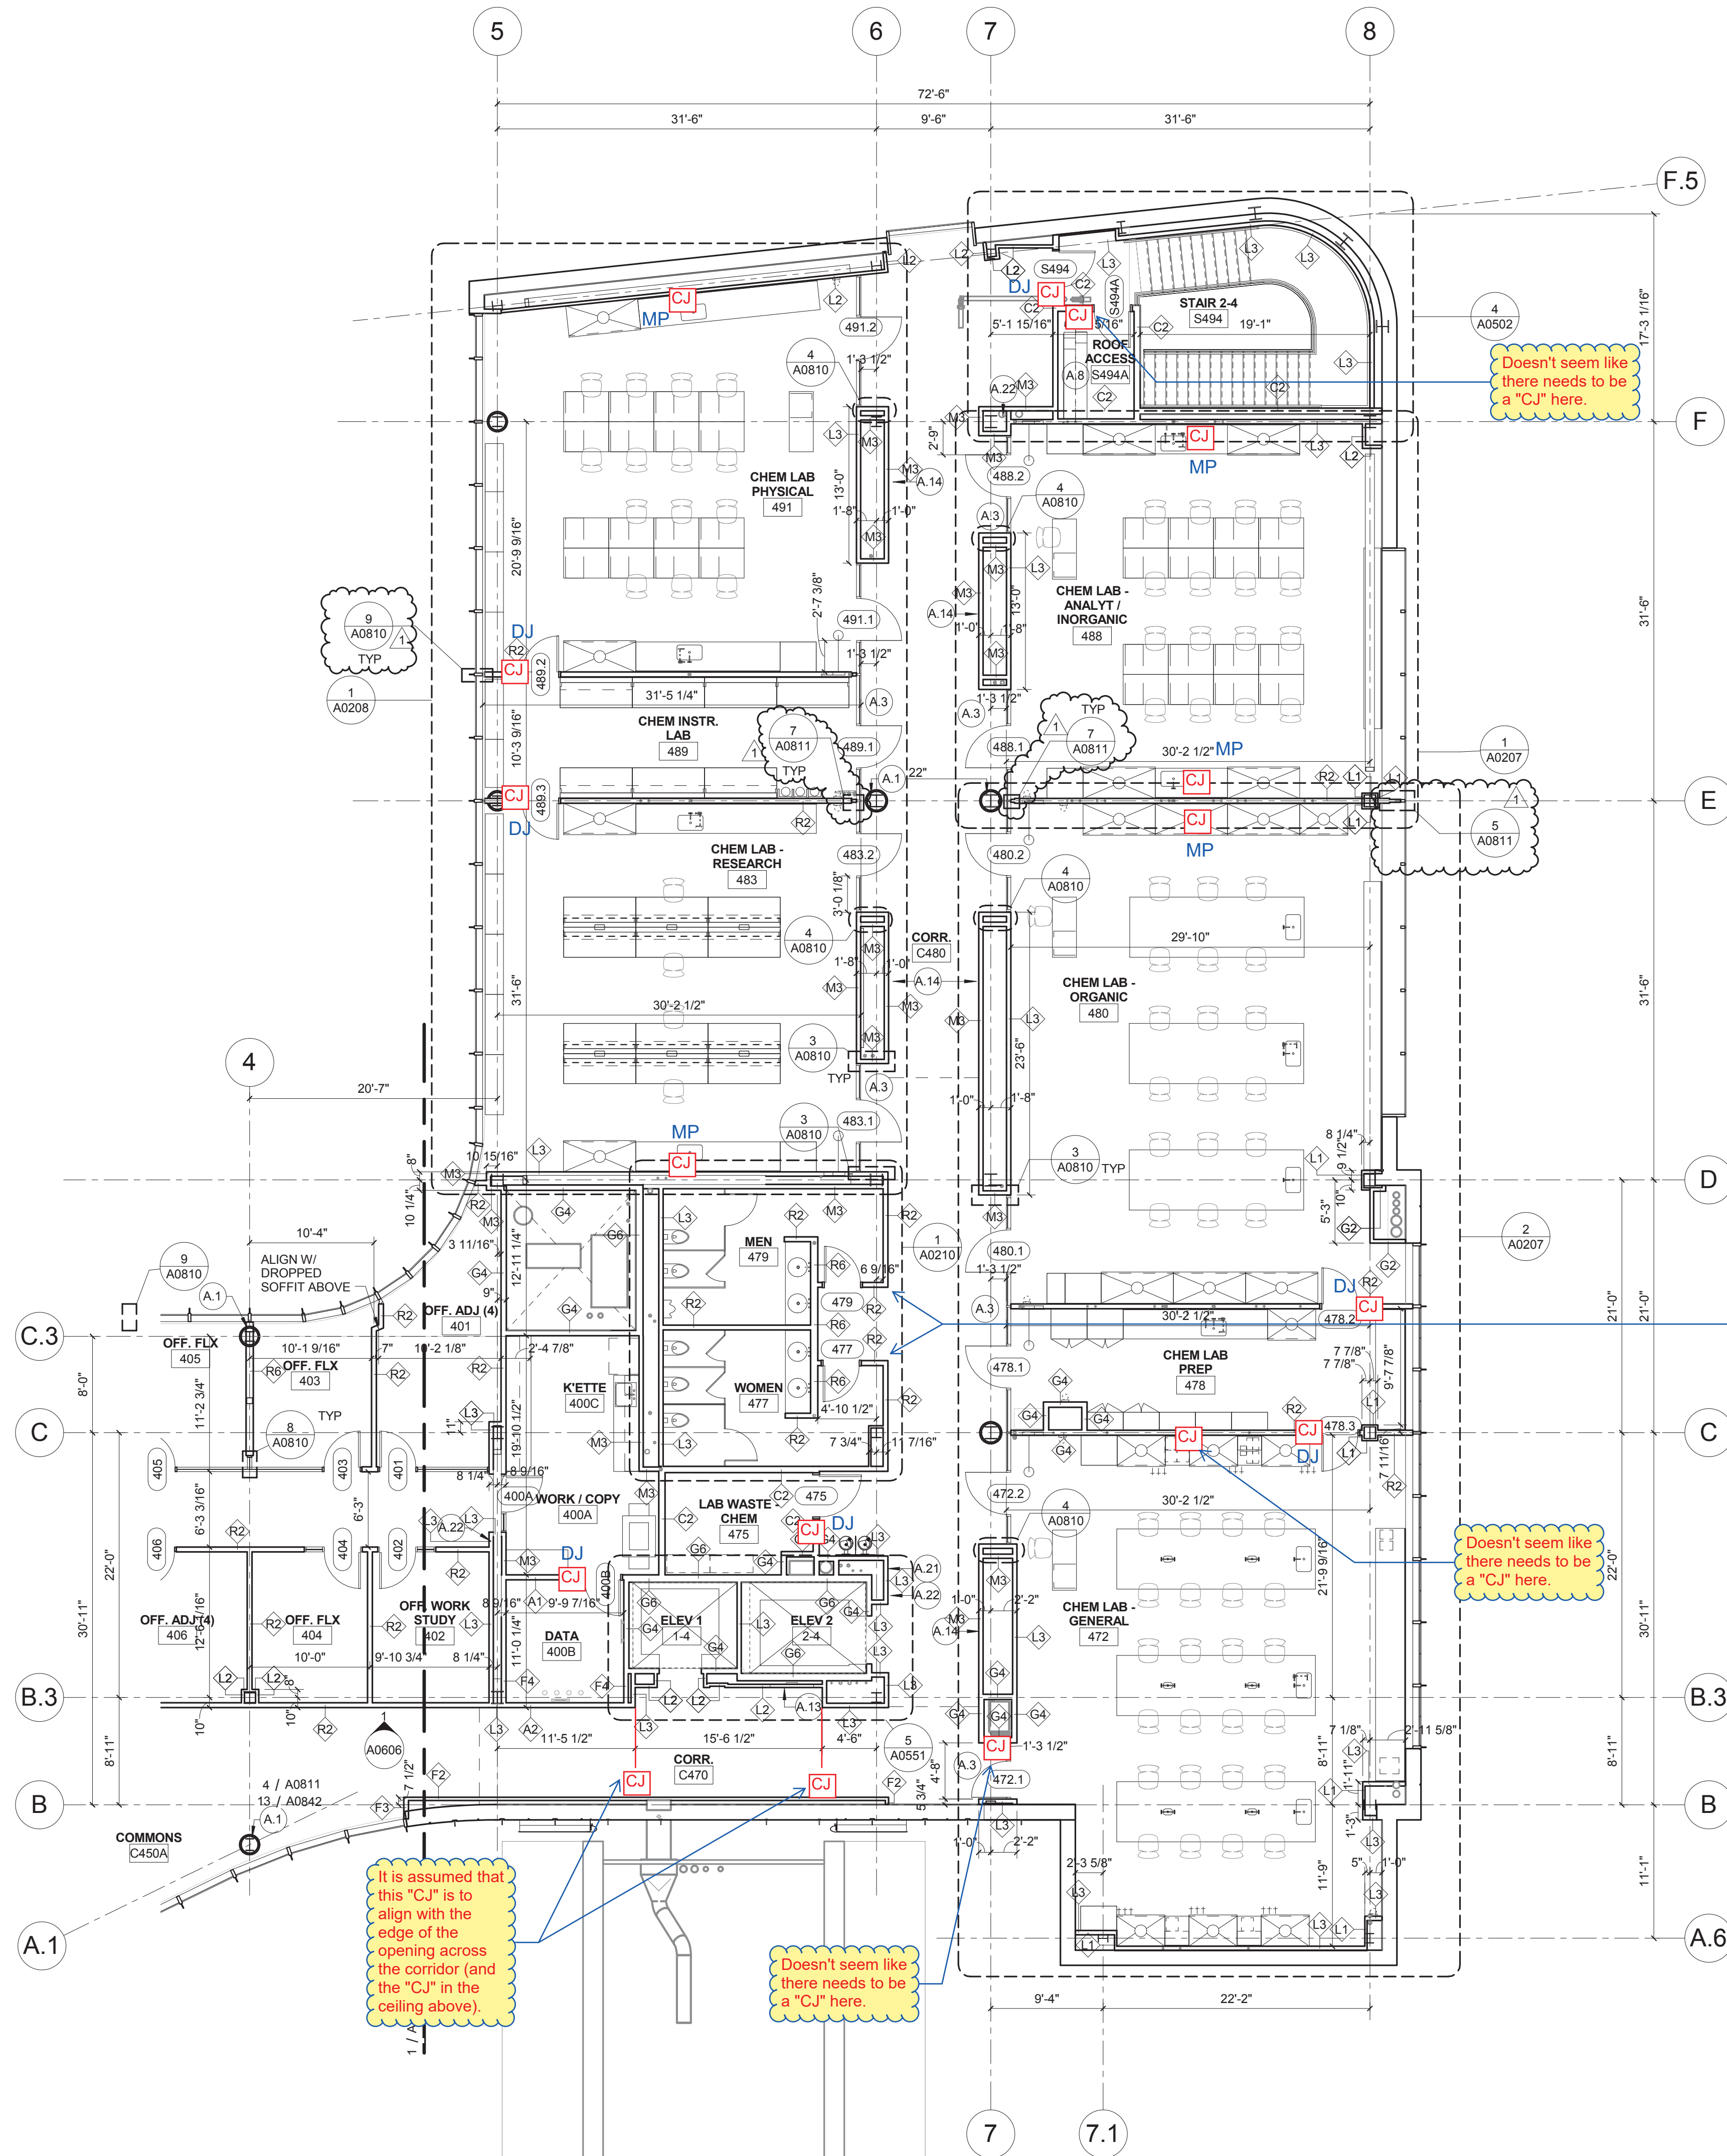

It is assumed that this "CJ" is to align with the edge of the opening across the corridor (and the "CJ" in the ceiling above).

Doesn't seem like there needs to be a "CJ" here.

Doesn't seem like there needs to be a "CJ" here.

Are these "CJ"s supposed to be above the jambs of doors 477 & 479 or are they supposed to be above the corners of this vestibule / alcove? Make sure that whichever location is required, that location is consistent at Levels 2, 3, & 4.

Partition Control Joint Notes:


1. All partition acoustical (stc) ratings and/or fire ratings must be maintained if a control joint is installed in them.

2. It is assumed that where ever there is a box with a "CJ" in it, that there is to be a control joint only at one side of the partition that this "CJ" box is next to. If this assumption is correct, then:

MP = Locate this control joint at the mid-point of this partition on the side of the partition that this abbreviation "MP" is located.

DJ = Locate this control joint above the door jamb on the side of the partition that this abbreviation "DJ" is located.

1 A-FL04-96 - AREA A
1/8" = 1'-0"

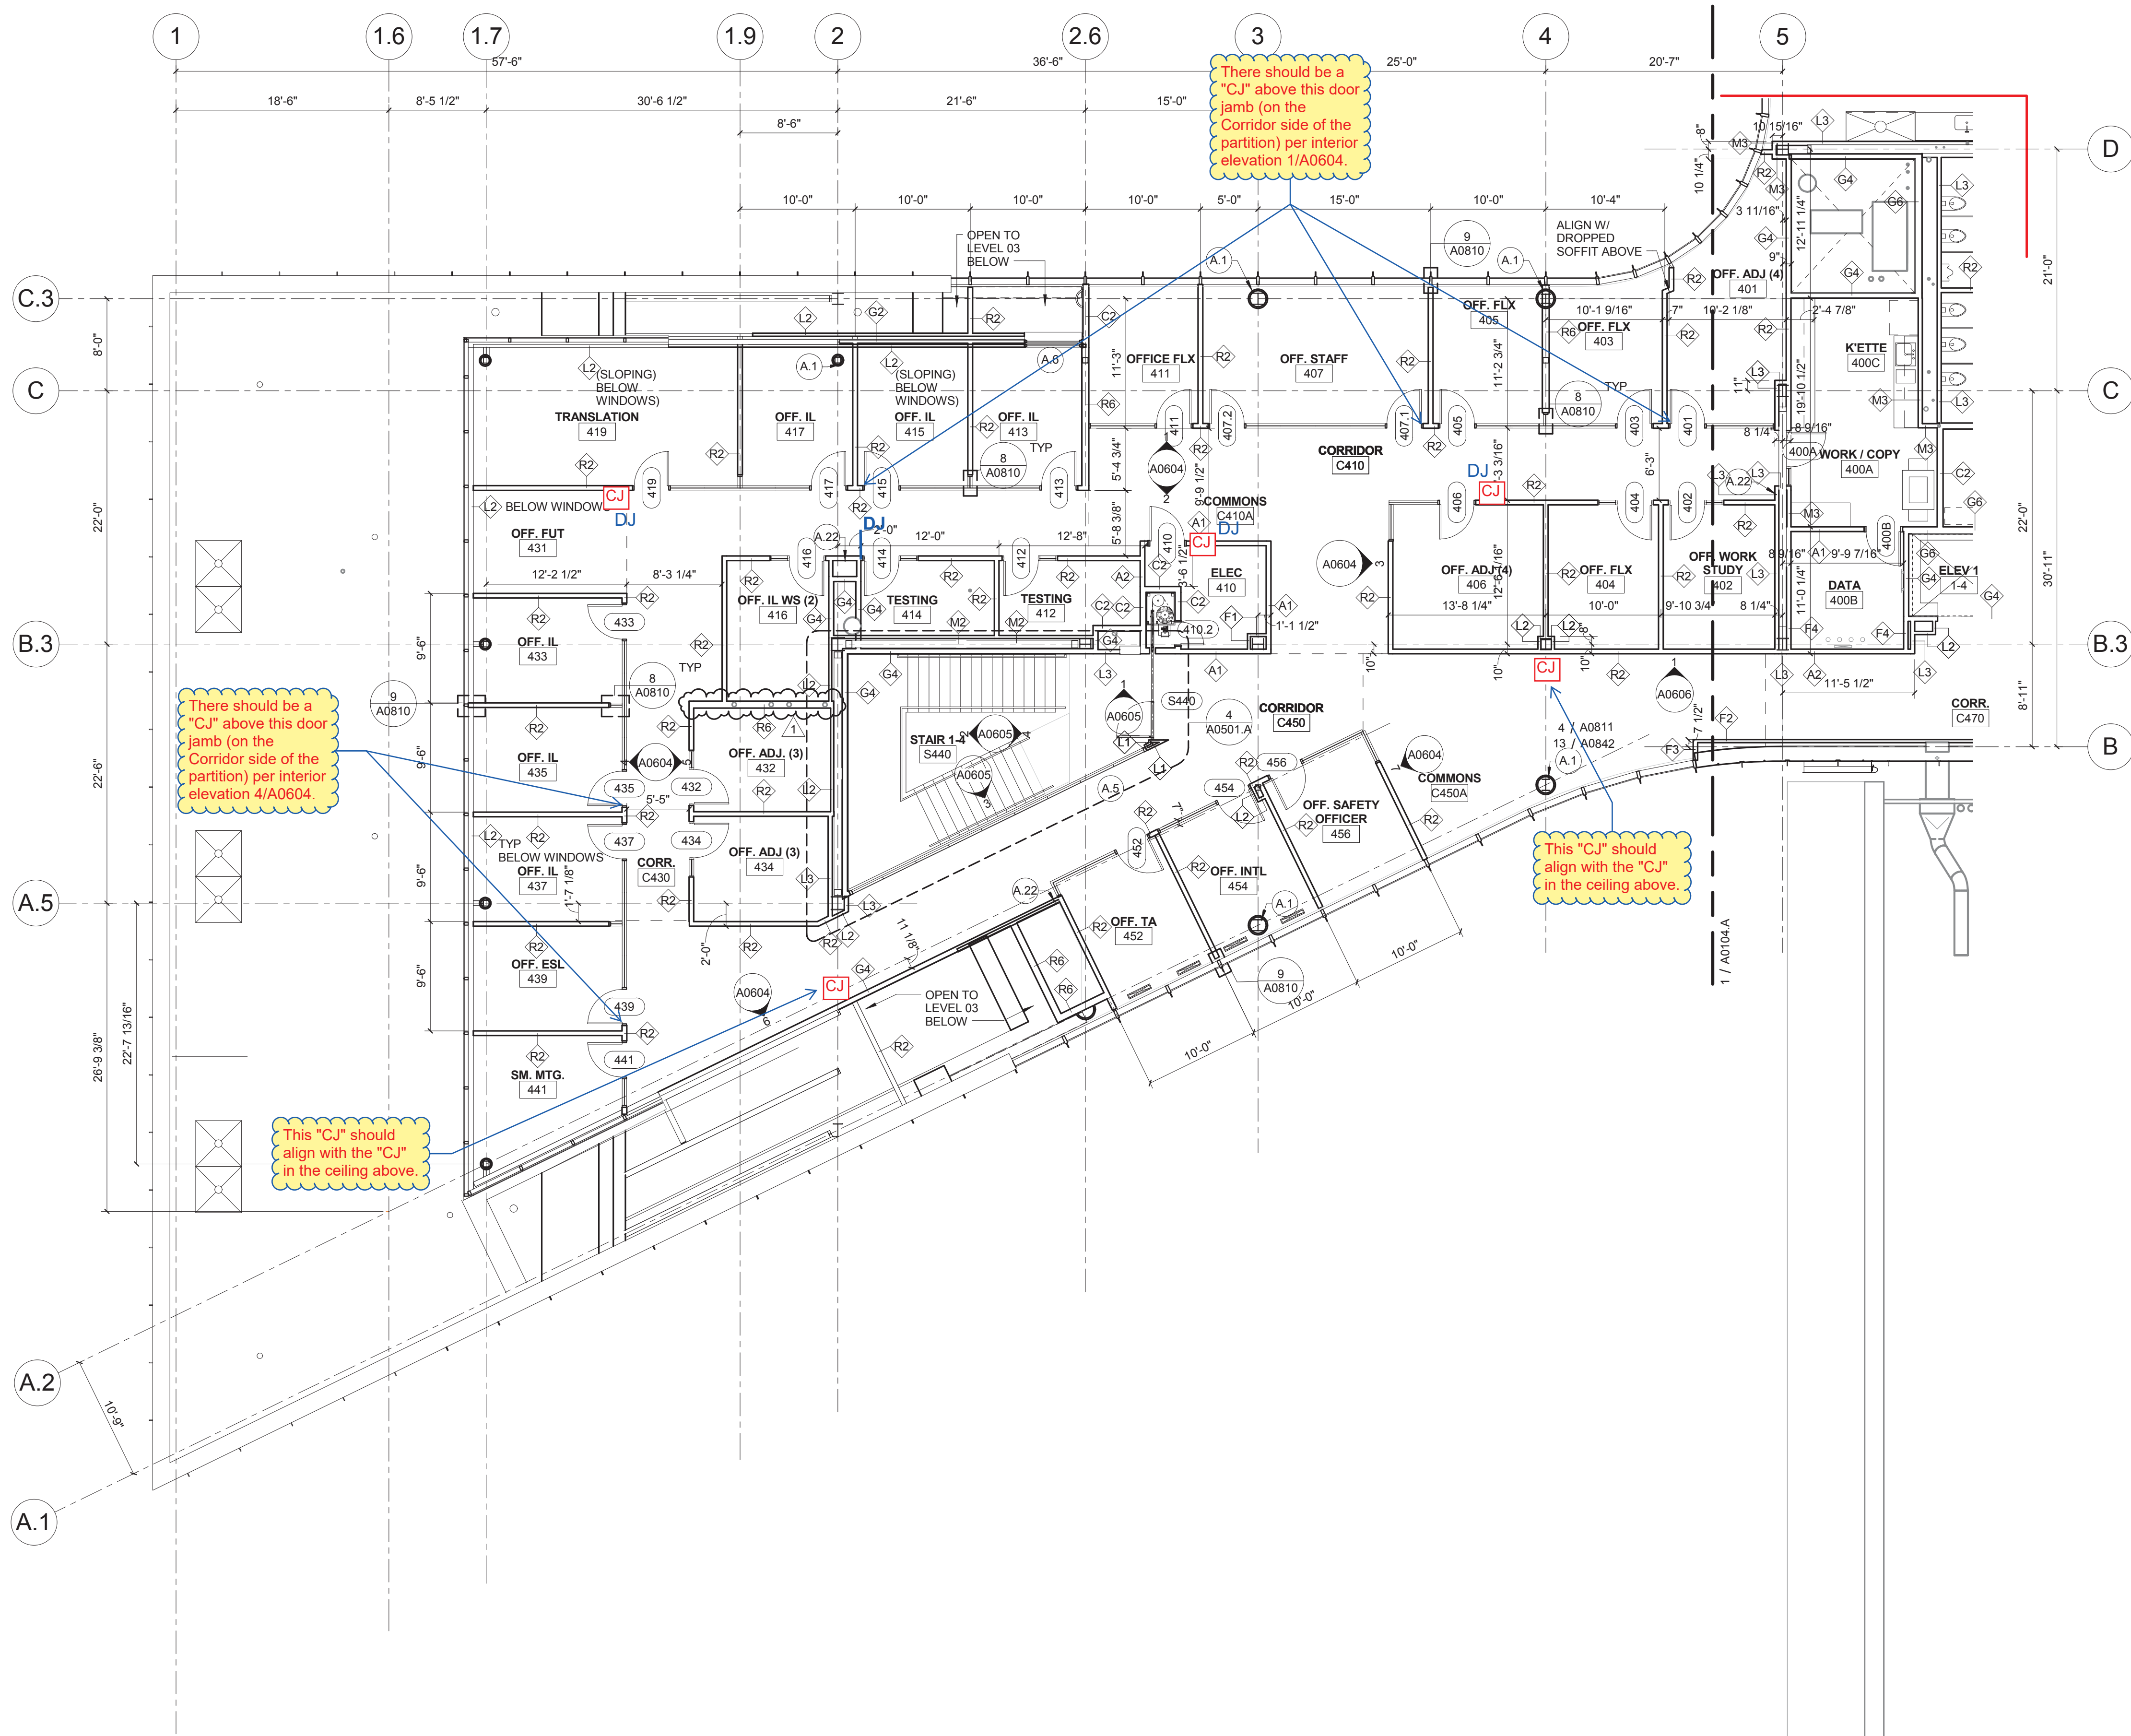

1 LEVEL 04- AREA B - WEST FLOOR PLAN
1/8" = 1'-0"


Partition Control Joint Notes:

1. All partition acoustical (stc) ratings and/or fire ratings must be maintained if a control joint is installed in them.
2. It is assumed that where ever there is a box with a "CJ" in it, that there is to be a control joint only at one side of the partition that this "CJ" box is next to. If this assumption is correct, then:
MP = Locate this control joint at the mid-point of this partition on the side of the partition that this abbreviation "MP" is located.
DJ = Locate this control joint above the door jamb on the side of the partition that this abbreviation "DJ" is located.

- KEYED NOTE LEGEND - PLAN**
- A.1 092700 GRG COLUMN COVER TO 3" ABOVE CEILING - 20" DIA. TYP. SEE DETAIL 4/A0811 AND 13/A0842.
 - A.2 081216 INTERIOR GLAZING SYSTEM: IGS-1. REFER TO TYPICAL INT. ELEVATIONS 1 AND 2 ON SHEET A0603
 - A.3 081216 INTERIOR GLAZING SYSTEM IGS-2. SEE TYPICAL ELEVATION 5 AND 6 A0603
 - A.4 081216 INTERIOR GLAZING SYSTEM: IGS-3. REFER TO INTERIOR ELEVATIONS
 - A.5 088813 FIRE RATED GLAZING- 120 MIN. FIRE RATED GLAZING 10'-0" HIGH. BASIS OF DESIGN: VETROTECH CONTRAFILAMM STRUTURA - WITH BUTT JOINTS AND PERIMETER FRAMING.
 - A.6 088813 FIRE RATED GLAZING AND FRAME- 120 MIN. FIRE RATED GLAZING 1'-8" HIGH X 5'-0" WIDE. BASIS OF DESIGN: VETROTECH CONTRAFILAMM WITH PERIMETER FRAMING.
 - A.7 111519 LOADING DOCK LIFT - STATIONARY- 6W x 8' DEEPW/ 14" PIT
 - A.8 ALTERNATING TREAD STAIRWAY UP TO ROOF HATCH
 - A.9 UNDERSLAB DRAINAGE SYSTEM PER OWNER'S GEOTECHNICAL CONSULTANT RECOMMENDATION TYPICAL ALL SLAB ON GRADE AREAS
 - A.11 NEW CONCRETE STEPS TO MATCH EXISTING REMOVED FOR CONSTRUCTION
 - A.12 553006 BRICK FACED CONCRETE DUMPSTER ENCLOSURE TOP OF WALL
 - A.13 LCD SIGNAGE SCREEN IN WALL RECESS (OFCI)
 - A.14 MARKERBOARD SURFACE
 - A.15 WOOD SCREEN W/ SOLID LUMBER
 - A.17 VIDEO WALL - 24 55" SCREENS
 - A.18 LCD SCREEN LOCATION (OFOI)
 - A.19 AIR PLENUM- INSULATED PLENUM CONSTRUCTION BY DIVISION 23
 - A.20 122200 CURTAIN LOCATION
 - A.21 104313 AED CABINET LOCATION
 - A.22 10 4413 FEC WITH FIRE EXTINGUISHER
 - A.23 08 4423 SULL SASH LOCATION: PROVIDE 1/4" TEMPERED CLEAR GLAZING AT INTERIOR FACE OF CURTAIN WALL MULLIONS FOR ACOUSTICAL SEPARATION.
 - A.24 6" X 8" FORMED CONCRETE TRENCH IN FLOOR W/ METAL PLATE COVER. PROVIDE BLIND SIDE WATERPROOFING
 - A.25 BUILT IN SALT WATER FISH TANK LOCATION. SIZE APPROX. 7'-6" X 2'-4" X 2'-6" HIGH. LOW IRON GLASS VIEW WINDOW ON CORRIDOR SIDE. SLIDING DOOR ON LAB SIDE. FISH TANK EQUIPMENT BELOW TANK W/ CABINET DOOR ACCESS ON LAB SIDE. FINISHED INTERIOR FACE OF WALLS AND CEILING INSIDE CAVITY W/ WATER RESISTANT GYP BOARD AND EPOXY PAINT.
 - A.26 LCD SIGNAGE SCREEN IN WALL RECESS (OFCI)
 - A.27 CONSTRUCT 2 HOUR RATED SEPARATION BETWEEN BOTTOM OF STAIR AND UTILITY PIPING CROSSING THIS AREA. USE HORIZ. GYP BD. ENCLOSURE ON SHEET A1002

CONFORMED SET 01 JUL 2016

1	ADDENDUM 3-2	15 APR 2016
-	ISSUED FOR CONSTRUCTION (BP3)	15 MAR 2016
No.	Description	Date

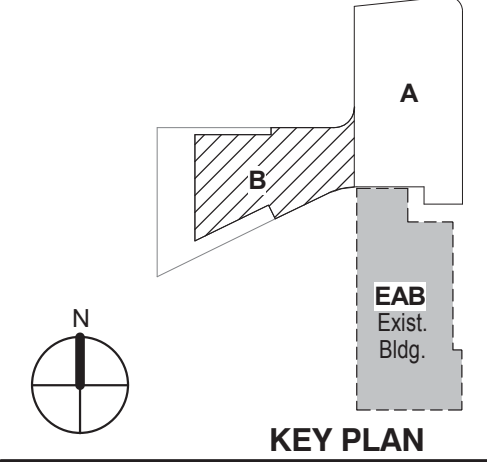

Drawing Title:

LEVEL 04 AREA B FLOOR PLAN

Project No.: 04561.01 Checked by:

A0104.B

KEYED NOTE LEGEND - REFLECTED CEILING PLAN


- C.1 122413 TYPE 1 SHADES: MOTORIZED ROLLER SHADES IN CONTINUOUS RECESSED POCKET (OFCI)
- C.2 122413 TYPE 2 SHADES: MOTORIZED DOUBLE ROLLER SHADES: SURFACE MOUNTED W/ CUSTOM COLOR FASCIA
- C.3 122413 TYPE 3 SHADES: MANUAL SHADES IN RECESSED POCKET
- C.4 122413 TYPE 4 SHADES: MULLION MOUNTED SHADE IN CONTINUOUS POCKET
- C.5 CEILING MOUNTING SUSPENSION FOR LCD SCREEN- PROVIDE STEEL SUPPORT ABOVE CEILING
- C.6 EXHAUST HOOD LOCATION - REFER TO FOOD SERVICE DRAWINGS
- C.7 FUME HOOD LOCATION - HOOD ENCLOSURE EXTENDS 6" ABOVE CEILING
- C.8 EXPOSED STRUCTURE
- C.9 083333 SIDE COILING DOOR TRACK
- C.10 ACOUSTICAL PANEL CEILING ABOVE WOOD GRILLE CEILING. 1" THICK
- C.11 ACOUSTICAL ISOLATION CEILING: 2 LAYERS 1/2" GYP BOARD CEILING ON SUSPENDED METAL FRAMING SUSPENSION SYSTEM TO BE ACOUSTICALLY ISOLATED FROM STRUCTURE BY SPRING/NEOPRENE ISOLATION HANGER - KINETIC NOISE CONTROL MODEL MUTA HANGERS. PROVIDE CONTINUOUS LAYERS OF 3/5" FIBERGLASS ACOUSTIC BATT'S. REFER TO DETAIL 16 SHEET A0842
- C.12 6" PANEL WHERE SHOWN @ 10'-6" O.C. MATCH CEILING TYPE
- C.13 RECESSED DRAPEY TRACK AND CURTAINS
- C.15 122413 TYPE 5 MOTORIZED DOUBLE ROLLER SHADE IN RECESSED POCKET.
- C.16 WOOD CEILING AT BOTTOM OF STAIRS - REFER TO STAIR 1 DRAWINGS AND DETAIL SHEET A0842
- C.17 CONTINUOUS COVE TYPE LIGHTING FIXTURE TAPED INTO GYP BOARD CEILING. REFER TO ELECTRICAL LIGHTING DRAWINGS AND TO DETAIL AT WALL SHEET A0842
- C.18 CEILING IN COLD ROOM BY COLD ROOM MFG
- C.19 G57500 MET ALUM. BEAM ENCLOSURE
- C.20 UNISTRUT MOUNTED TO CEILING W/ STEEL ANGLE HANGERS AND KICKERS ABOVE FOR SUPPORT
- C.21 STAINLESS STEEL STEAM CAPTURE HOOD ABOVE AUTOCLAVE
- C.22 REFER TO DETAIL 6/A0452
- C.23 122413 TYPE 6 SHADES: MANUAL SHADES IN RECESSED POCKET AT INTERIOR GLAZING. POCKET CONTINUOUS ACROSS OPENING
- C.24 INSULATED SOFFIT - SIMILAR TO WA-14 ON SHEET A0400
- C.25 CEILING MOUNTED SURGICAL LIGHT - SEE EQUIPMENT LIST (OFCI) - PROVIDE STRUCTURAL STEEL SUPPORT TO DECK - 4 - 2X2X 1/4" STEEL ANGLE HANGER WITH 4 - ANGLE KICKERS 2 X 2 X 1/4". AND MOUNTING PLATE PER MANUFACTURER. SEE DETAIL 01/A0814.
- C.26 CONTROL JOINT LOCATION
- C.27 ABOVE CEILING WHERE INDICATED WITH DASHED LINE: PROVIDE 2 HOUR RATED HORIZONTAL GYP BOARD ENCLOSURE AROUND DUCTS SERVING FLOOR GRILLES ON LEVEL ABOVE. REFER TO DETAIL SHEET A1002
- C.28 ABOVE CEILING WHERE INDICATED WITH DASHED LINE: PROVIDE 2 HOUR RATED HORIZONTAL GYP BOARD ENCLOSURE AROUND STANDPIPE RUN. REFER TO DETAIL SHEET A1002
- C.29 PROVIDE 2 HOUR RATED HORIZONTAL GYP BOARD ENCLOSURE AT BOTTOM OF SHAFT. REFER TO DETAIL SHEET A1002
- C.30 122413 TYPE 7 SHADES: MOTORIZED DOUBLE ROLLER SHADES: SURFACE MOUNTED W/ CUSTOM COLOR FASCIA
- C.31 122413 TYPE 8 MOTORIZED DOUBLE ROLLER SHADE IN RECESSED POCKET.
- C.32 SPECIAL ACOUSTICAL SEPARATION CEILING: APPLY KINETICS NOISE CONTROL QUIET TILE CAC-51 TO TOP SIDE OF ACOUSTICAL PANELS. ISOLATE CEILING TILE FROM STRUCTURE ABOVE WITH KNC AF HANGERS. - LEAVE 3/4" GAP ALL SIDES
- C.33 REVEAL TRIM AROUND DIAGONAL BRACE PENETRATION THROUGH CEILING
- C.34 LABORATORY OVERHEAD SERVICE CARRIER - REFER TO ENLARGED FLOOR PLANS
- C.35 EMERGENCY SAFETY SHOWER - PIPING TO HEAD ABOVE CEILING
- C.36 122413 TYPE 3 SHADES: MANUAL SHADES - STEPPED WITH SLOPE IN CONT. SLOPED OPENING

CEILING LEGEND

- APC-1 2' x 2' - ARMSTRONG OPTIMA TEGULAR 1" THICK IN 9/16" GRID
- APC-2 2' x 2' - ARMSTRONG ULTIMA TEGULAR 1" THICK IN 9/16" GRID
- APC-3A 2' x 2' - ARMSTRONG ULTIMA HEALTH ZONE IN 9/16" GRID
- APC-3B 2' x 2' - ARMSTRONG ULTIMA HEALTH ZONE TEGULAR 9/16" GRID
- APC-4 NOT USED
- APC-5 2' x 2' - ARMSTRONG FINE FISSURED IN 15/16" GRID
- APC-6 088310 ACOUSTICAL PLASTER: BASWAPHON (40 MM) OVER 1 1/2" INSULATION OVER GYP. BOARD
- APC-7 2' x 4' - ARMSTRONG ULTIMA TEGULAR IN 9/16" SILHOUETTE XL GRID W/ 6" PANEL INSERTS AS SHOWN
- APC-8 2' x 6' ARMSTRONG OPTIMA TEGULAR - 1" THICK, NRC - .90, IN 9/16" SILHOUETTE XL 1/8" GRID MATCH APC-7 - EXCEPT, REF. 085113- SPECIAL ACOUSTIC TREATMENT: APPLY SPECIAL ACOUSTIC MATERIAL TO TOP SIDE OF PANELS AND PROVIDE ISOLATORS FOR CEILING HANGERS:

- WDC-1 09 5426 WOOD GRILLE CEILING W/ 3/4" x 2 1/4" MEMBERS - 6 PER FOOT - NINEWOOD GRILL 1400 W/ 1" THICK ARMSTRONG OPTIMA PANELS FIT TO GRID SUPPORT ABOVE
- WDC-2 06 4216 FLUSH WOOD PANEL SOFFIT - MATCH WVP-1
- WDC-3 06 4216 OPAQUE WOOD PANEL TO MATCH WOOD ACOUST WALL PANEL

- GWB-1 PAINTED GYP. BOARD
- GWB-2 GYP. BOARD W/ COATING TO MATCH ADJACENT ACOUST. PLASTER

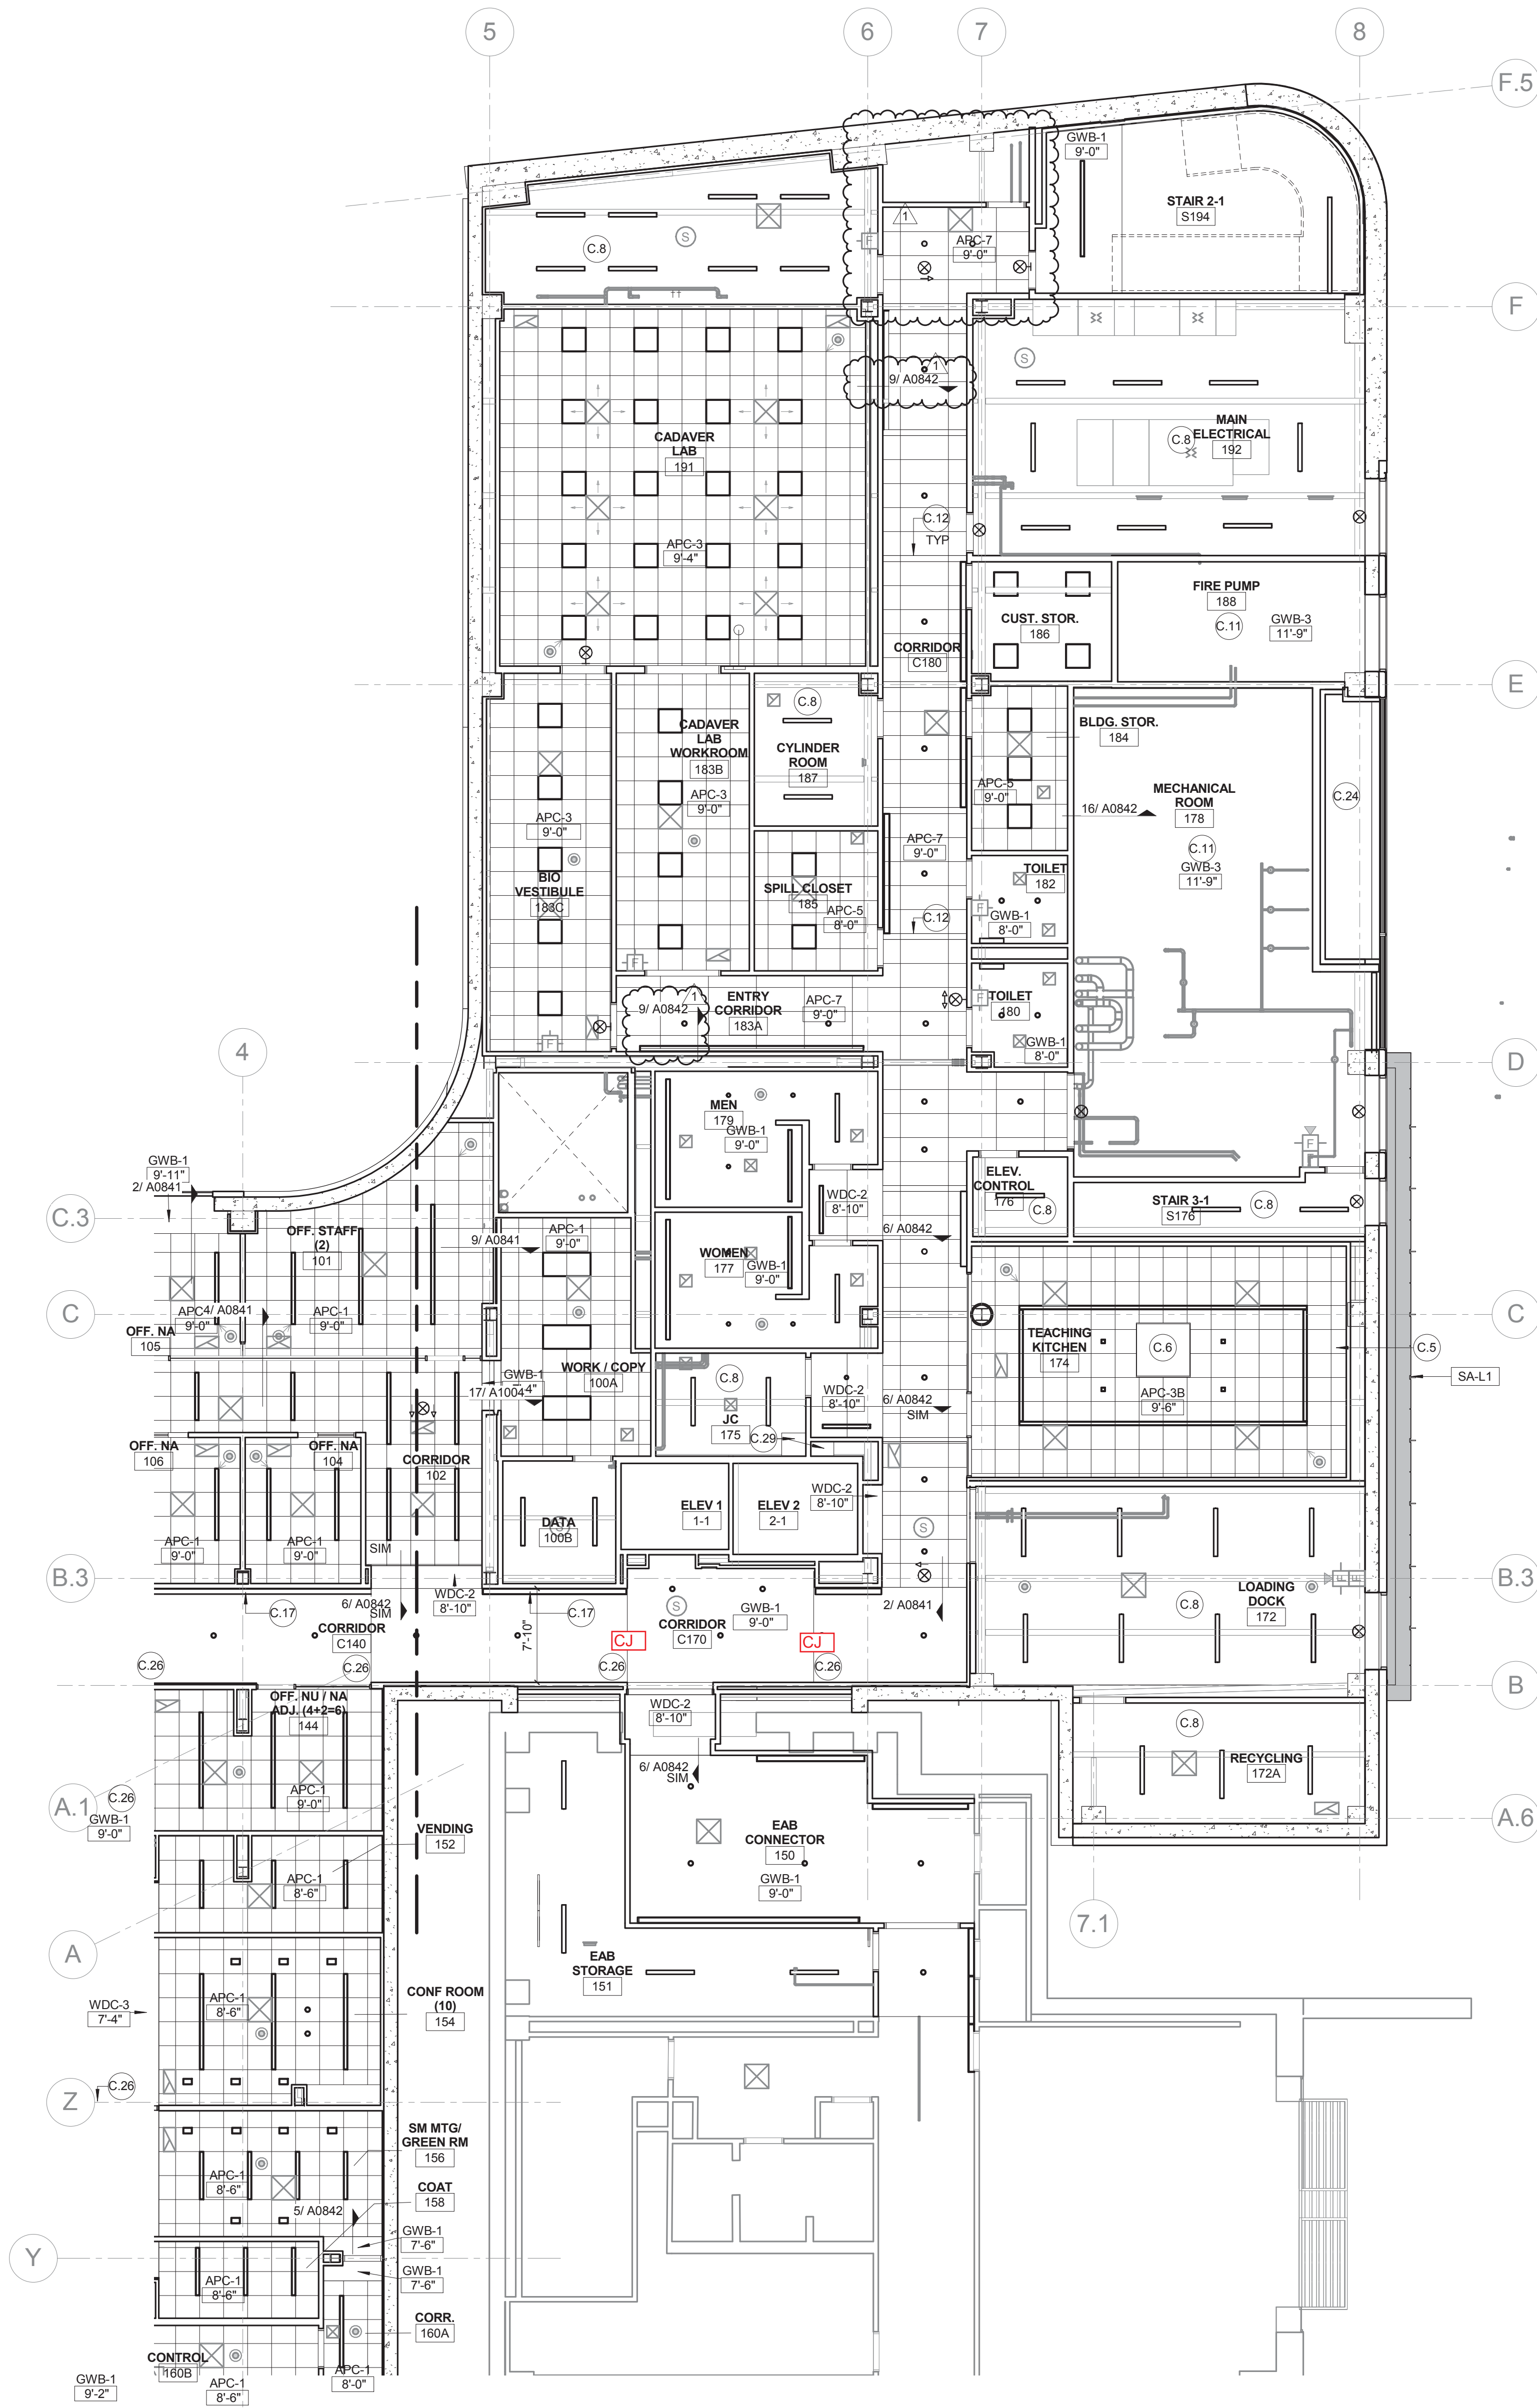


1 LEVEL 01 REFLECTED CEILING PLAN - AREA A

1/8" = 1'-0"

CONFORMED SET

01 JUL 2016

1 ADDENDUM 3-2		15 APR 2016
ISSUED FOR CONSTRUCTION (BP3)		15 MAR 2016
No.	Description	Date

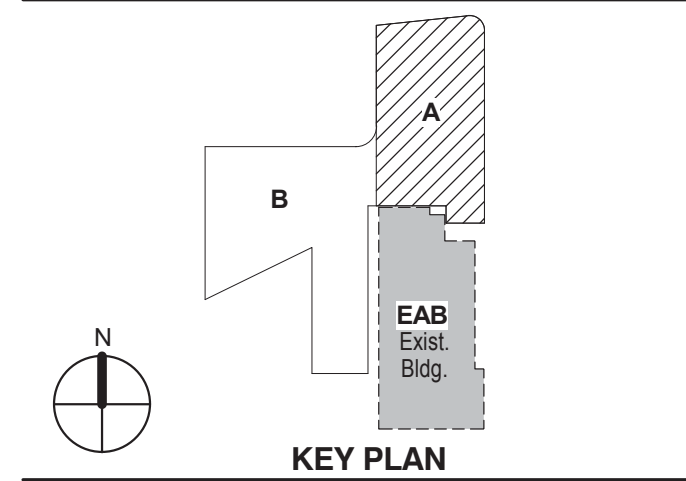

Drawing Title:

LEVEL 01 REFLECTED
CEILING PLAN AREA A


Project No.: 04561.01

Checked by:

A0701.A

CONFORMED SET 01 JUL 2016

1 ADDENDUM 3-2 15 APR 2016
ISSUED FOR CONSTRUCTION (BPS) 15 MAR 2016
No. Description Date

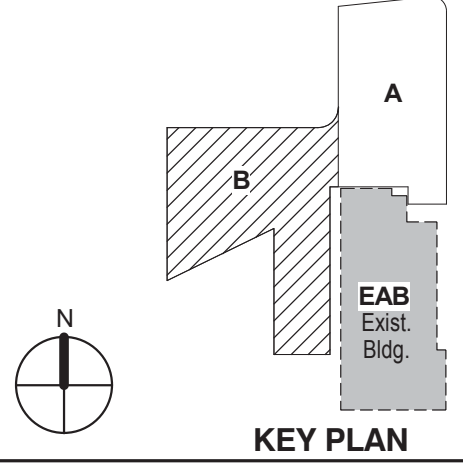


KEY PLAN

LEVEL 01 REFLECTED
CEILING PLAN AREA B

Project No.: 04561.01 Checked by:

A0701.B

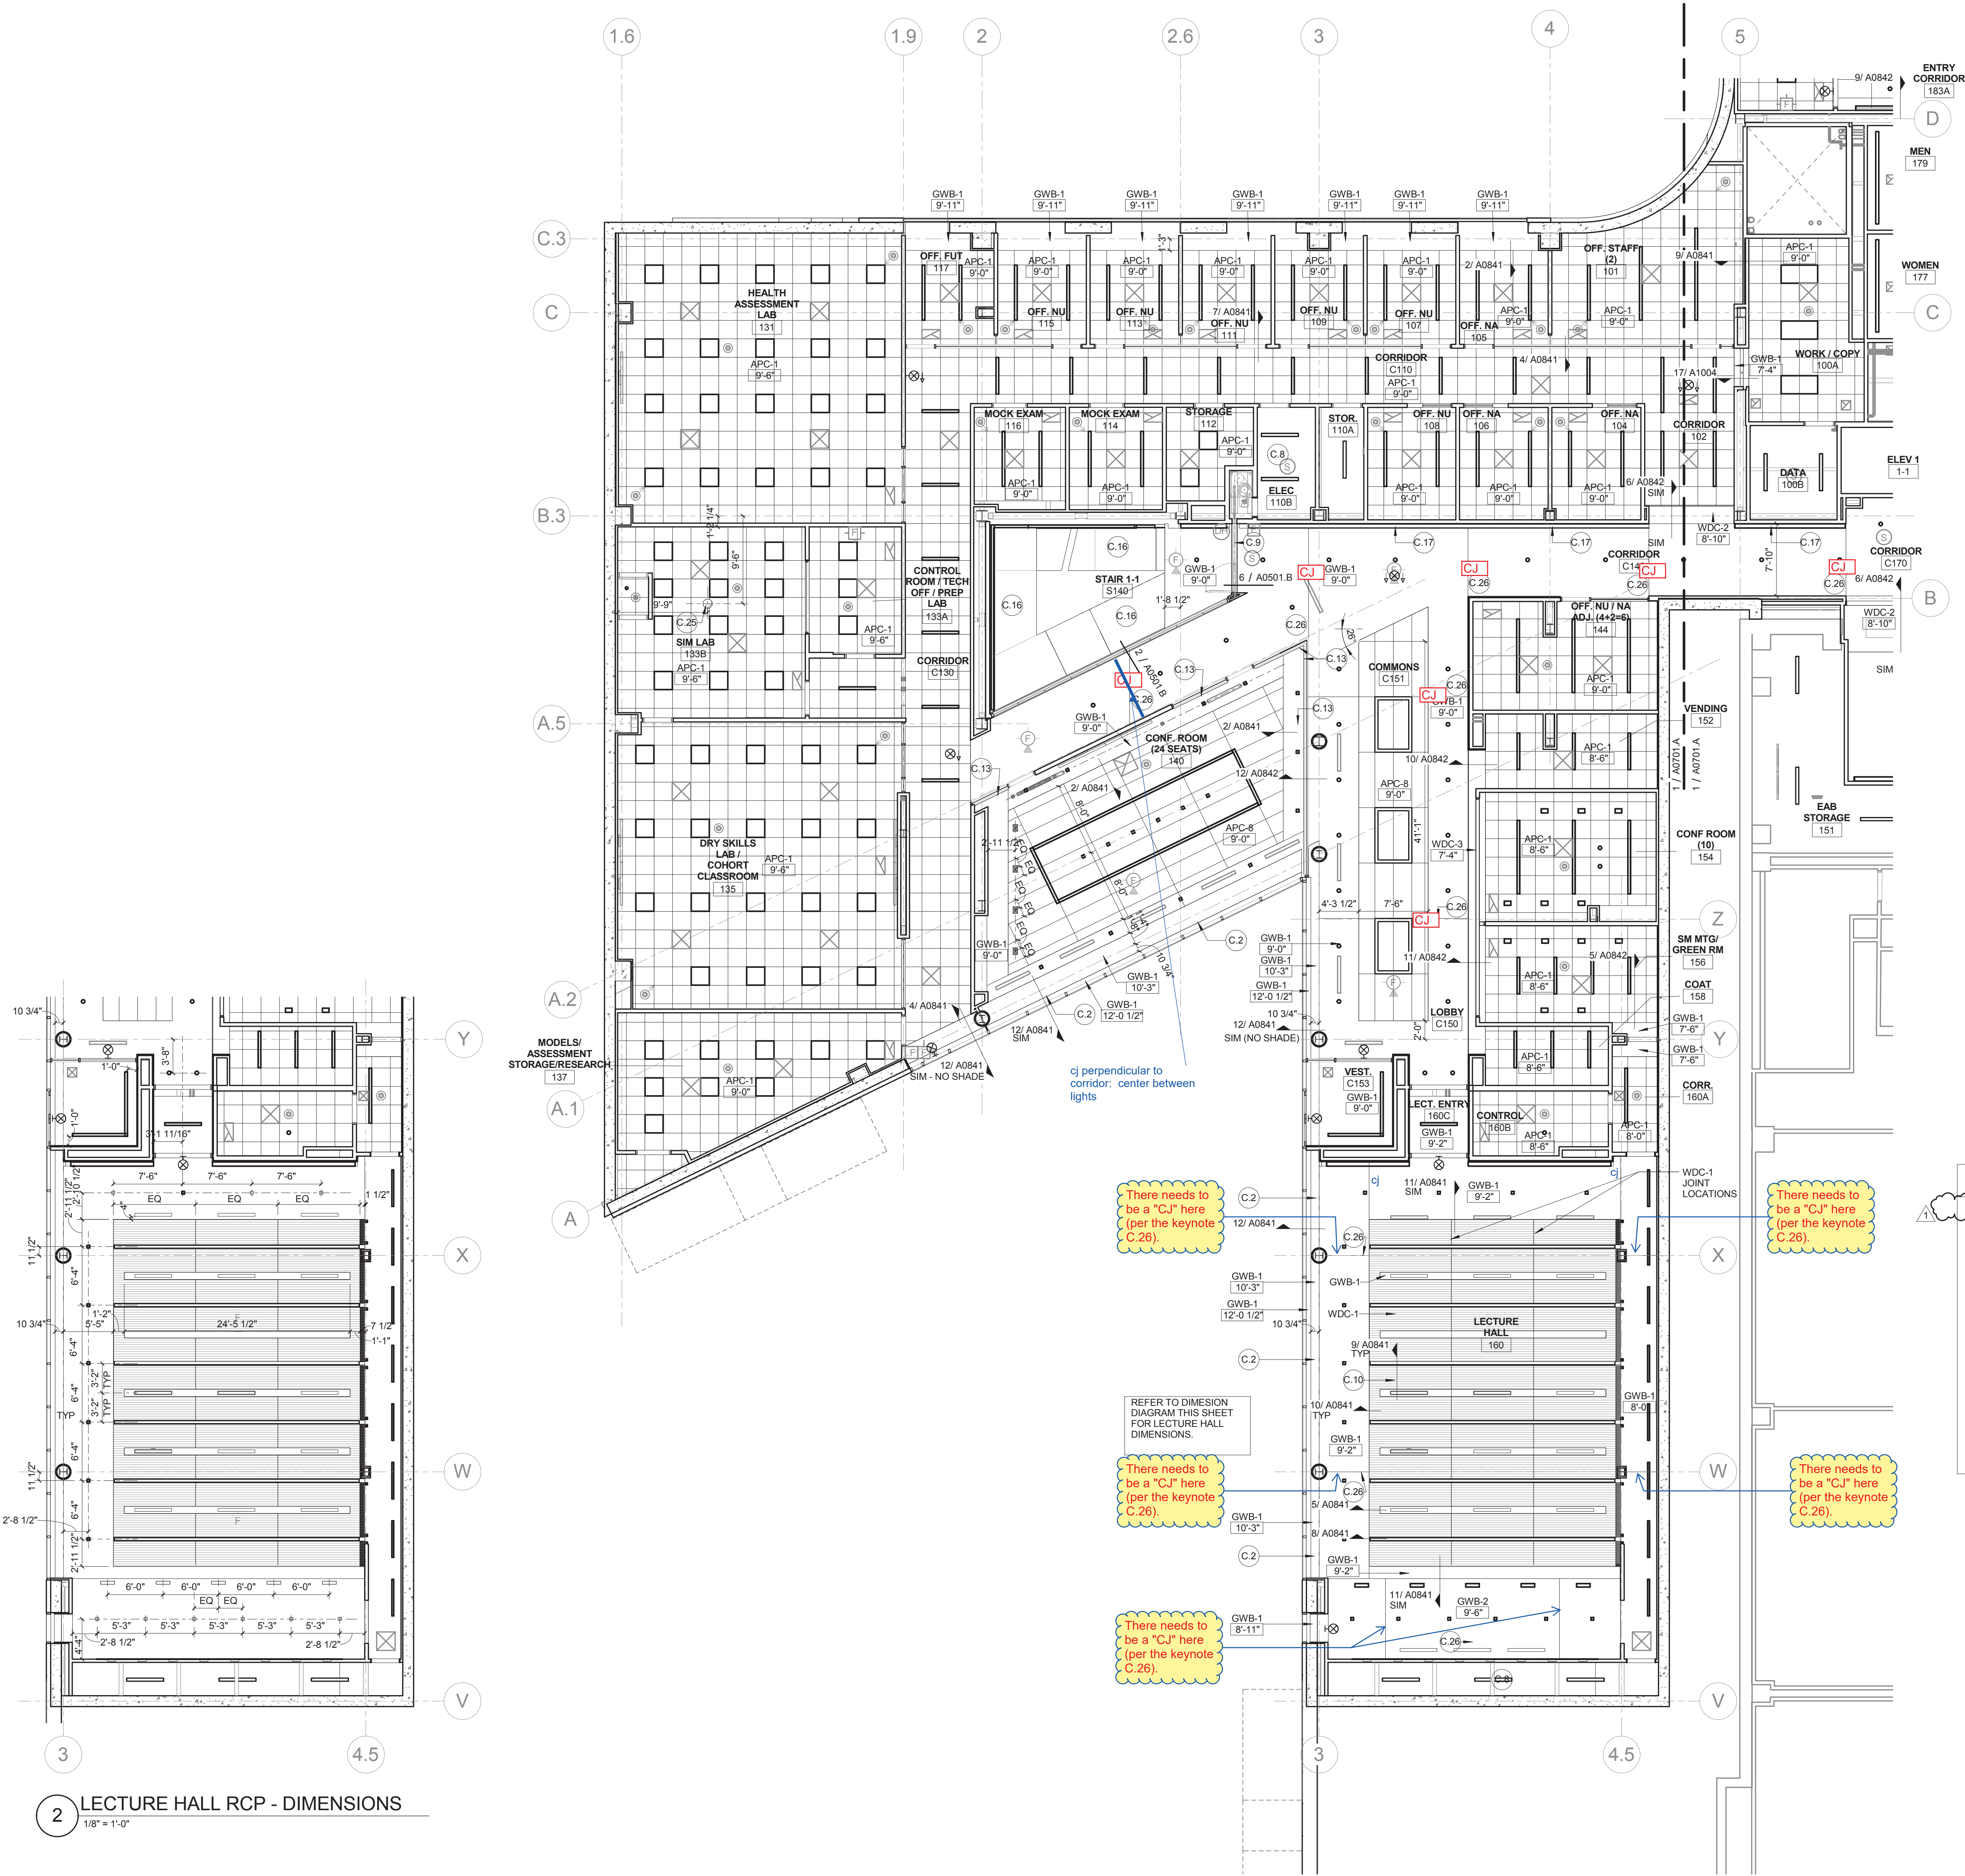


2 LECTURE HALL RCP - DIMENSIONS

1/8" = 1'-0"

1 LEVEL 01 REFLECTED CEILING PLAN - AREA B

1/8" = 1'-0"

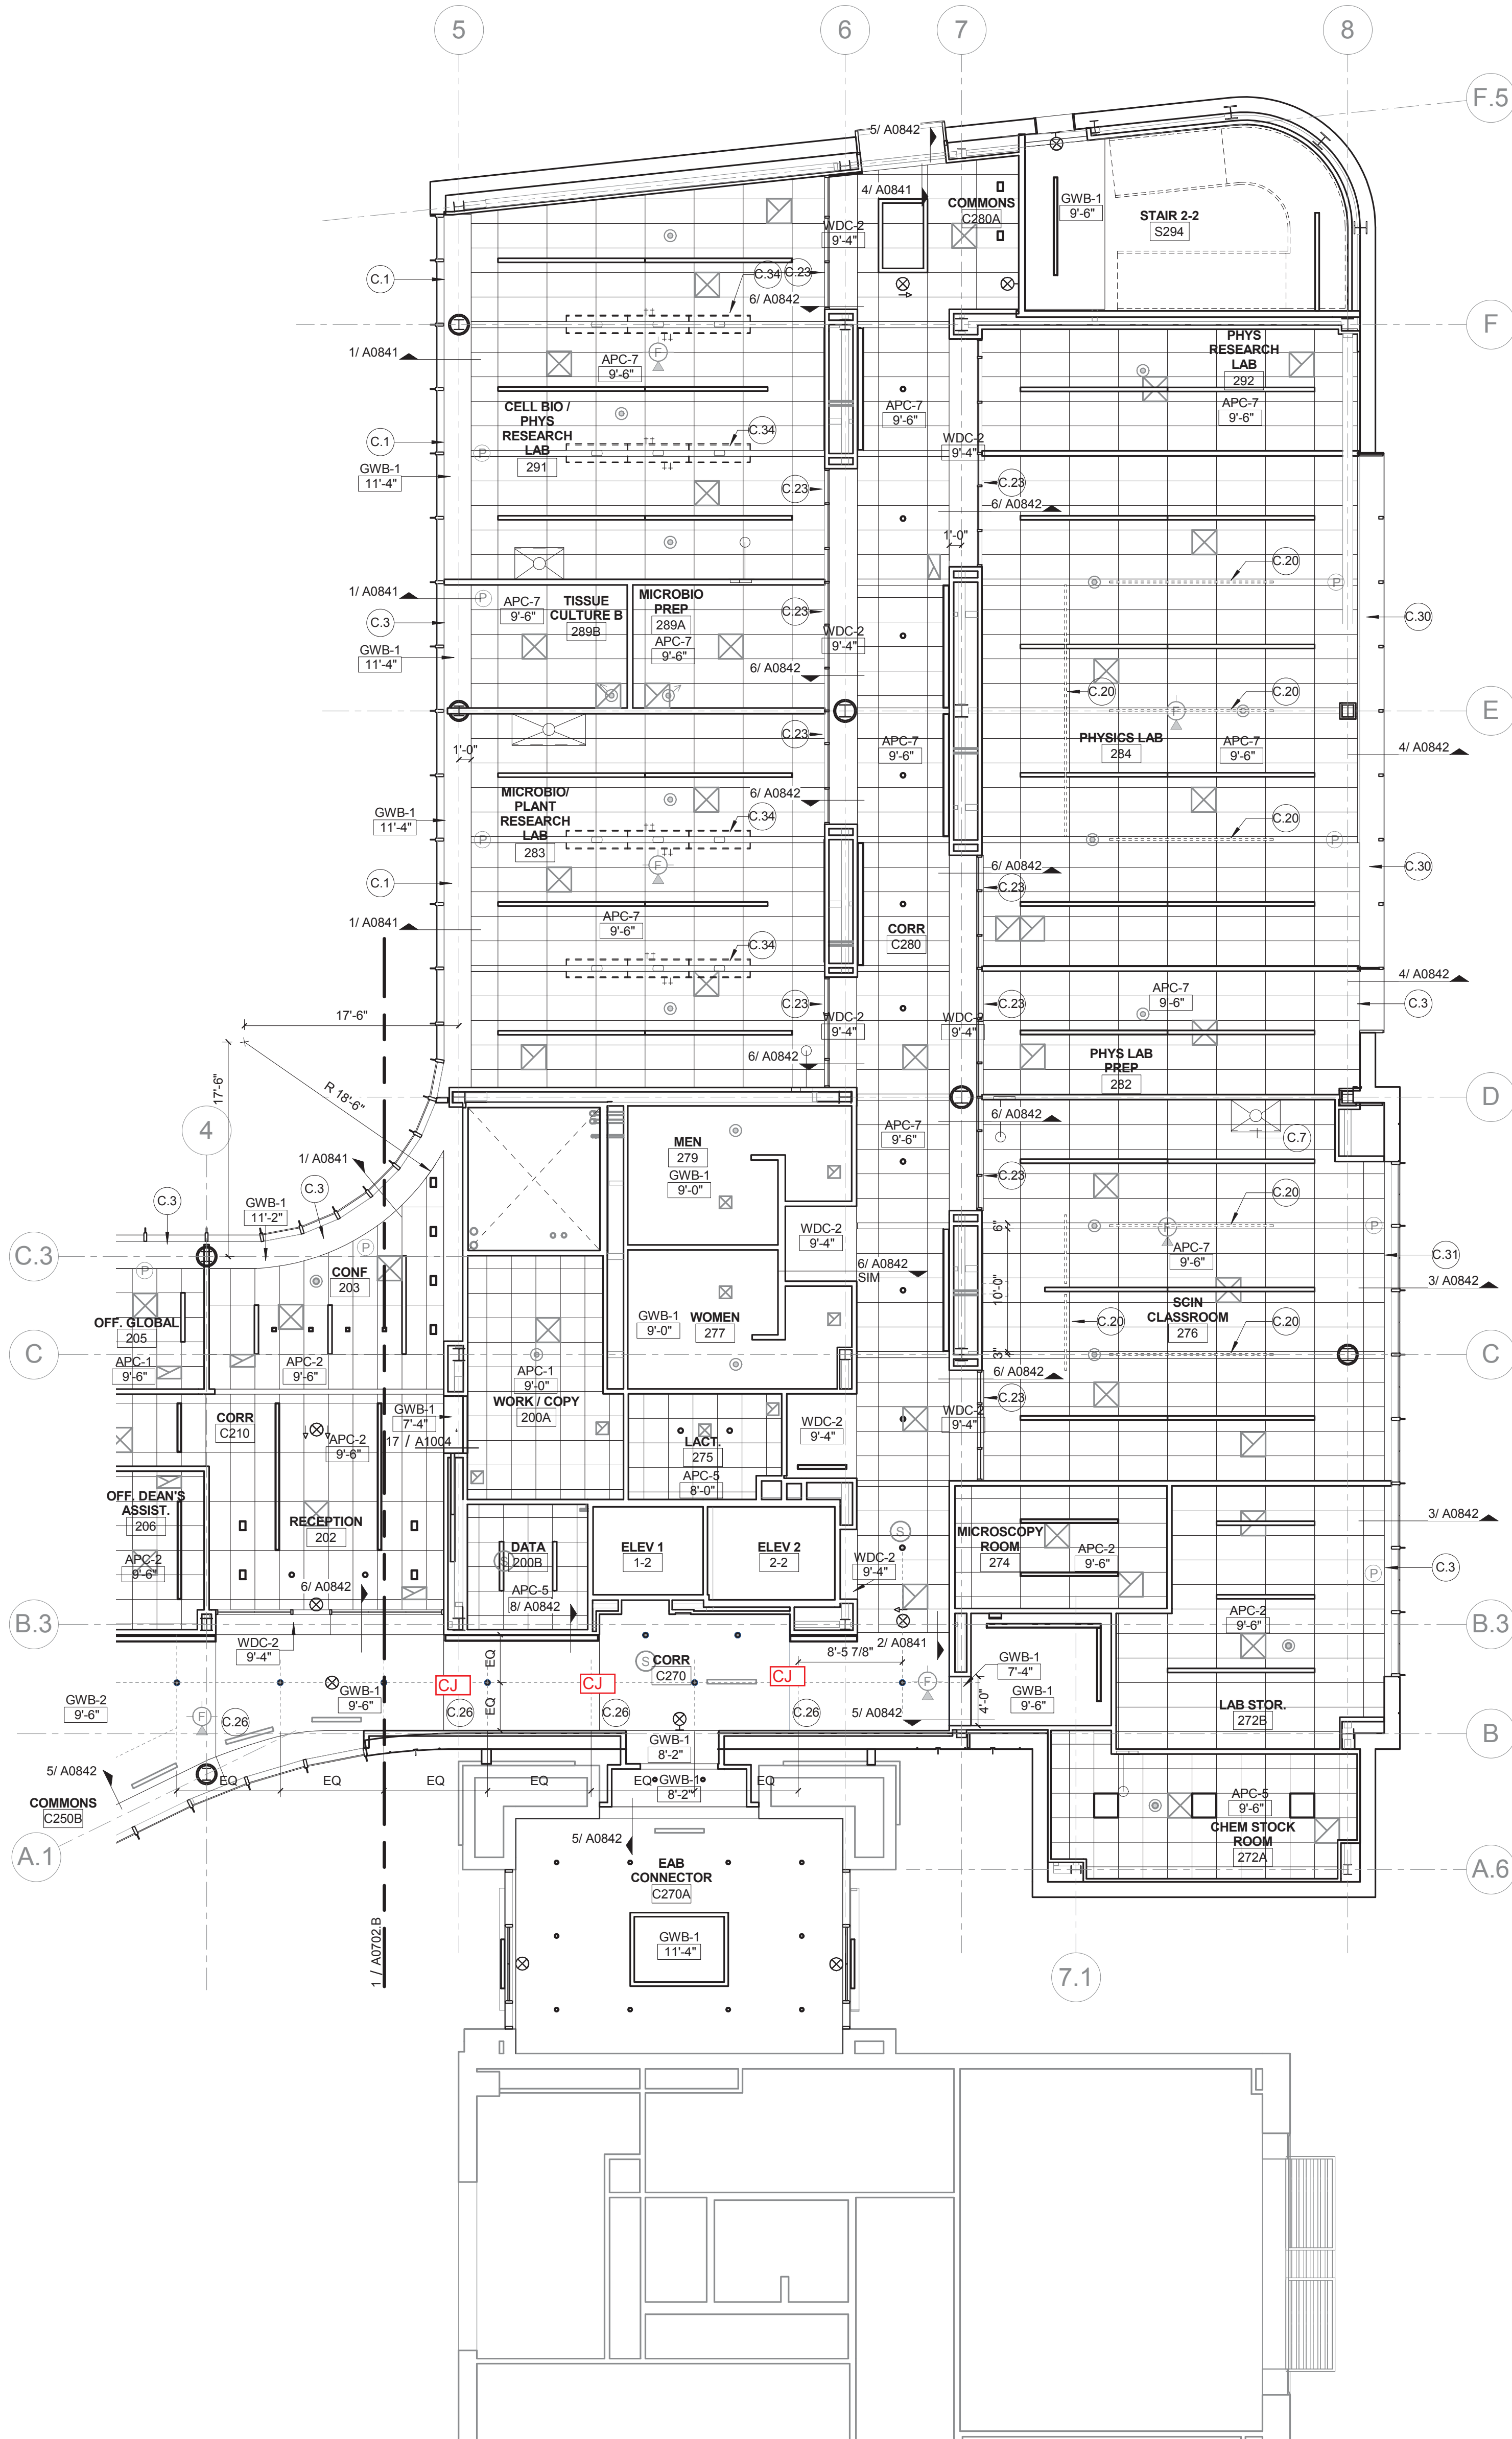

1 LEVEL 02 REFLECTED CEILING PLAN - AREA A
1/8" = 1'-0"

KEYED NOTE LEGEND - REFLECTED CEILING PLAN


- C.1 122413 TYPE 1 SHADES: MOTORIZED ROLLER SHADES IN CONTINUOUS RECESSED POCKET (OFCI)
- C.2 122413 TYPE 2 SHADES: MOTORIZED DOUBLE ROLLER SHADES: SURFACE MOUNTED W/ CUSTOM COLOR FASCIA
- C.3 122413 TYPE 3 SHADES: MANUAL SHADES IN RECESSED POCKET
- C.4 122413 TYPE 4 SHADES: MULLION MOUNTED SHADE IN CONTINUOUS POCKET
- C.5 CEILING MOUNTING SUSPENSION FOR LCD SCREEN- PROVIDE STEEL SUPPORT ABOVE CEILING
- C.6 EXHAUST HOOD LOCATION - REFER TO FOOD SERVICE DRAWINGS
- C.7 FUME HOOD LOCATION - HOOD ENCLOSURE EXTENDS 6" ABOVE CEILING
- C.8 EXPOSED STRUCTURE
- C.9 083333 SIDE COILING DOOR TRACK
- C.10 ACOUSTICAL PANEL CEILING ABOVE WOOD GRILLE CEILING. 1" THICK
- C.11 ACOUSTICAL ISOLATION CEILING: 2 LAYERS 1/2" GYP BOARD CEILING ON SUSPENDED METAL FRAMING SUSPENSION SYSTEM TO BE ACOUSTICALLY ISOLATED FROM STRUCTURE BY SPRING/NEOPRENE ISOLATION HANGER - KINETIC NOISE CONTROL MODEL MUTA HANGERS. PROVIDE CONTINUOUS LAYERS OF 3/5" FIBERGLASS ACOUSTIC BATT'S. REFER TO DETAIL 16 SHEET A0842
- C.12 6" PANEL WHERE SHOWN @ 10'-6" O.C. MATCH CEILING TYPE
- C.13 RECESSED DRAPEY TRACK AND CURTAINS
- C.15 122413 TYPE 5 MOTORIZED DOUBLE ROLLER SHADE IN RECESSED POCKET.
- C.16 WOOD CEILING AT BOTTOM OF STAIRS - REFER TO STAIR 1 DRAWINGS AND DETAIL SHEET A0842
- C.17 CONTINUOUS COVE TYPE LIGHTING FIXTURE TAPED INTO GYP BOARD CEILING. REFER TO ELECTRICAL LIGHTING DRAWINGS AND TO DETAIL AT WALL SHEET A0842
- C.18 CEILING IN COLD ROOM BY COLD ROOM MFG
- C.19 G57500 MET ALUM. BEAM ENCLOSURE
- C.20 UNISTRUT MOUNTED TO CEILING W/ STEEL ANGLE HANGERS AND KICKERS ABOVE FOR SUPPORT
- C.21 STAINLESS STEEL STEAM CAPTURE HOOD ABOVE AUTOCLAVE
- C.22 REFER TO DETAIL 6/A0452
- C.23 122413 TYPE 6 SHADES: MANUAL SHADES IN RECESSED POCKET AT INTERIOR GLAZING. POCKET CONTINUOUS ACROSS OPENING
- C.24 INSULATED SOFFIT - SIMILAR TO WA-L4 ON SHEET A0400
- C.25 CEILING MOUNTED SURGICAL LIGHT - SEE EQUIPMENT LIST (OFCI) - PROVIDE STRUCTURAL STEEL SUPPORT TO DECK - 4 - 2X2X 1/4" STEEL ANGLE HANGER WITH 4 - ANGLE KICKERS 2 X 2 X 1/4" AND MOUNTING PLATE PER MANUFACTURER. SEE DETAIL 01/A0814.
- C.26 CONTROL JOINT LOCATION
- C.27 ABOVE CEILING WHERE INDICATED WITH DASHED LINE: PROVIDE 2 HOUR RATED HORIZONTAL GYP BOARD ENCLOSURE AROUND DUCTS SERVING FLOOR GRILLES ON LEVEL ABOVE. REFER TO DETAIL SHEET A1002
- C.28 ABOVE CEILING WHERE INDICATED WITH DASHED LINE: PROVIDE 2 HOUR RATED HORIZONTAL GYP BOARD ENCLOSURE AROUND STANDPIPE RUN. REFER TO DETAIL SHEET A1002
- C.29 PROVIDE 2 HOUR RATED HORIZONTAL GYP BOARD ENCLOSURE AT BOTTOM OF SHAFT. REFER TO DETAIL SHEET A1002
- C.30 122413 TYPE 7 SHADES: MOTORIZED DOUBLE ROLLER SHADES: SURFACE MOUNTED W/ CUSTOM COLOR FASCIA
- C.31 122413 TYPE 8 MOTORIZED DOUBLE ROLLER SHADE IN RECESSED POCKET. SPECIAL ACOUSTICAL SEPARATION CEILING: APPLY KINETICS NOISE CONTROL QUIET TILE CAC-51 TO TOP SIDE OF ACOUSTICAL PANELS. ISOLATE CEILING TILE FROM STRUCTURE ABOVE WITH KNC AF HANGERS. REVEAL TRIM AROUND DIAGONAL BRACE PENETRATION THROUGH CEILING - LEAVE 3/4" GAP ALL SIDES
- C.33 LABORATORY OVERHEAD SERVICE CARRIER - REFER TO ENLARGED FLOOR PLANS
- C.34 EMERGENCY SAFETY SHOWER - PIPING TO HEAD ABOVE CEILING
- C.35 122413 TYPE 3 SHADES: MANUAL SHADES - STEPPED WITH SLOPE IN CONT. SLOPED OPENING

CEILING LEGEND

- WDC-1 09 5426 WOOD GRILLE CEILING W/ 3/4" X 2 1/4" MEMBERS - 6 PER FOOT - NINEWOOD GRILL 1400 W/ 1" THICK ARMSTRONG OPTIMA PANELS FIT TO GRID SUPPORT ABOVE
- WDC-2 06 4216 FLUSH WOOD PANEL SOFFIT - MATCH WVP-1
- WDC-3 06 4216 OPAQUE WOOD PANEL TO MATCH WOOD ACOUST WALL PANEL
- GWB-1 PAINTED GYP. BOARD
- GWB-2 GYP. BOARD W/ COATING TO MATCH ADJACENT ACOUST. PLASTER
- APC-1 2' x 2' - ARMSTRONG OPTIMA REGULAR 1" THICK N10 GRID
- APC-2 2' x 4' - ARMSTRONG ULTIMA REGULAR IN 9/16" SILHOUETTE XL 1/8" GRID
- APC-3 2' x 2' - ARMSTRONG ULTIMA HEALTH ZONE REGULAR 9/16" GRID
- APC-4 NOT USED
- APC-5 2' x 2' - ARMSTRONG FINE FISURED IN 15/16" GRID
- APC-6 08510 ACOUSTICAL PLASTER: BASWAPHON (40 MM) OVER 1 1/2" INSULATION OVER GYP. BOARD
- APC-7 2' x 4' - ARMSTRONG ULTIMA REGULAR IN 9/16" SILHOUETTE XL GRID W/ 6" PANEL INSERTS AS SHOWN
- APC-8 2' x 6' ARMSTRONG OPTIMA REGULAR - 1" THICK, NRC - .90, IN 9/16" SILHOUETTE XL 1/8" GRID MATCH APC-7 - EXCEPT REF. 095113- SPECIAL ACOUSTIC TREATMENT: APPLY SPECIAL ACOUSTIC MATERIAL TO TOP SIDE OF PANELS AND PROVIDE ISOLATORS FOR CEILING HANGERS:

CONFORMED SET 01 JUL 2016

No.	Description	Date
1	ADDENDUM 3-2	15 APR 2016
2	ISSUED FOR CONSTRUCTION (BP3)	15 MAR 2016

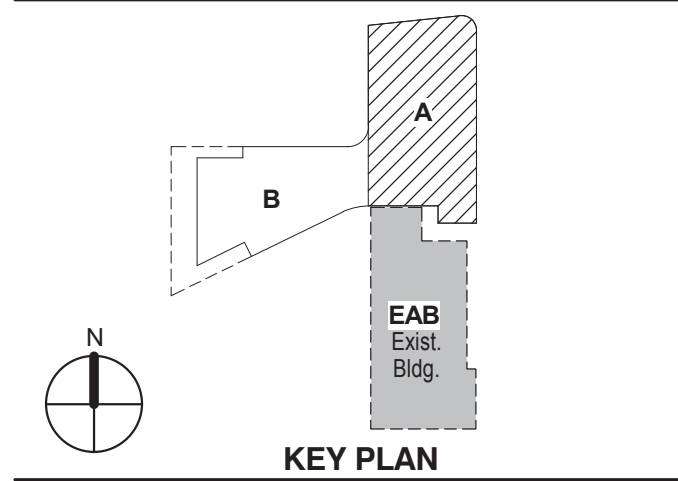



LEVEL 02 REFLECTED CEILING PLAN AREA A

Project No.: 04561.01 Checked by:

A0702.A

CONFORMED SET 01 JUL 2016

1 ADDENDUM 3-2 15 APR 2016
ISSUED FOR CONSTRUCTION (BP3) 15 MAR 2016
No. Description Date

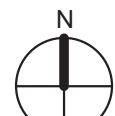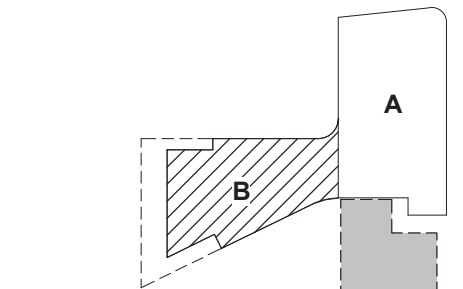


KEY PLAN

LEVEL 02 REFLECTED
CEILING PLAN AREA B

Project No.: 04561.01 Checked by:

A0702.B

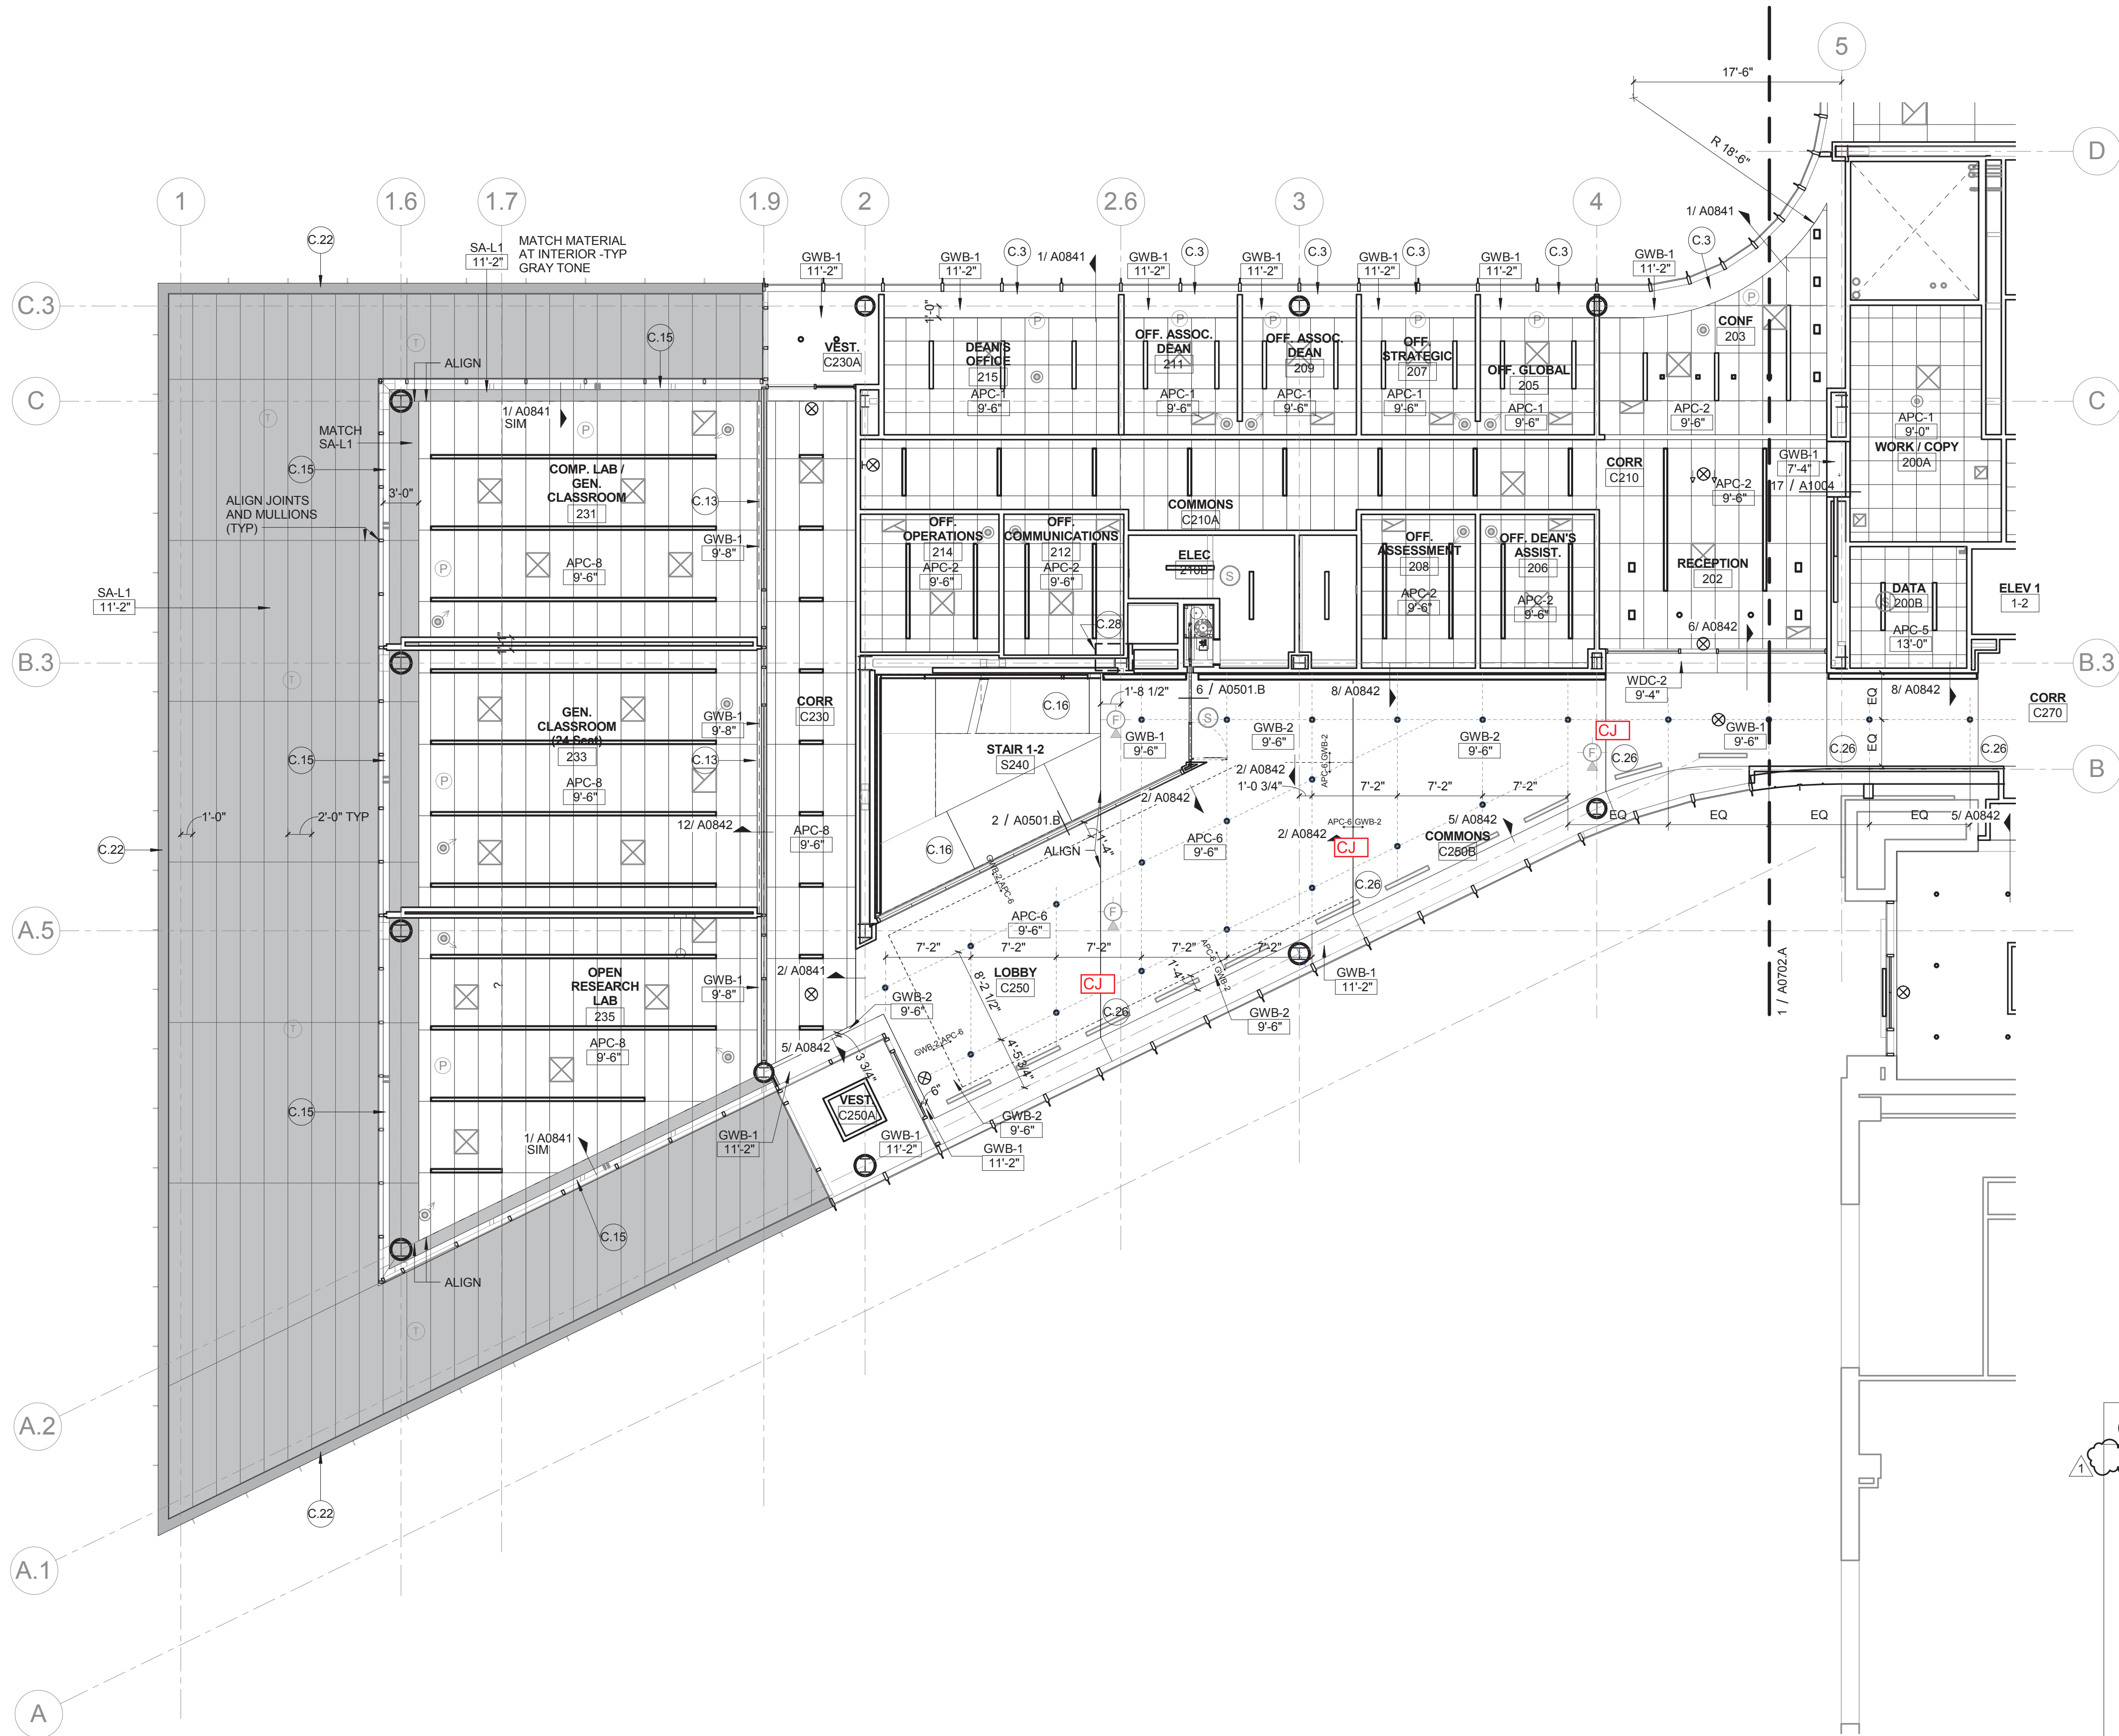

KEYED NOTE LEGEND - REFLECTED CEILING PLAN

- C.1 122413 TYPE 1 SHADES: MOTORIZED ROLLER SHADES IN CONTINUOUS RECESSED POCKET (OFCI)
- C.2 122413 TYPE 2 SHADES MOTORIZED DOUBLE ROLLER SHADES: SURFACE MOUNTED W/ CUSTOM COLOR FASCIA
- C.3 122413 TYPE 3 SHADES: MANUAL SHADES IN RECESSED POCKET
- C.4 122413 TYPE 4 SHADES: MULLION MOUNTED SHADE IN CONTINUOUS POCKET
- C.5 CEILING MOUNTING SUSPENSION FOR LCD SCREEN- PROVIDE STEEL SUPPORT ABOVE CEILING
- C.6 EXHAUST HOOD LOCATION - REFER TO FOOD SERVICE DRAWINGS
- C.7 FUME HOOD LOCATION - HOOD ENCLOSURE EXTENDS 6" ABOVE CEILING
- C.8 EXPOSED STRUCTURE
- C.9 083333 SIDE COILING DOOR TRACK
- C.10 ACOUSTICAL PANEL CEILING ABOVE WOOD GRILLE CEILING. 1" THICK
- C.11 ACOUSTICAL ISOLATION CEILING: 2 LAYERS 1/2" GYP BOARD CEILING ON SUSPENDED METAL FRAMING SUSPENSION SYSTEM TO BE ACOUSTICALLY ISOLATED FROM STRUCTURE BY SPRING/NEOPRENE ISOLATION HANGER - KINETIC NOISE CONTROL MODEL MUTA HANGERS. PROVIDE CONTINUOUS LAYERS OF 3/5" FIBERGLASS ACOUSTIC BATT'S. REFER TO DETAIL 16 SHEET A0842
- C.12 6" PANEL WHERE SHOWN @ 10'-6" O.C. MATCH CEILING TYPE
- C.13 RECESSED DRAPEY TRACK AND CURTAINS
- C.15 122413 TYPE 5 MOTORIZED DOUBLE ROLLER SHADE IN RECESSED POCKET.
- C.16 WOOD CEILING AT BOTTOM OF STAIRS - REFER TO STAIR 1 DRAWINGS AND DETAILS FIRST AND
- C.17 CONTINUOUS Cove TYPE LIGHTING FIXTURE TAPED INTO GYP BOARD CEILING. REFER TO ELECTRICAL LIGHTING DRAWINGS AND TO DETAIL AT WALL SHEET A0842
- C.18 CEILING IN COLD ROOM BY COLD ROOM MFG
- C.19 G57500 MET ALUM. BEAM ENCLOSURE
- C.20 UNISTRUT MOUNTED TO CEILING W/ STEEL ANGLE HANGERS AND KICKERS ABOVE FOR SUPPORT
- C.21 STAINLESS STEEL STEAM CAPTURE HOOD ABOVE AUTOCLAVE
- C.22 REFER TO DETAIL 6/A0452
- C.23 122413 TYPE 6 SHADES: MANUAL SHADES IN RECESSED POCKET AT INTERIOR GLAZING. POCKET CONTINUOUS ACROSS OPENING
- C.24 INSULATED SOFFIT - SIMILAR TO WA-14 ON SHEET A0400
- C.25 CEILING MOUNTED SURGICAL LIGHT - SEE EQUIPMENT LIST (OFCI) - PROVIDE STRUCTURAL STEEL SUPPORT TO DECK - 4 - 2X2X 1/4" STEEL ANGLE HANGER WITH 4 - ANGLE KICKERS 2 X 2 X 1/4" AND MOUNTING PLATE PER MANUFACTURER. SEE DETAIL 01/A0814
- C.26 CONTROL JOINT LOCATION
- C.27 ABOVE CEILING WHERE INDICATED WITH DASHED LINE: PROVIDE 2 HOUR RATED HORIZONTAL GYP BOARD ENCLOSURE AROUND DUCTS SERVING FLOOR GRILLES ON LEVEL ABOVE. REFER TO DETAIL SHEET A1002
- C.28 ABOVE CEILING WHERE INDICATED WITH DASHED LINE: PROVIDE 2 HOUR RATED HORIZONTAL GYP BOARD ENCLOSURE AROUND STANDPIPE RUN. REFER TO DETAIL SHEET A1002
- C.29 PROVIDE 2 HOUR RATED HORIZONTAL GYP BOARD ENCLOSURE AT BOTTOM OF SHAFT. REFER TO DETAIL SHEET A1002
- C.30 122413 TYPE 7 SHADES MOTORIZED DOUBLE ROLLER SHADES: SURFACE MOUNTED W/ CUSTOM COLOR FASCIA
- C.31 122413 TYPE 8 MOTORIZED DOUBLE ROLLER SHADE IN RECESSED POCKET.
- C.32 SPECIAL ACOUSTICAL SEPARATION CEILING: APPLY KINETICS NOISE CONTROL QUIET TILE CAC-51 TO TOP SIDE OF ACOUSTICAL PANELS. ISOLATE CEILING TILE FROM STRUCTURE ABOVE WITH KNC AF HANGERS. REVEAL TRIM AROUND DIAGONAL BRACE PENETRATION THROUGH CEILING - LEAVE 3/4" GAP ALL SIDES
- C.33 LABORATORY OVERHEAD SERVICE CARRIER - REFER TO ENLARGED FLOOR PLANS
- C.34 EMERGENCY SAFETY SHOWER - PIPING TO HEAD ABOVE CEILING
- C.35 122413 TYPE 3 SHADES: MANUAL SHADES - STEPPED WITH SLOPE IN CONT. SLOPED OPENING

CEILING LEGEND

- APC-1 2' x 2' ARMSTRONG OPTIMA REGULAR 1" THICK IN 9/16" GRID
- APC-2 2' x 2' ARMSTRONG ULTIMA REGULAR 1" THICK IN 9/16" GRID
- APC-3A 2' x 2' ARMSTRONG ULTIMA HEALTH ZONE IN 9/16" GRID
- APC-3B 2' x 2' ARMSTRONG ULTIMA HEALTH ZONE REGULAR 9/16" GRID
- APC-4 NOT USED
- APC-5 2' x 2' ARMSTRONG FINE FISSURED IN 15/16" GRID
- APC-6 095310 ACOUSTICAL PLASTER: BASWAPHON (40 MM) OVER 1 1/2" INSULATION OVER GYP. BOARD
- APC-7 2' x 4' ARMSTRONG ULTIMA REGULAR IN 9/16" SILHOUETTE XL GRID W/ 6" PANEL INSERTS AS SHOWN
- APC-8 2' x 6' ARMSTRONG OPTIMA REGULAR - 1" THICK, NRC-.90, IN 9/16" SILHOUETTE XL 1/8" GRID MATCH APC-7 - EXCEPT REF. 090113- SPECIAL ACOUSTIC TREATMENT. APPLY SPECIAL
- APC-9 ACOUSTIC MATERIAL TO TOP SIDE OF PANELS AND PROVIDE ISOLATORS FOR CEILING HANGERS:

- WDC-1 09 5426 WOOD GRILLE CEILING W/ 3/4" x 2 1/4" MEMBERS - 6 PER FOOT - NINEWOOD GRILL 1400 W/ 1" THICK ARMSTRONG OPTIMA PANELS FIT TO GRID SUPPORT ABOVE
- WDC-2 06 4216 FLUSH WOOD PANEL SOFFIT - MATCH WV-1
- WDC-3 06 4216 OPAQUE WOOD PANEL TO MATCH WOOD ACOUST WALL PANEL

- GWB-1 PAINTED GYP. BOARD
- GWB-2 GYP. BOARD W/ COATING TO MATCH ADJACENT ACOUST. PLASTER

1 LEVEL 02 REFLECTED CEILING PLAN - AREA B

1/8" = 1'-0"

There needs to be a "C.1" here (even though keynote C.26 was not shown here).

1 LEVEL 03 REFLECTED CEILING PLAN - AREA A
1/8" = 1'-0"

KEYED NOTE LEGEND - REFLECTED CEILING PLAN

- C.1 122413 TYPE 1 SHADES: MOTORIZED ROLLER SHADES IN CONTINUOUS RECESSED POCKET (OFCI)
C.2 122413 TYPE 2 SHADES: MOTORIZED DOUBLE ROLLER SHADES: SURFACE MOUNTED W/ CUSTOM COLOR FASCIA
C.3 122413 TYPE 3 SHADES: MANUAL SHADES IN RECESSED POCKET
C.4 122413 TYPE 4 SHADES: MULLION MOUNTED SHADE IN CONTINUOUS POCKET
C.5 CEILING MOUNTING SUSPENSION FOR LCD SCREEN- PROVIDE STEEL SUPPORT ABOVE CEILING
C.6 EXHAUST HOOD LOCATION - REFER TO FOOD SERVICE DRAWINGS
C.7 FUME HOOD LOCATION - HOOD ENCLOSURE EXTENDS 6" ABOVE CEILING
C.8 EXPOSED STRUCTURE
C.9 083333 SIDE COILING DOOR TRACK
C.10 ACOUSTICAL PANEL CEILING ABOVE WOOD GRILLE CEILING. 1" THICK
C.11 ACOUSTICAL ISOLATION CEILING: 2 LAYERS 1/2" GYP BOARD CEILING ON SUSPENDED METAL FRAMING SUSPENSION SYSTEM TO BE ACOUSTICALLY ISOLATED FROM STRUCTURE BY SPRING/NEOPRENE ISOLATION HANGER - KINETIC NOISE CONTROL MODEL. MUTA HANGERS: PROVIDE CONTINUOUS LAYERS OF 3/8" FIBERGLASS ACOUSTIC BATTES. REFER TO DETAIL 16 SHEET A0703.2
C.12 6" PANEL WHERE SHOWN @ 10'-6" O.C. MATCH CEILING TYPE
C.13 RECESSED DRAPEY TRACK AND CURTAINS
C.15 122413 TYPE 5 MOTORIZED DOUBLE ROLLER SHADE IN RECESSED POCKET.
C.16 WOOD CEILING AT BOTTOM OF STAIRS - REFER TO STAIR 1 DRAWINGS AND DETAILS SHEET A0703.2
C.17 CONTINUOUS COVE TYPE LIGHTING FIXTURE TAPED INTO GYP BOARD CEILING. REFER TO ELECTRICAL LIGHTING DRAWINGS AND TO DETAIL AT WALL SHEET A0703.2
C.18 CEILING IN COLD ROOM BY COLD ROOM MFG
C.19 G57500 MET ALUM. BEAM ENCLOSURE
C.20 UNISTRUT MOUNTED TO CEILING W/ STEEL ANGLE HANGERS AND KICKERS ABOVE FOR SUPPORT
C.21 STAINLESS STEEL STEAM CAPTURE HOOD ABOVE AUTOCLAVE
C.22 REFER TO DETAIL 6/A0452
C.23 122413 TYPE 6 SHADES: MANUAL SHADES IN RECESSED POCKET AT INTERIOR GLAZING. POCKET CONTINUOUS ACROSS OPENING
C.24 INSULATED SOFFIT - SIMILAR TO WA-14 ON SHEET A0400
C.25 CEILING MOUNTED SURGICAL LIGHT - SEE EQUIPMENT LIST (OFCI) - PROVIDE STRUCTURAL STEEL SUPPORT TO DECK - 4 - 2X2X 1/4" STEEL ANGLE HANGER WITH 4 - ANGLE KICKERS 2 X 2 X 1/4". AND MOUNTING PLATE PER MANUFACTURER. SEE DETAIL 01/A0914.
C.26 CONTROL JOINT LOCATION
C.27 ABOVE CEILING WHERE INDICATED WITH DASHED LINE: PROVIDE 2 HOUR RATED HORIZONTAL GYP BOARD ENCLOSURE AROUND DUCTS SERVING FLOOR GRILLES ON LEVEL ABOVE. REFER TO DETAIL SHEET A1002
C.28 ABOVE CEILING WHERE INDICATED WITH DASHED LINE: PROVIDE 2 HOUR RATED HORIZONTAL GYP BOARD ENCLOSURE AROUND STANDPIPE RUN. REFER TO DETAIL SHEET A1002
C.29 PROVIDE 2 HOUR RATED HORIZONTAL GYP BOARD ENCLOSURE AT BOTTOM OF SHAFT. REFER TO DETAIL SHEET A1002
C.30 122413 TYPE 7 SHADES: MOTORIZED DOUBLE ROLLER SHADES: SURFACE MOUNTED W/ CUSTOM COLOR FASCIA
C.31 122413 TYPE 8 MOTORIZED DOUBLE ROLLER SHADE IN RECESSED POCKET.
C.32 SPECIAL ACOUSTICAL SEPARATION CEILING: APPLY KINETICS NOISE CONTROL QUIET TILE CAC-51 TO TOP SIDE OF ACOUSTICAL PANELS. ISOLATE CEILING TILE FROM STRUCTURE ABOVE WITH KNC AF HANGERS. LEAVE 3/4" GAP ALL SIDES
C.33 REVEAL TRIM AROUND DIAGONAL BRACE PENETRATION THROUGH CEILING
C.34 LABORATORY OVERHEAD SERVICE CARRIER - REFER TO ENLARGED FLOOR PLANS
C.35 EMERGENCY SAFETY SHOWER - PIPING TO HEAD ABOVE CEILING
C.36 122413 TYPE 3 SHADES: MANUAL SHADES - STEPPED WITH SLOPE IN CONT. SLOPED OPENING

CEILING LEGEND


- APC-1 2' x 2' - ARMSTRONG OPTIMA REGULAR IN 916" SILHOUETTE XL 1/8" GRID
APC-2 2' x 4' - ARMSTRONG ULTIMA REGULAR IN 916" SILHOUETTE XL 1/8" GRID
APC-3B 2' x 2' - ARMSTRONG ULTIMA HEALTH ZONE REGULAR 916" GRID
APC-4 NOT USED
APC-5 2' x 2' - ARMSTRONG FINE FISSURED IN 1516" GRID
APC-6 086310 ACOUSTICAL PLASTER: BASWAPHON (40 MM) OVER 1 1/2" INSULATION OVER GYP. BOARD
APC-7 2' x 4' - ARMSTRONG ULTIMA REGULAR IN 916" SILHOUETTE XL GRID W/ 6" PANEL INSERTS AS SHOWN
APC-8 2' x 6' - ARMSTRONG OPTIMA REGULAR - 1" THICK, NRC: .90, IN 916" SILHOUETTE XL 1/8" GRID
APC-9 MATCH APC-7 - EXCEPT REF. 085113- SPECIAL ACOUSTIC TREATMENT: APPLY SPECIAL ACOUSTIC MATERIAL TO TOP SIDE OF PANELS AND PROVIDE ISOLATORS FOR CEILING HANGERS

- WDC-1 09 5426 WOOD GRILLE CEILING W/ 3/4" x 2 1/4" MEMBERS - 6 PER FOOT - NINEWOOD GRILL 1400 W/ 1" THICK ARMSTRONG OPTIMA PANELS FIT TO GRID SUPPORT ABOVE
WDC-2 06 4216 FLUSH WOOD PANEL SOFFIT - MATCH WVP-1
WDC-3 06 4216 OPAQUE WOOD PANEL TO MATCH WOOD ACOUST WALL PANEL

- GWB-1 PAINTED GYP. BOARD
GWB-2 GYP. BOARD W/ COATING TO MATCH ADJACENT ACOUST. PLASTER

CONFORMED SET 01 JUL 2016

1	ADDENDUM 3-2	15 APR 2016
2	ISSUED FOR CONSTRUCTION (BP3)	15 MAR 2016
No.	Description	Date

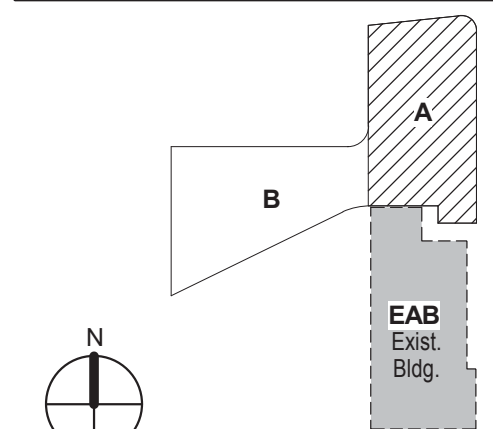

KEY PLAN


LEVEL 03 REFLECTED
CEILING PLAN AREA A

Project No.: 04561.01 Checked by:

A0703.A

CONFORMED SET 01 JUL 2016

1 ADDENDUM 3-2 15 APR 2016
- ISSUED FOR CONSTRUCTION (BP3) 15 MAR 2016
No. Description Date

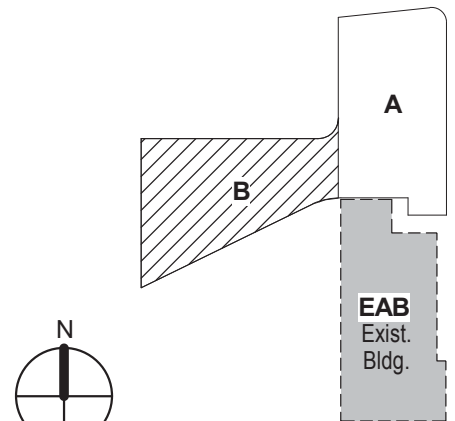


KEY PLAN

LEVEL 03 REFLECTED
CEILING PLAN AREA B

Project No.: 04561.01 Checked by:

A0703.B

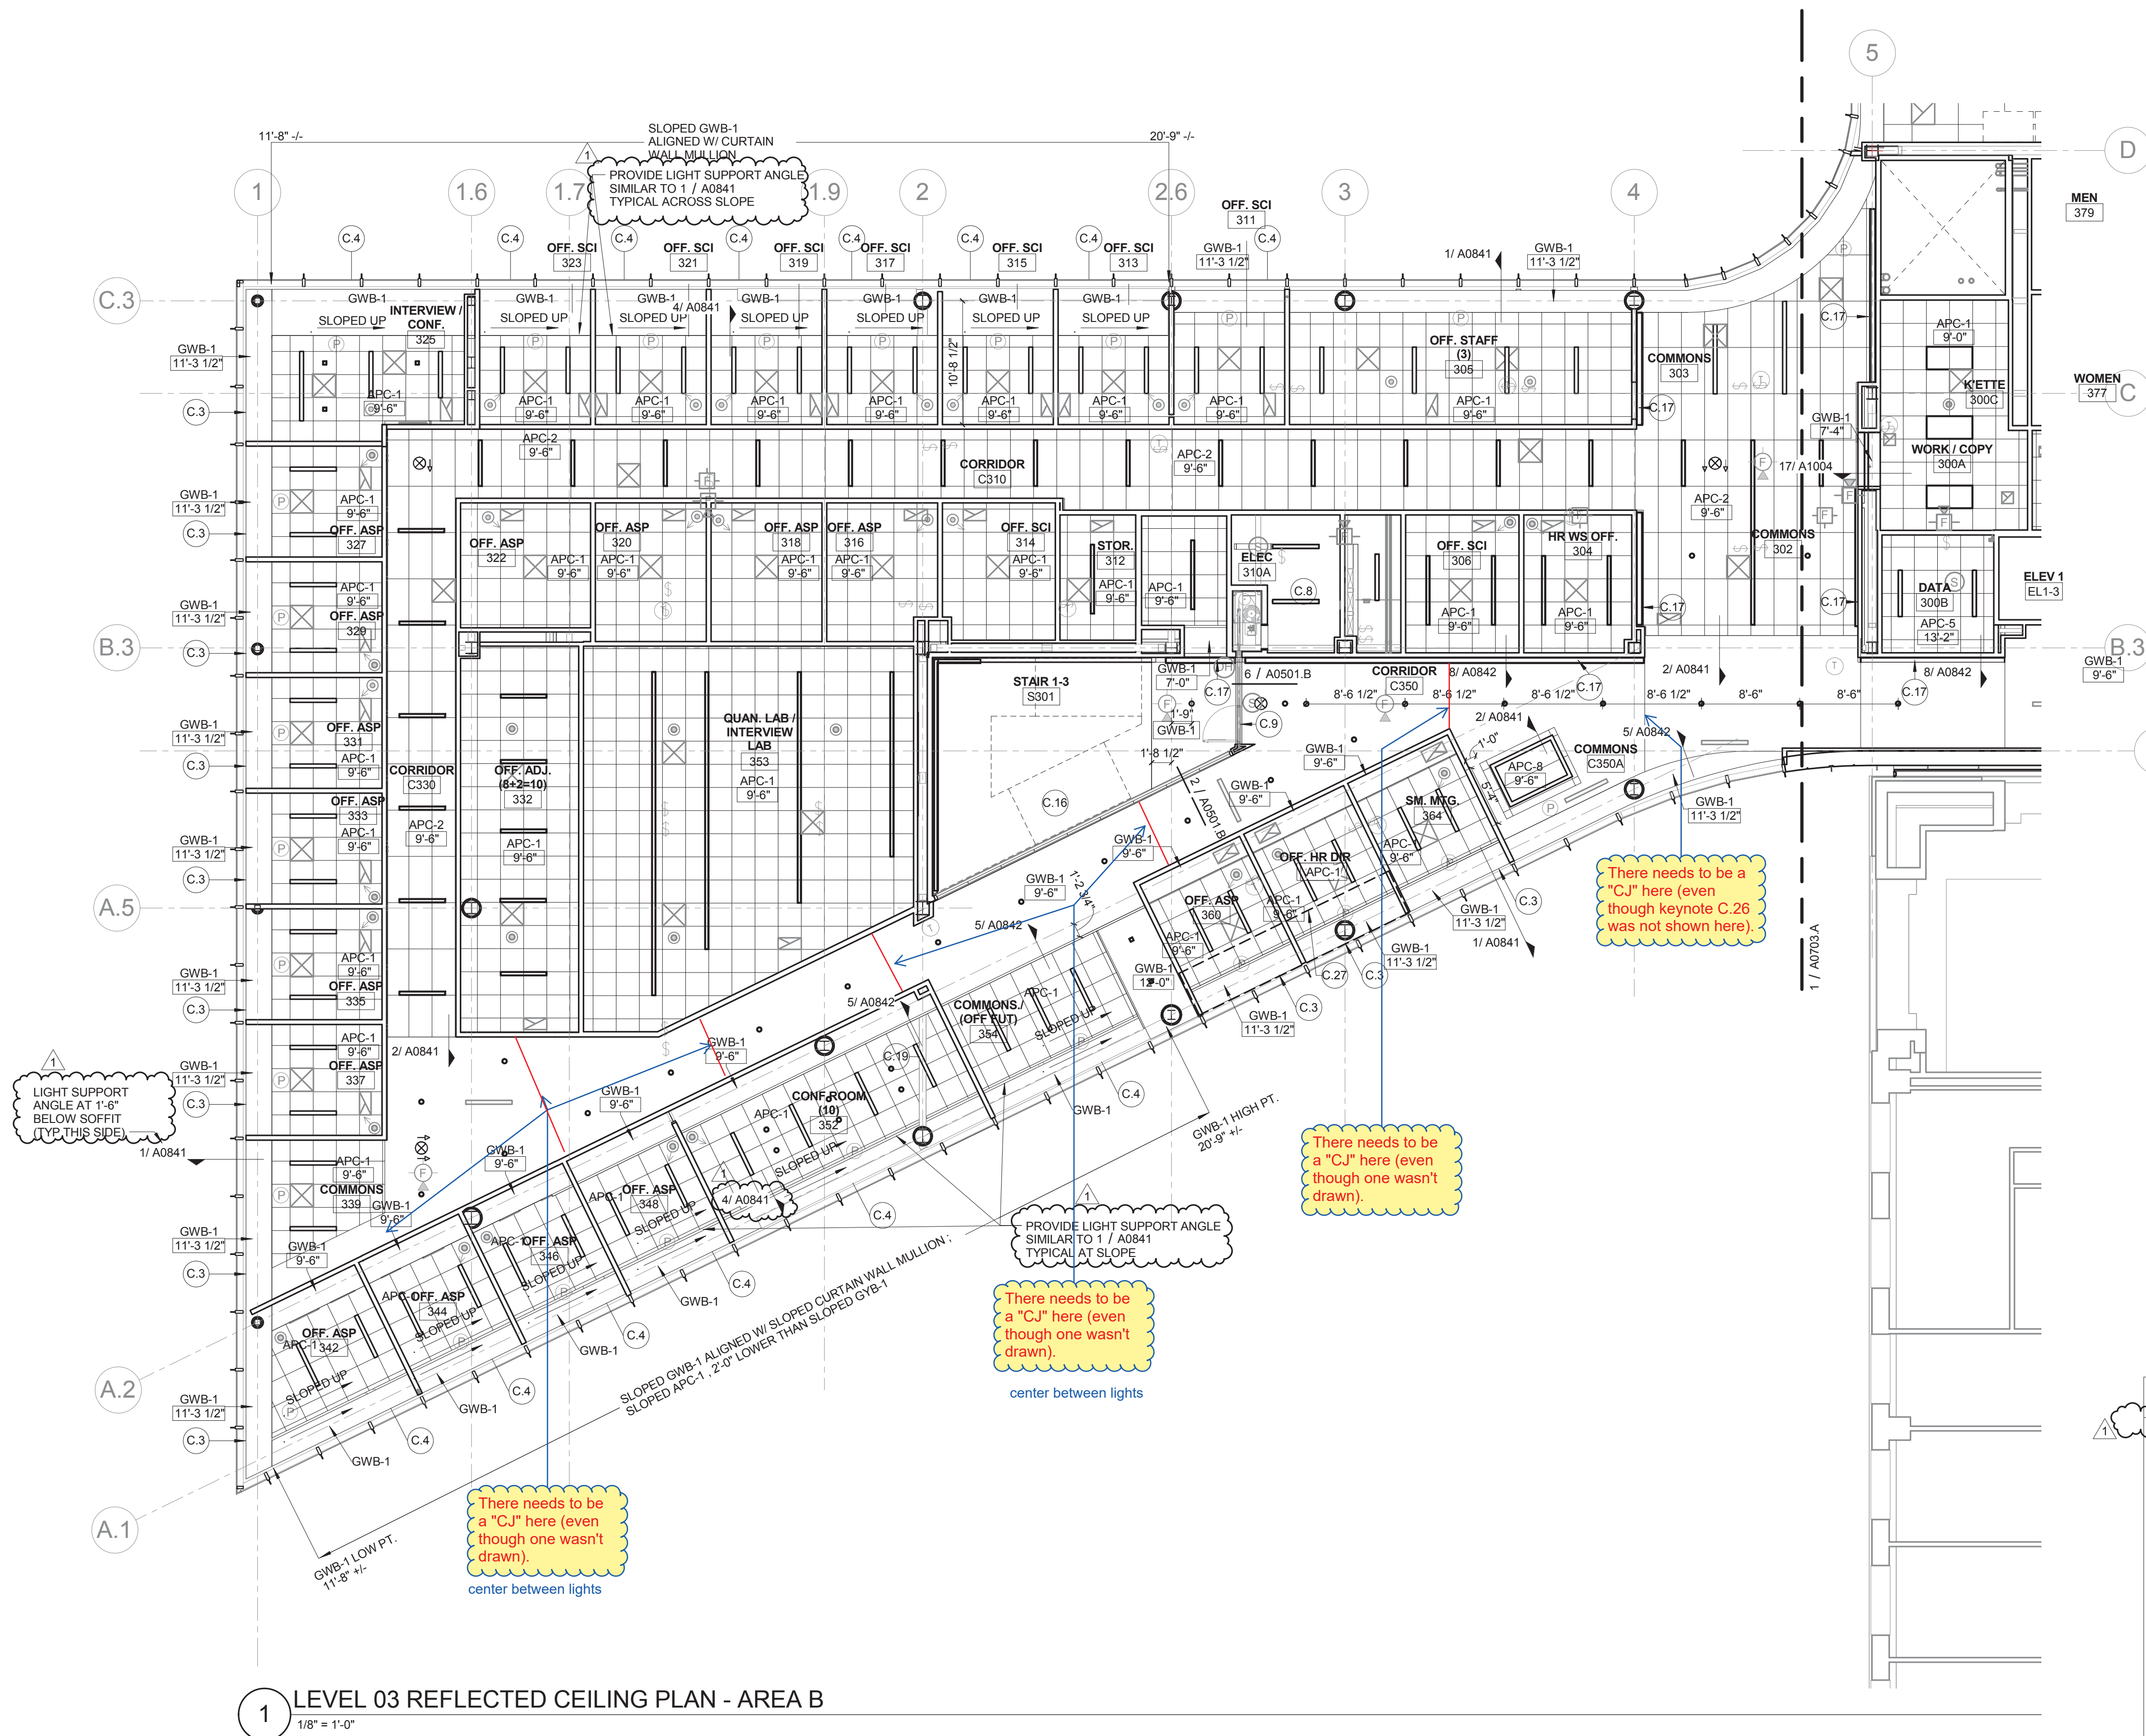


KEYED NOTE LEGEND - REFLECTED CEILING PLAN

- C.1 122413 TYPE 1 SHADES: MOTORIZED ROLLER SHADES IN CONTINUOUS RECESSED POCKET (GFCI)
- C.2 122413 TYPE 2 SHADES: MOTORIZED DOUBLE ROLLER SHADES: SURFACE MOUNTED W/ CUSTOM COLOR FASCIA
- C.3 122413 TYPE 3 SHADES: MANUAL SHADES IN RECESSED POCKET
- C.4 122413 TYPE 4 SHADES: MULLION MOUNTED SHADE IN CONTINUOUS POCKET
- C.5 CEILING MOUNTING SUSPENSION FOR LCD SCREEN- PROVIDE STEEL SUPPORT ABOVE CEILING
- C.6 EXHAUST HOOD LOCATION - REFER TO FOOD SERVICE DRAWINGS
- C.7 FUME HOOD LOCATION - HOOD ENCLOSURE EXTENDS 6" ABOVE CEILING
- C.8 EXPOSED STRUCTURE
- C.9 083333 SIDE COILING DOOR TRACK
- C.10 ACOUSTICAL PANEL CEILING ABOVE WOOD GRILLE CEILING. 1" THICK
- C.11 ACOUSTICAL ISOLATION CEILING: 2 LAYERS 1/2" GYP BOARD CEILING ON SUSPENDED METAL FRAMING SUSPENSION SYSTEM TO BE ACOUSTICALLY ISOLATED FROM STRUCTURE BY SPRING/NEOPRENE ISOLATION HANGER - KINETIC NOISE CONTROL MODEL. MUTA HANGERS: PROVIDE CONTINUOUS LAYERS OF 3/8" FIBERGLASS ACOUSTIC BATTES. REFER TO DETAIL 16 SHEET A0842
- C.12 6" PANEL WHERE SHOWN @ 10'-6" O.C. MATCH CEILING TYPE
- C.13 RECESSED DRAPEY TRACK AND CURTAINS
- C.15 122413 TYPE 5 MOTORIZED DOUBLE ROLLER SHADE IN RECESSED POCKET.
- C.16 WOOD CEILING AT BOTTOM OF STAIRS - REFER TO STAIR 1 DRAWINGS AND DATA SHEET A0842
- C.17 CONTINUOUS COVE TYPE LIGHTING FIXTURE TAPED INTO GYP BOARD CEILING. REFER TO ELECTRICAL LIGHTING DRAWINGS AND TO DETAIL AT WALL SHEET A0842
- C.18 CEILING IN COLD ROOM BY COLD ROOM MFG
- C.19 G57500 MET ALUM. BEAM ENCLOSURE
- C.20 UNISTRUT MOUNTED TO CEILING W/ STEEL ANGLE HANGERS AND KICKERS ABOVE FOR SUPPORT
- C.21 STAINLESS STEEL STEAM CAPTURE HOOD ABOVE AUTOCLAVE
- C.22 REFER TO DETAIL 6/A0462
- C.23 122413 TYPE 6 SHADES: MANUAL SHADES IN RECESSED POCKET AT INTERIOR GLAZING. POCKET CONTINUOUS ACROSS OPENING
- C.24 INSULATED SOFFIT - SIMILAR TO WA-14 ON SHEET A0400
- C.25 CEILING MOUNTED SURGICAL LIGHT - SEE EQUIPMENT LIST (UFCI) - PROVIDE STRUCTURAL STEEL SUPPORT TO DECK - 4 - 2X2X 1/4" STEEL ANGLE HANGER WITH 4 - ANGLE KICKERS 2 X 2 X 1/4" AND MOUNTING PLATE PER MANUFACTURER. SEE DETAIL 01/A0814
- C.26 CONTROL JOINT LOCATION
- C.27 ABOVE CEILING WHERE INDICATED WITH DASHED LINE: PROVIDE 2 HOUR RATED HORIZONTAL GYP BOARD ENCLOSURE AROUND DUCTS SERVING FLOOR GRILLES ON LEVEL ABOVE. REFER TO DETAIL SHEET A1002
- C.28 ABOVE CEILING WHERE INDICATED WITH DASHED LINE: PROVIDE 2 HOUR RATED HORIZONTAL GYP BOARD ENCLOSURE AROUND STANDPIPE RUN. REFER TO DETAIL SHEET A1002
- C.29 PROVIDE 2 HOUR RATED HORIZONTAL GYP BOARD ENCLOSURE AT BOTTOM OF SHAFT. REFER TO DETAIL SHEET A1002
- C.30 122413 TYPE 7 SHADES: MOTORIZED DOUBLE ROLLER SHADES: SURFACE MOUNTED W/ CUSTOM COLOR FASCIA
- C.31 122413 TYPE 8 MOTORIZED DOUBLE ROLLER SHADE IN RECESSED POCKET. SPECIAL ACOUSTICAL SEPARATION CEILING: APPLY KINETICS NOISE CONTROL QUIET TILE CAC-51 TO TOP SIDE OF ACOUSTICAL PANELS. ISOLATE CEILING TILE FROM STRUCTURE ABOVE WITH KNC AF HANGERS. LEAVE 3/4" GAP ALL SIDES
- C.33 REVEAL TRIM AROUND DIAGONAL BRACE PENETRATION THROUGH CEILING
- C.34 LABORATORY OVERHEAD SERVICE CARRIER - REFER TO ENLARGED FLOOR PLANS
- C.35 EMERGENCY SAFETY SHOWER - PIPING TO HEAD ABOVE CEILING
- C.36 122413 TYPE 3 SHADES: MANUAL SHADES - STEPPED WITH SLOPE IN CONT. SLOPED OPENING

CEILING LEGEND

- WDC-1 09 5426 WOOD GRILLE CEILING W/ 3/4" x 2 1/4" MEMBERS - 8 PER FOOT - NINEWOOD GRILL 1400 W/ 1" THICK ARMSTRONG OPTIMA PANELS FIT TO GRID SUPPORT ABOVE
- WDC-2 06 4216 FLUSH WOOD PANEL SOFFIT - MATCH WVP-1
- WDC-3 06 4216 OPAQUE WOOD PANEL TO MATCH WOOD ACOUST WALL PANEL
- GWB-1 PAINTED GYP. BOARD
- GWB-2 GYP. BOARD W/ COATING TO MATCH ADJACENT ACOUST. PLASTER

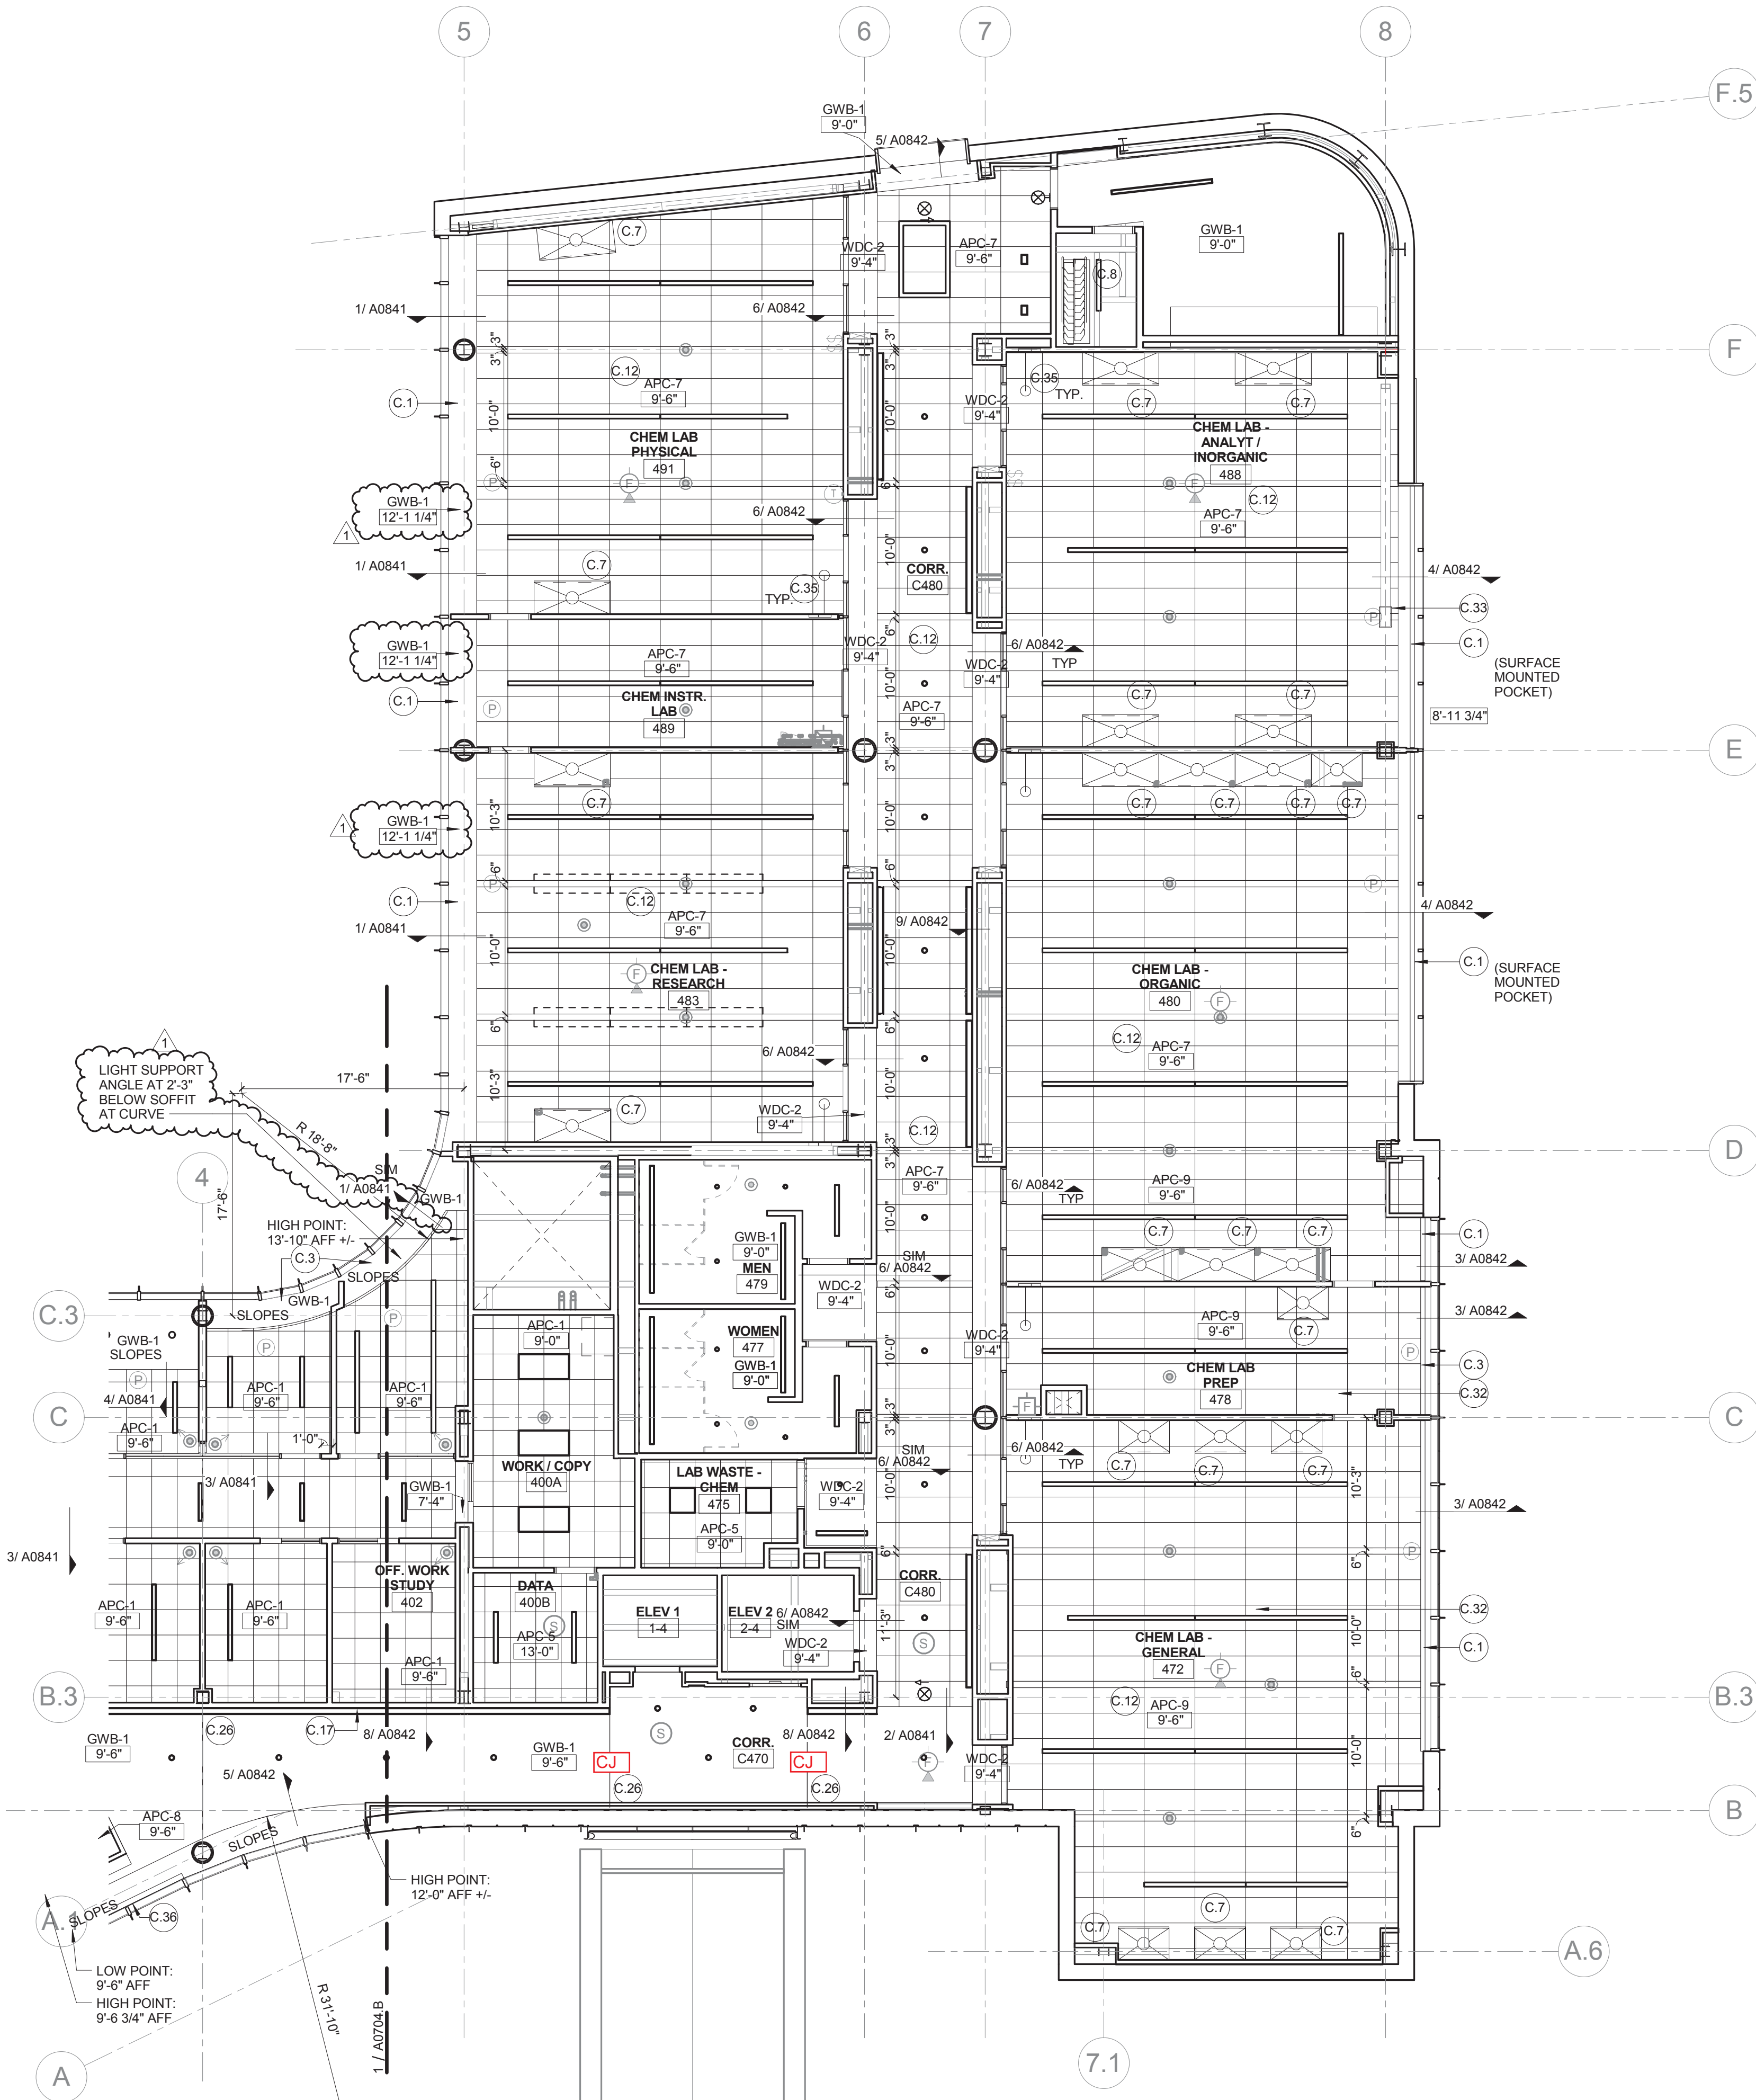

KEYED NOTE LEGEND - REFLECTED CEILING PLAN

- C.1 122413 TYPE 1 SHADES: MOTORIZED ROLLER SHADES IN CONTINUOUS RECESSED POCKET (OFCI)
- C.2 122413 TYPE 2 SHADES: MOTORIZED DOUBLE ROLLER SHADES: SURFACE MOUNTED W/ CUSTOM COLOR FASCIA
- C.3 122413 TYPE 3 SHADES: MANUAL SHADES IN RECESSED POCKET
- C.4 122413 TYPE 4 SHADES: MULLION MOUNTED SHADE IN CONTINUOUS POCKET
- C.5 CEILING MOUNTING SUSPENSION FOR LCD SCREEN- PROVIDE STEEL SUPPORT ABOVE CEILING
- C.6 EXHAUST HOOD LOCATION - REFER TO FOOD SERVICE DRAWINGS
- C.7 FUME HOOD LOCATION - HOOD ENCLOSURE EXTENDS 6" ABOVE CEILING
- C.8 EXPOSED STRUCTURE
- C.9 083333 SIDE COILING DOOR TRACK
- C.10 ACOUSTICAL PANEL CEILING ABOVE WOOD GRILLE CEILING. 1" THICK
- C.11 ACOUSTICAL ISOLATION CEILING: 2 LAYERS 1/2" GYP BOARD CEILING ON SUSPENDED METAL FRAMING SUSPENSION SYSTEM TO BE ACOUSTICALLY ISOLATED FROM STRUCTURE BY SPRING/NEOPRENE ISOLATION HANGER - KINETIC NOISE CONTROL MODEL. MUTA HANGERS. PROVIDE CONTINUOUS LAYERS OF 3/5" FIBERGLASS ACOUSTIC BATTES. REFER TO DETAIL 16 SHEET A0842
- C.12 6" PANEL WHERE SHOWN @ 10'-6" O.C. MATCH CEILING TYPE
- C.13 RECESSED DRAPERY TRACK AND CURTAINS
- C.15 122413 TYPE 5 MOTORIZED DOUBLE ROLLER SHADE IN RECESSED POCKET.
- C.16 WOOD CEILING AT BOTTOM OF STAIRS - REFER TO STAIR 1 DRAWINGS AND DETAIL SHEET A0842
- C.17 CONTINUOUS COVE TYPE LIGHTING FIXTURE TAPED INTO GYP BOARD CEILING. REFER TO ELECTRICAL LIGHTING DRAWINGS AND TO DETAIL AT WALL SHEET A0842
- C.18 CEILING IN COLD ROOM BY COLD ROOM MFG
- C.19 G57500 MET ALUM. BEAM ENCLOSURE
- C.20 UNISTRUT MOUNTED TO CEILING W/ STEEL ANGLE HANGERS AND KICKERS ABOVE FOR SUPPORT
- C.21 STAINLESS STEEL STEAM CAPTURE HOOD ABOVE AUTOCLAVE
- C.22 REFER TO DETAIL 6/A0452
- C.23 122413 TYPE 6 SHADES: MANUAL SHADES IN RECESSED POCKET AT INTERIOR GLAZING. POCKET CONTINUOUS ACROSS OPENING
- C.24 INSULATED SOFFIT - SIMILAR TO WA-14 ON SHEET A0400
- C.25 CEILING MOUNTED SURGICAL LIGHT - SEE EQUIPMENT LIST (OFCI) - PROVIDE STRUCTURAL STEEL SUPPORT TO DECK - 4 - 2X2X 1/4" STEEL ANGLE HANGER WITH 4 - ANGLE KICKERS 2 X 2 X 1/4". AND MOUNTING PLATE PER MANUFACTURER. SEE DETAIL 01/A0814.
- C.26 CONTROL JOINT LOCATION
- C.27 ABOVE CEILING WHERE INDICATED WITH DASHED LINE: PROVIDE 2 HOUR RATED HORIZONTAL GYP BOARD ENCLOSURE AROUND DUCTS SERVING FLOOR GRILLES ON LEVEL ABOVE. REFER TO DETAIL SHEET A1002
- C.28 ABOVE CEILING WHERE INDICATED WITH DASHED LINE: PROVIDE 2 HOUR RATED HORIZONTAL GYP BOARD ENCLOSURE AROUND STANDPIPE RUN. REFER TO DETAIL SHEET A1002
- C.29 PROVIDE 2 HOUR RATED HORIZONTAL GYP BOARD ENCLOSURE AT BOTTOM OF SHAFT. REFER TO DETAIL SHEET A1002
- C.30 122413 TYPE 7 SHADES: MOTORIZED DOUBLE ROLLER SHADES: SURFACE MOUNTED W/ CUSTOM COLOR FASCIA
- C.31 122413 TYPE 8 MOTORIZED DOUBLE ROLLER SHADE IN RECESSED POCKET.
- C.32 SPECIAL ACOUSTICAL SEPARATION CEILING: APPLY KINETICS NOISE CONTROL QUIET TILE CAC-51 TO TOP SIDE OF ACOUSTICAL PANELS. ISOLATE CEILING TILE FROM STRUCTURE ABOVE WITH KNC AF HANGERS. LEAVE 3/4" GAP ALL SIDES
- C.33 REVEAL TRIM AROUND DIAGONAL BRACE PENETRATION THROUGH CEILING
- C.34 LABORATORY OVERHEAD SERVICE CARRIER - REFER TO ENLARGED FLOOR PLANS
- C.35 EMERGENCY SAFETY SHOWER - PIPING TO HEAD ABOVE CEILING
- C.36 122413 TYPE 3 SHADES: MANUAL SHADES - STEPPED WITH SLOPE IN CONT. SLOPED OPENING


CEILING LEGEND

- APC-1 2' x 2' - ARMSTRONG OPTIMA REGULAR 1" THICK IN 9/16" GRID
- APC-2 2' x 4' - ARMSTRONG ULTIMA REGULAR IN 9/16" SILHOUETTE XL 1/8" GRID
- APC-3A 2' x 2' - ARMSTRONG ULTIMA HEALTH ZONE IN 1/8" GRID
- APC-3B 2' x 2' - ARMSTRONG ULTIMA HEALTH ZONE IN 1/8" GRID
- APC-4 NOT USED
- APC-5 2' x 2' - ARMSTRONG FINE FISSURED IN 15/16" GRID
- APC-6 08810 ACOUSTICAL PLASTER: BASWAPHON (40 MM) OVER 1 1/2" INSULATION OVER GYP. BOARD
- APC-7 2' x 4' - ARMSTRONG ULTIMA REGULAR IN 9/16" SILHOUETTE XL GRID W/ 6" PANEL INSERTS AS SHOWN
- APC-8 2' x 6' ARMSTRONG OPTIMA REGULAR - 1" THICK, NRC - .90. IN 9/16" SILHOUETTE XL 1/8" GRID MATCH APC-7 - EXCEPT. REF. 086113- SPECIAL ACOUSTIC TREATMENT. APPLY SPECIAL ACOUSTIC MATERIAL TO TOP SIDE OF PANELS AND PROVIDE ISOLATORS FOR CEILING HANGERS:

- WDC-1 09 5428 WOOD GRILLE CEILING W/ 3/4" x 2 1/4" MEMBERS - 6 PER FOOT - NINEWOOD GRILL 1400 W/ 1" THICK ARMSTRONG OPTIMA PANELS FIT TO GRID SUPPORT ABOVE
- WDC-2 06 4216 FLUSH WOOD PANEL. SOFFIT - MATCH WVP-1
- WDC-3 06 4216 OPAQUE WOOD PANEL TO MATCH WOOD ACOUST WALL PANEL
- GWB-1 PAINTED GYP. BOARD
- GWB-2 GYP. BOARD W/ COATING TO MATCH ADJACENT ACOUST. PLASTER

CONFORMED SET 01 JUL 2016

No.	Description	Date
1	ADDENDUM 3-2	15 APR 2016
2	ISSUED FOR CONSTRUCTION (BP3)	15 MAR 2016

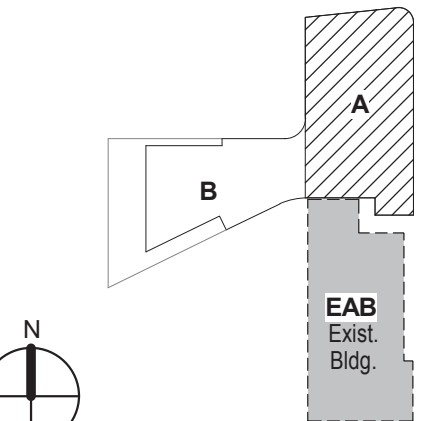


KEY PLAN

**LEVEL 04 REFLECTED
CEILING PLAN AREA A**

Project No.: 04561.01 Checked by:

A0704.A

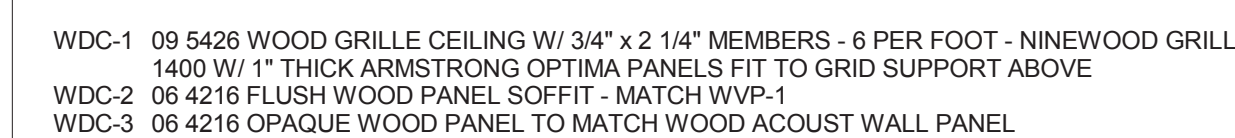

1 LEVEL 04 REFLECTED CEILING PLAN - AREA B
1/8" = 1'-0"

