H:\CADD\55453-98

GOLTERMAN & SABO

ACOUSTICAL WALL PANEL SHOP DRAWING

JOB: Webster ISB

JOB NO: I-55453-98400

SHIP TO ADDRESS: 8724 Big Bend Blvd.
St. Louis, MO. 63119

CONTACT: Matt Horton
CONTACT PHONE #: 636-561-9841
CONTACT FAX #:
G&S CONTACT: Matt Reeves

ACOUSTICAL WALL PANEL

PRODUCT: AIP-1
CORE MATERIAL: 1", 6-7# fiberglass with a high density scrim facing.
FINISH: Momentum Universe Cosmic
Snoopy Fabric- Graphite

MOUNTING: AF1 Impaling Clip, Adhsive
EDGE DETAIL: Square
NRC: .85
NOTES:
* Fiberglass can vary in thickness up to 1/16" +/- per inch on thickness, shimming may be required to make panels flush.

DATE MATERIAL REQUIRED: _____
JOBSITE CONTACT: _____
JOBSITE PHONE NUMBER: _____
CELL NUMBER: _____

SHIPPING NOTIFICATION ATTN: _____
EMAIL: _____ PHONE: _____ FAX: _____

Lead time is a minimum of 6-8 weeks after receipt of approved shop drawing and field verified dimensions.
Golterman & Sabo is not responsible for unloading or storage of materials.
Is this project phased: Yes_____No_____

APPROVED BY: _____ DATE: _____

WALL MOUNTING

TYPE: AF1 CLIP WITH ADHESIVE

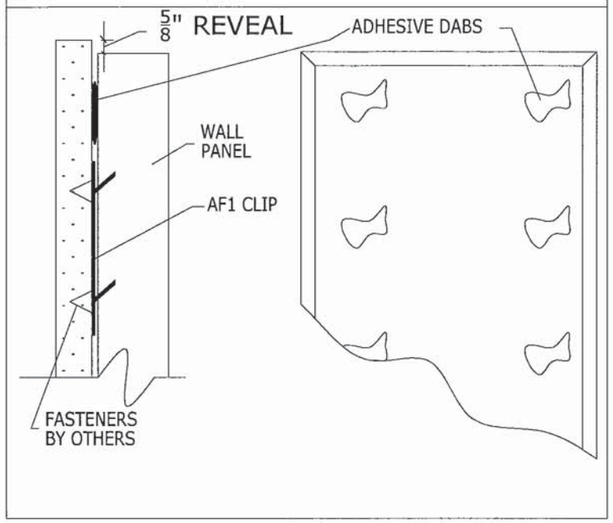

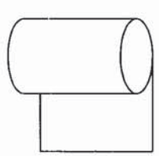

Standard:
Top Down
off the roll

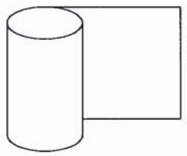

Railroad:
Left to Right
off the roll

CROSS LIGHTING

Critical cross lighting from windows, skylights, down lighting or sconces can alter the appearance of our panels. Please note below if there is cross lighting on our panels. If so please define.

☐ No, there is no critical cross lighting.

☐ Yes, there is critical cross lighting.

Explain below:

_____
_____
_____
_____
_____

098433 Shop Drawings for AP-1 and FAP-1 per RFI-038 and ID0201

All dimensions will be field verified prior to production.

Due to lead time, approval requested by 2/24/17

NOTES:
1) FVD = FIELD VERIFIED DIMENSIONS
2) HOLD ELECTRICAL FIXTURES OUT TO ACCOMODATE PANEL THICKNESS
3) NRC IS BASED ON STANDARD FINISH
4) FIELD VERIFYING DONE BY GOLTERMAN & SABO

NOTE: NRC test results based on our standard acoustically transparent fabric. Results may vary with other fabrics.

GOLTERMAN & SABO
3555 SCARLET OAK BLVD
ST. LOUIS, MO 63122
(636) 225-8800
(800) 737-0307

G&S Contact: Matt Reeves

Representative:

Job Name: Webster ISB

Job #: I-55453-98400

Date: 12/28/16 By: KEB
Date: Chkd By:
Rev Date: By:
Rev Date: Chkd By:

H:\CADD\55453-98400.dwg

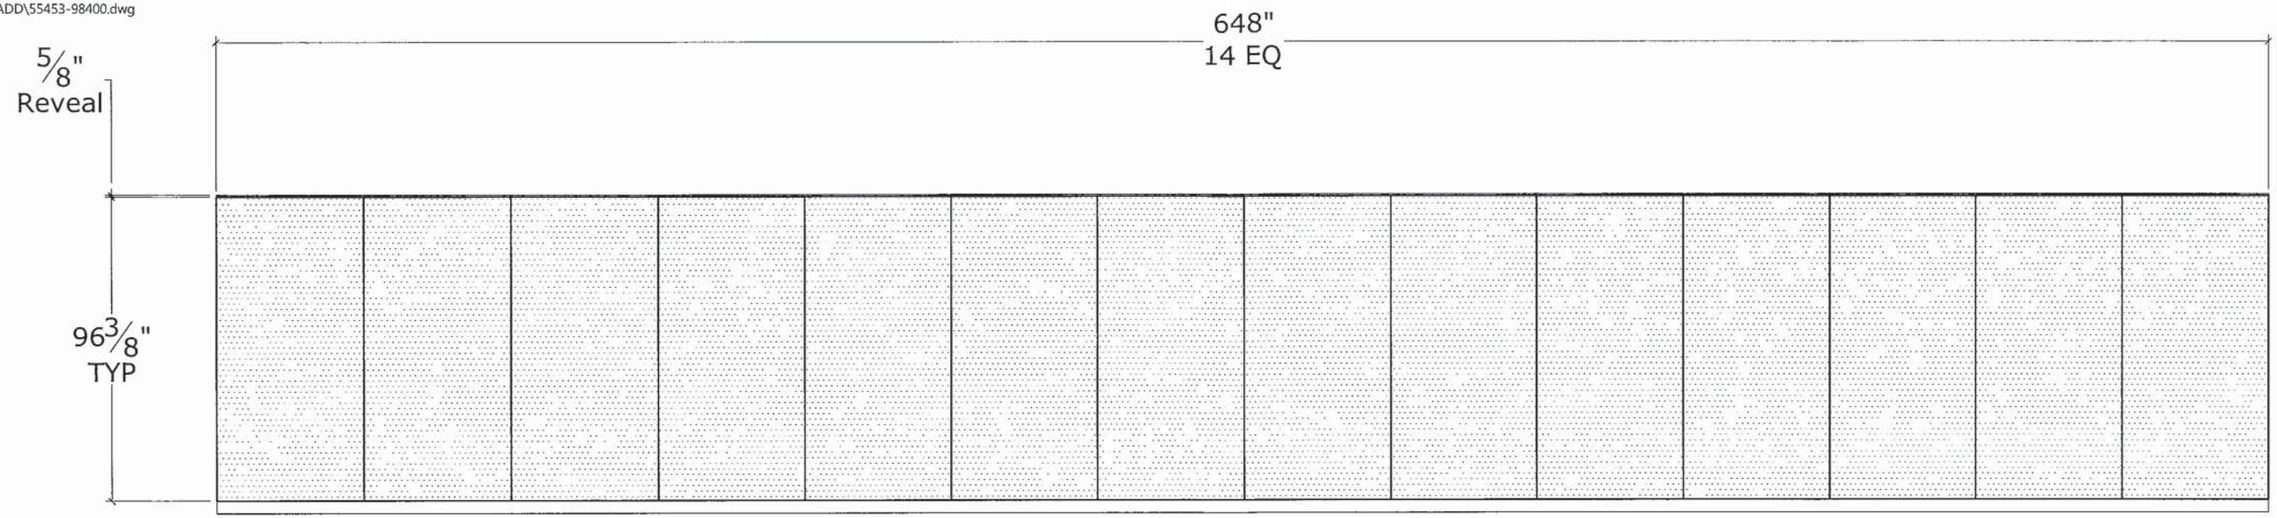

East Elevation
Lecture Hall Corridor
1/2 SCALE: 1/4"=1'-0"

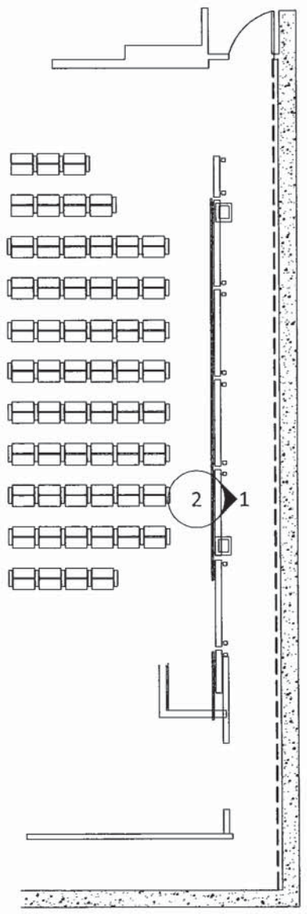

Indicates Panels

Partial Plan View
Lecture Hall Corridor
2/3 SCALE: 3/32"=1'-0"

AP1 Momentum Universe
Cosmic

All dimensions to be field verified.

GOLTERMAN & SABO
3555 SCARLET OAK BLVD
ST. LOUIS, MO 63122
(636) 225-8800 FAX#: (636) 225-2020
(800) 737-0307 FAX#: (636) 225-2966

JOB NAME: Webster ISB

JOB #: I-55453-98400

H:\CADD\55453-98400.dwg

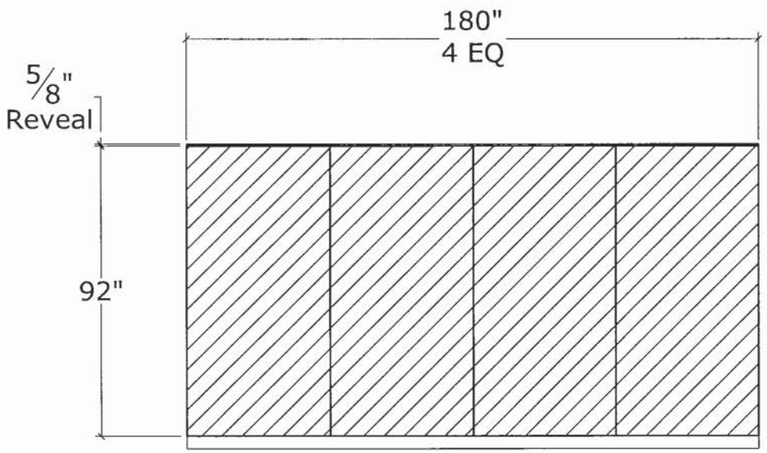

Control Room 160B
1/3 North Elevation
SCALE: 1/4"=1'-0"

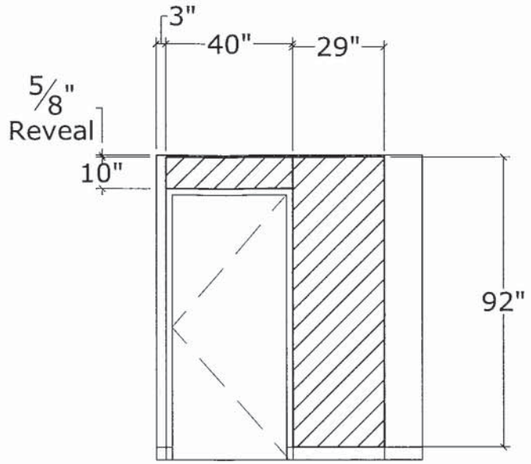

Control Room 160B
2/3 East Elevation
SCALE: 1/4"=1'-0"

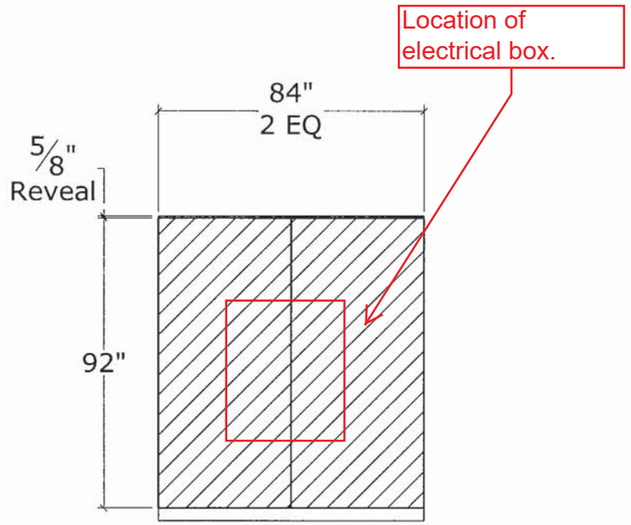

Control Room 160B
3/3 West Elevation
SCALE: 1/4"=1'-0"

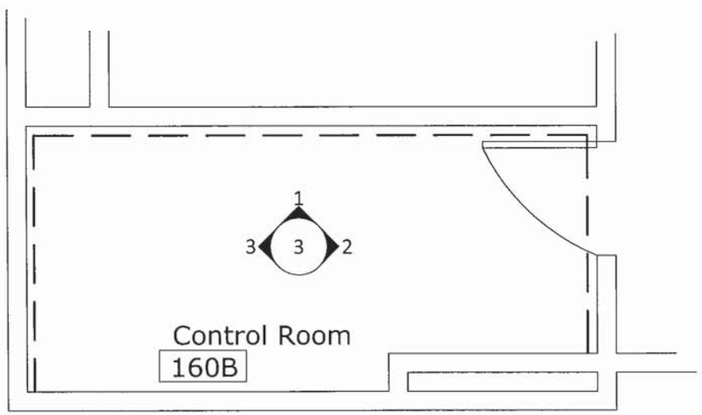

4/3 Partial Plan View
SCALE: 1/4"=1'-0"

Panels to be cut around the electrical box. Panels will be against the wall and the electrical panel can stick out past the face of the panels.

Arch. to verify what needs to be done on this elevation. Please verify if panels are supposed to sit flush with exposed electrical box.

Indicates Panels

AP1 Snoopy Fabric
Graphite

All dimensions to be field verified.

GOLTERMAN & SABO

3555 SCARLET OAK BLVD
ST. LOUIS, MO 63122
(636) 225-8800 FAX#: (636) 225-2020
(800) 737-0307 FAX#: (636) 225-2966

JOB NAME: Webster ISB

JOB #: I-55453-98400

PAGE: 3 OF 3

CANNONDESIGN

SUBMITTAL IDENTIFICATION SHEET

To be completed by Contractor/CM

WEBSTER UNIVERSITY ISB
PROJECT NAME

8274 BIG BEND BLVD
ADDRESS

NUMBER

WEBSTER UNIVERSITY
OWNER

CANNON DESIGN
ARCHITECT / ENGINEER

Joe Voypick
SUBMITTED BY

098433-006
CONTRACTOR / CM SUBMITTAL NO.

CANNON DESIGN SUBMITTAL NO.

DRAWING / DETAIL REFERENCE

098433
SPECIFICATION SECTION / PARAGRAPH

Self Perform
MANUFACTURER / SUPPLIER

ITEM / PRODUCT ID

REQUIRED DATE

PRIORITY

CRITICAL

ITEM BEING SUBMITTED (check only one)

- (●) Shop Drawings
- ( ) Samples (_____ copies)
- ( ) LEED Submittal
- ( ) Certification / Qualifications
- ( ) Record Documents
- ( ) Product Data
- ( ) Coordination Drawing
- ( ) Calculations
- ( ) Schedules
- ( ) O&M Manuals
- ( ) Other _____

ITEM BEING SUBMITTED FOR (check only one)

- (●) Action
- ( ) Information Only
- ( ) Record

REMARKS OR DEVIATIONS

Physical Samples to be Submitted within a week.

CONTRACTOR / CM CERTIFICATION
(SUBMITTALS NOT CERTIFIED WILL BE RETURNED WITHOUT REVIEW)

PARIC

PARIC CORPORATION
SUBMITTAL STAMP

THIS SHOP DRAWING HAS BEEN REVIEWED BY PARIC CORPORATION

Subcontractor remains responsible for dimensions, quantities, coordination with other trades and compliance with contract documents.

By:
Devin D. Gates

Joe Voypick — REVIEWED BY
2/17/17 — DATE

To be completed by Reviewer

09 8433-006
CANNON DESIGN SUBMITTAL NUMBER

2/17/17
RECEIVED DATE

- ( ) A. No Exceptions Taken
  No further review of submittal is required.
- (●) B. Make Corrections Noted
  Incorporate corrections in work; resubmission is not required.
- ( ) C. Revise and Resubmit
  Revise as noted, and resubmit for review.
- ( ) D. Rejected
  Submittal is not in compliance with Contract Documents; provide new submittal.
- ( ) E. For Record / Information Only
  Submittal was reviewed for Record / Information purposes only.
- ( ) F. Not Required for Review
  Submittal is not required by Contract Documents and has not been reviewed.

Review is for conformance with the design concept of this project and for general compliance with contract documents. Contractor is responsible for quantities, dimensions and compliance with contract documents and for information that pertains to fabrication processes, construction techniques and coordination of this work with all trades which will be affected thereby. This review is null and void if submittal deviates from contract documents and does not indicate or note deviations.

A/E COMMENTS

( ) See attached sheet(s) for additional comments

Kelvin Patel — REVIEWED BY

Digitally signed by Kelvin Patel
DN: C=US, E=kpatel@cannondesign.com, O=Cannon Design, OU=Architect, CN=Kelvin Patel
Date: 2017.02.24 12:45:36-06'00'

2/24/17 — DATE

77 Westport Plaza
Suite 250
St. Louis, MO 63146

TRANSMITTAL

No. 15051-0498

Paric Corporation

PROJECT: 15051-Webster University Interdisciplinary Science Building

DATE: 02/17/2017

TO: Cannon Design
1100 Clark Ave
St Louis MO 63102

Fax;
314-241-2203

RE: Acoustical Wall Panel Shop Drawings

ATTN: Kelvin Patel

JOB: 15051

WE ARE SENDING:	SUBMITTED FOR:	ACTION TAKEN:
☑ Shop Drawings	☑ Approval	☐ Approved as Submitted
☐ Letter	☐ Your Use	☐ Approved as Noted
☐ Prints	☐ As Requested	☐ Returned After Loan
☐ Change Order	☐ Review and Comment	☐ Resubmit
☐ Plans		☐ Submit
☐ Samples	**SENT VIA:**	☐ Returned
☐ Specifications	☐ Attached	☐ Returned for Corrections
☐ Other:	☐ Separate Cover Via:	☐ Due Date:

Item	*Package*	*Code*	*Rev.*	*Copies*	*Date*	*Description*	*Status*
Submittal		098433-006	1		02/17/2017	Acoustical Wall Panel Shop Drawings	Submitted

NOTES:

CC:

Signed: _____
Devin Gates