Spec Section 123661.16
Bench 183 C

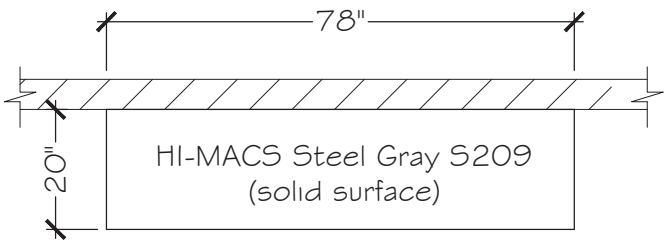

note: bench to be constructed and anchored and supported to support people sitting

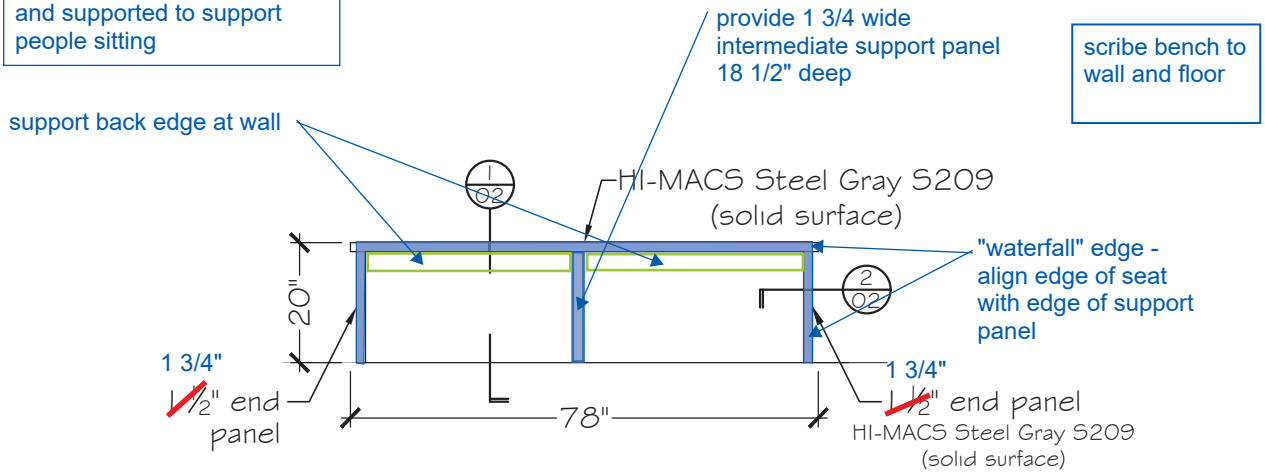

1/01 Plan and Elevation at Bio Vestibule 183C
3/8"= 1'-0"

FINISHES

HI-MACS Steel Gray S209
(solid surface)

St. Louis Wood Works will field verify all dimensions

ST. LOUIS WOODWORKS
500 Prospect Ave.
St. Louis, MO 63110
ph.# 314-652-9663 fax# 314-652-7684

Project: Webster Science		Approved:	
Job No: Job #16243	Date: 2/10/17	Approved Date:	
Scale: As Noted	Drawn by: Paul Rose	Revision Date:	Sht No. 01 of 02

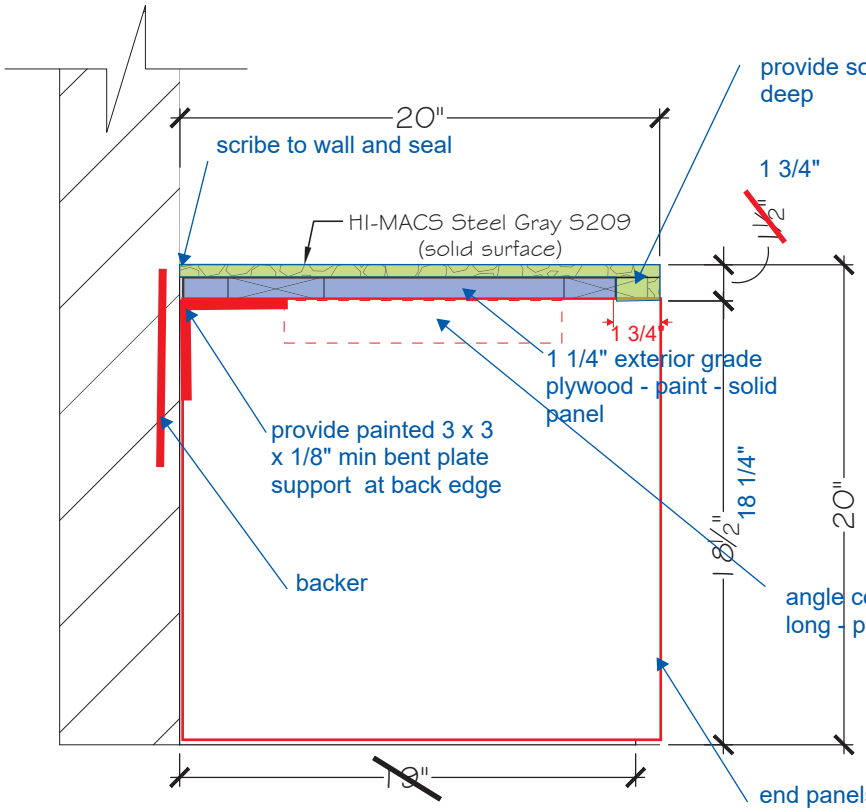

1/02 Section at Bench
1 1/2"=1'-0"

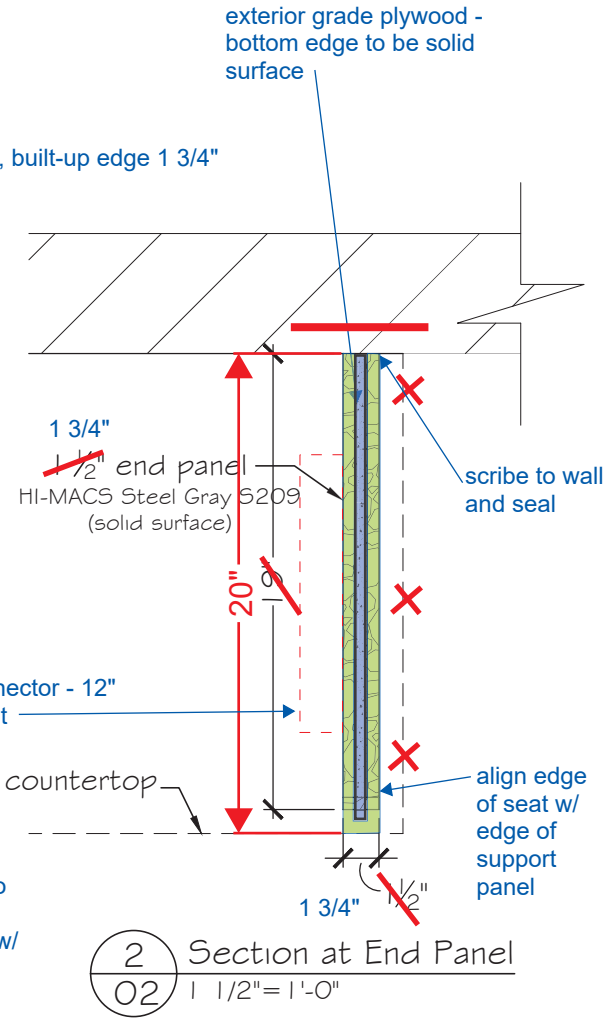

2/02 Section at End Panel
1 1/2"=1'-0"

FINISHES

HI-MACS Steel Gray S209
(solid surface)

St. Louis Wood Works will field verify all dimensions

ST. LOUIS WOODWORKS
500 Prospect Ave.
St. Louis, MO 63110
ph.# 314-652-9663 fax# 314-652-7684

Project: Webster Science			Approved:
Job No: Job #16243	Date: 2/10/17		Approved Date:
Scale: As Noted	Drawn by: Paul Rose	Revision Date:	Sht No. 02 of 02

CANNONDESIGN

SUBMITTAL IDENTIFICATION SHEET

To be completed by Contractor/CM

WEBSTER UNIVERSITY ISB
PROJECT NAME

8274 BIG BEND BLVD
ADDRESS

NUMBER

WEBSTER UNIVERSITY
OWNER

CANNON DESIGN
ARCHITECT / ENGINEER

Joe Voypick
SUBMITTED BY

123661.16-003
CONTRACTOR / CM SUBMITTAL NO.

CANNON DESIGN SUBMITTAL NO.

DRAWING / DETAIL REFERENCE

123661.16
SPECIFICATION SECTION / PARAGRAPH

Self Perform
MANUFACTURER / SUPPLIER

ITEM / PRODUCT ID

REQUIRED DATE

PRIORITY

CRITICAL

ITEM BEING SUBMITTED (check only one)

- (•) Shop Drawings
- ( ) Samples (_____ copies)
- ( ) LEED Submittal
- ( ) Certification / Qualifications
- ( ) Record Documents
- ( ) Product Data
- ( ) Coordination Drawing
- ( ) Calculations
- ( ) Schedules
- ( ) O&M Manuals
- ( ) Other _____

ITEM BEING SUBMITTED FOR (check only one)

(•) Action ( ) Information Only ( ) Record

REMARKS OR DEVIATIONS

CONTRACTOR / CM CERTIFICATION
(SUBMITTALS NOT CERTIFIED WILL BE RETURNED WITHOUT REVIEW)

PARIC

PARIC CORPORATION
SUBMITTAL STAMP

THIS SHOP DRAWING HAS BEEN REVIEWED BY PARIC CORPORATION

Subcontractor remains responsible for dimensions, quantities, coordination with other trades and compliance with contract documents.

By:
Devin D. Gates

Joe Voypick
REVIEWED BY

2/17/17
DATE

To be completed by Reviewer

12 3661.16-003
CANNON DESIGN SUBMITTAL NUMBER

2/17/17
RECEIVED DATE

( ) A. No Exceptions Taken
No further review of submittal is required.

(•) B. Make Corrections Noted
Incorporate corrections in work; resubmission is not required.

( ) C. Revise and Resubmit
Revise as noted, and resubmit for review.

( ) D. Rejected
Submittal is not in compliance with Contract Documents; provide new submittal.

( ) E. For Record / Information Only
Submittal was reviewed for Record / Information purposes only.

( ) F. Not Required for Review
Submittal is not required by Contract Documents and has not been reviewed.

Review is for conformance with the design concept of this project and for general compliance with contract documents. Contractor is responsible for quantities, dimensions and compliance with contract documents and for information that pertains to fabrication processes, construction techniques and coordination of this work with all trades which will be affected thereby. This review is null and void if submittal deviates from contract documents and does not indicate or note deviations.

A/E COMMENTS

( ) See attached sheet(s) for additional comments

bench to be constructed, fastened, supported and anchored as required to support people sitting.

Lynn Grossman
Digitally signed by Lynn Grossman
DN: C=US, E=lgrossman@cannondesign.com, O=Cannon Design, CN=Lynn Grossman
Date: 2017.03.21 20:11:05-05'00'
REVIEWED BY

03.2117
DATE

PARIC
EXPERIENCE. EXCELLENCE.
77 Westport Plaza
Suite 250
St. Louis, MO 63146

TRANSMITTAL

No. 15051-0501

Paric Corporation

PROJECT: 15051-Webster University Interdisciplinary Science Building

DATE: 02/17/2017

TO: Cannon Design
1100 Clark Ave
St Louis MO 63102

Fax;
314-241-2203

RE: Bench 183C Shop Drawings

ATTN: Kelvin Patel

JOB: 15051

WE ARE SENDING:	SUBMITTED FOR:	ACTION TAKEN:
☑ Shop Drawings	☑ Approval	☐ Approved as Submitted
☐ Letter	☐ Your Use	☐ Approved as Noted
☐ Prints	☐ As Requested	☐ Returned After Loan
☐ Change Order	☐ Review and Comment	☐ Resubmit
☐ Plans		☐ Submit
☐ Samples	**SENT VIA:**	☐ Returned
☐ Specifications	☐ Attached	☐ Returned for Corrections
☐ Other:	☐ Separate Cover Via:	☐ Due Date:

Item	*Package*	*Code*	*Rev.*	*Copies*	*Date*	*Description*	*Status*
Submittal		123661.16-003	1		02/17/2017	Bench 183C Shop Drawings	Submitted

NOTES:

CC:

Signed: _____
Devin Gates