



REV	DESCRIPTION	BY	DATE	—	----	---	---/---/---
—	----	---	---/---/---	—	----	---	---/---/---

CKT NO	ACCESSORIES	TYPE	RATING AMP/P		RATING AMP/P	TYPE	ACCESSORIES	CKT NO
1		QOB	20 / 1		20 / 1	QOB		2
3		QOB	20 / 1		20 / 1	QOB		4
5		QOB	20 / 1		20 / 1	QOB		6
7		QOB	20 / 1		20 / 1	QOB		8
9		QOB	20 / 1		20 / 1	QOB		10
11		QOB	20 / 1		20 / 1	QOB		12
13		QOB	20 / 1		20 / 1	QOB		14
15		QOB	20 / 1		20 / 1	QOB		16
17		QOB	20 / 1		20 / 1	QOB		18
19		QOB	20 / 1		20 / 1	QOB		20
21		QOB	15 / 1		15 / 1	QOB		22
23		QOB	15 / 1		15 / 1	QOB		24
25	PREPARED SPACE	QOB	20 / 1		20 / 1	QOB	PREPARED SPACE	26
27	PREPARED SPACE	QOB	20 / 1		20 / 1	QOB	PREPARED SPACE	28
29	PREPARED SPACE	QOB	20 / 1		20 / 1	QOB	PREPARED SPACE	30
31	PREPARED SPACE	QOB	20 / 1		20 / 1	QOB	PREPARED SPACE	32
33	PREPARED SPACE	QOB	20 / 1		20 / 1	QOB	PREPARED SPACE	34
35	PREPARED SPACE	QOB	20 / 1		20 / 1	QOB	PREPARED SPACE	36
37	PREPARED SPACE	QOB	20 / 1		20 / 1	QOB	PREPARED SPACE	38
39	PREPARED SPACE	QOB	20 / 1		20 / 1	QOB	PREPARED SPACE	40
41	PREPARED SPACE	QOB	20 / 1		20 / 1	QOB	PREPARED SPACE	42

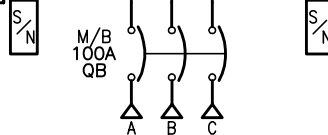

NQ442L2CSR/NQMB2QSK/QBL32100

SEISMIC QUALIFIED LABEL REQUIRED

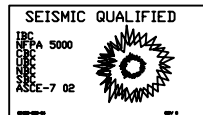

PHYSICAL DATA

- ENCLOSURE: INTERIOR ONLY

FRONT CAT#: N/A

BOX CAT#: N/A

DIMENSIONS:

"H X "W X "D

WIRE BENDING SPACE:

TOP

BOTTOM

SIDE

- BUSSING: COPPER BUS
STANDARD PLATING

- SPECIAL:
STANDARD SOLID NEUTRAL
STANDARD GROUND BAR

ELECTRICAL DATA

- SYSTEM: 208Y/120V 3PH 4W 60Hz
10,000 AMPS SYMS. SCCR

- MAIN BREAKER: 100A
ACC:
BOTTOM FEED

- BRANCH MOUNTING TYPE: BOLT-ON

JOB NAME:	WEBSTER UNIVERSITY ISB	EQUIPMENT DESIGNATION:	PANEL 1EL1
JOB LOCATION:	WEBSTER GROVES, MO	EQUIPMENT TYPE:	NQ
DRAWN BY:	AMS	DRAWING TYPE:	IPC2
ENGR:	AMS		
DATE:	10/3/2016		
DRAWING STATUS:	RECORD	DWG#	37999262-007-1-01-2



Schneider Electric