REV	DESCRIPTION	BY	DATE	–	----	--	--/--/--
1	UPDATED PRINT	AMS	12/6/16	–	----	--	--/--/--

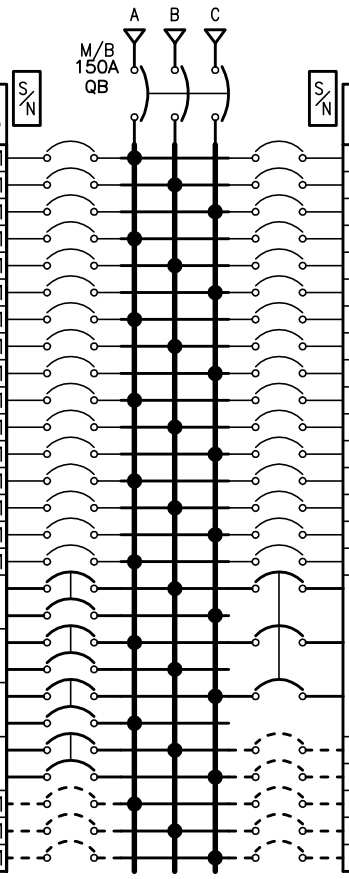

CKT NO	ACCESSORIES	TYPE	RATING AMP/P
1		QOB	20/1
3		QOB	20/1
5		QOB	20/1
7		QOB	20/1
9		QOB	20/1
11		QOB	20/1
13		QOB	20/1
15		QOB	20/1
17		QOB	20/1
19		QOB	20/1
21		QOB	20/1
23		QOB	20/1
25		QOB	20/1
27		QOB	20/1
29		QOB	20/1
31		QOB	20/1
33		QOB	30/2
35			
37		QOB	30/2
39			
41		QOB	30/2
43			
45		QOB	30/2
47			
49	PREPARED SPACE	QOB	20/1
51	PREPARED SPACE	QOB	20/1
53	PREPARED SPACE	QOB	20/1

RATING AMP/P	TYPE	ACCESSORIES	CKT NO
20/1	QOB		2
20/1	QOB		4
20/1	QOB		6
20/1	QOB		8
20/1	QOB		10
20/1	QOB		12
20/1	QOB		14
20/1	QOB		16
20/1	QOB		18
20/1	QOB		20
20/1	QOB		22
20/1	QOB		24
20/1	QOB		26
20/1	QOB		28
20/1	QOB		30
20/1	QOB		32
150/3	QOB–VH		34
			36
			38
			40
			42
			44
20/1	QOB	PREPARED SPACE	46
20/1	QOB	PREPARED SPACE	48
20/1	QOB	PREPARED SPACE	50
20/1	QOB	PREPARED SPACE	52
20/1	QOB	PREPARED SPACE	54

NQ454L2C/NQMB2Q/QBL32150

SEISMIC QUALIFIED LABEL REQUIRED

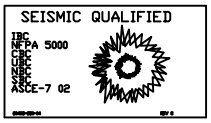

PHYSICAL DATA

- ENCLOSURE: INTERIOR ONLY

  FRONT CAT#: N/A
  BOX CAT#: N/A
  DIMENSIONS:
  "H X "W X "D
  WIRE BENDING SPACE:
  TOP
  BOTTOM
  SIDE
  PBA 709A
- BUSSING: COPPER BUS
  STANDARD PLATING
- SPECIAL:
  COPPER SOLID NEUTRAL
  COPPER GROUND BAR

ELECTRICAL DATA

- SYSTEM: 208Y/120 VAC 3PH 4W 60 HZ
  10,000 AMPS SYMS. SCCR
- MAIN BREAKER: 150A
  TOP FEED
- BRANCH MOUNTING TYPE: BOLT–ON

JOB NAME:	WEBSTER UNIVERSITY ISP	EQUIPMENT DESIGNATION:	1SL1
JOB LOCATION:	WEBSTER GROVEES, MO	EQUIPMENT TYPE:	NQ PANEL
DRAWN BY:	AMS	DRAWING TYPE:	IPC2
ENGR:	AMS		
DATE:	11/2/2016		
DRAWING STATUS:	RECORD	DWG# 37999262-008-2-01-1	PG 3 OF 5 REV –